


COORDINATION SIGN-OFF

COMPANY	TRADE	DATE
CONTI	ELEC.	/ /
		/ /
		/ /
**Music City Center**  
 Nashville, Tennessee

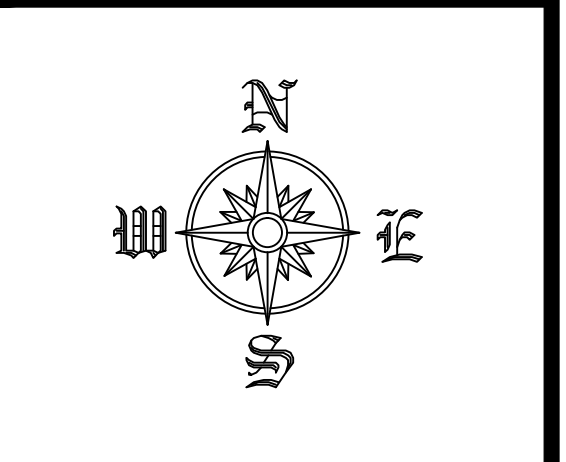

REVISIONS

NO.	DATE	DESCRIPTION

**RECORD DRAWINGS STAMP**

CONTRACT DATE (Last Update): 6/24/2015  
 DRAWING FILE NAME: EL2-104  
 CAD OPERATOR: GERRITMAN  
 PRINTED BY: FREDMAN, GREGG  
 PLOT DATE: 6/24/2015 8:08 AM  
 SUBMITTED BY: G.L.P.  
 ASSIGNED TO:


LEVEL 1 LIGHTING  
 ZONE 4  
 SCALE: 1/8" = 1'-0"

EL2-104

FILE PATH FOR CAD OPERATOR USE ONLY: P:\3085\Conti\Bldg\Nashville\_MusCity\Level 01\Bldg 4\EL2\Zone 1 Lighting\Zone 4 For Opening

COORDINATION SIGN-OFF		DATE	NAME
COMPANY	TRADE		
CONTI	ELEC.		

Music City Center  
 Nashville, Tennessee

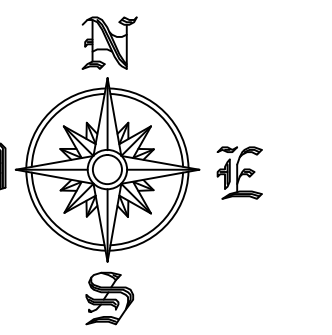



REVISIONS		
NO.	DATE	DESCRIPTION

RECORD DRAWINGS STAMP	
CONTI ELECTRIC DATE (Last Update):	6/4/2015 B.O.B.A1
DRAWING FILE NAME:	EL2-105
CAD OPERATOR:	SEYMEN
PRINTED BY:	SEYMEN, GREGG
PLOT DATE:	6/4/2015 B.O.B.A1
SUBMITTED BY:	ELF
ASSIGNED TO:	

LEVEL 1 LIGHTING  
 ZONE 5  
 SCALE: 1/8" = 1'-0"


EL2-105

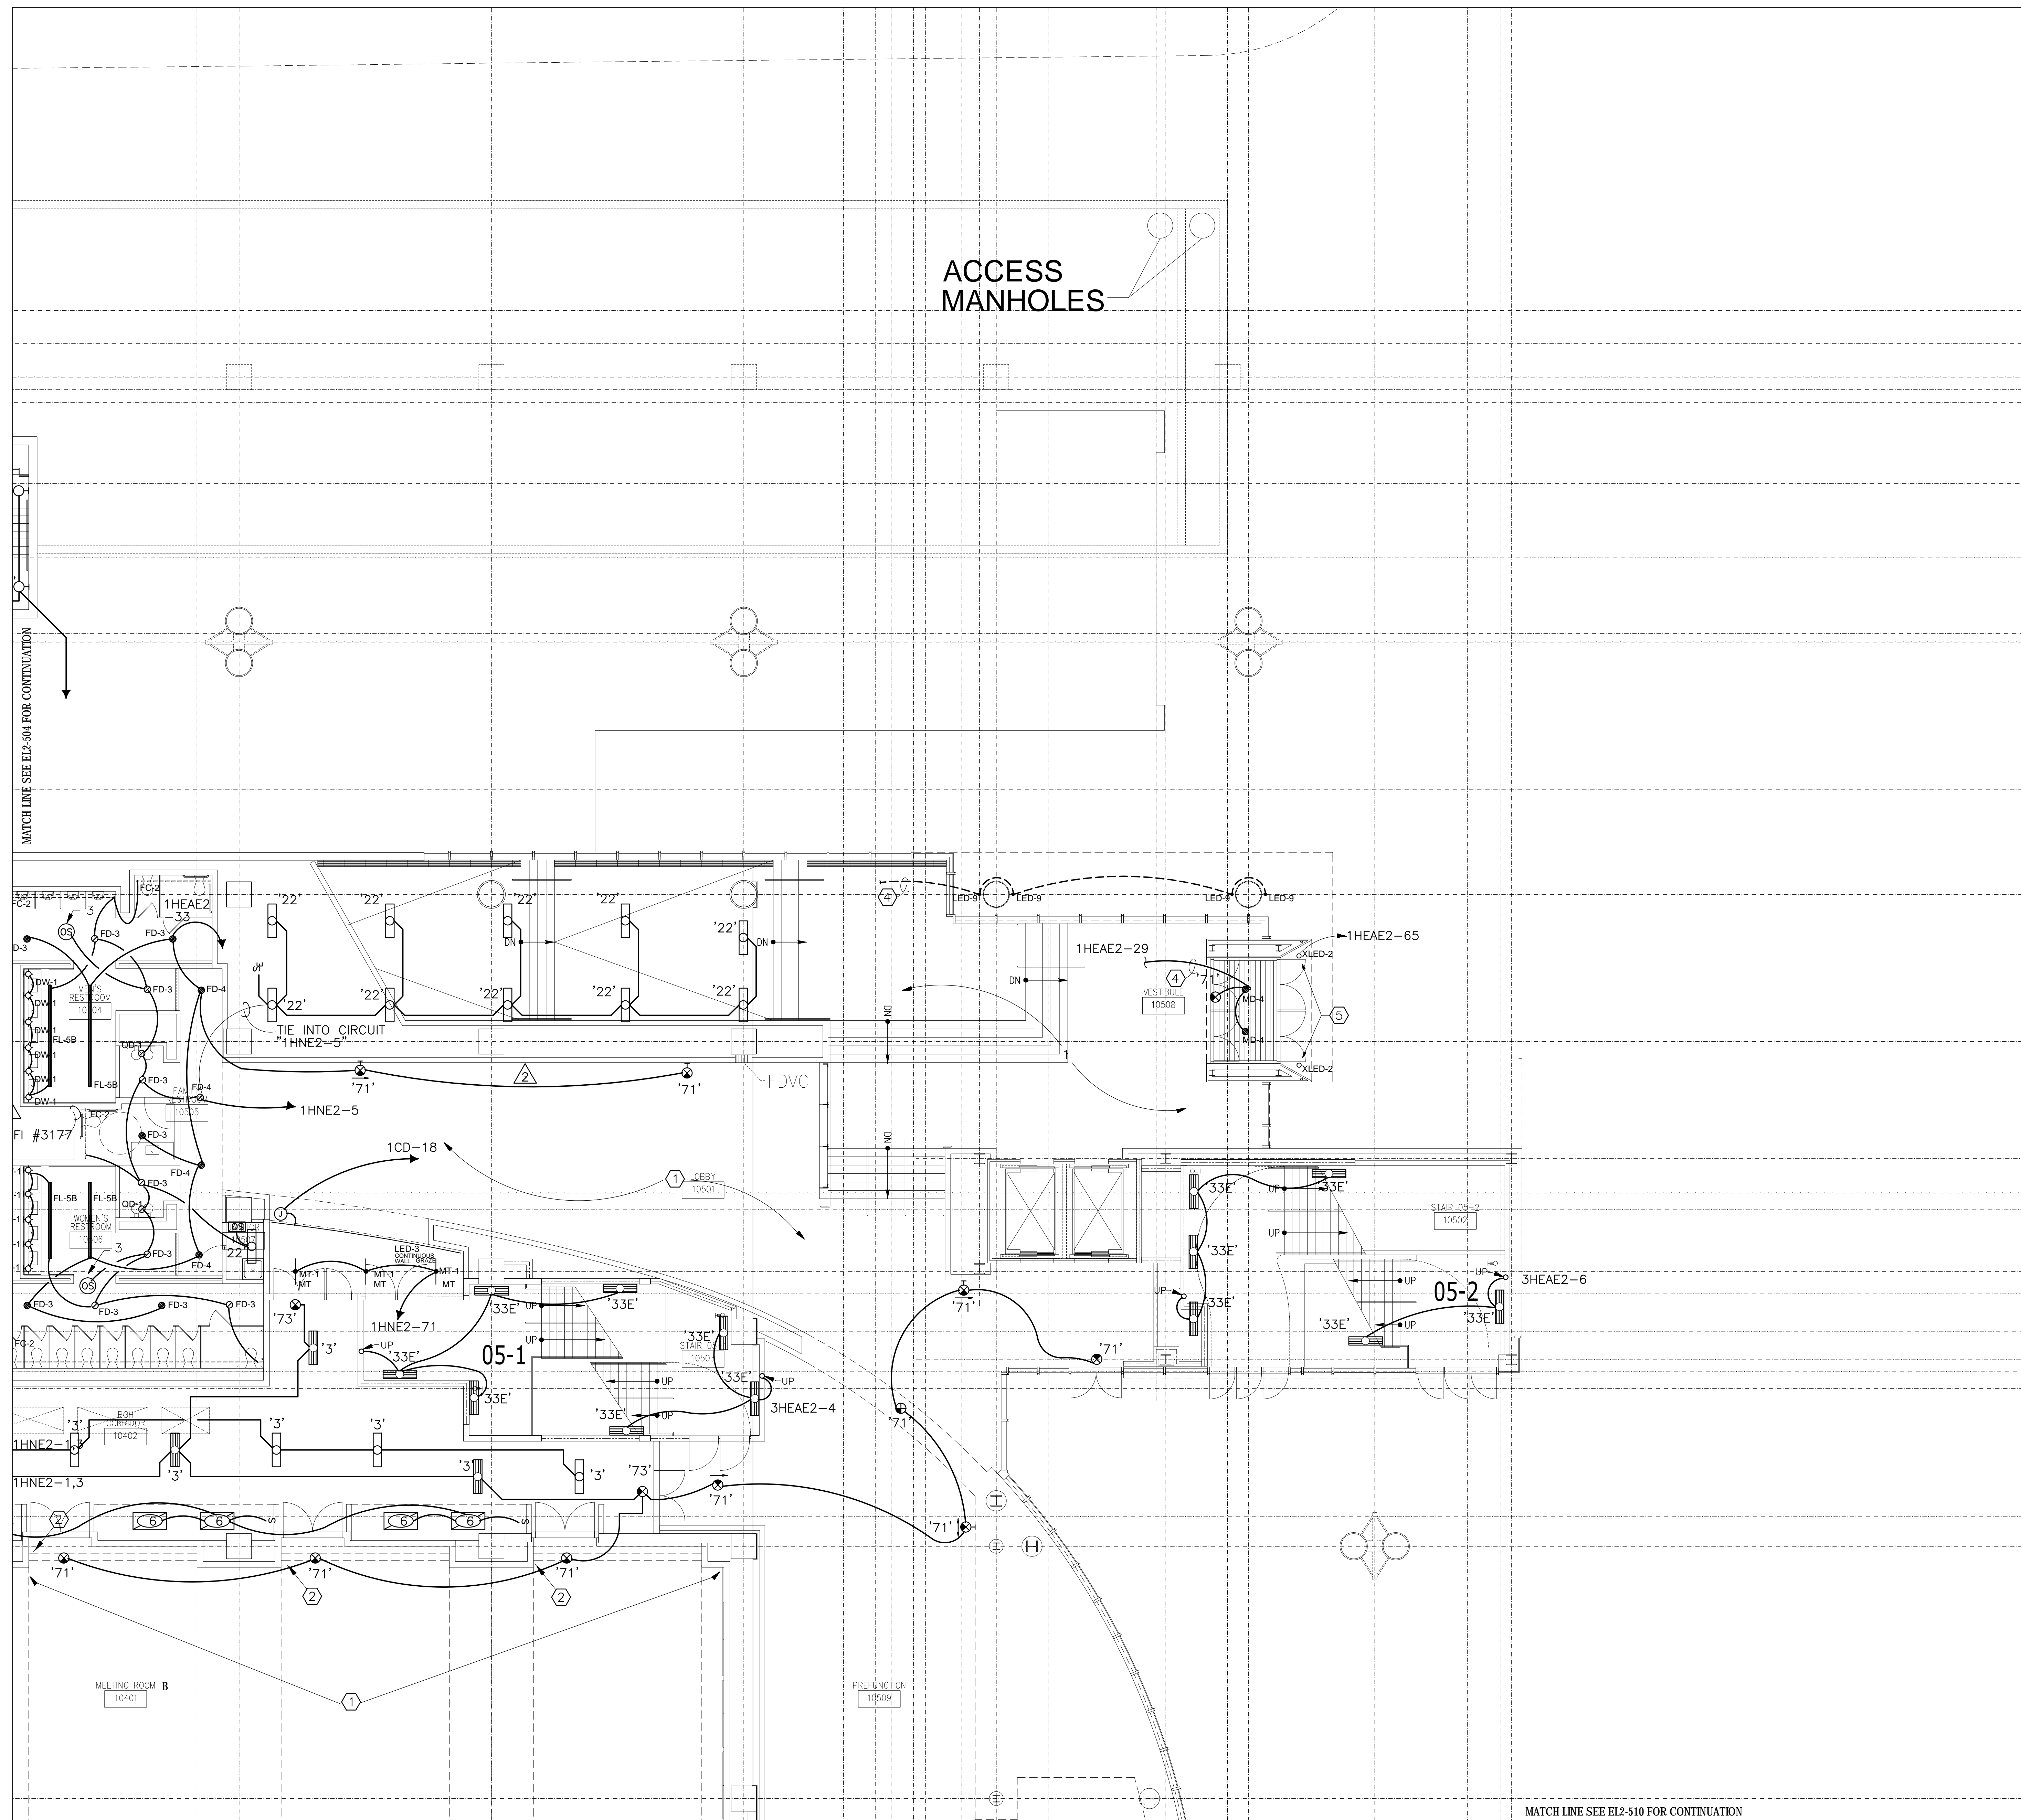

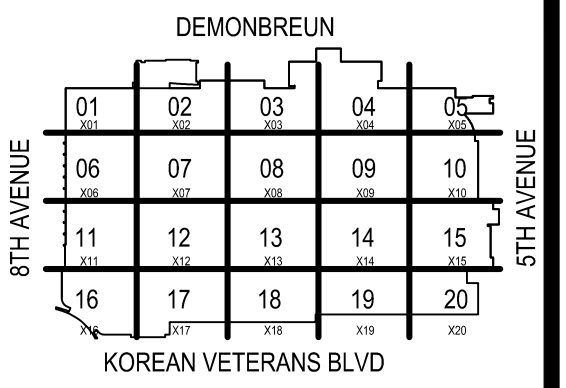

COORDINATION SIGN-OFF				
COMPANY	TRADE	NAME	DATE	
CONTI	ELEC.		/ /	
			/ /	
			/ /	
**Music City Center**  
 Nashville, Tennessee

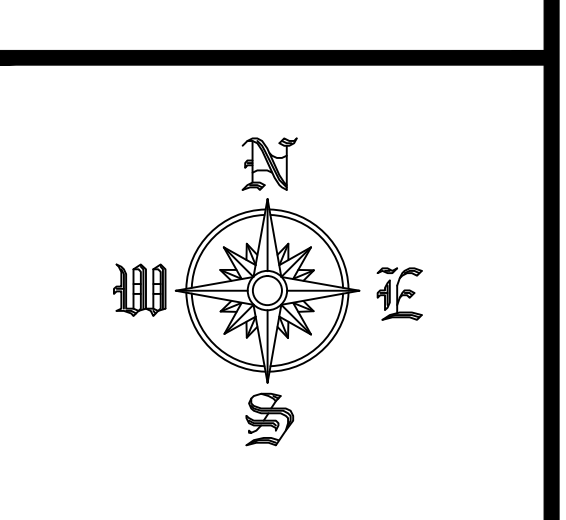

REVISIONS		
NO.	DATE	DESCRIPTION

**RECORD DRAWINGS STAMP**

CONTI ELECTRIC DATE (Last Update): 6/4/2012 8:00 AM  
 DRAWING FILE NAME: E2-09  
 CAD OPERATOR: SEYMEN  
 PRINTED BY: SEYMEN GREG  
 PLOT DATE: 6/4/2012 8:00 AM  
 SUBMITTED BY: SLP  
 ASSIGNED TO:

LEVEL 1 LIGHTING  
 ZONE 8  
 SCALE: 1/8" = 1'-0"

EL2-108



FILE PATH FOR CAD DEPARTMENT USE ONLY: P:\08\Conti\Bids\Nashville\Level1\Zone 8\EL2-108.dwg

DEMONBREUN


01	02	03	04	05
06	07	08	09	10
11	12	13	14	15
16	17	18	19	20

KOREAN VETERANS BLVD

KEY PLAN  
NO SCALE

COORDINATION SIGN-OFF	
DATE	/ /
NAME	/ /
TRADE	ELEC.
COMPANY	CONTI

**Music City Center**  
Nashville, Tennessee

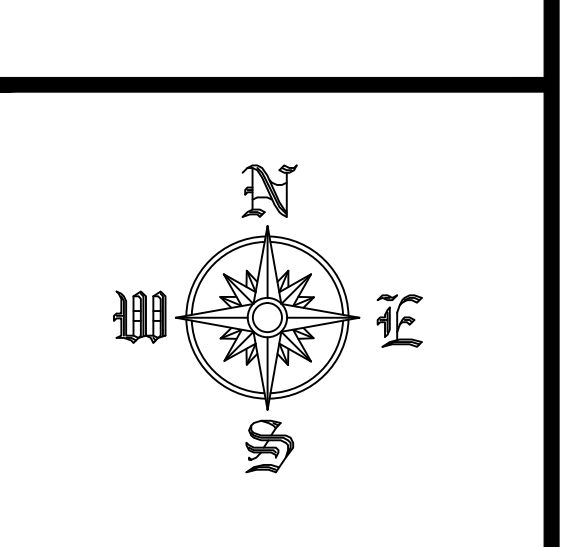

REVISIONS


NO.	DATE	DESCRIPTION

RECORD DRAWINGS STAMP


CONTELECTRIC DATE (Last Update): 6/4/2012 8:08 AM  
 DRAWING FILE NAME: EL2-109  
 CAD OPERATOR: GERTMAN  
 PRINTED BY: FREDMAN, GREGG  
 PLOT DATE: 6/4/2012 8:08 AM  
 SUBMITTED BY: GELF  
 ASSIGNED TO:

LEVEL 1 LIGHTING  
 ZONE 9  
 SCALE: 1/8" = 1'-0"

EL2-109

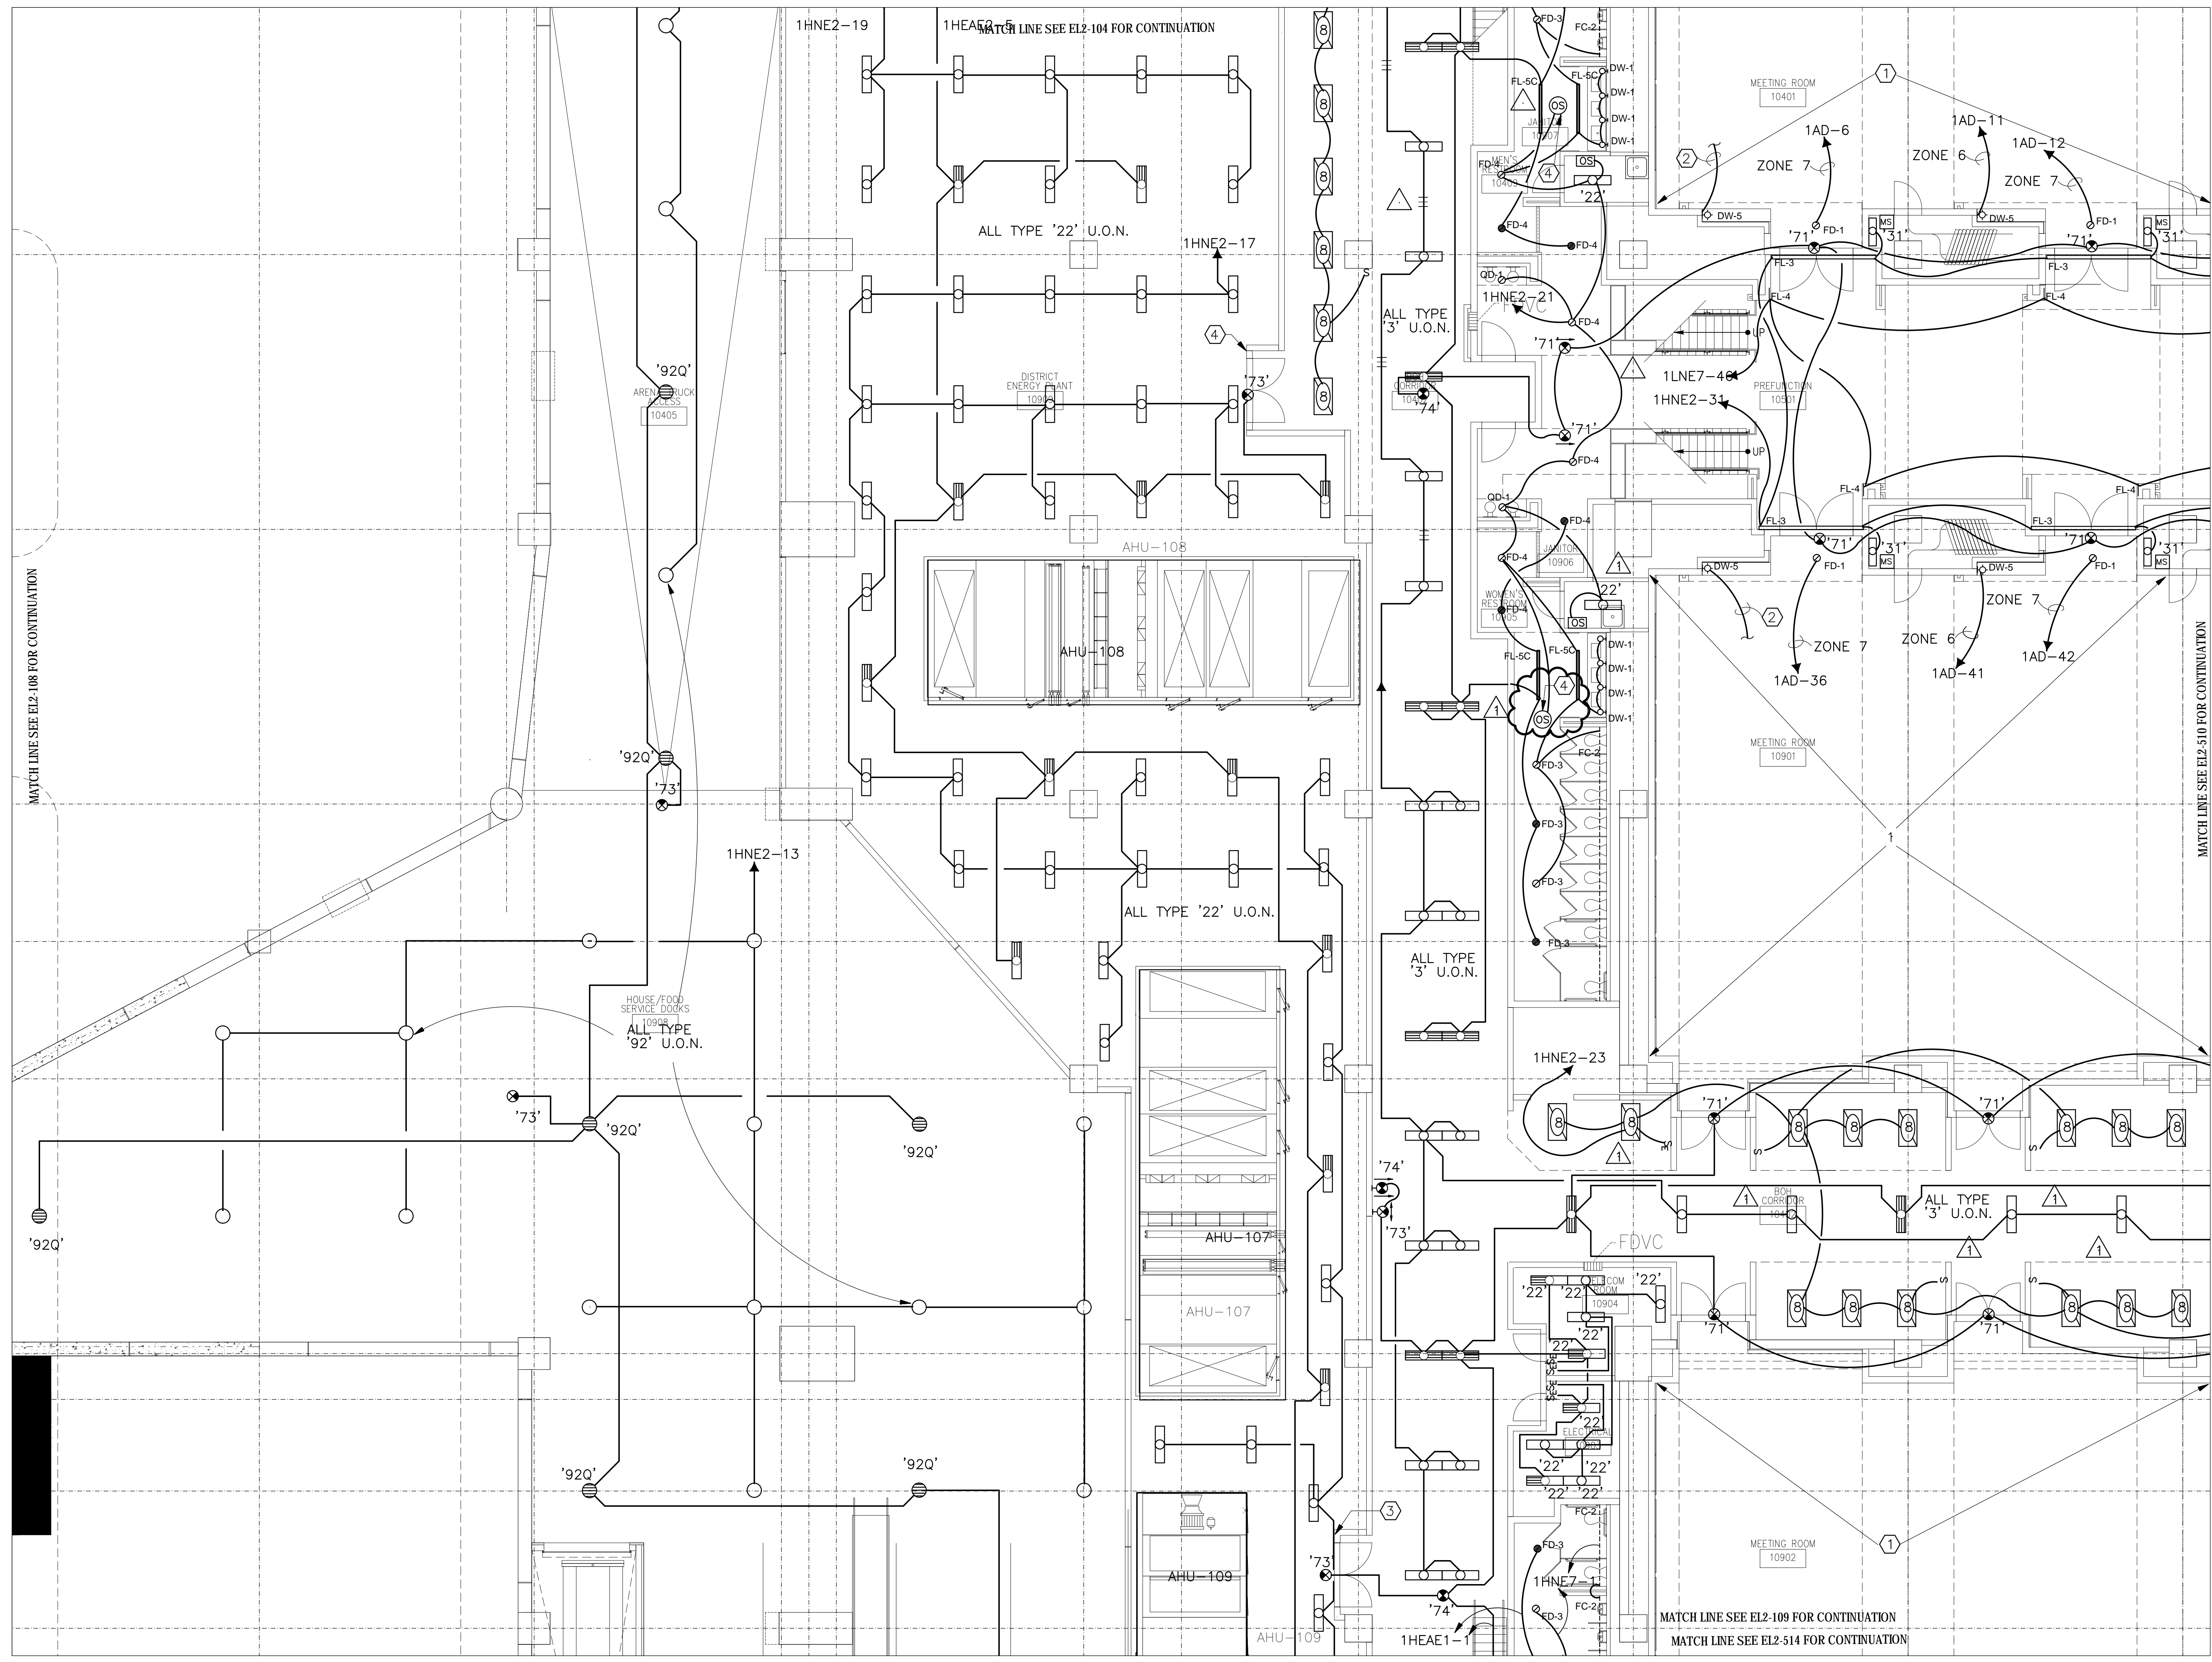


FILE PATH FOR CAD DEPARTMENT USE ONLY: P:\2012\Conti\Bids\Nashville\_MCC\Level 01 - Center At Ballin\4-13-12\Level 1 Lighting\Zone 9 For Opening.dwg

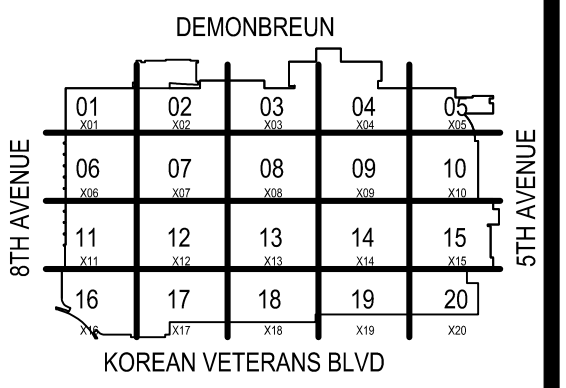

COORDINATION SIGN-OFF

COMPANY	TRADE	DATE
CONTI	ELEC.	/ /
		/ /
		/ /
**Music City Center**  
 Nashville, Tennessee

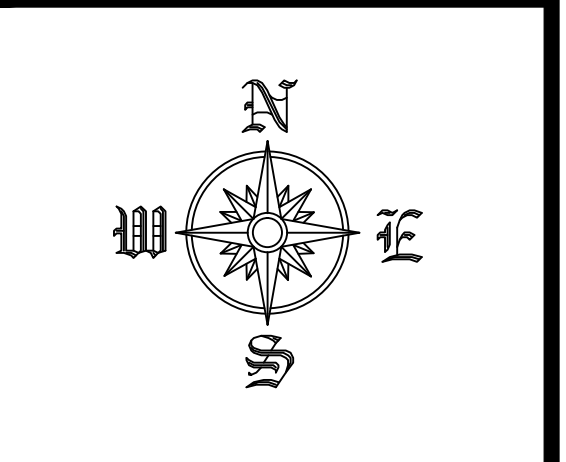

REVISIONS


NO.	DATE	DESCRIPTION

RECORD DRAWINGS STAMP


CONTI ELECTRIC DATE (Last Update):	6/4/2012
DRAWING FILE NAME:	EL2-110
CAD OPERATOR:	SEBASTIAN
PRINTED BY:	SEBASTIAN
PLOT DATE:	6/4/2012 8:08 AM
SUBMITTED BY:	SEBASTIAN
ASSIGNED TO:	

LEVEL 1 LIGHTING  
 ZONE 10  
 SCALE: 1/8" = 1'-0"

EL2-110

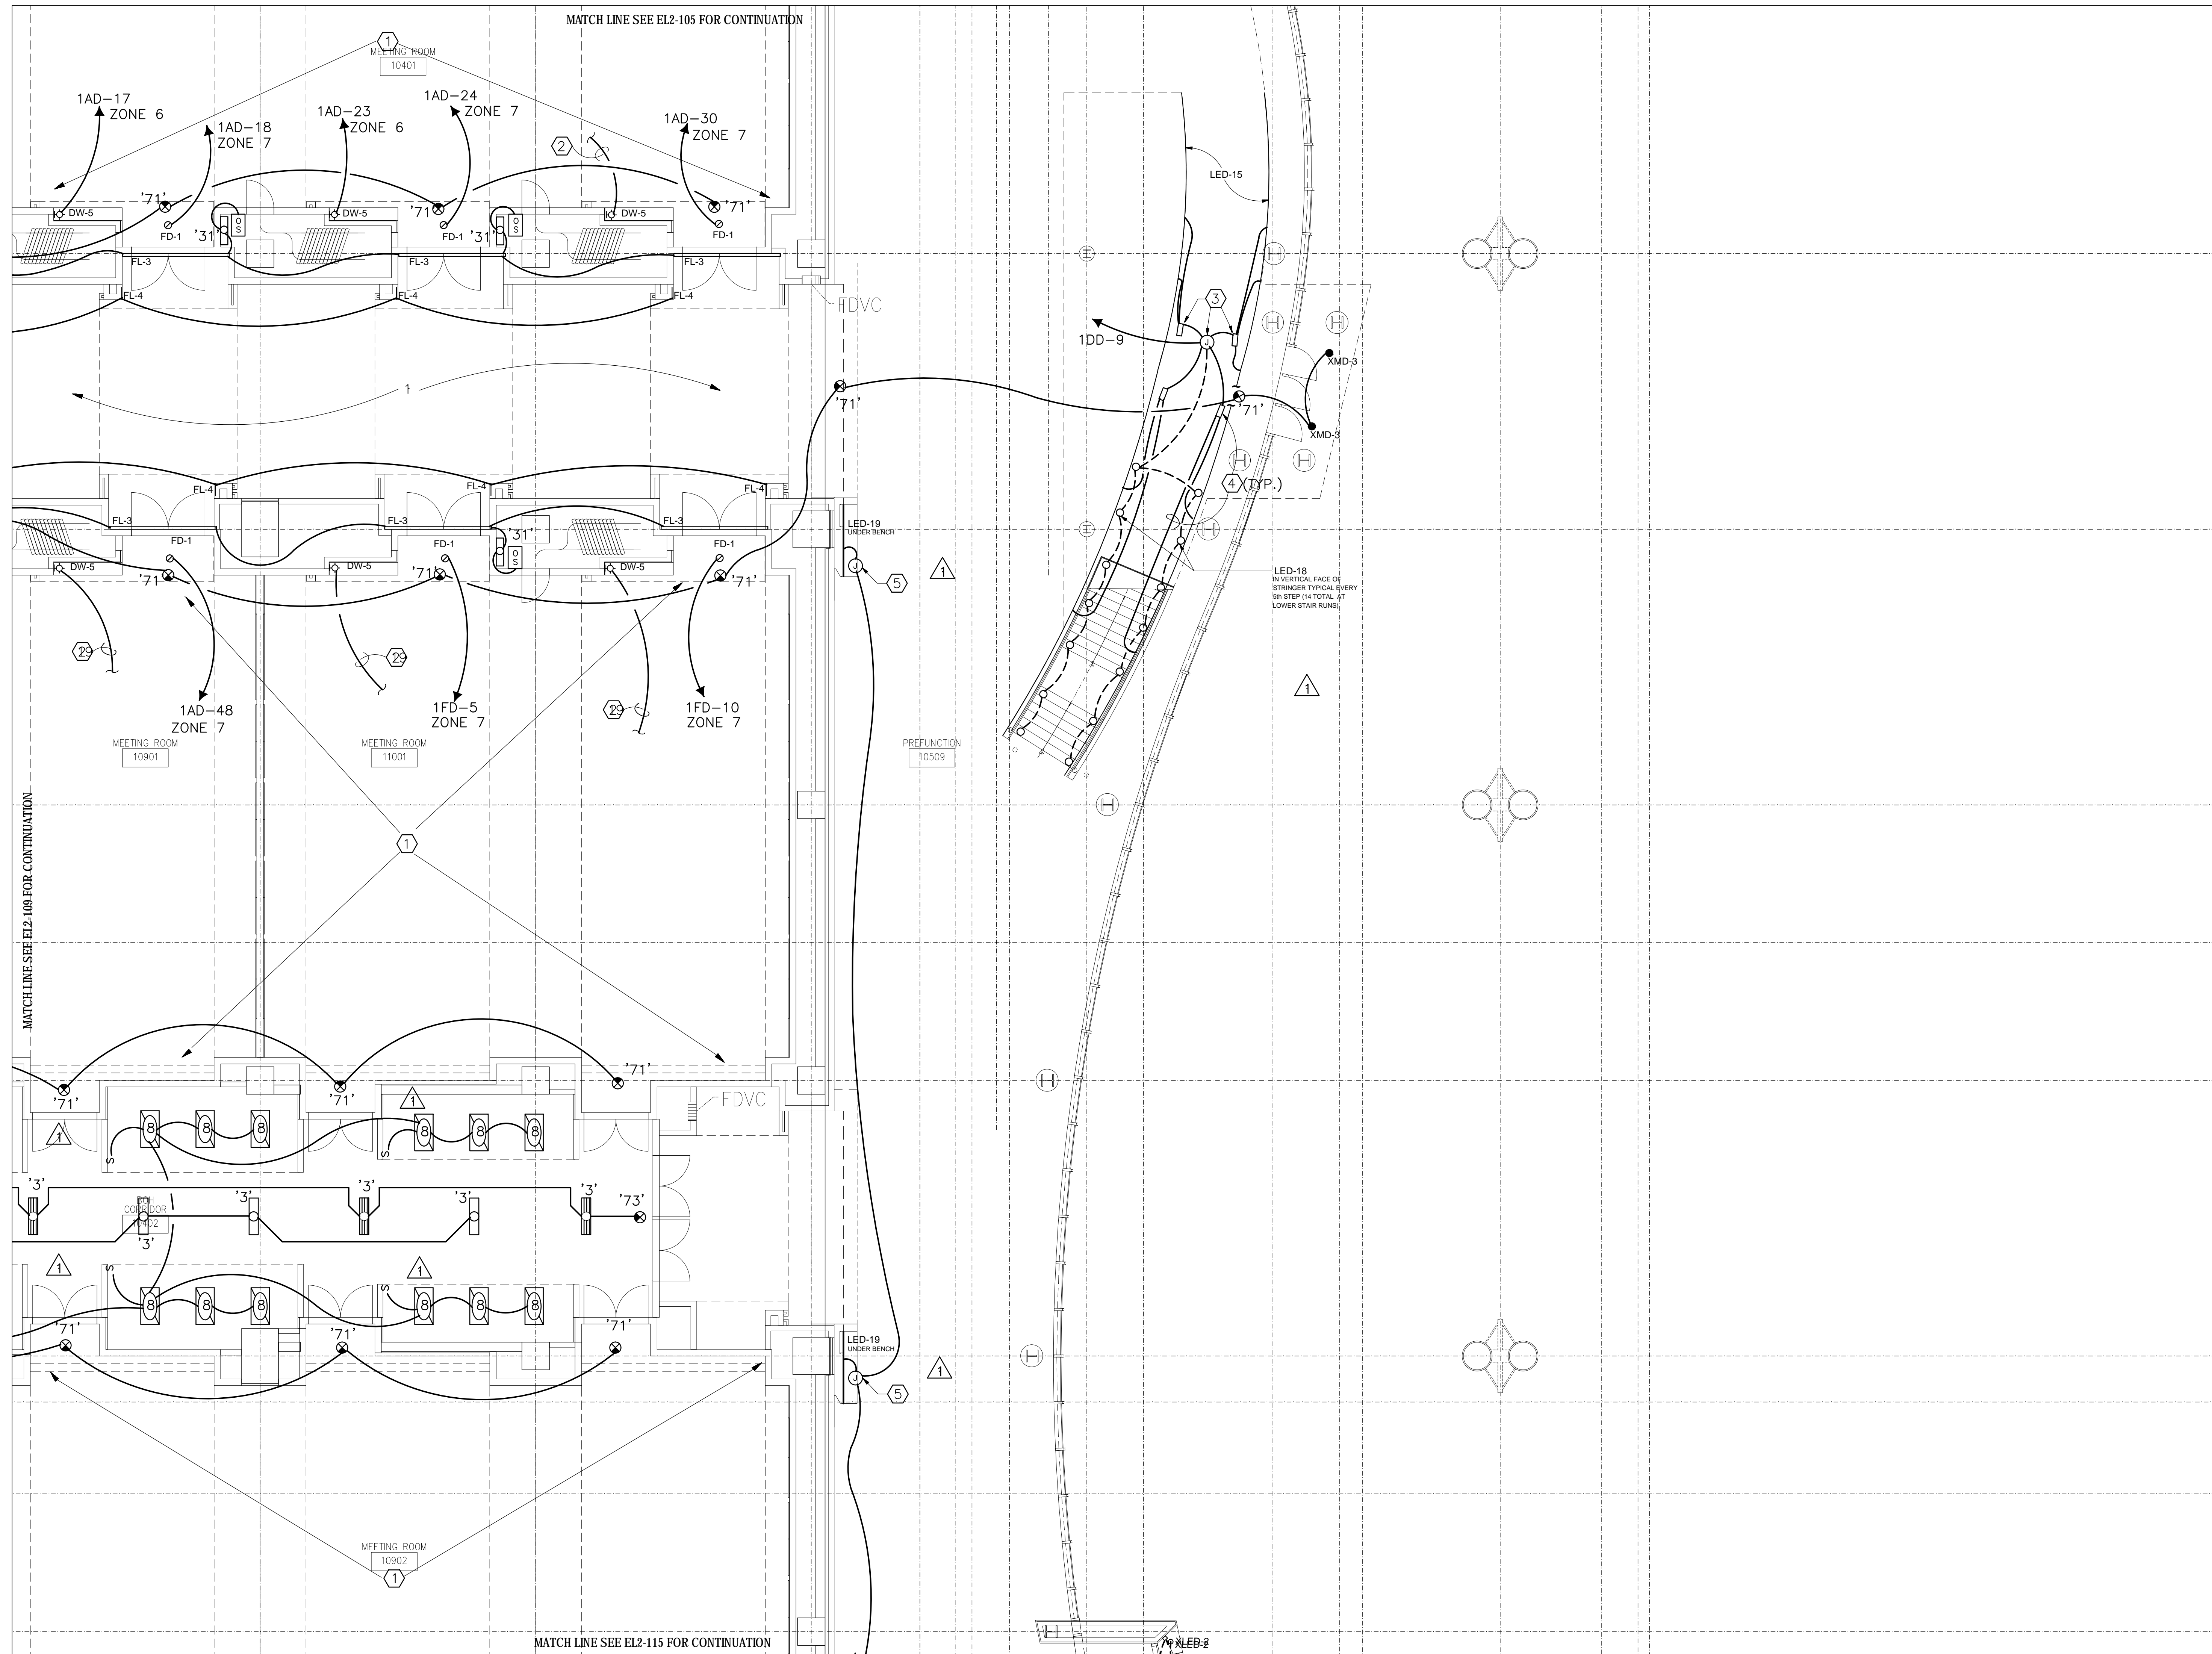


FILE PATH FOR CAD OPERATOR USE ONLY: P:\0305\Conti\Bids\Nashville\_MCC\Level 01\Level 1 Lighting\Zone 10 Lighting.dwg

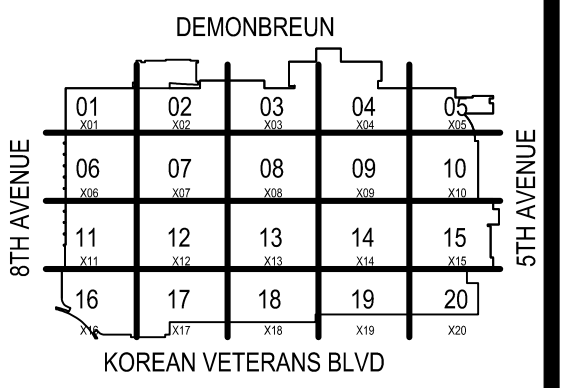

COORDINATION SIGN-OFF

COMPANY	TRADE	DATE
CONTI	ELEC.	/ /
		/ /
		/ /
**Music City Center**  
 Nashville, Tennessee

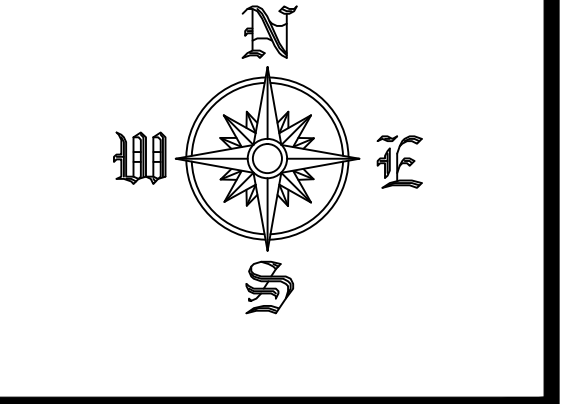

REVISIONS


NO.	DATE	DESCRIPTION

RECORD DRAWINGS STAMP

CONTI ELECTRIC DATE (Last Update):  
 6/4/2015 B.C.B./A1  
 DRAWING FILE NAME:  
 E22-114  
 CAD OPERATOR:  
 GERTMAN  
 PRINTED BY:  
 FREDMAN, GREGG  
 PLOT DATE:  
 6/4/2015 B.C.B./A1  
 SUBMITTED BY:  
 G.P.  
 ASSIGNED TO:

LEVEL 1 LIGHTING  
 ZONE 14  
 SCALE: 1/8" = 1'-0"

EL2-114

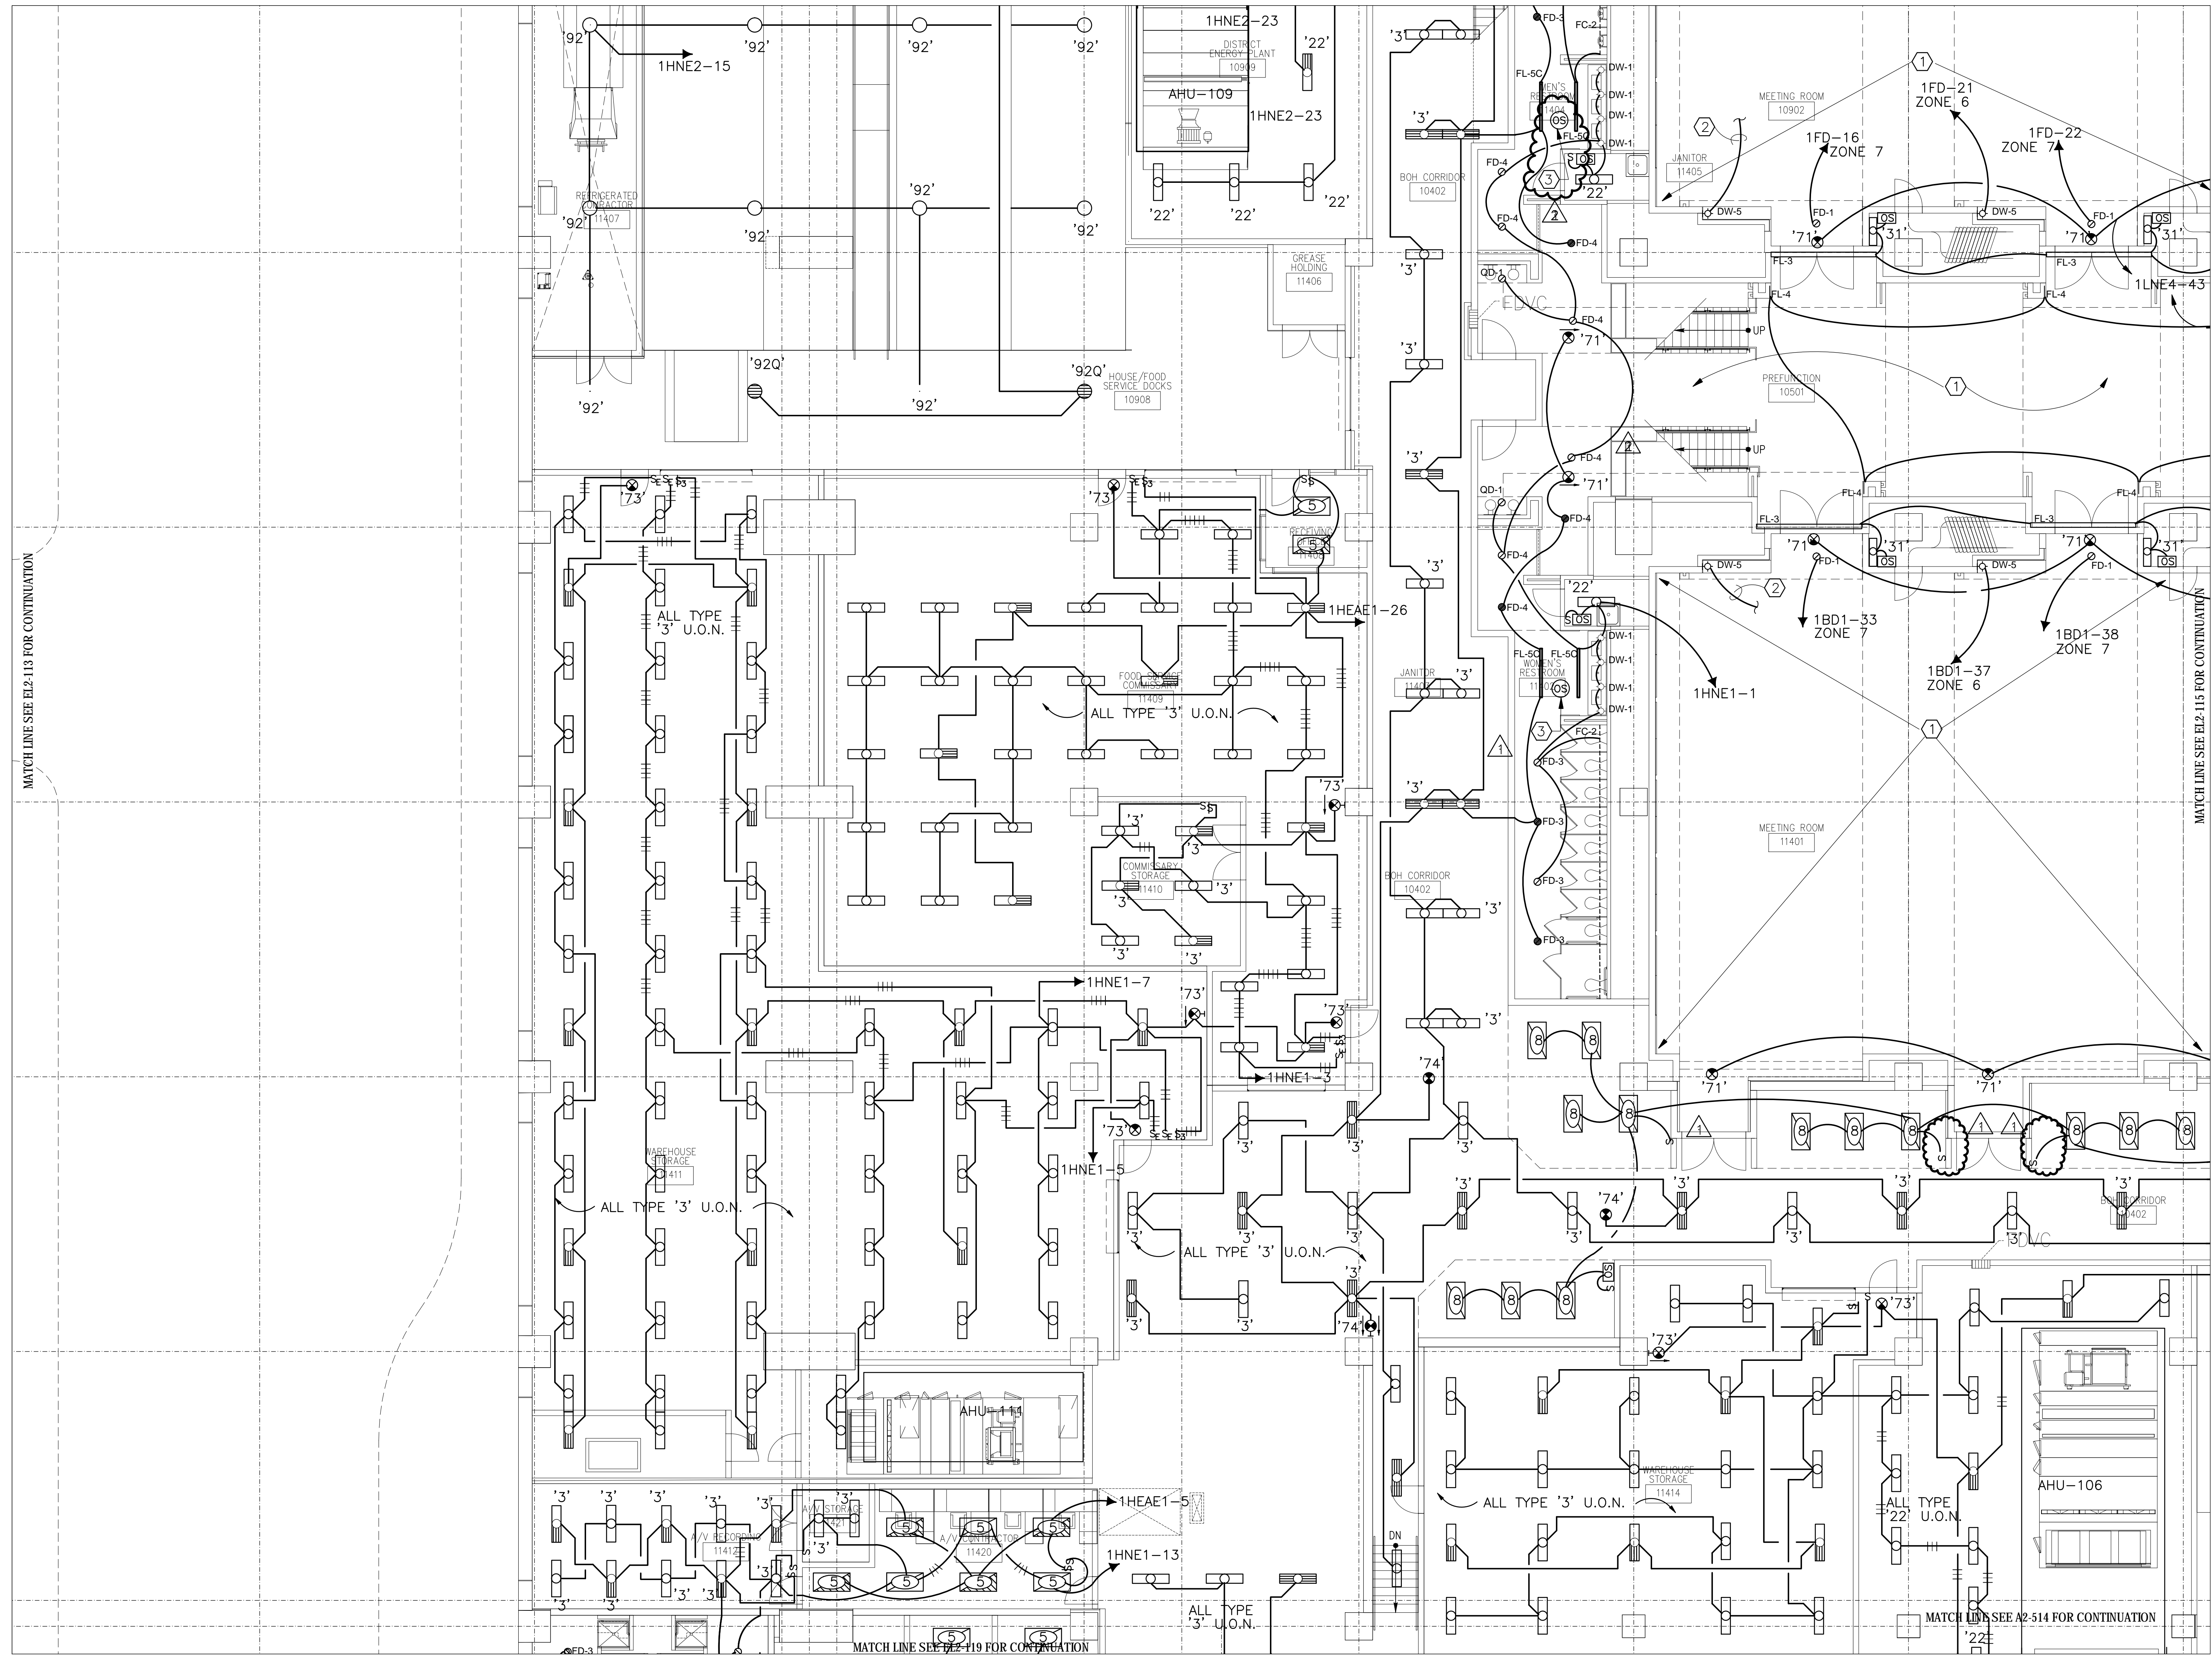

MATCH LINE SEE E2-113 FOR CONTINUATION


MATCH LINE SEE E2-115 FOR CONTINUATION

MATCH LINE SEE E2-119 FOR CONTINUATION

MATCH LINE SEE A2-514 FOR CONTINUATION

FILE PATH FOR CAD OPERATOR USE ONLY: P:\2015\Conti\Bids\Projects\MusicCity\Level 01\Bids\A2-514\Level 1 Lighting\Zone 14 For Opening.dwg




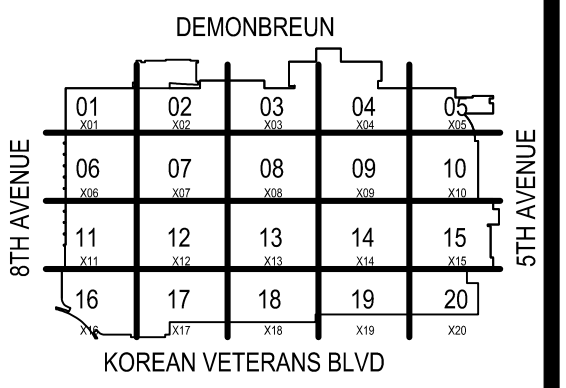

COORDINATION SIGN-OFF

COMPANY	TRADE	DATE
CONTI	ELEC.	/ /
		/ /
		/ /
**Music City Center**  
 Nashville, Tennessee

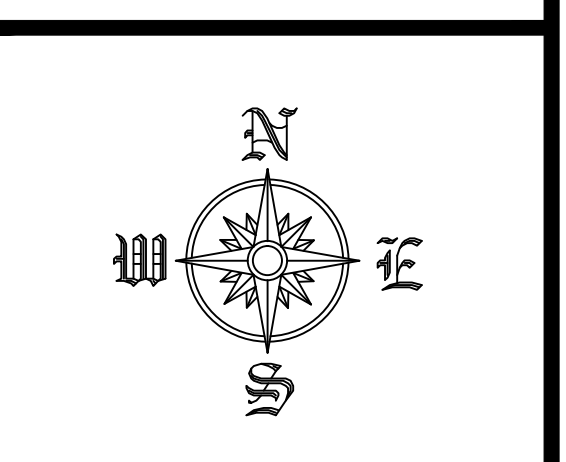

REVISIONS

NO.	DATE	DESCRIPTION

RECORD DRAWINGS STAMP

CONTI ELECTRIC DATE (Last Update): 6/4/2015 BCP/AT

DRAWING FILE NAME: E2-119

CAD OPERATOR: GERTMAN

PRINTED BY: FREDMAN, GREGG


PLOT DATE: 6/4/2015 BCP/AT

SUBMITTED BY: G.L.P.

ASSIGNED TO:

LEVEL 1 LIGHTING  
 ZONE 19  
 SCALE: 1/8" = 1'-0"

EL2-119

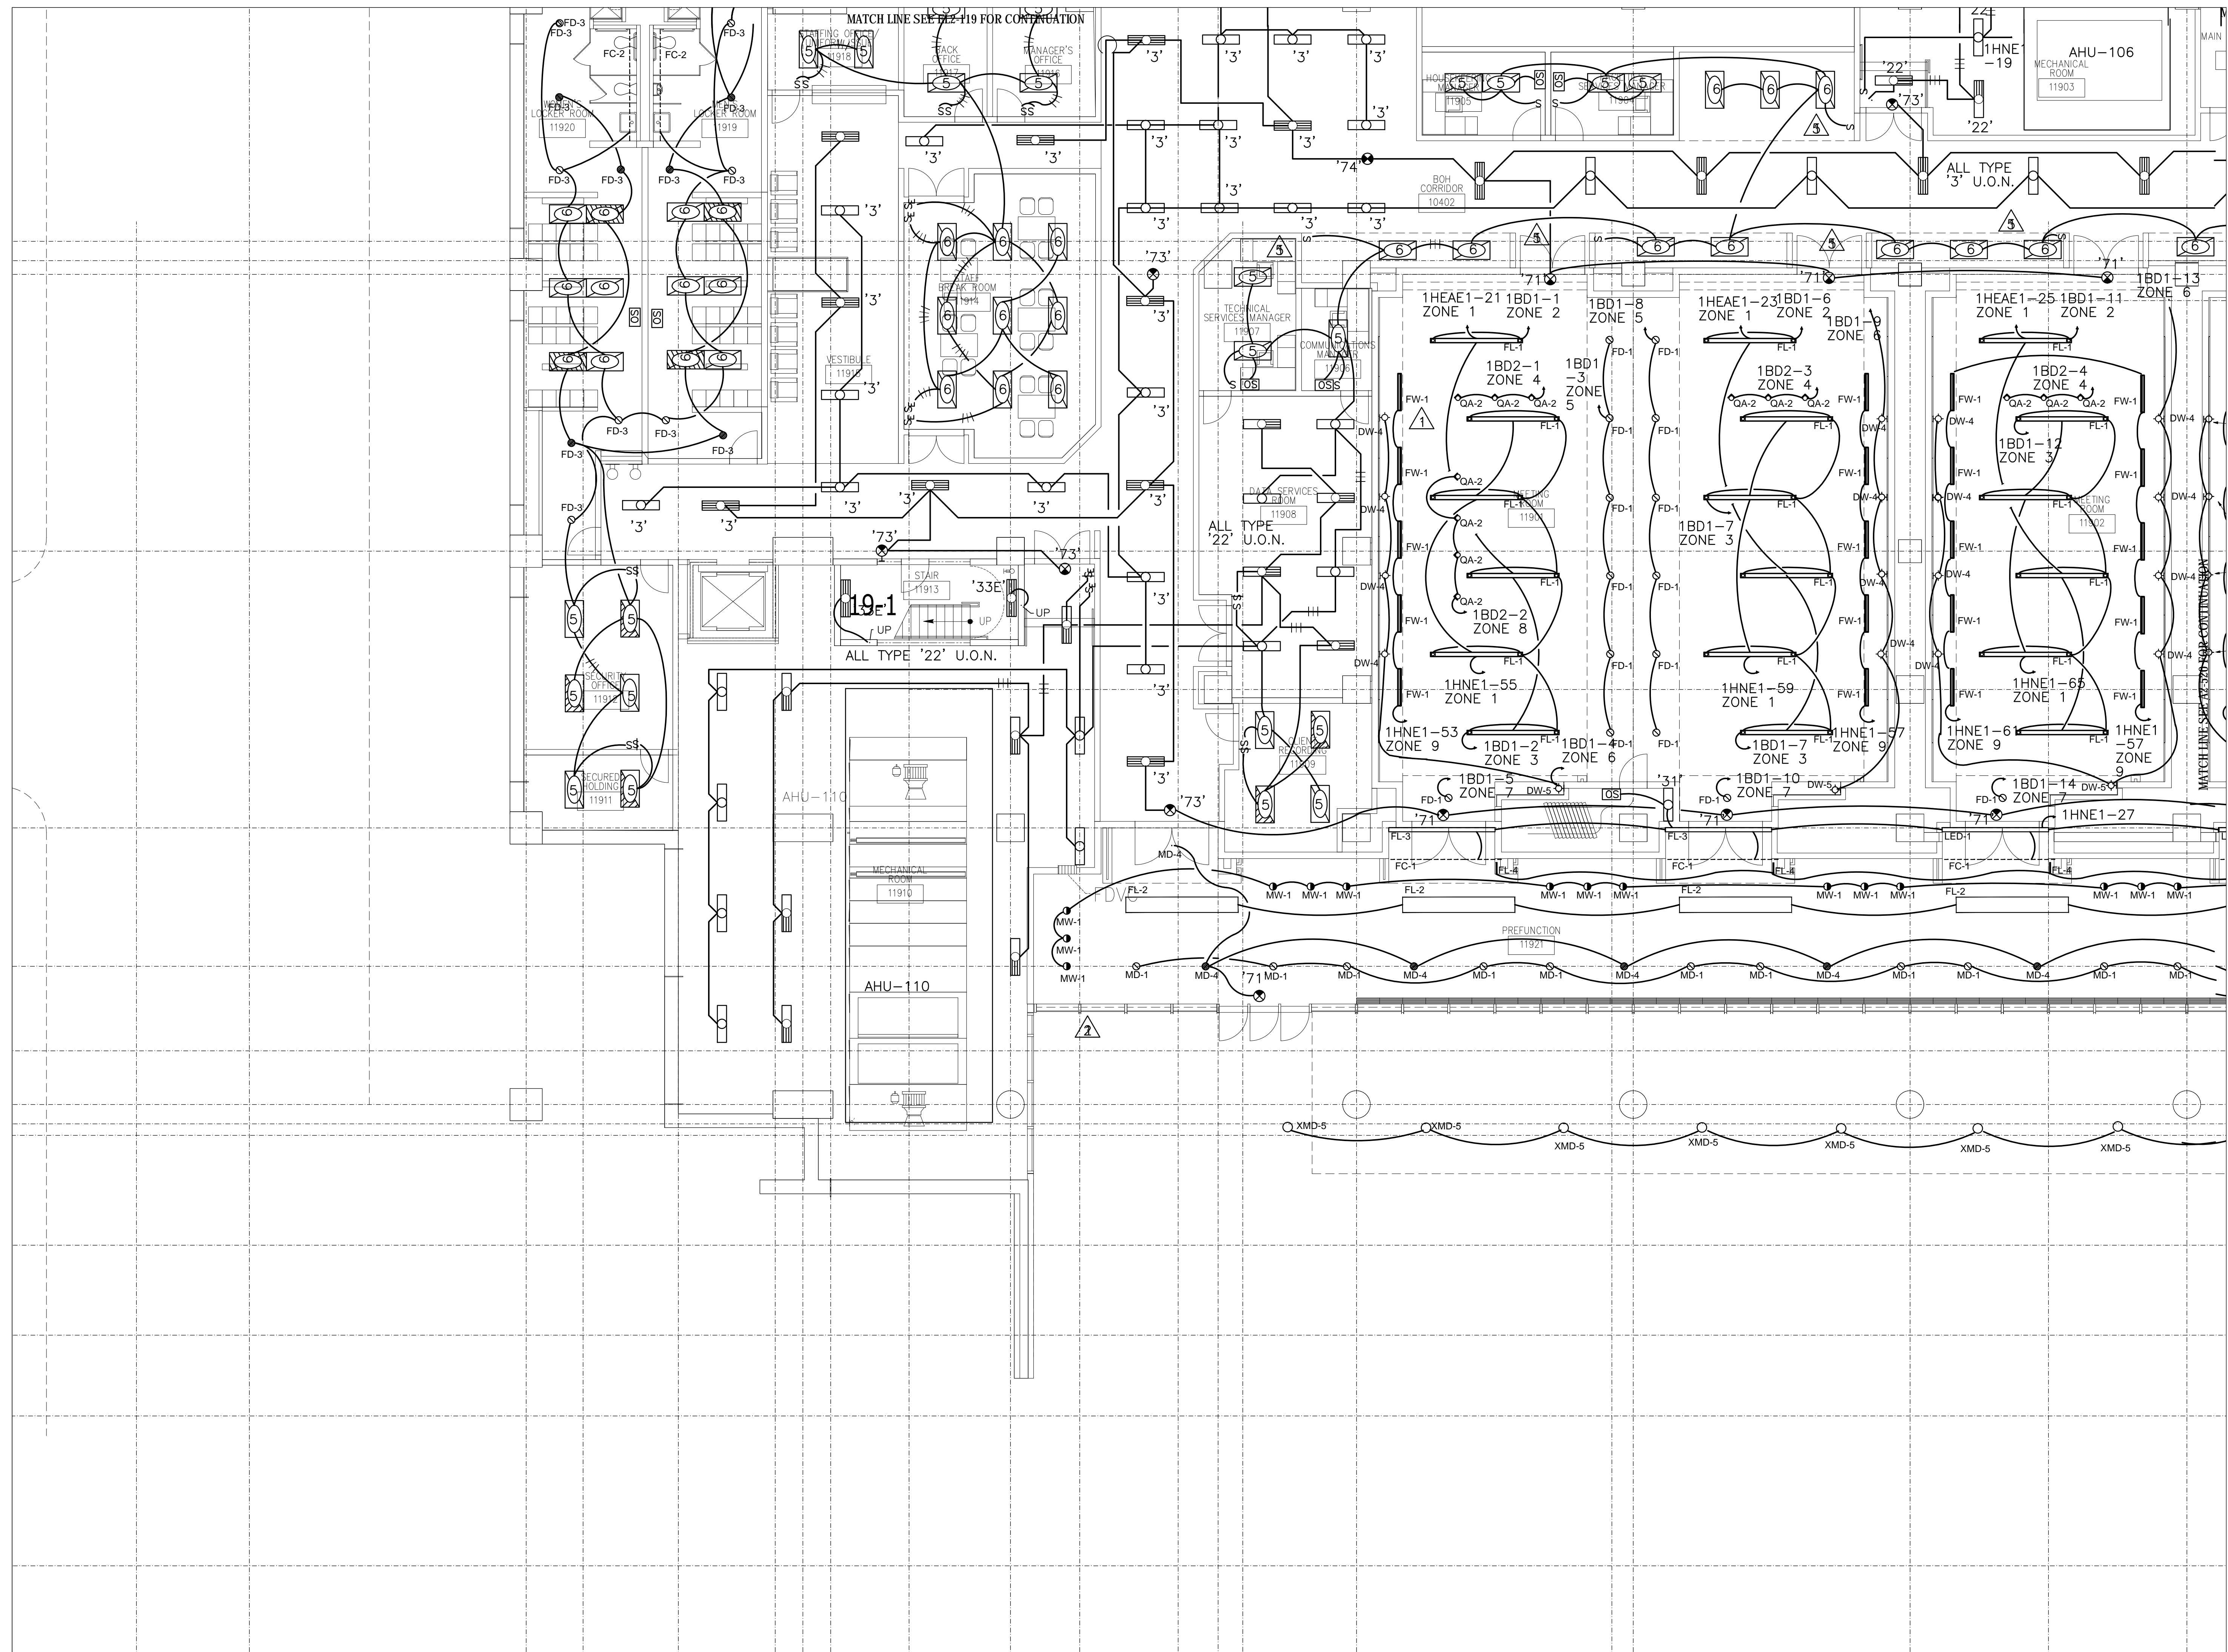




DEMONEBREM

01	02	03	04		
05	06	07	08	09	10
11	12	13	14	15	16
17	18	19	20		


KOREAN VETERANS BLVD  
 KEY PLAN  
 NO SCALE

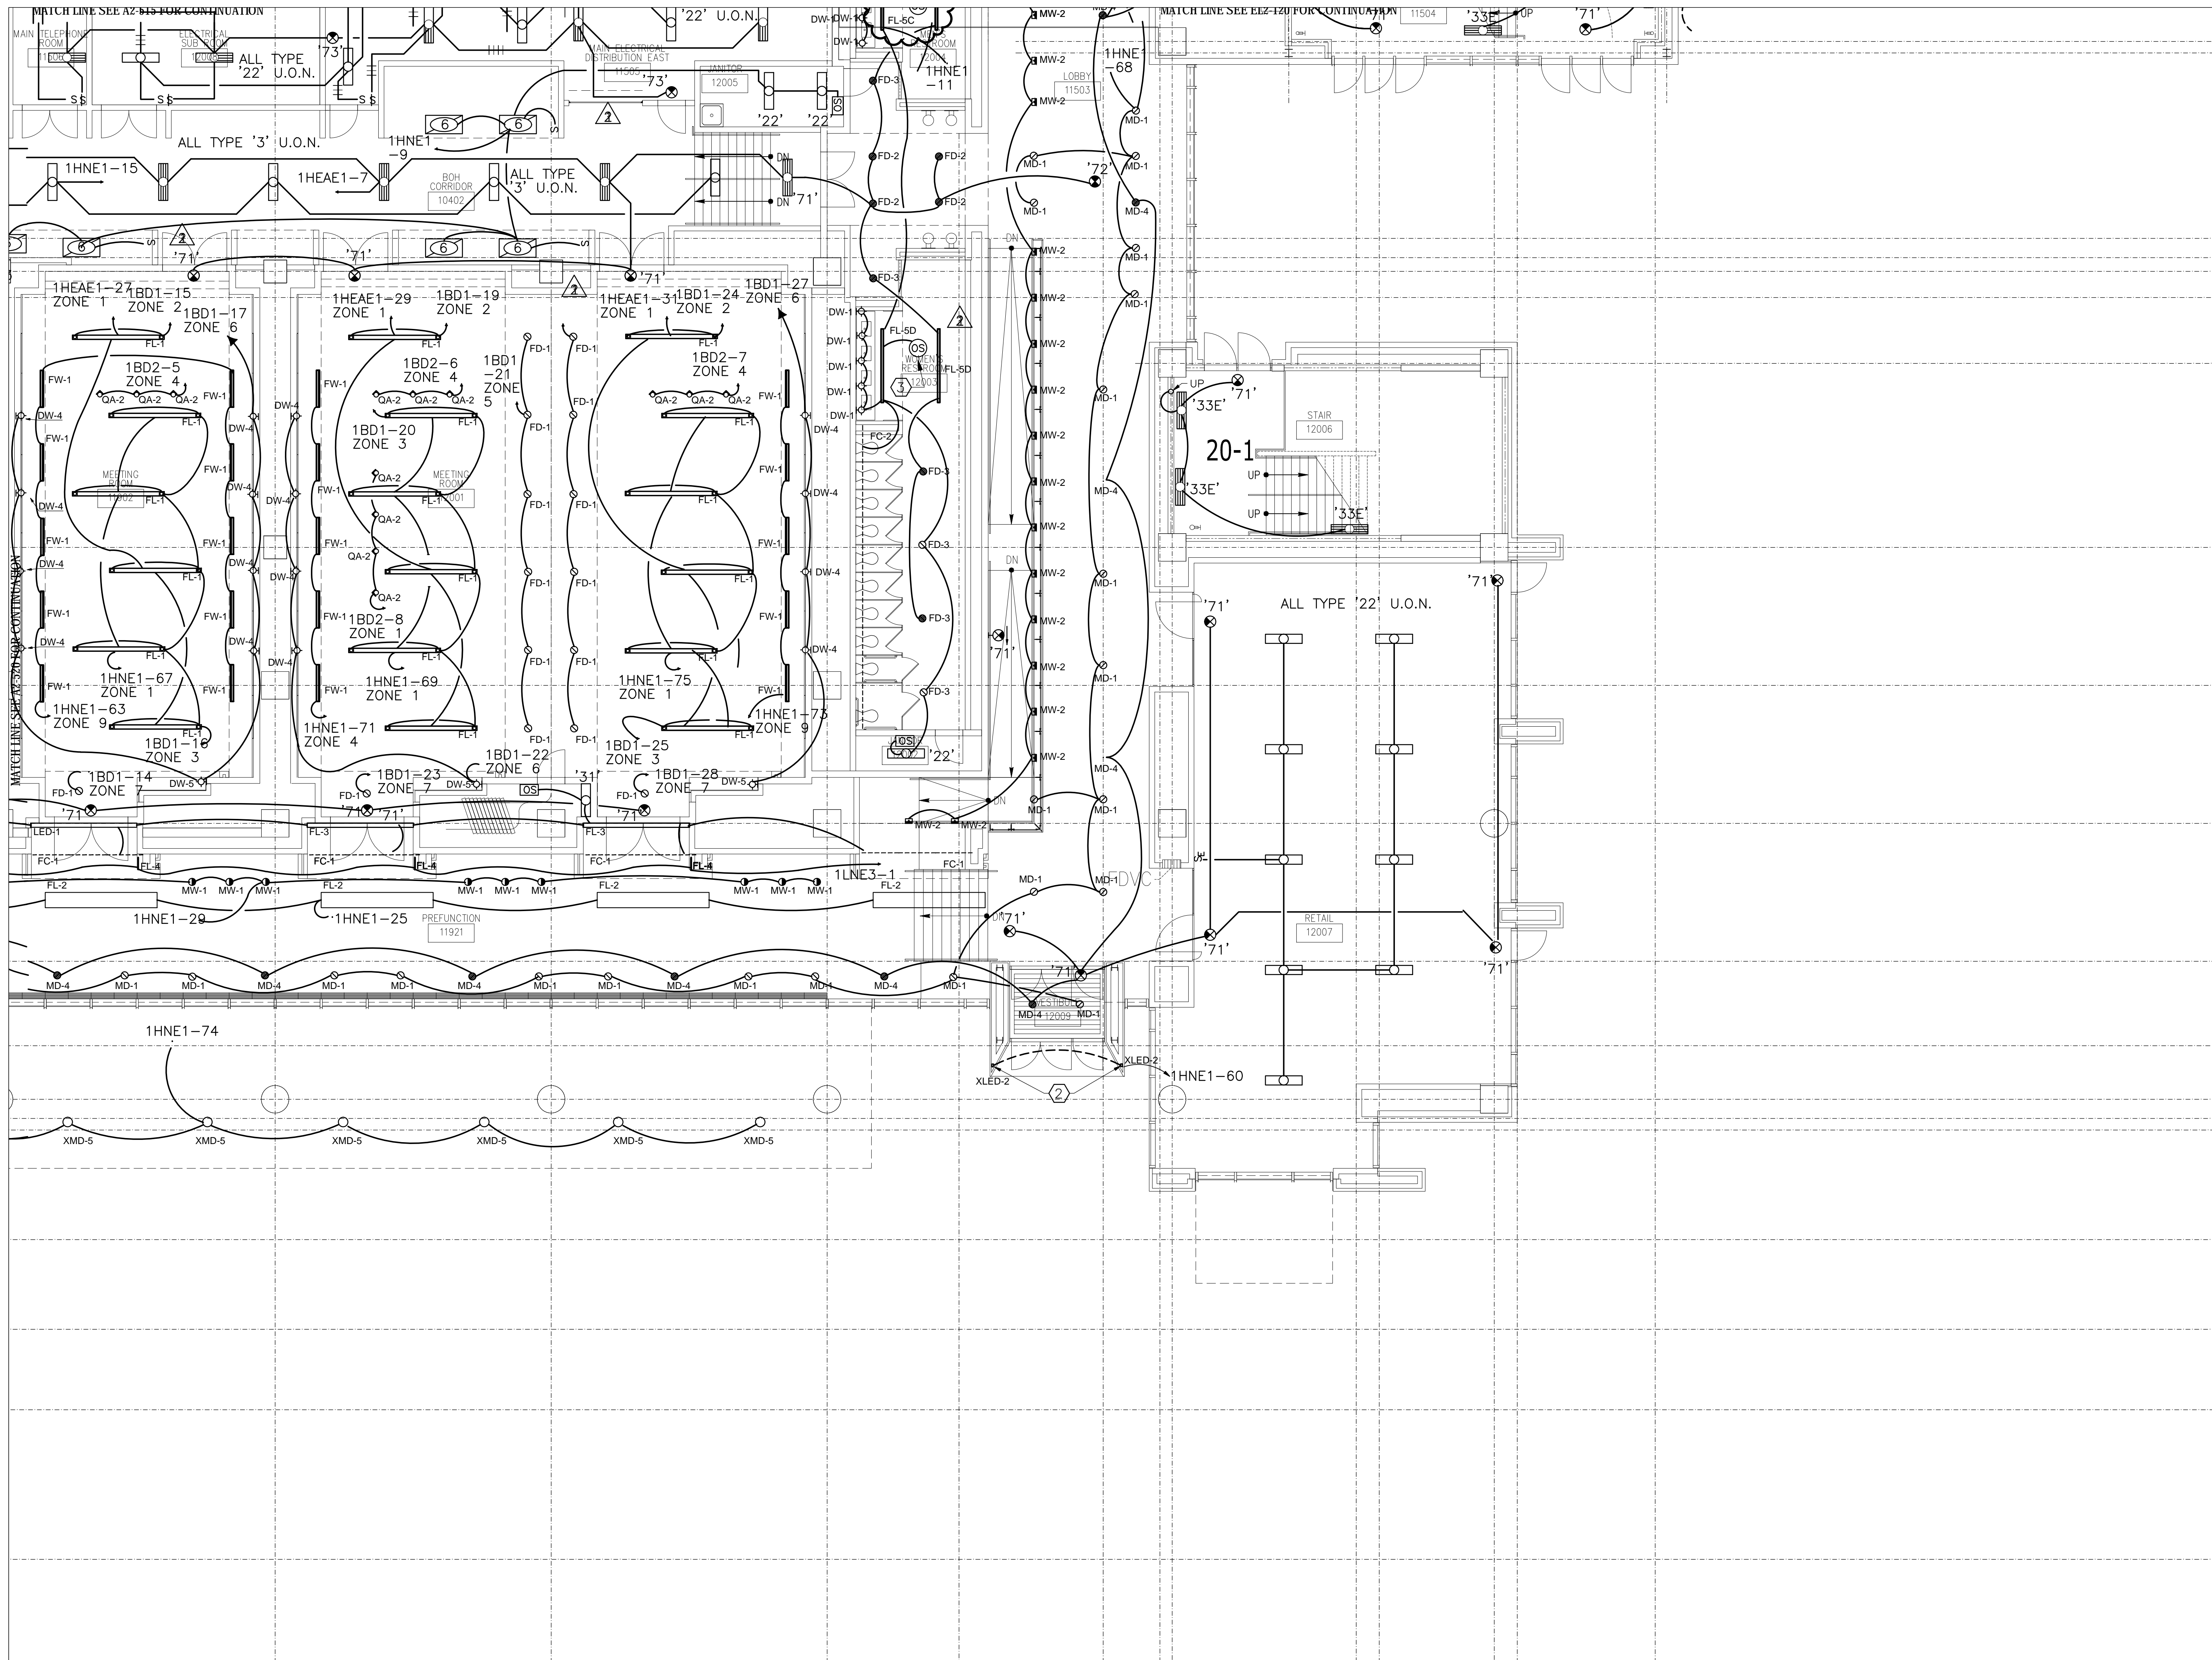

COORDINATION SIGN-OFF

COMPANY	TRADE	DATE
CONTI	ELEC.	

**Music City Center**  
 Nashville, Tennessee

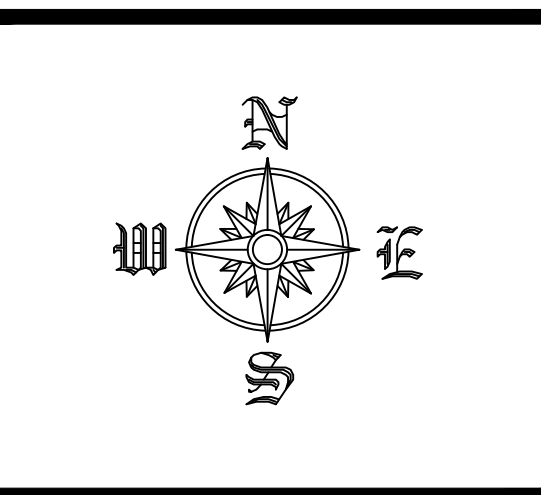

REVISIONS

NO.	DATE	DESCRIPTION

RECORD DRAWINGS STAMP

CONTI ELECTRIC DATE (Last Update):  
 6/4/2012 BOP M1

DRAWING FILE NAME:  
 E20-19

CAD OPERATOR:  
 GERTMAN

PRINTED BY:  
 FREEMAN, GREGG

PLOT DATE:  
 6/4/2012 BOP M1

SUBMITTED BY:  
 G.L.F.

ASSIGNED TO:

LEVEL 1 LIGHTING  
 ZONE 20  
 SCALE: 1/8" = 1'-0"