


COORDINATION SIGN-OFF

COMPANY	TRADE	DATE
CONTI	ELEC.	/ /
		/ /
		/ /
Music City Center
 Nashville, Tennessee

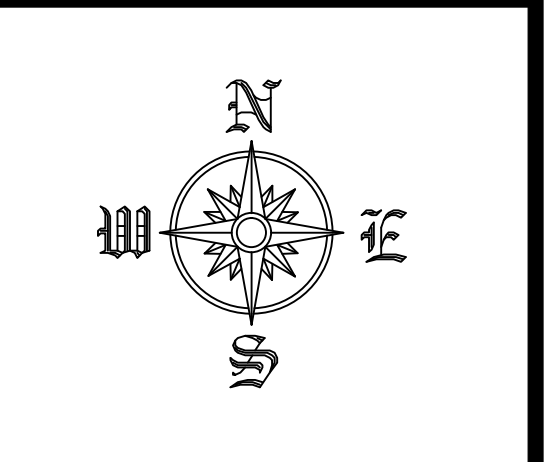

REVISIONS



NO.	DATE	DESCRIPTION

RECORD DRAWINGS STAMP

CONTI ELECTRIC DATE (Last Update): 2/21/2012 12:44 PM
 DRAWING FILE NAME: E22-202
 CAD OPERATOR: GERTMAN
 PRINTED BY: FREDMAN, GREG
 PLOT DATE: 2/21/2012 2:29 PM
 SUBMITTED BY: G.P.
 ASSIGNED TO:

LEVEL 2 LIGHTING
 ZONE 2
 SCALE: 1/8" = 1'-0"


EL2-202

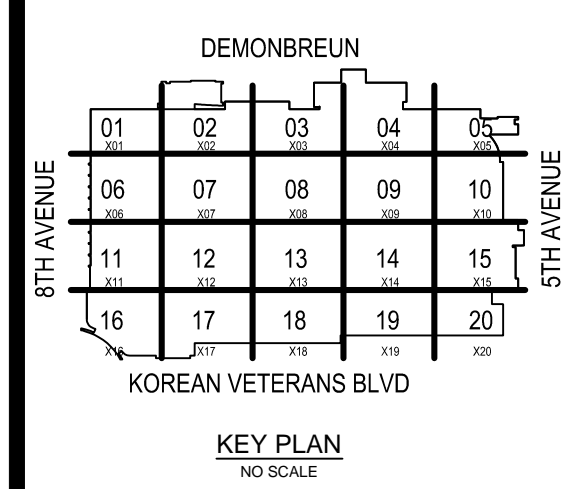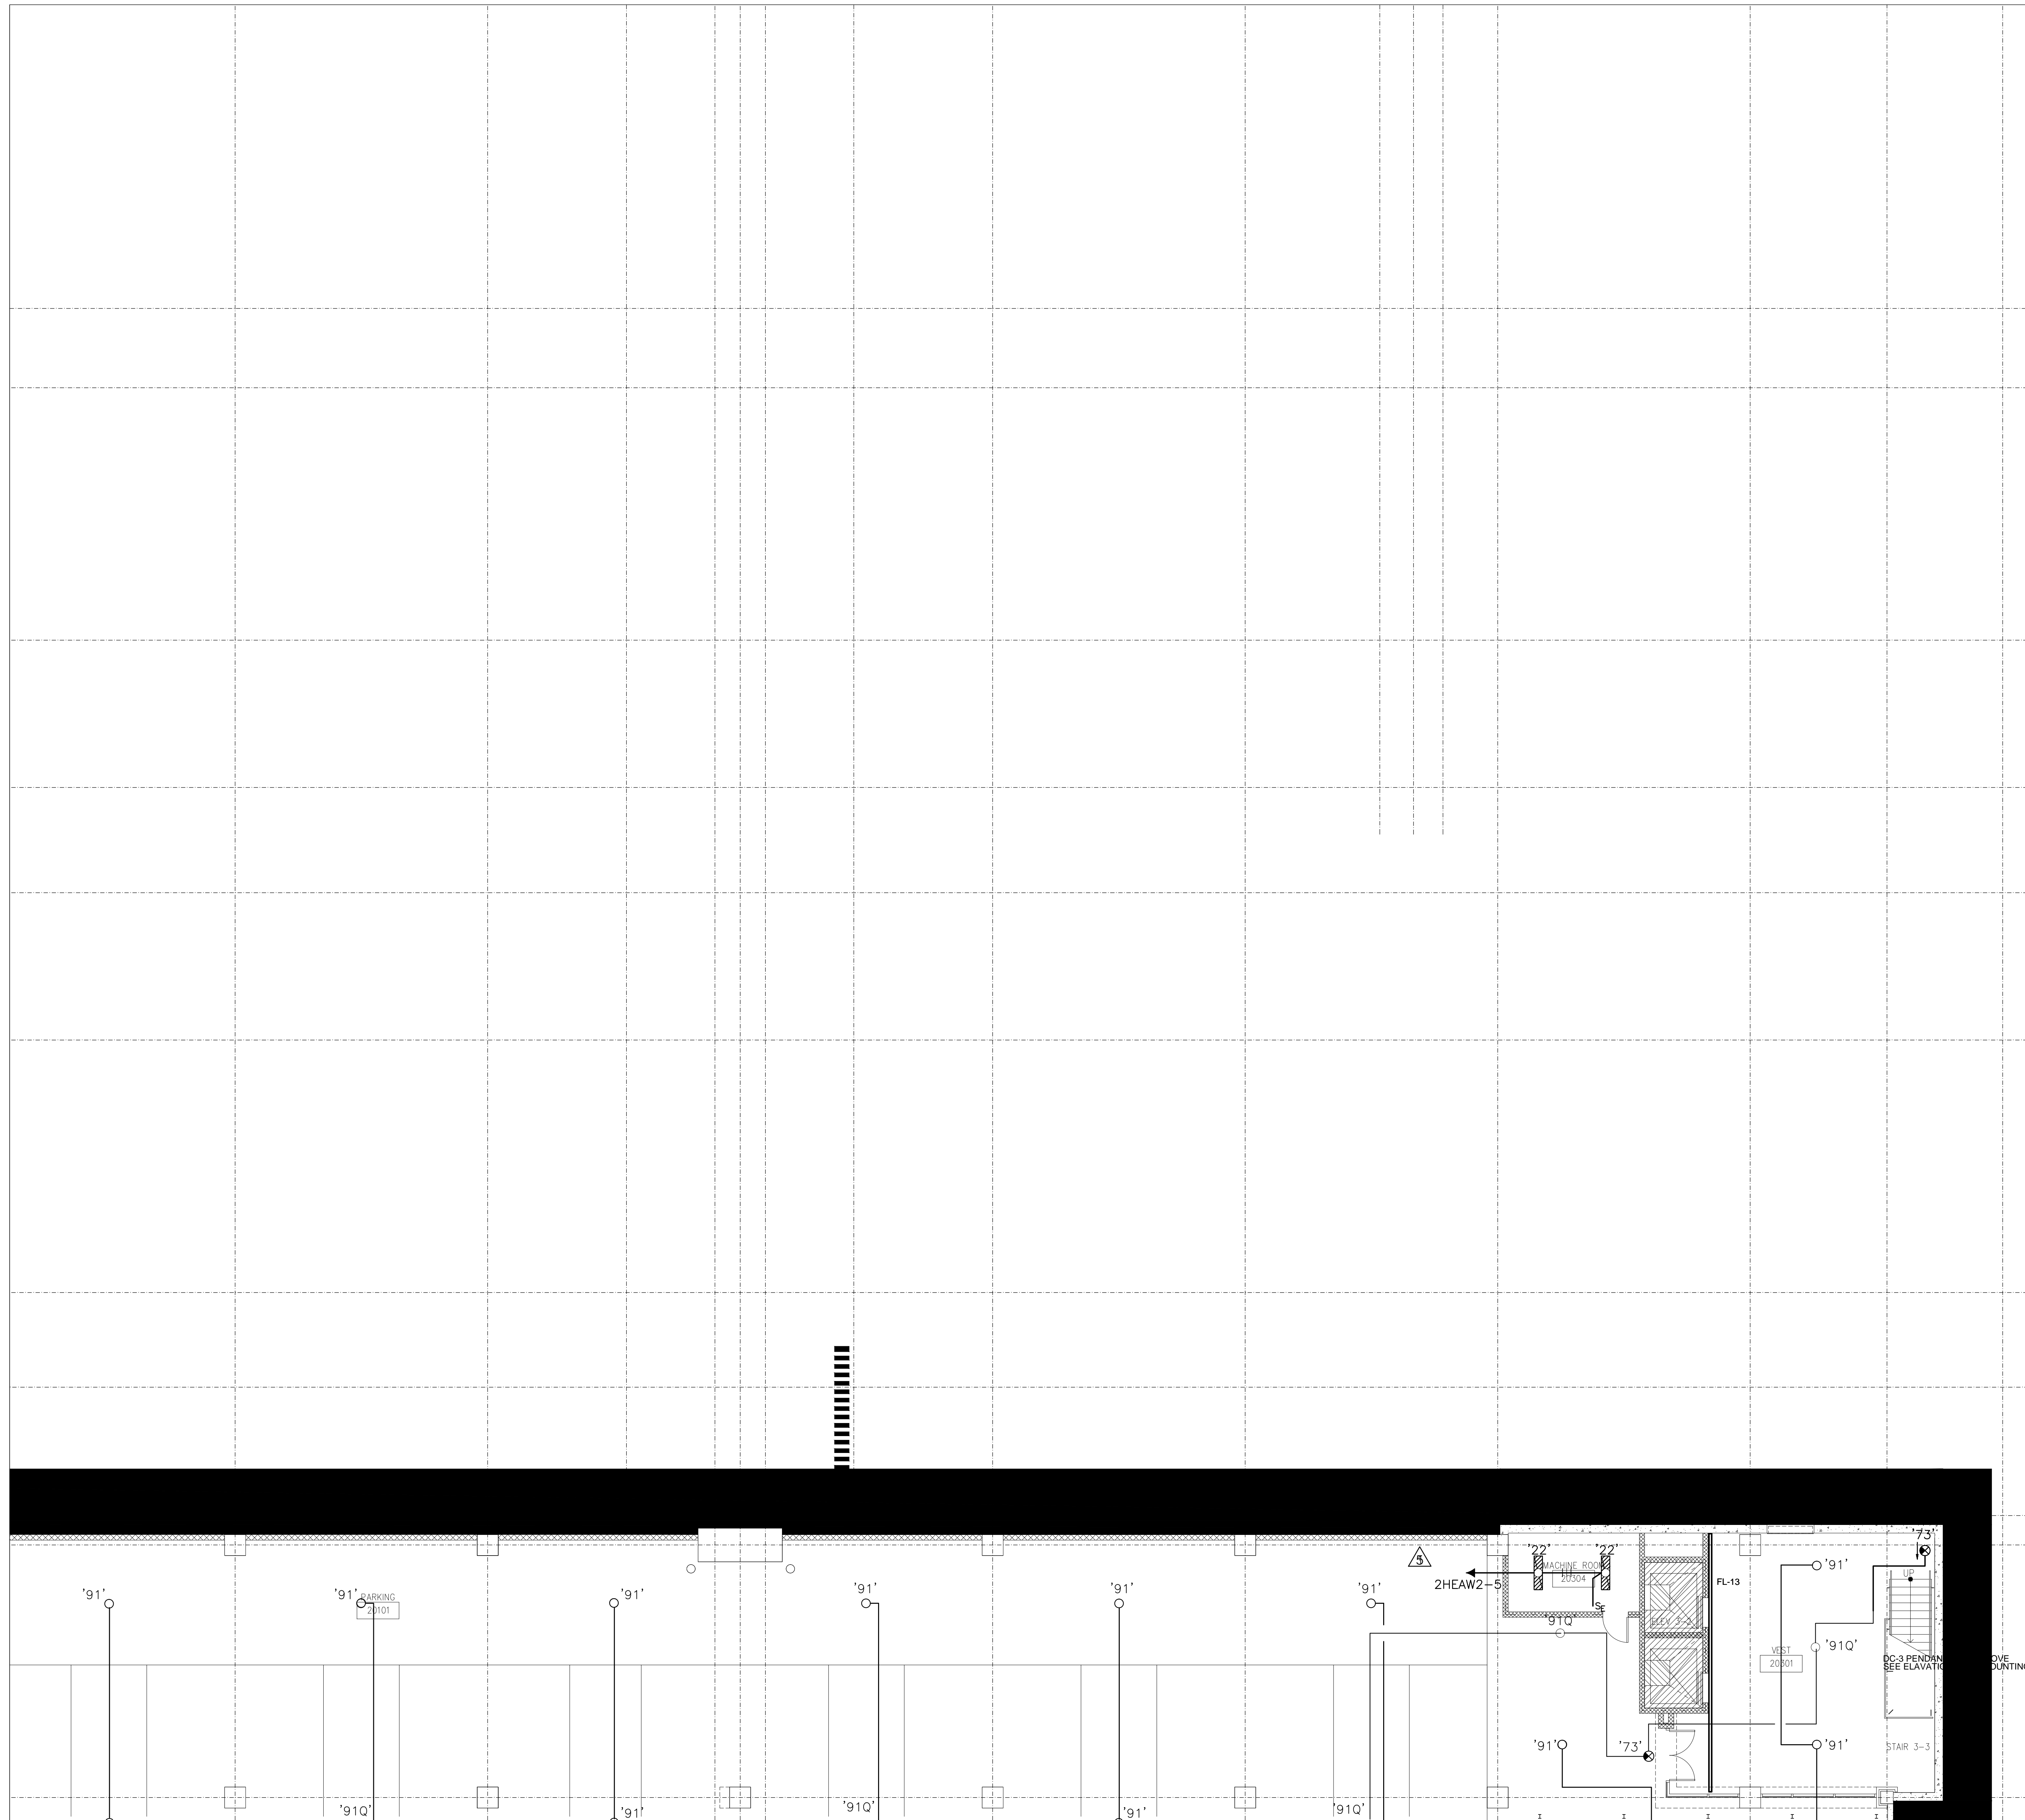

COORDINATION SIGN-OFF

COMPANY	TRADE	DATE
CONTI	ELEC.	

Music City Center
 Nashville, Tennessee

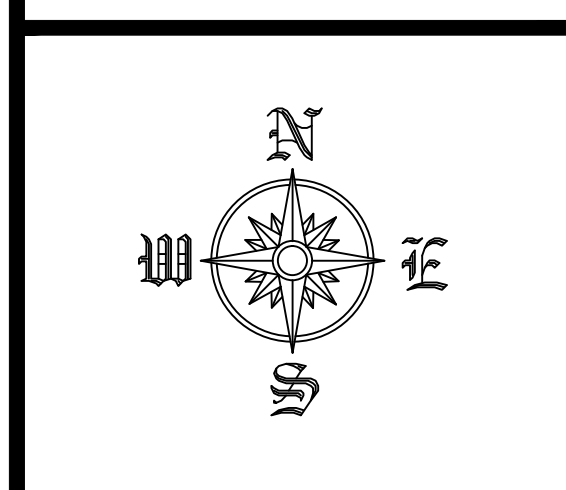

REVISIONS

NO.	DATE	DESCRIPTION



RECORD DRAWINGS STAMP

CONTI ELECTRIC DATE (Last Update): 2/21/2012 12:44 PM
 DRAWING FILE NAME: E22-203
 CAD OPERATOR: GREGG
 PRINTED BY: GREGG
 PLOT DATE: 2/21/2012 2:29 PM
 SUBMITTED BY: GREGG
 ASSIGNED TO: GREGG

LEVEL 2 LIGHTING
 ZONE 3
 SCALE: 1/8" = 1'-0"


EL2-203

FILE PATH FOR CAD OPERATOR USE ONLY: P:\2008\Conti Electric\Nashville MusicCity\Conti - 203\EL2-203.dwg 2/21/2012 2:29 PM

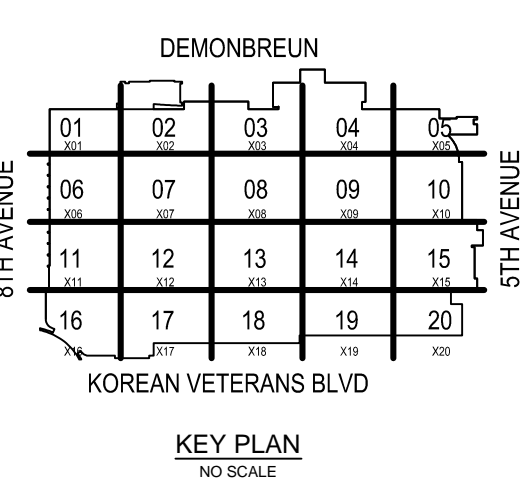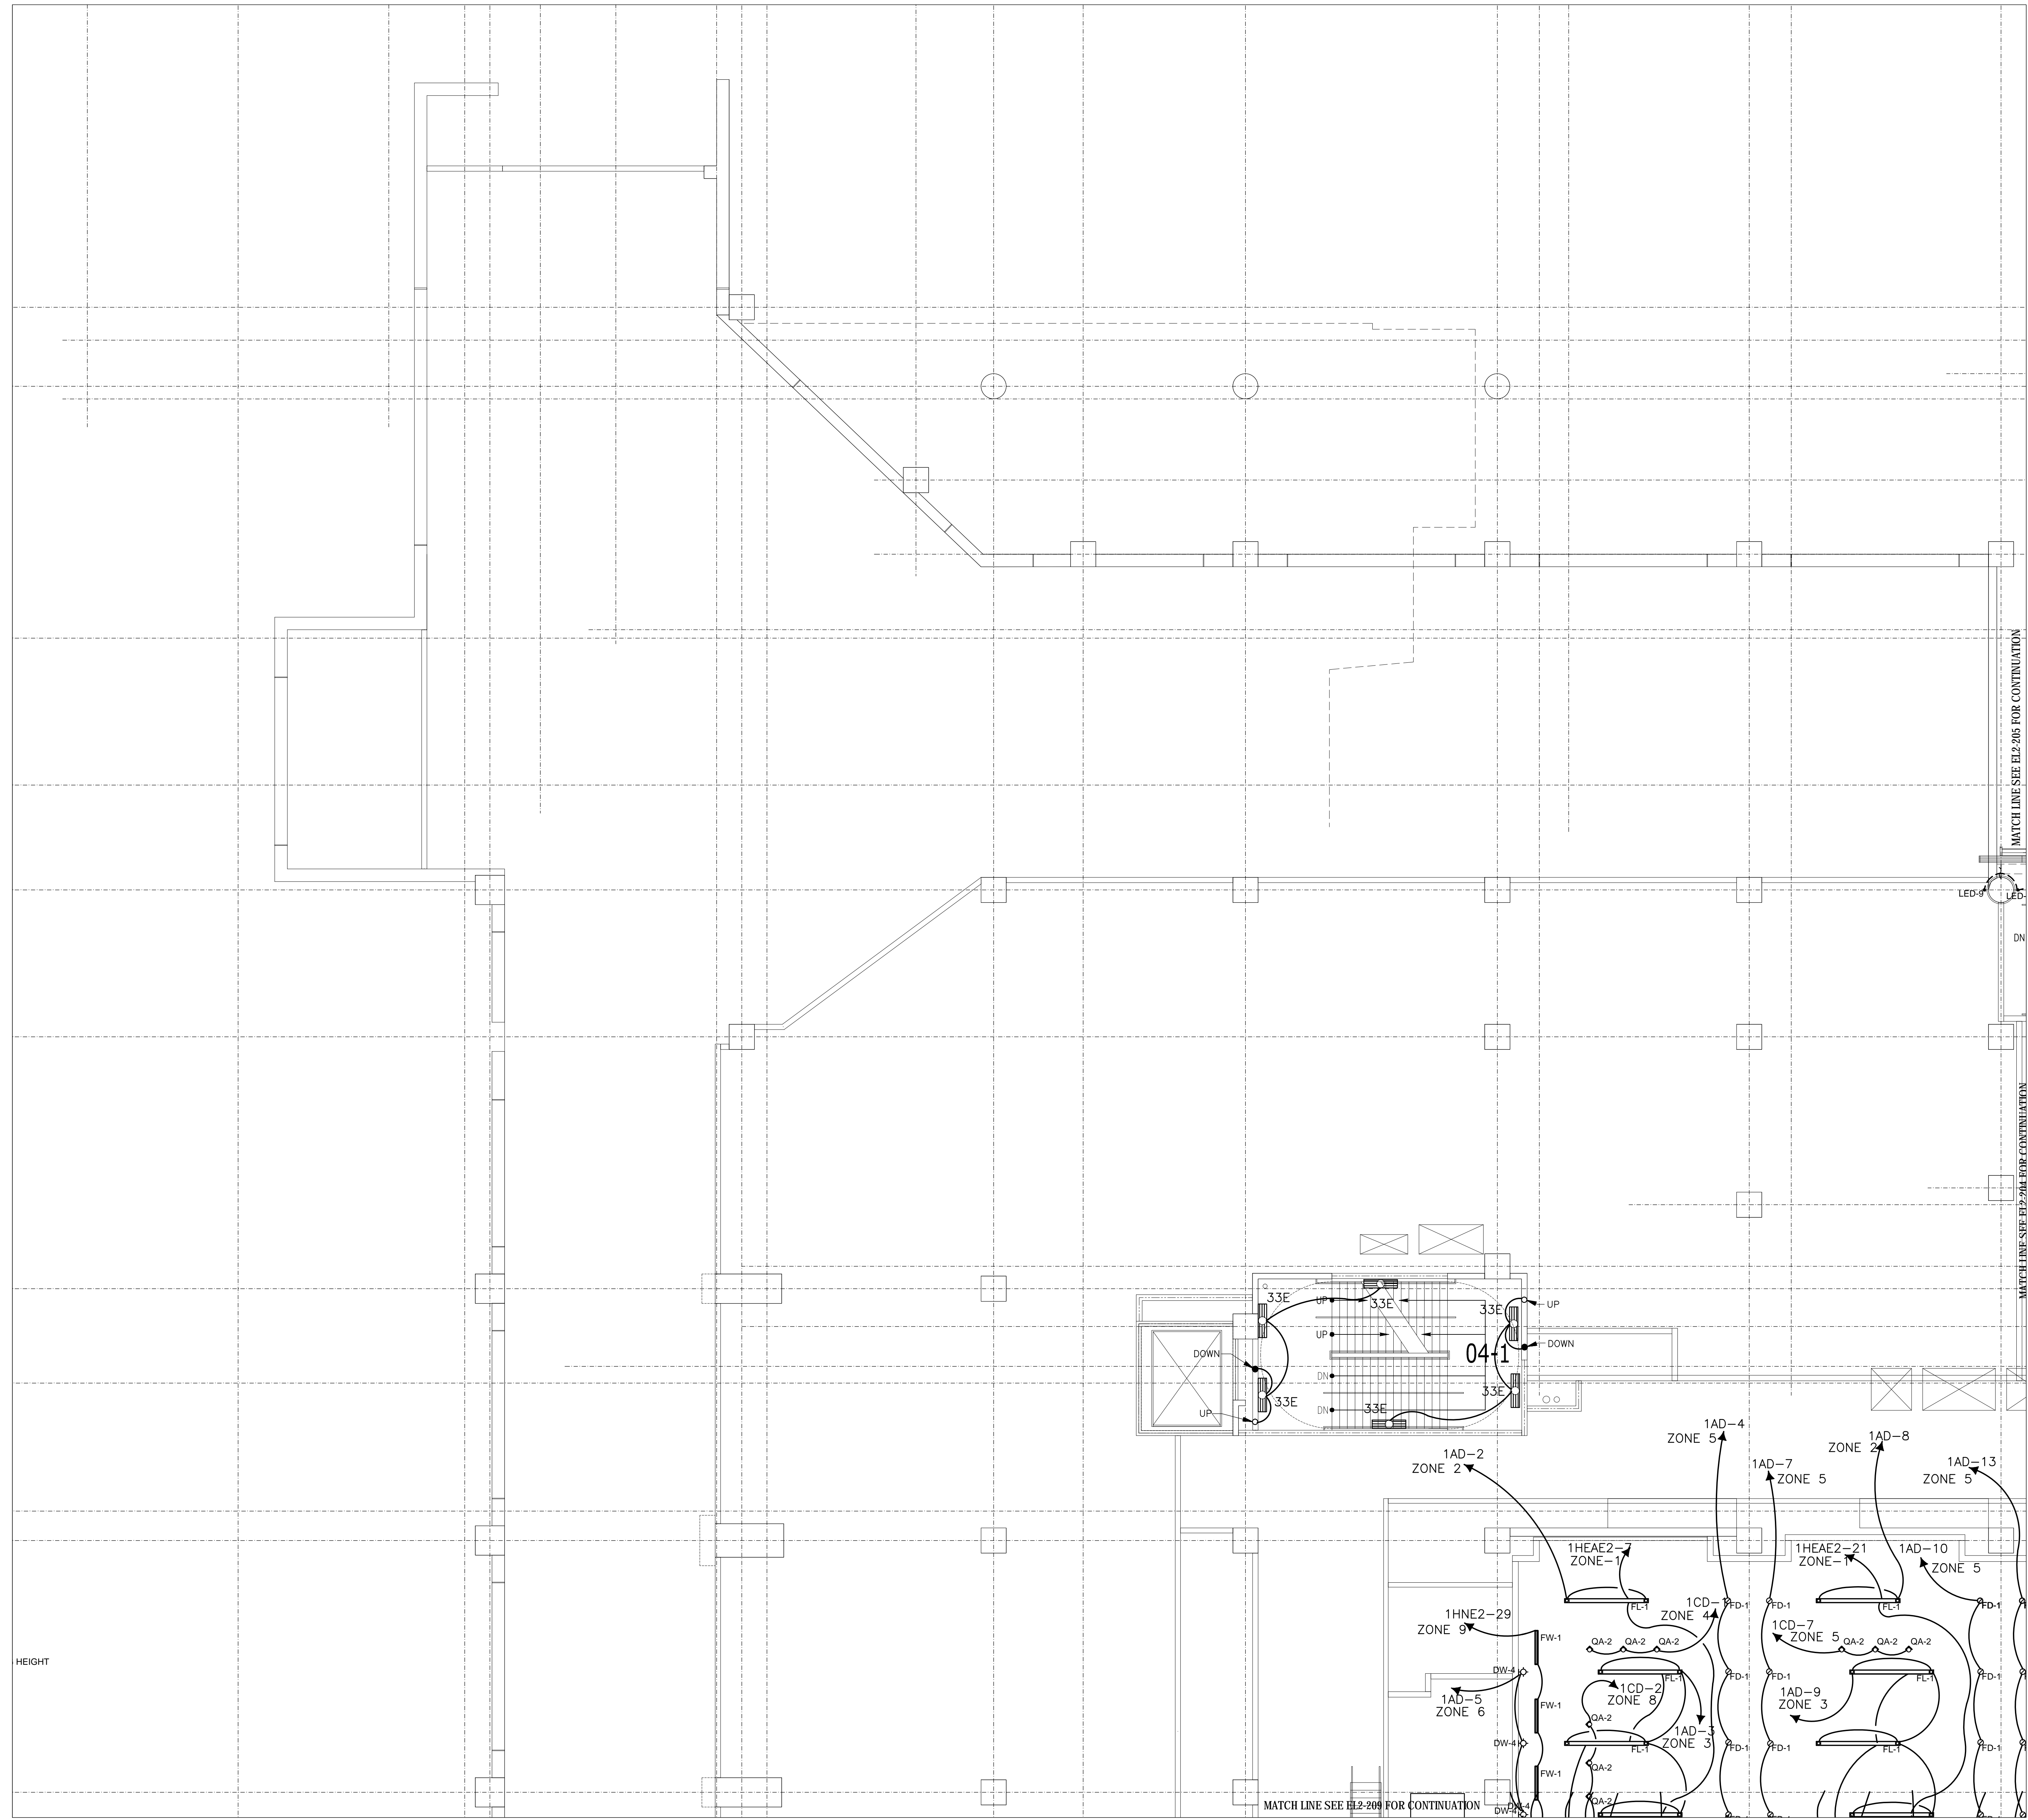

COMPANY	TRADE	NAME	DATE				
			1	2	3	4	5
CONTI	ELEC.		/	/	/	/	/

Music City Center
 Nashville, Tennessee

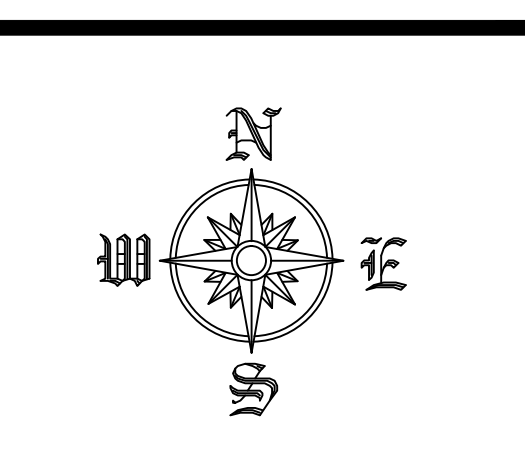


REVISIONS		
NO.	DATE	DESCRIPTION

RECORD DRAWINGS STAMP

CONTELECTRIC DATE (Last Update): 2/21/2012 2:29 PM
 DRAWING FILE NAME: E2-204
 CAD OPERATOR: GERRMAN
 PRINTED BY: FREDMAN, GREG
 PLOT DATE: 2/21/2012 2:29 PM
 SUBMITTED BY: GLF
 ASSIGNED TO:

LEVEL 2 LIGHTING
 ZONE 4
 SCALE: 1/8" = 1'-0"


EL2-204

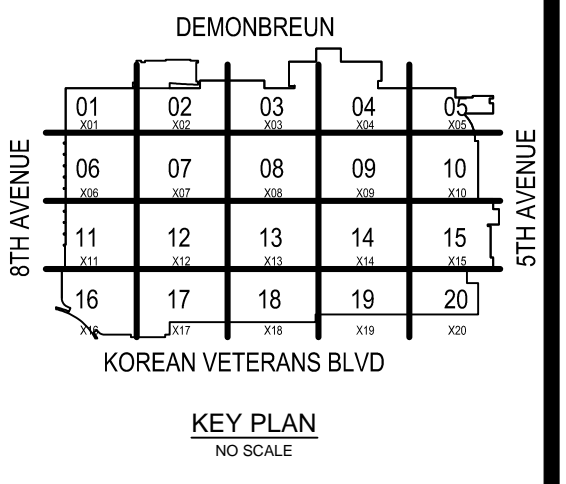

COORDINATION SIGN-OFF

COMPANY	TRADE	DATE
CONTI	ELEC.	/ /
		/ /
		/ /
Music City Center
 Nashville, Tennessee

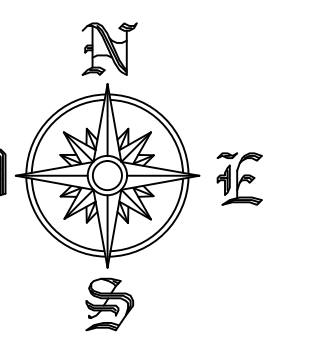

REVISIONS

NO.	DATE	DESCRIPTION

RECORD DRAWINGS STAMP

CONTI ELECTRIC DATE (Last Update):
 2/21/2012 12:44 PM

DRAWING FILE NAME:
 EL2-205


CAD OPERATOR:
 GERRMAN

PRINTED BY:
 FREDMAN, GREGG

PLOT DATE:
 2/21/2012 2:29 PM

SUBMITTED BY:
 G.L.P.


ASSIGNED TO:

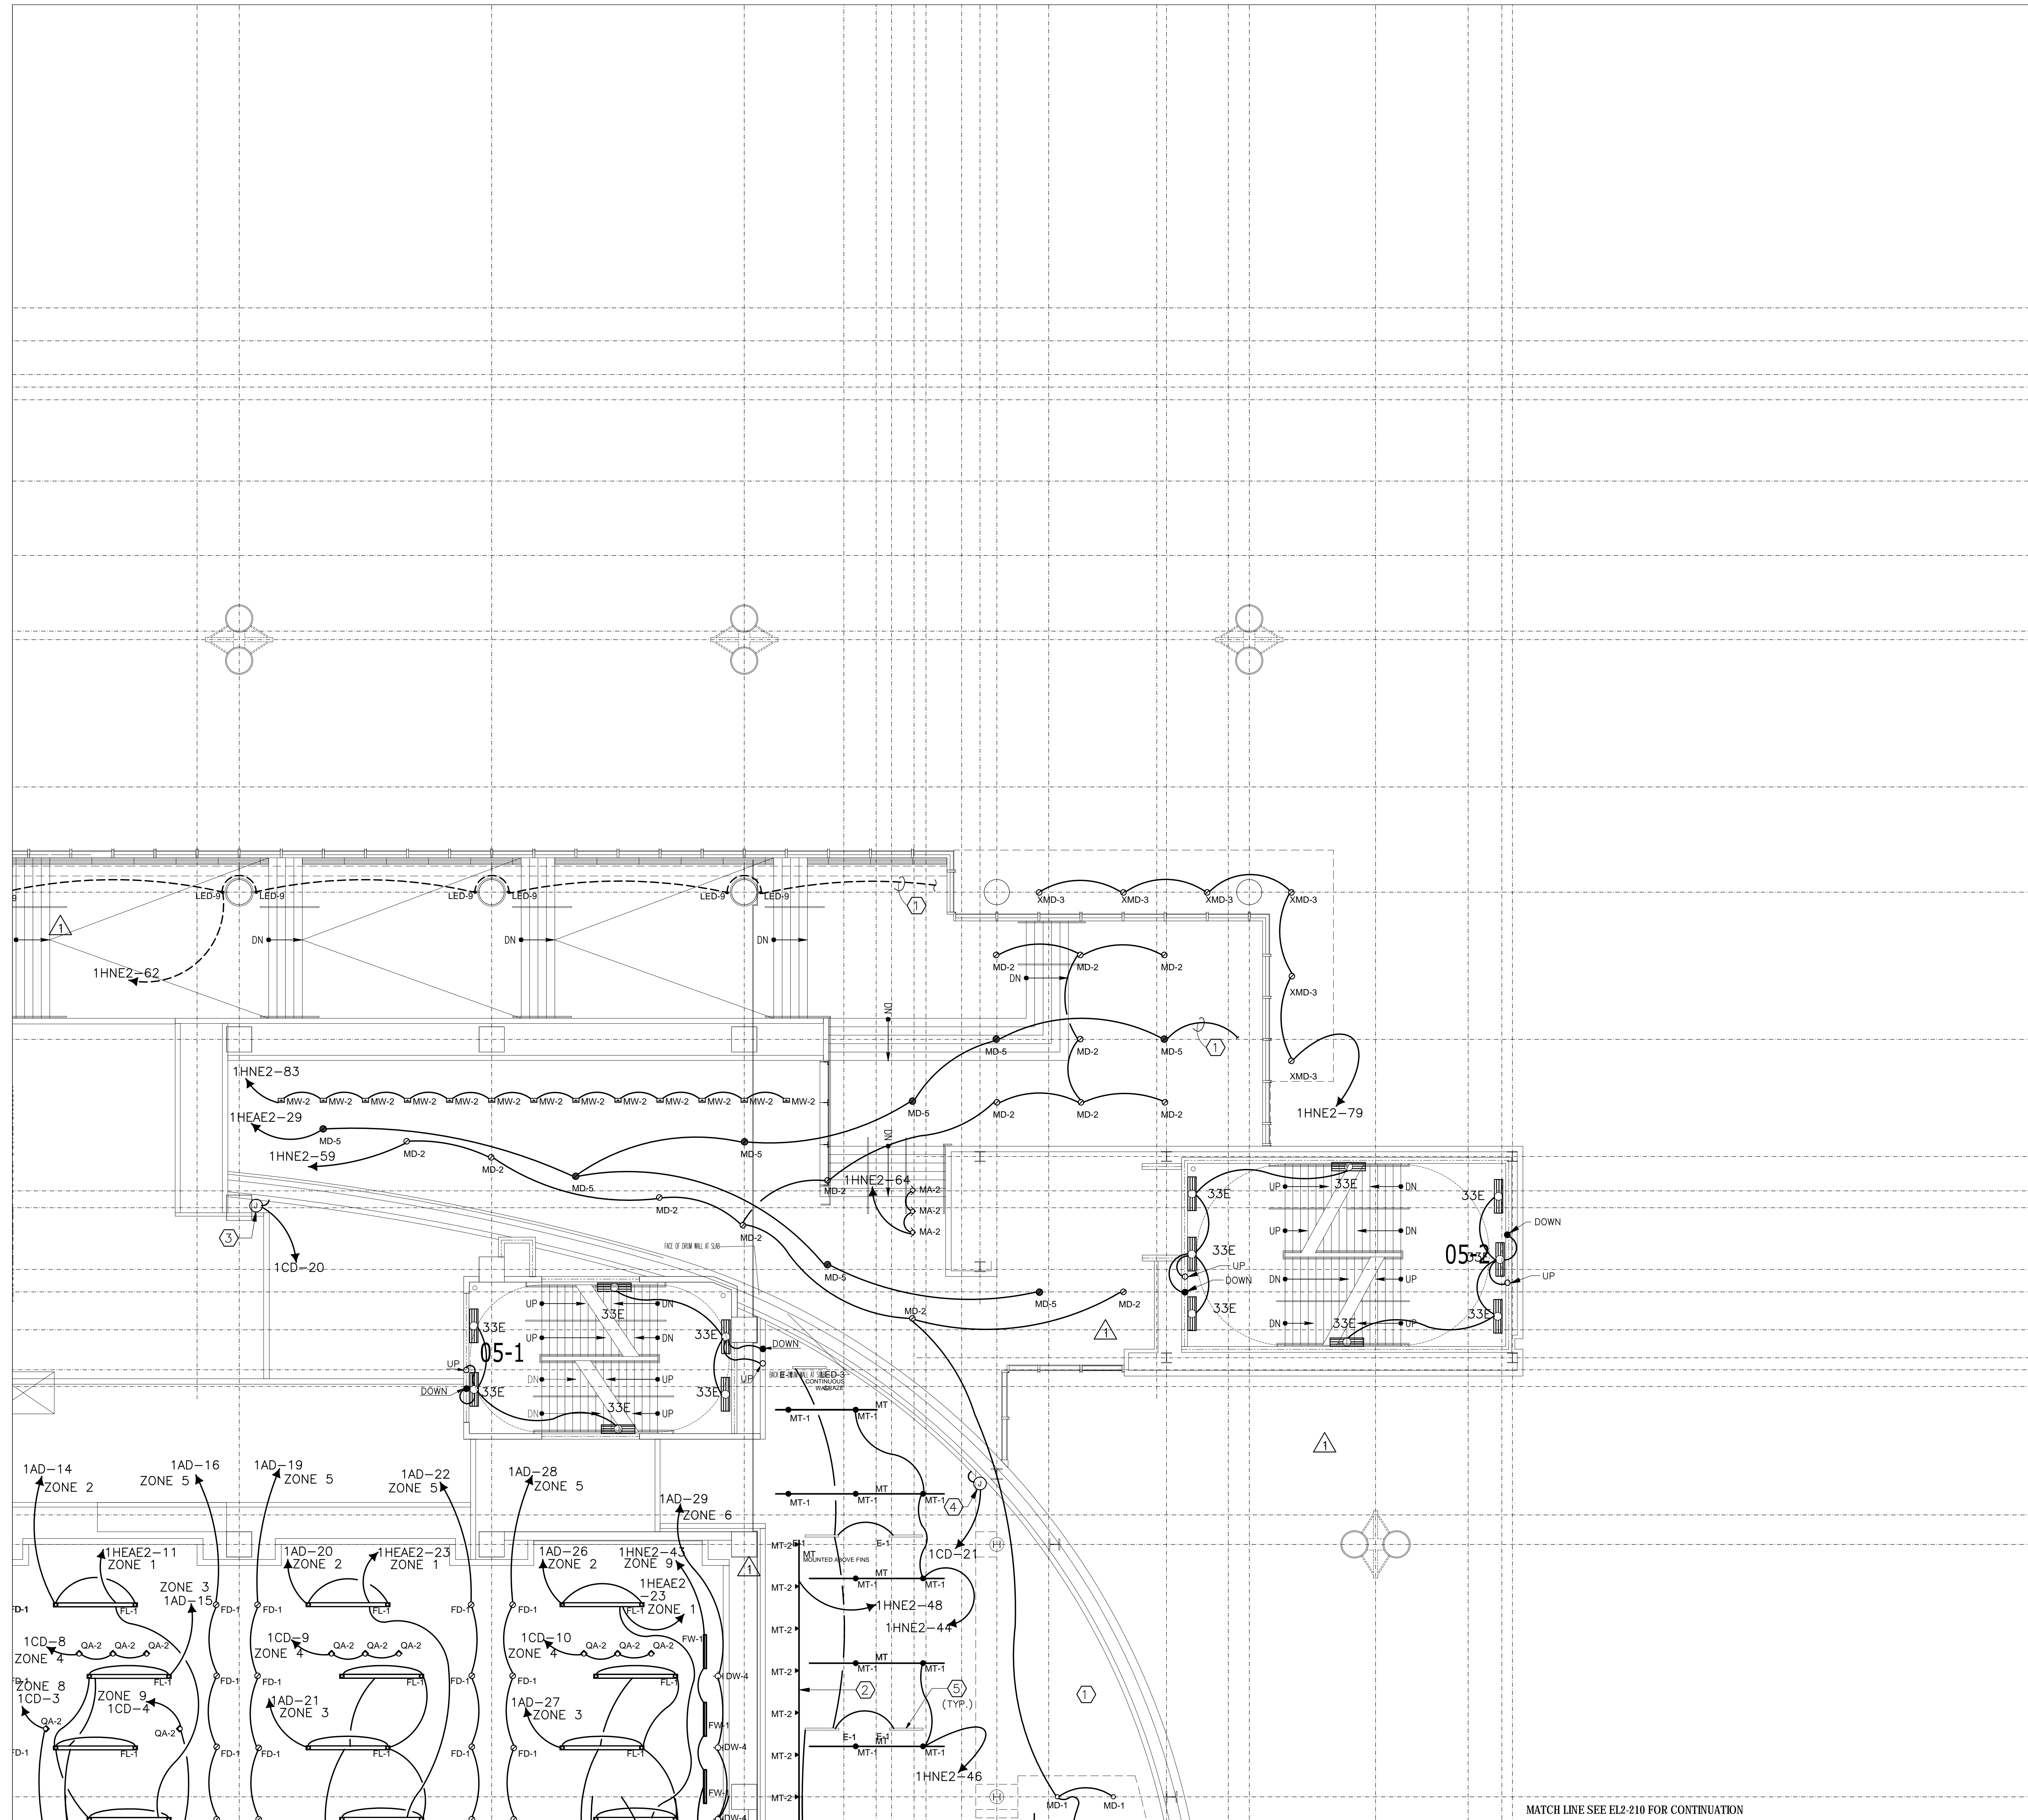

MATCH LINE SEE EL2-210 FOR CONTINUATION

LEVEL 2 LIGHTING
 ZONE 5
 SCALE: 1/8" = 1'-0"


EL2-205

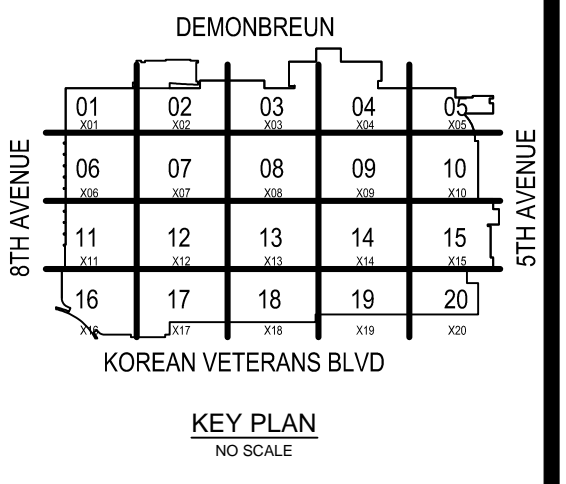

COORDINATION SIGN-OFF

COMPANY	TRADE	DATE
CONTI	ELEC.	/ /
		/ /
		/ /
Music City Center
 Nashville, Tennessee

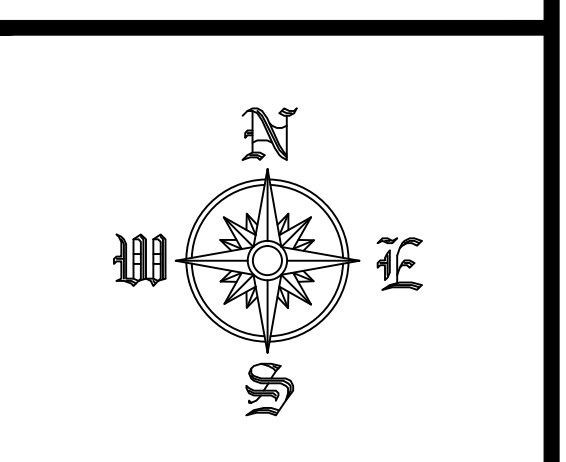


REVISIONS

NO.	DATE	DESCRIPTION


RECORD DRAWINGS STAMP

CONTI ELECTRIC DATE (Last Update): 2/21/2012 12:44 PM
 DRAWING FILE NAME: E2-207
 CAD OPERATOR: GERTMAN
 PRINTED BY: FREDMAN, GREG
 PLOT DATE: 2/21/2012 2:29 PM
 SUBMITTED BY: G.P.
 ASSIGNED TO:

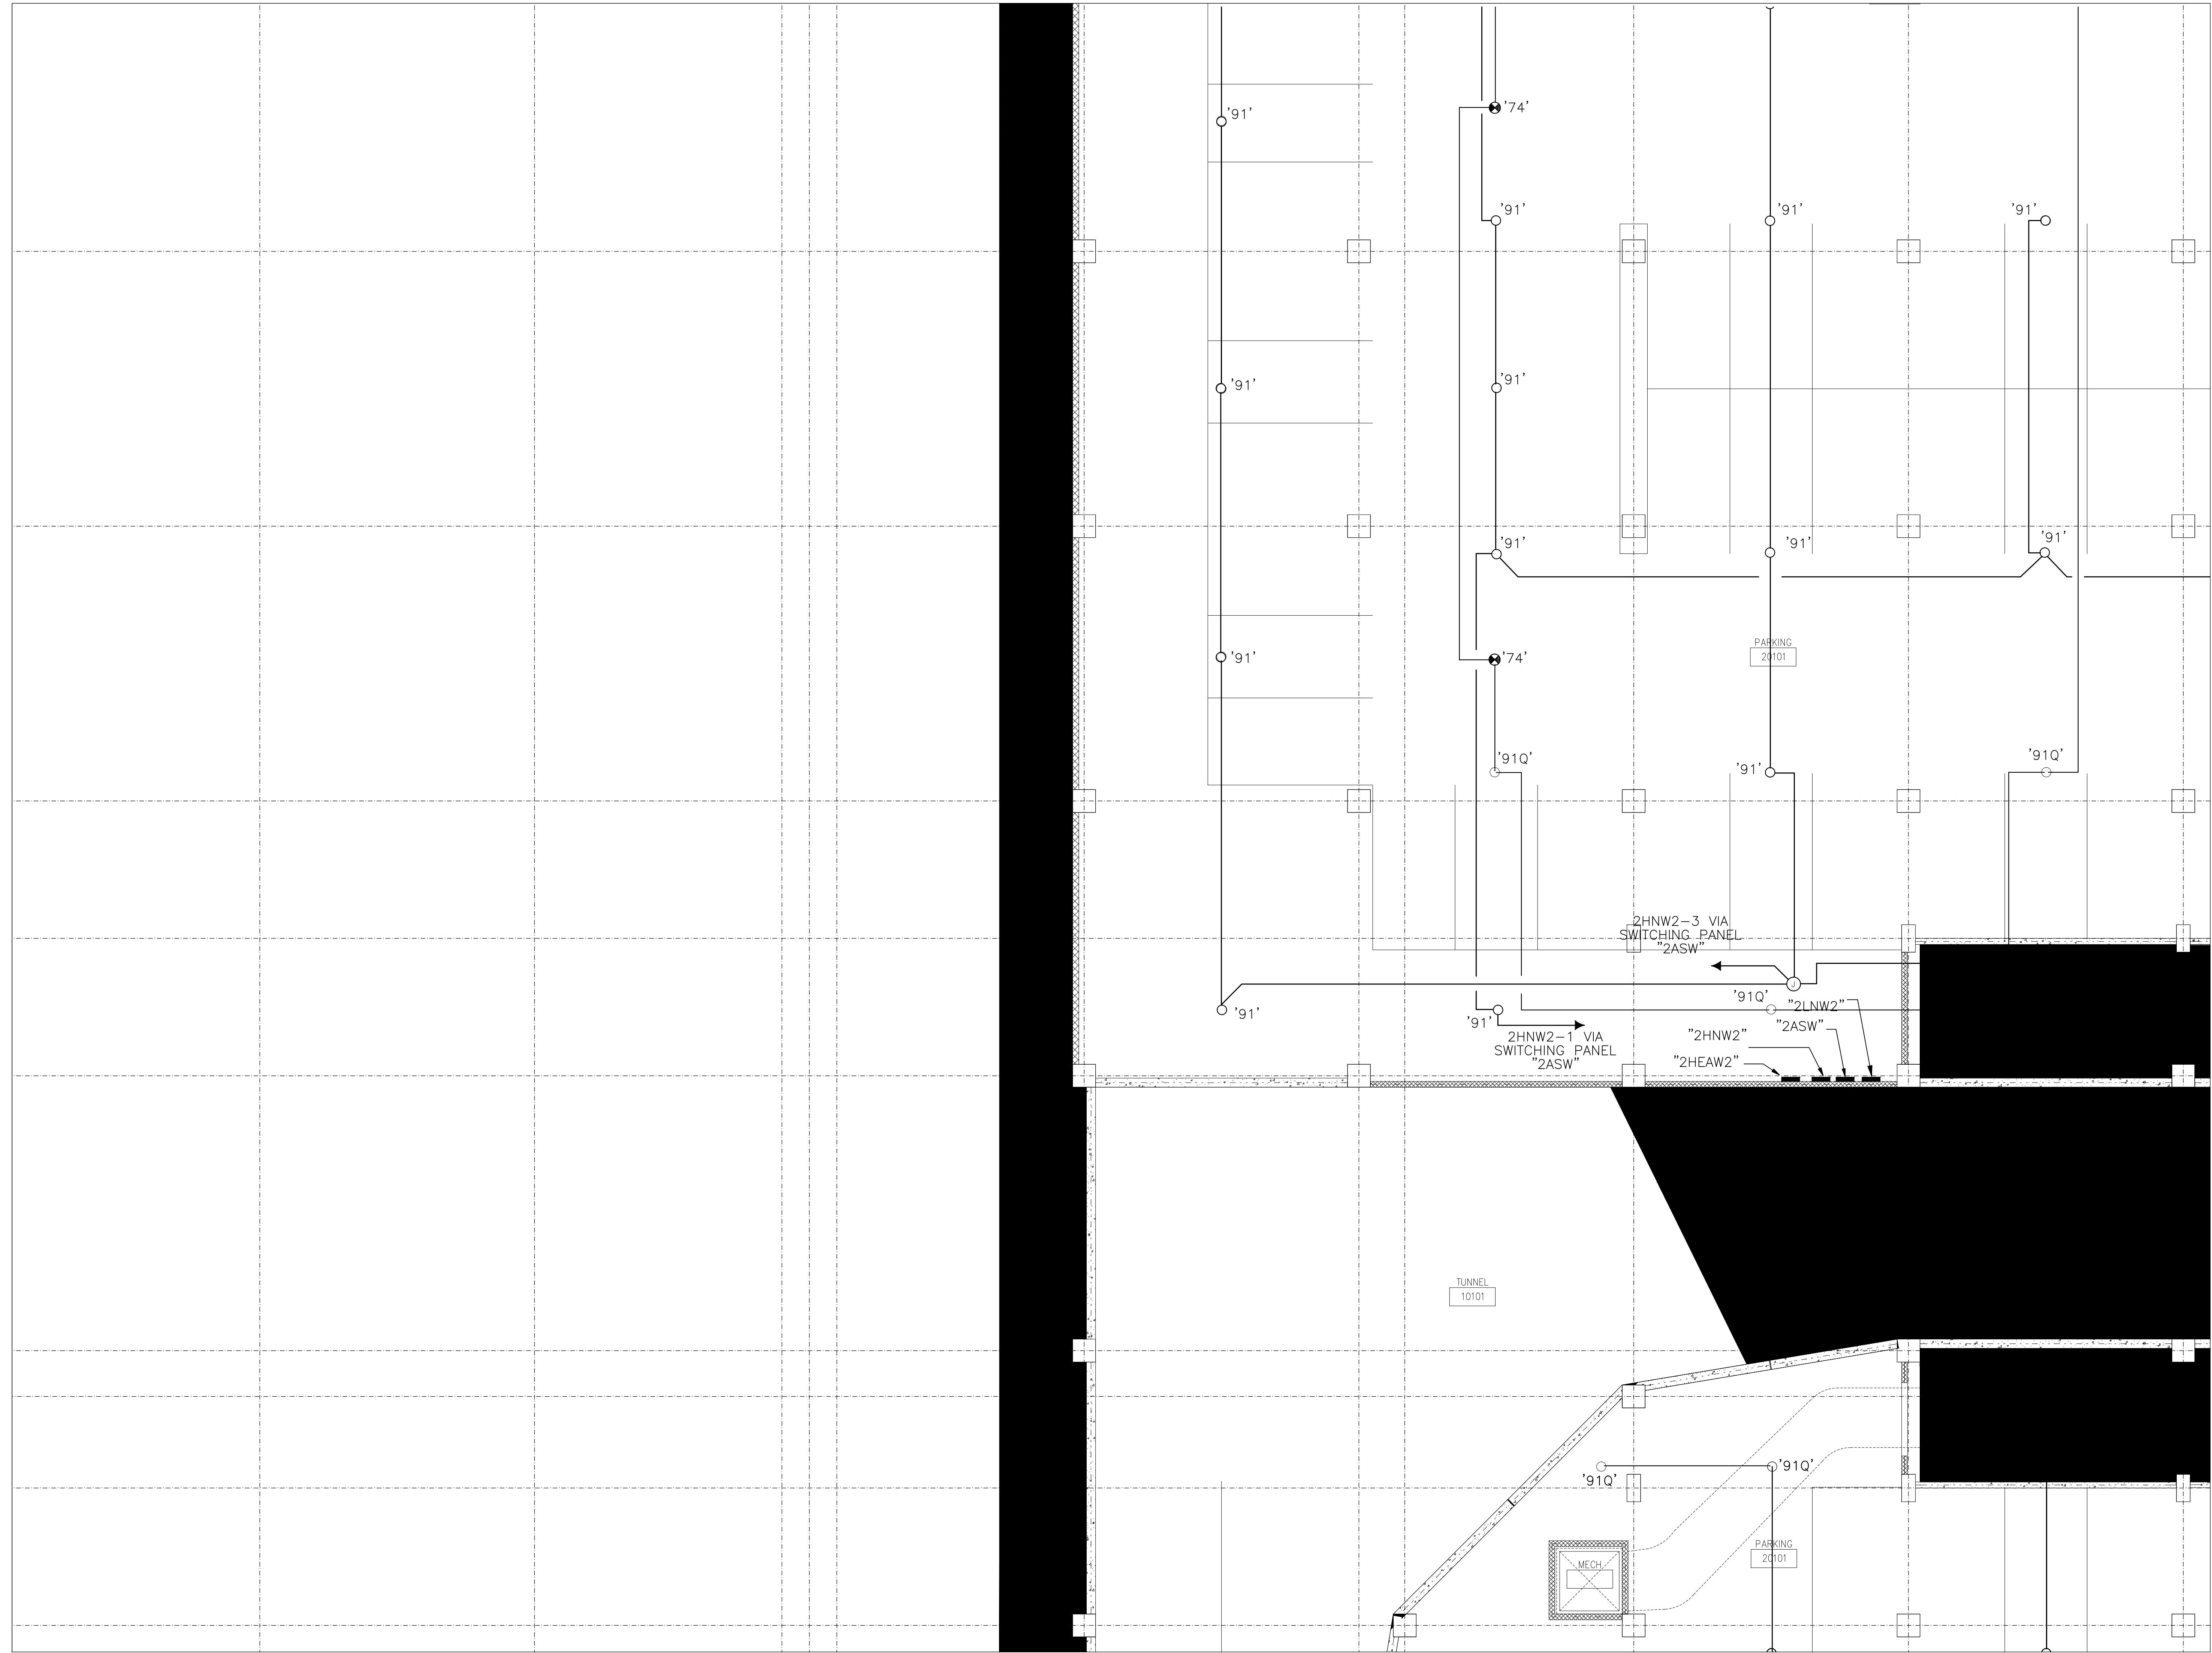

LEVEL 2 LIGHTING
 ZONE 7
 SCALE: 1/8" = 1'-0"


EL2-207

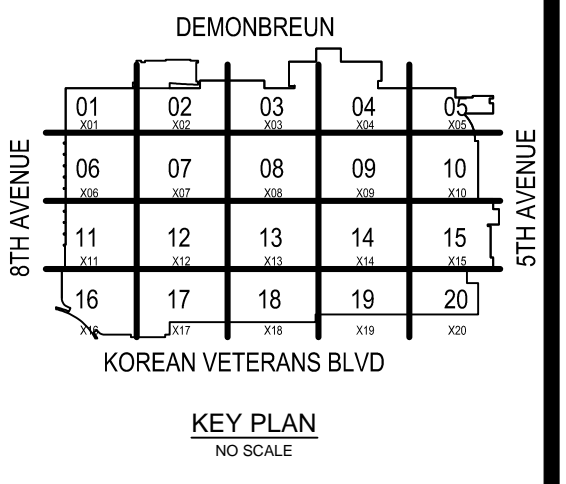

COORDINATION SIGN-OFF

COMPANY	TRADE	DATE
CONTI	ELEC.	/ /
		/ /
		/ /
Music City Center
 Nashville, Tennessee

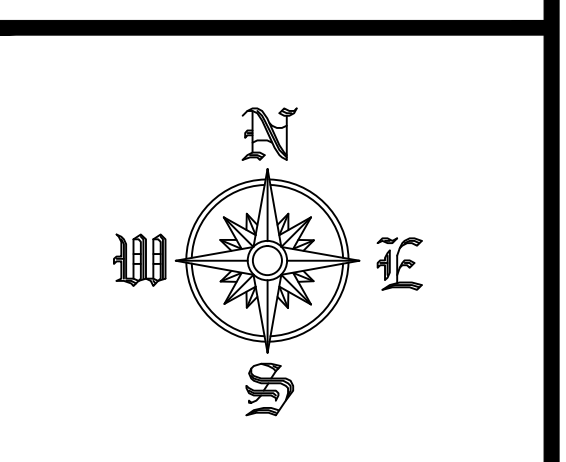

REVISIONS


NO.	DATE	DESCRIPTION


RECORD DRAWINGS STAMP

CONTELECTRIC DATE (Last Update):
 2/21/2012 12:44 PM
 DRAWING FILE NAME:
 E2-208
 CAD OPERATOR:
 GERRITAN
 PRINTED BY:
 FREDIAN GREGG
 PLOT DATE:
 2/21/2012 2:29 PM
 SUBMITTED BY:
 G.L.F.
 ASSIGNED TO:

LEVEL 2 LIGHTING
 ZONE 8
 SCALE: 1/8" = 1'-0"

EL2-208

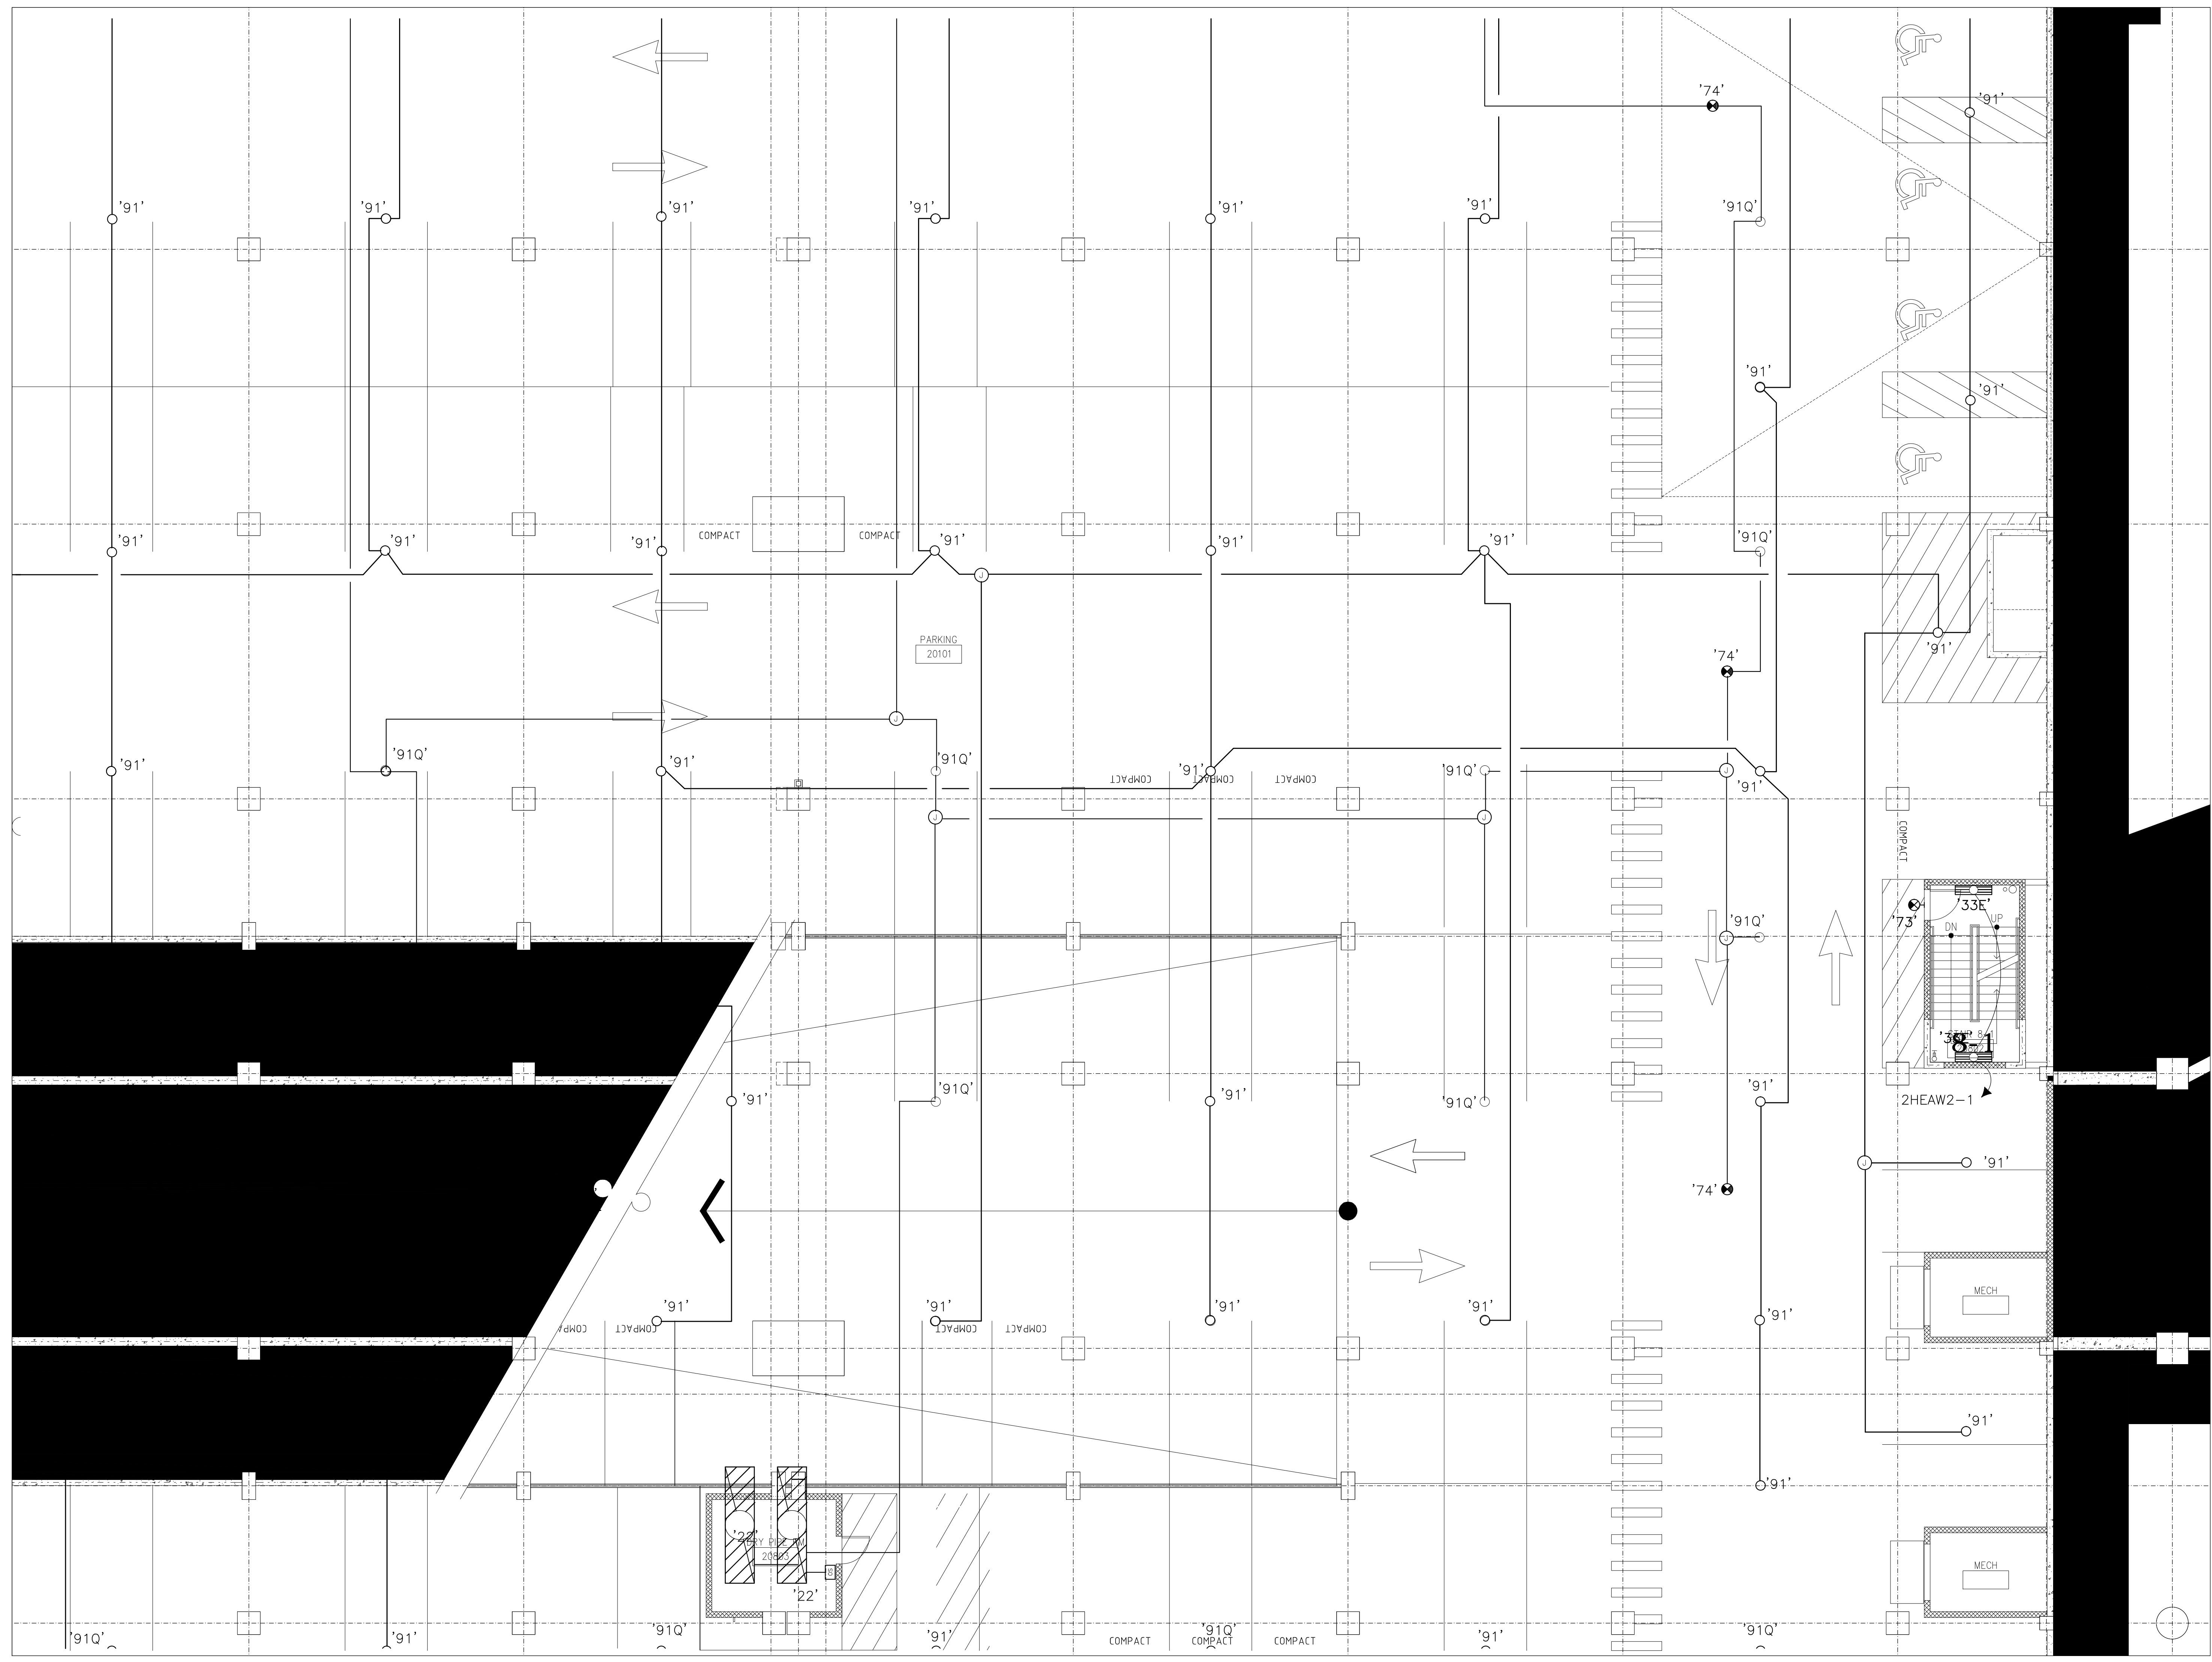


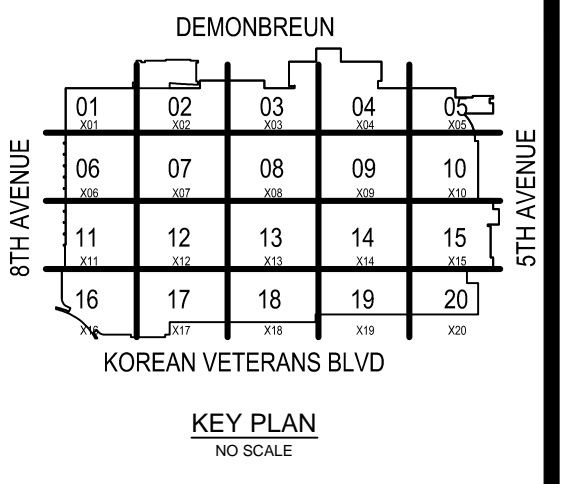

COORDINATION SIGN-OFF

COMPANY	TRADE	DATE
CONTI	ELEC.	/ /
		/ /
		/ /
Music City Center
Nashville, Tennessee

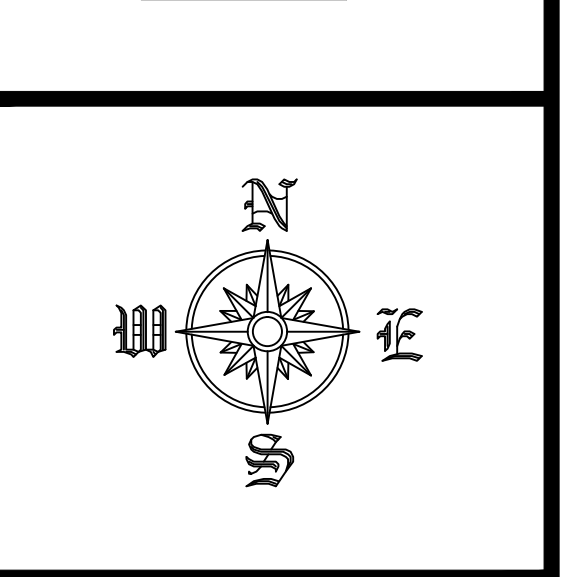

REVISIONS

NO.	DATE	DESCRIPTION

RECORD DRAWINGS STAMP

CONTELECTRIC DATE (last update):
2/21/2012 10:44:11

DRAWING FILE NAME:
EL2-209

CAD OPERATOR:
SERMAN

PRINTED BY:
SERMAN, GREG


PLOT DATE:
2/21/2012 2:29:11


SUBMITTED BY:
GREG

ASSIGNED TO:

LEVEL 2 LIGHTING
 ZONE 9
 SCALE: 1/8" = 1'-0"

EL2-209

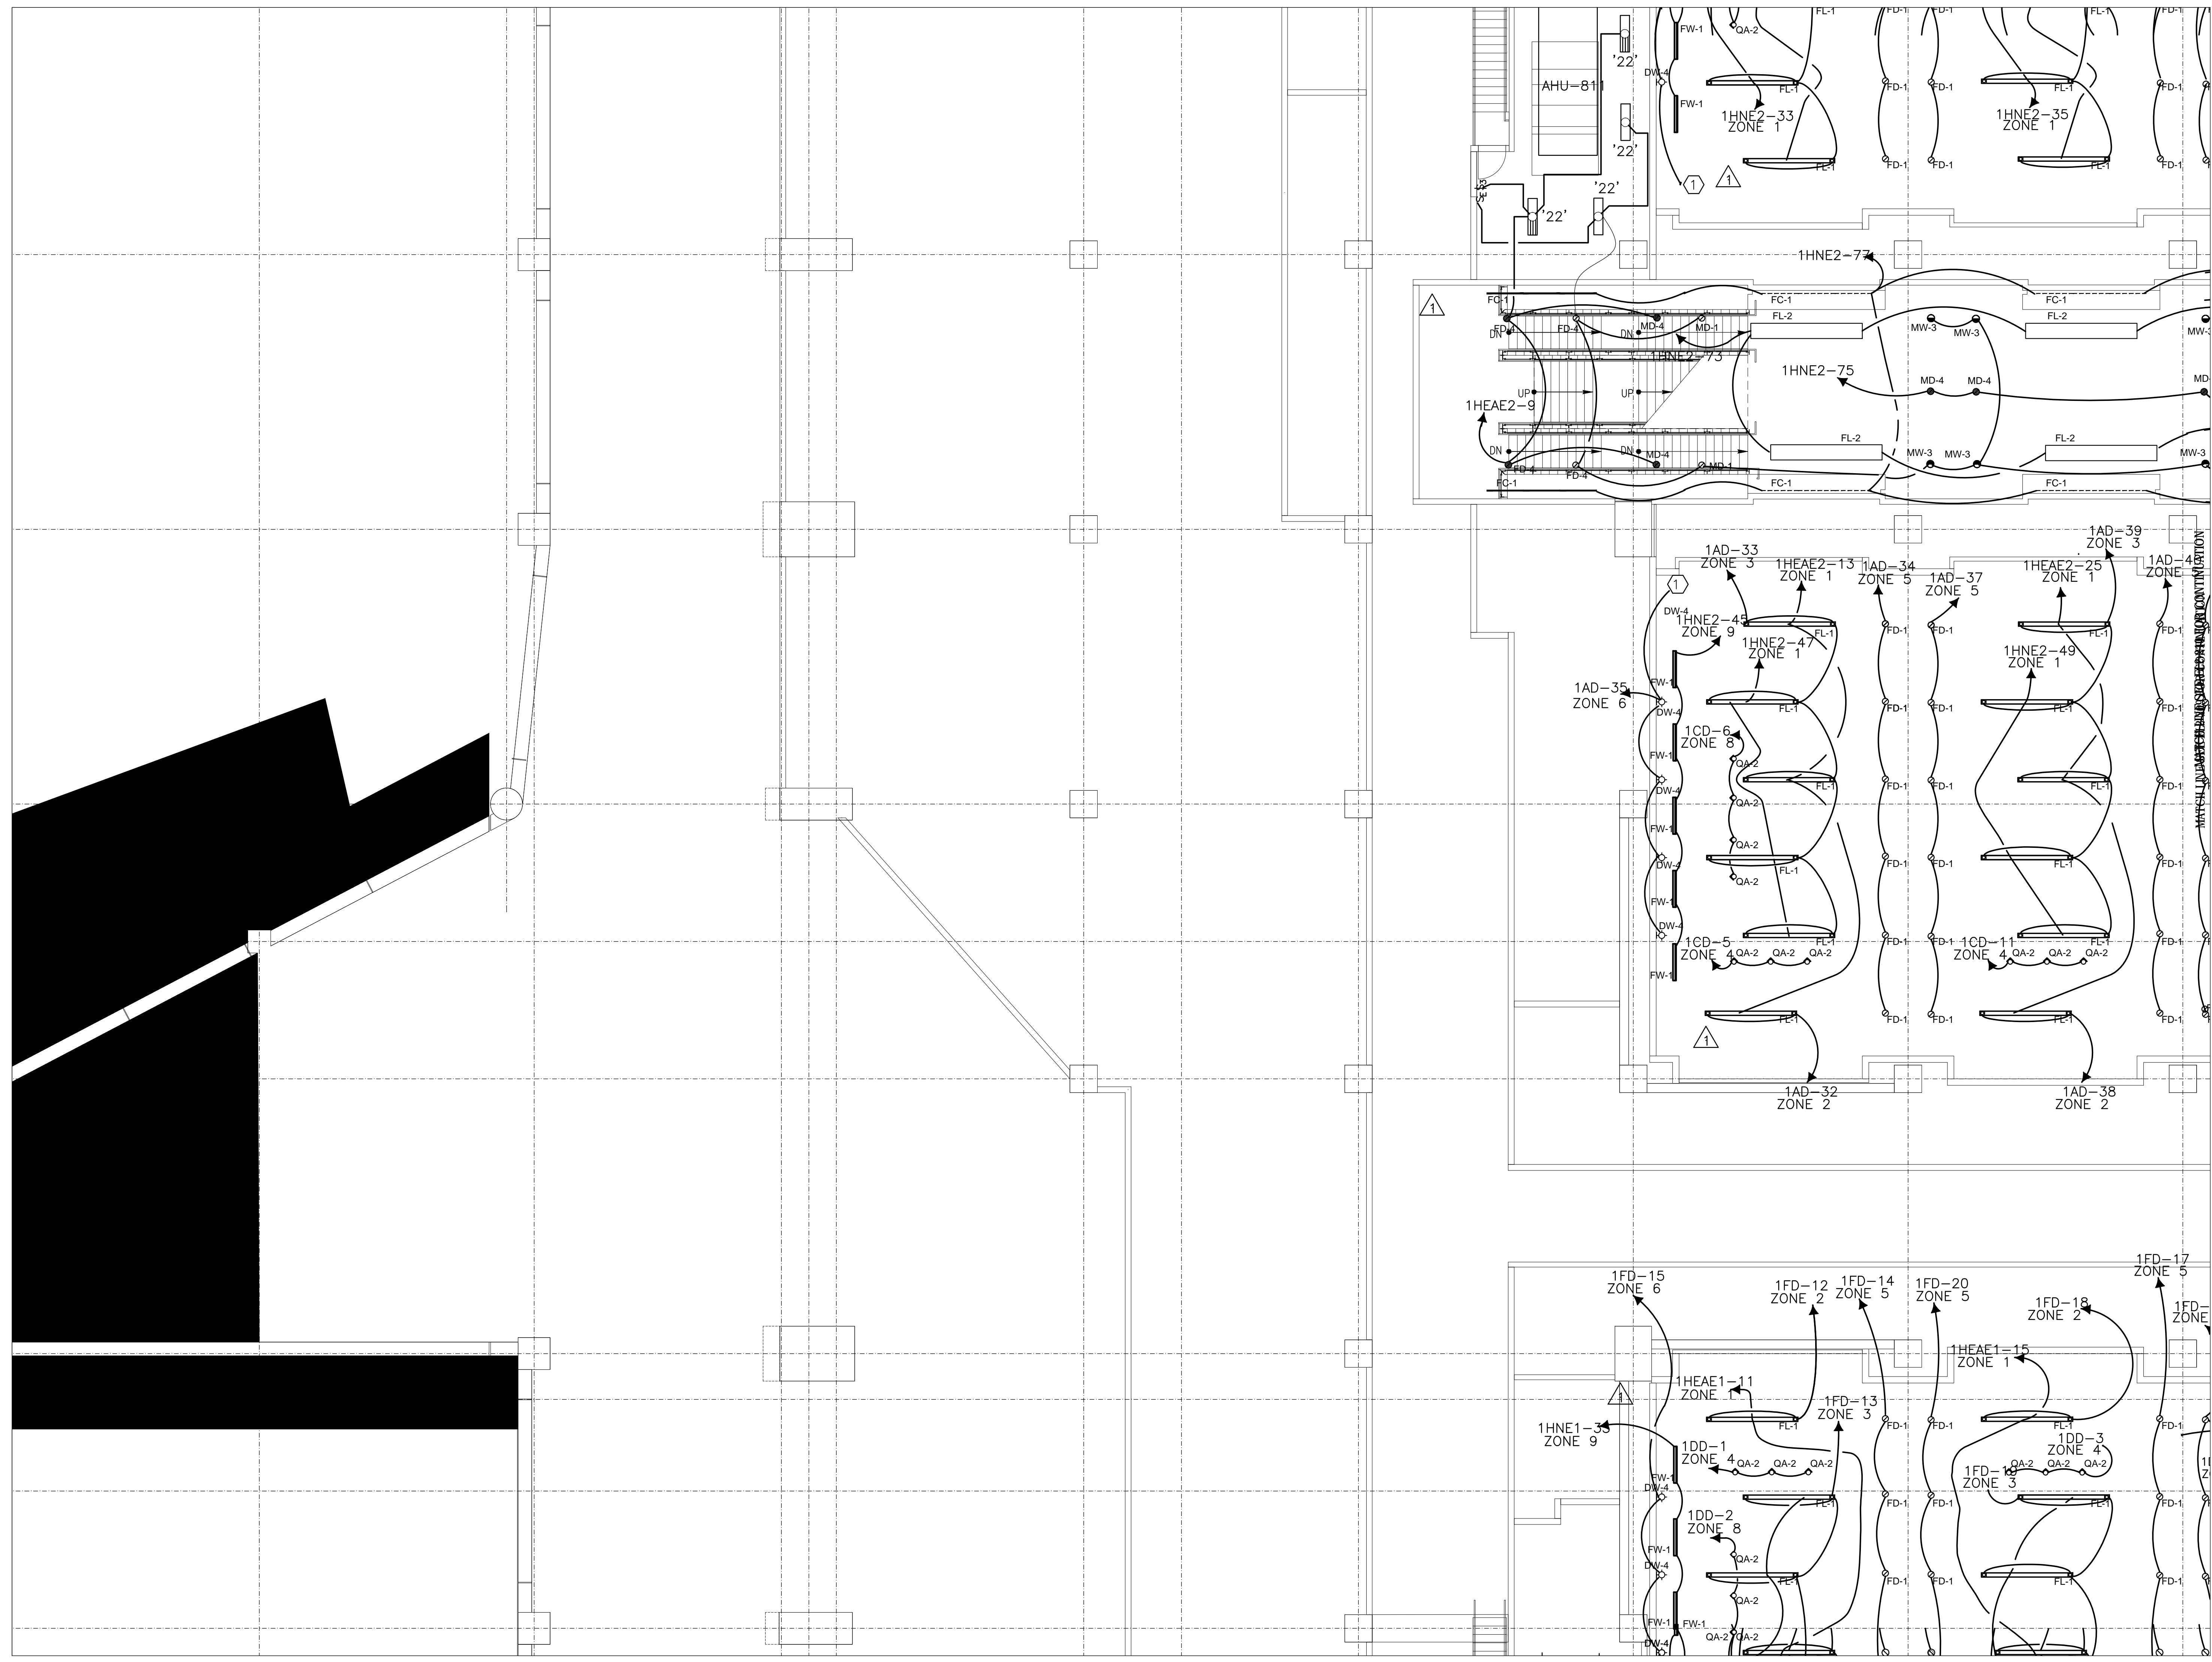


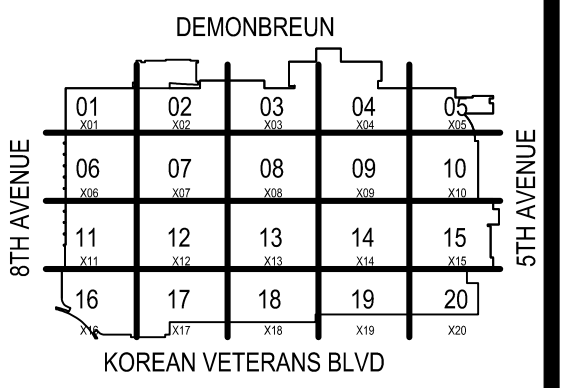

COORDINATION SIGN-OFF

DATE	NAME	TRADE	ELEC.

Music City Center
 Nashville, Tennessee

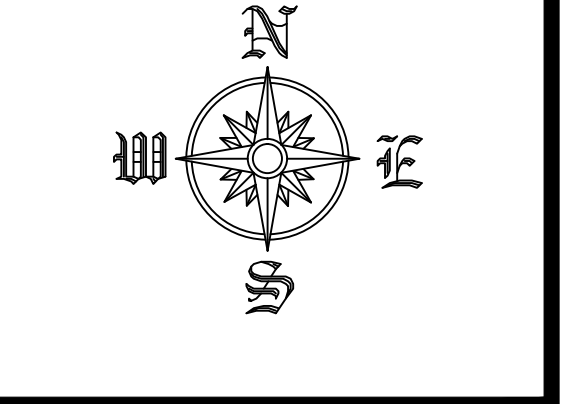

REVISIONS


NO.	DATE	DESCRIPTION


RECORD DRAWINGS STAMP

CONTRACT DATE (Last Update): 2/21/2012 12:44 PM
 DRAWING FILE NAME: E2-10
 CAD OPERATOR: GERRITMAN
 PRINTED BY: FREDMAN, GREGG
 PLOT DATE: 2/21/2012 2:00 PM
 SUBMITTED BY: G.P.F.
 ASSIGNED TO:

LEVEL 2 LIGHTING
 ZONE 10
 SCALE: 1/8" = 1'-0"

EL2-210

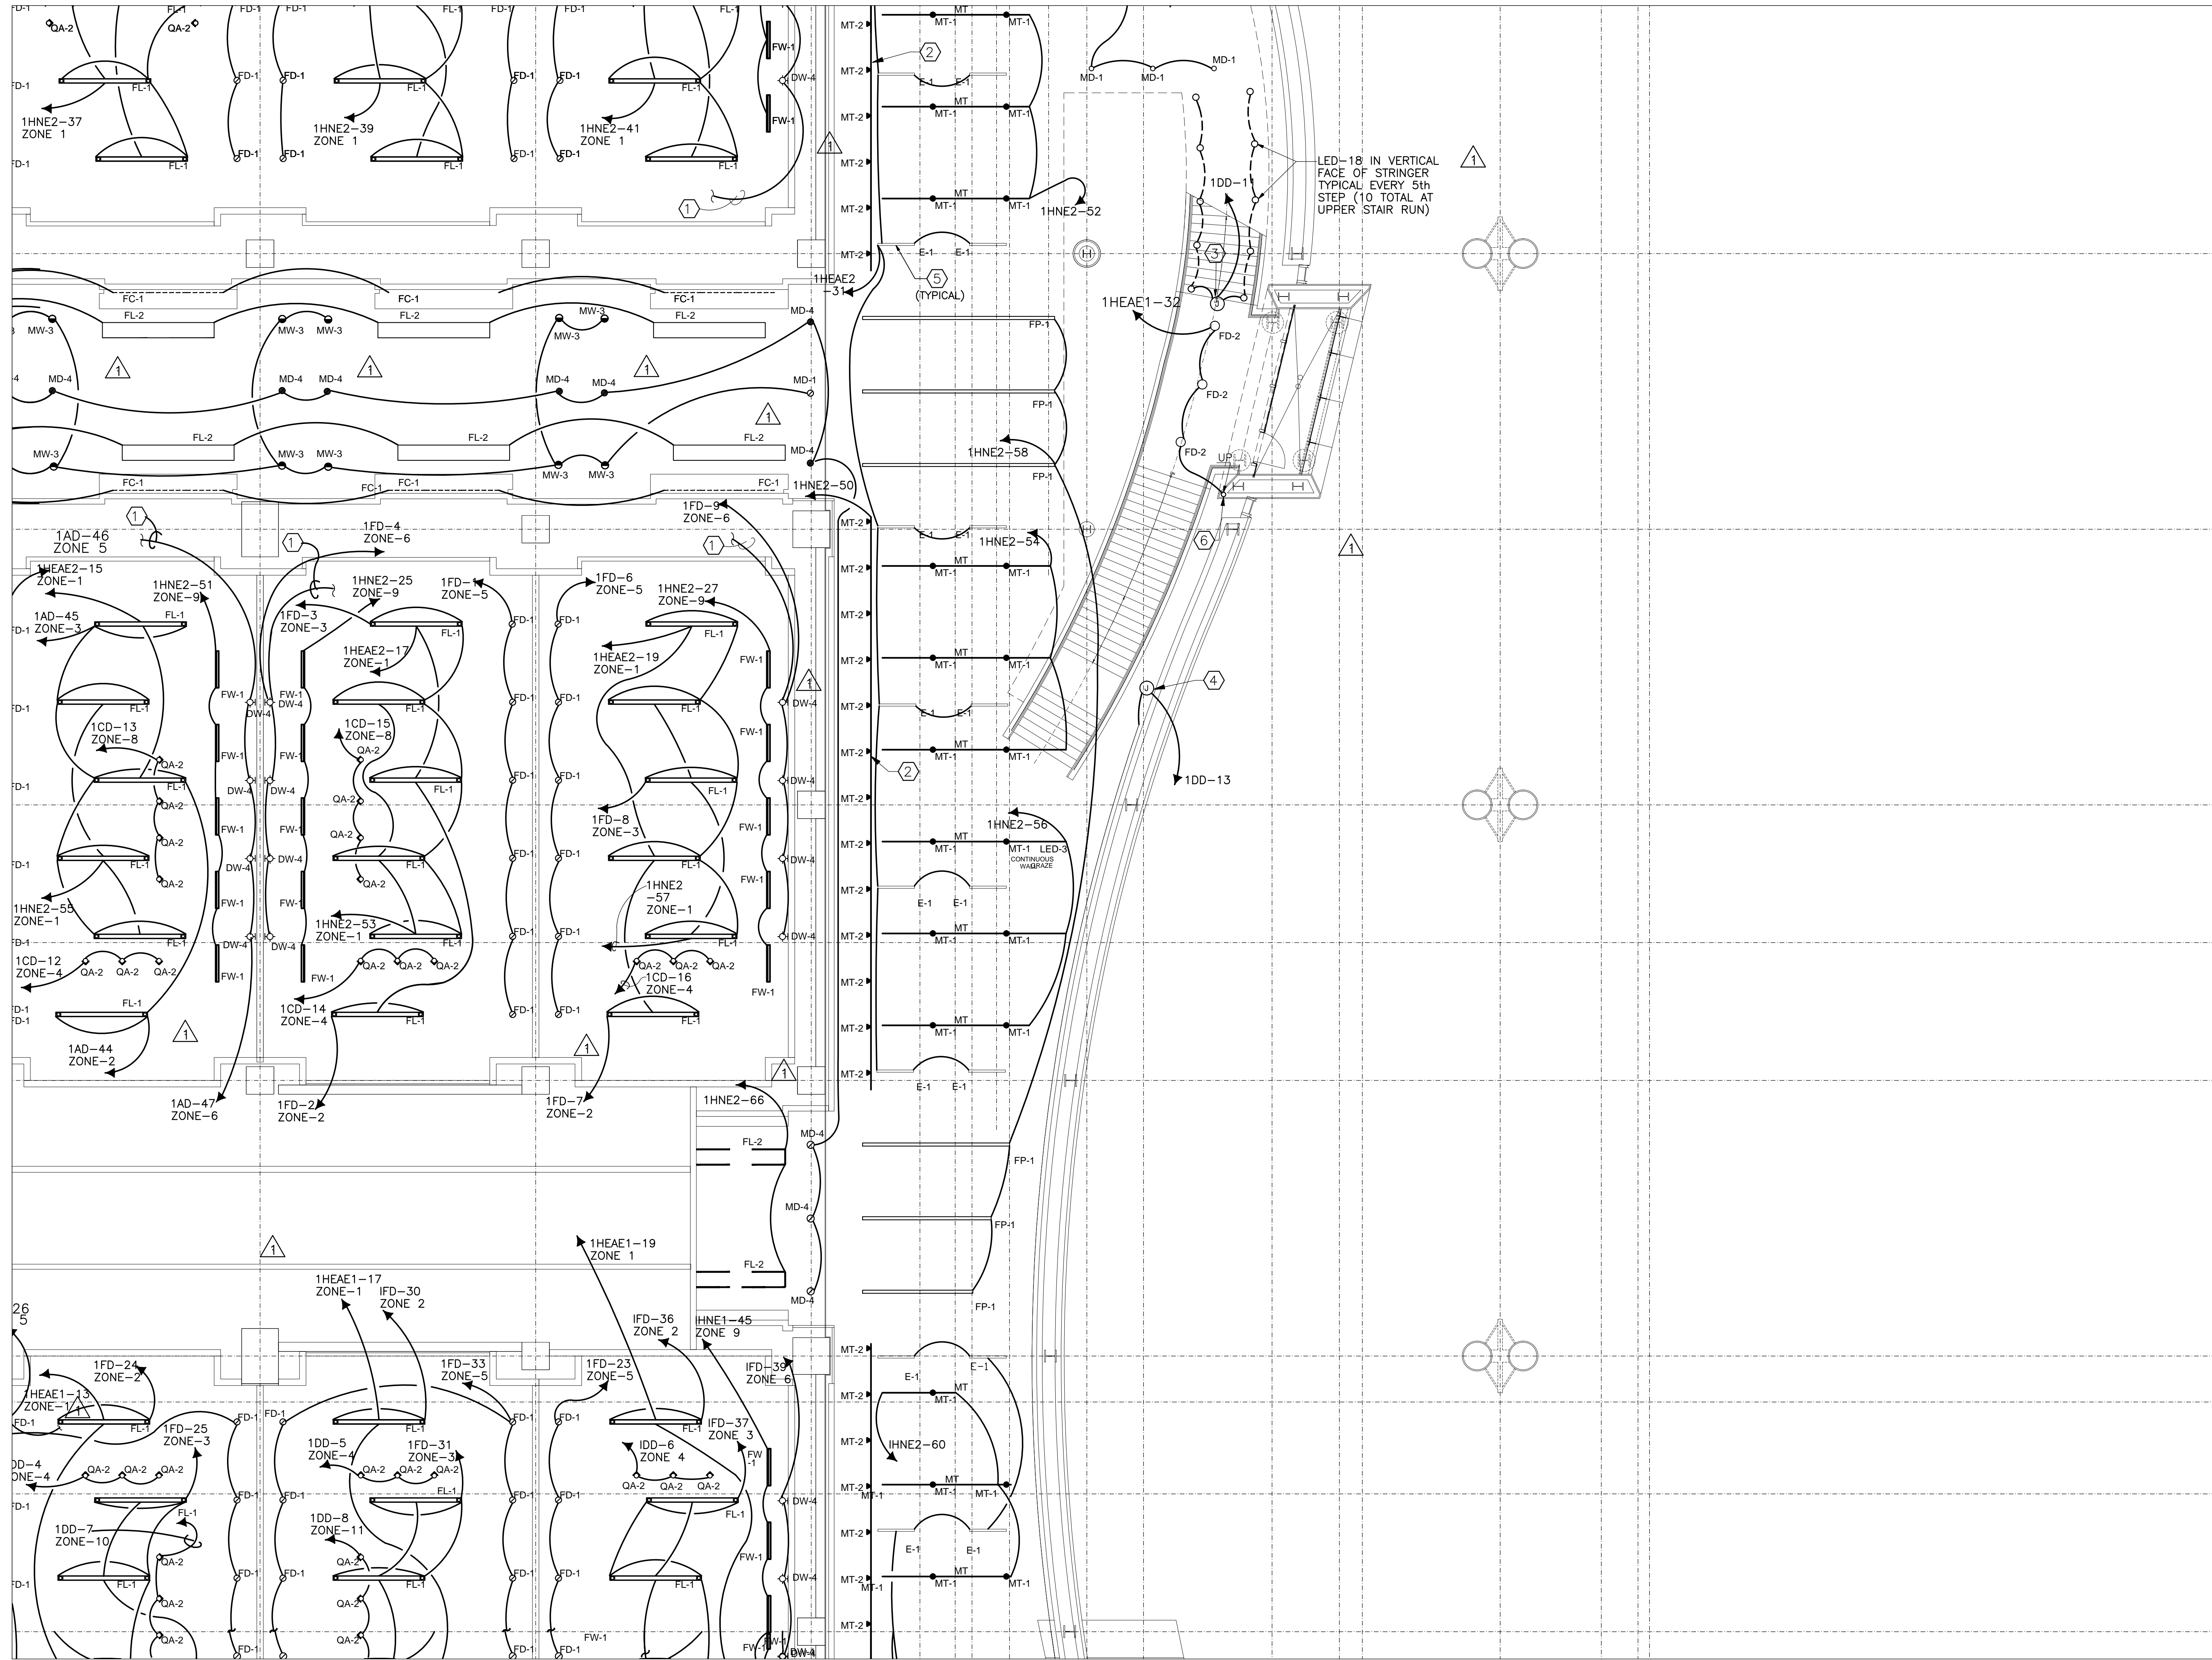


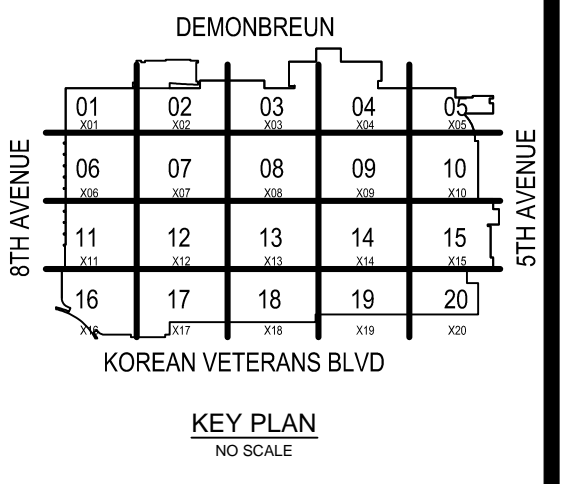

COORDINATION SIGN-OFF

COMPANY	TRADE	DATE
CONTI	ELEC.	/ /
		/ /
		/ /
Music City Center
 Nashville, Tennessee

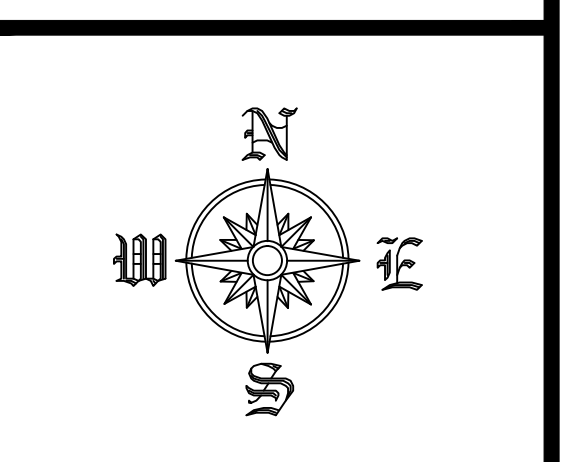

REVISIONS

NO.	DATE	DESCRIPTION


RECORD DRAWINGS STAMP

CONTI ELECTRIC DATE (Last Update): 2/21/2012 12:44 PM
 DRAWING FILE NAME: E2-12
 CAD OPERATOR: GREGG
 PRINTED BY: FREDAN, GREGG
 PLOT DATE: 2/21/2012 2:00 PM
 SUBMITTED BY: G.P.
 ASSIGNED TO:

LEVEL 2 LIGHTING
 ZONE 12
 SCALE: 1/8" = 1'-0"

EL2-212




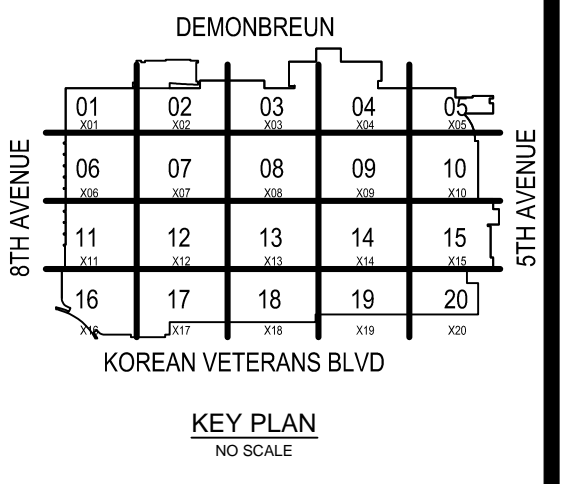

COORDINATION SIGN-OFF

COMPANY	TRADE	DATE
CONTI	ELEC.	/ /
		/ /
		/ /
Music City Center
 Nashville, Tennessee

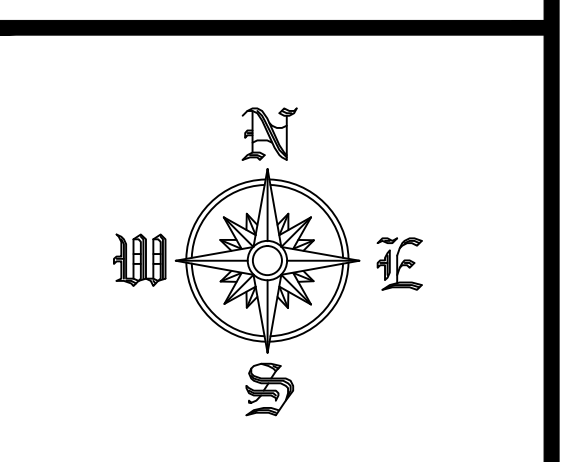

REVISIONS


NO.	DATE	DESCRIPTION

RECORD DRAWINGS STAMP


CONTI ELECTRIC DATE (Last Update):	2/21/2012 12:44 PM
DRAWING FILE NAME:	EL2-213
CAD OPERATOR:	GERMAN
PRINTED BY:	FREDMAN, GREGG
PLOT DATE:	2/21/2012 2:00 PM
SUBMITTED BY:	ELF
ASSIGNED TO:	

LEVEL 2 LIGHTING
 ZONE 13
 SCALE: 1/8" = 1'-0"

EL2-213

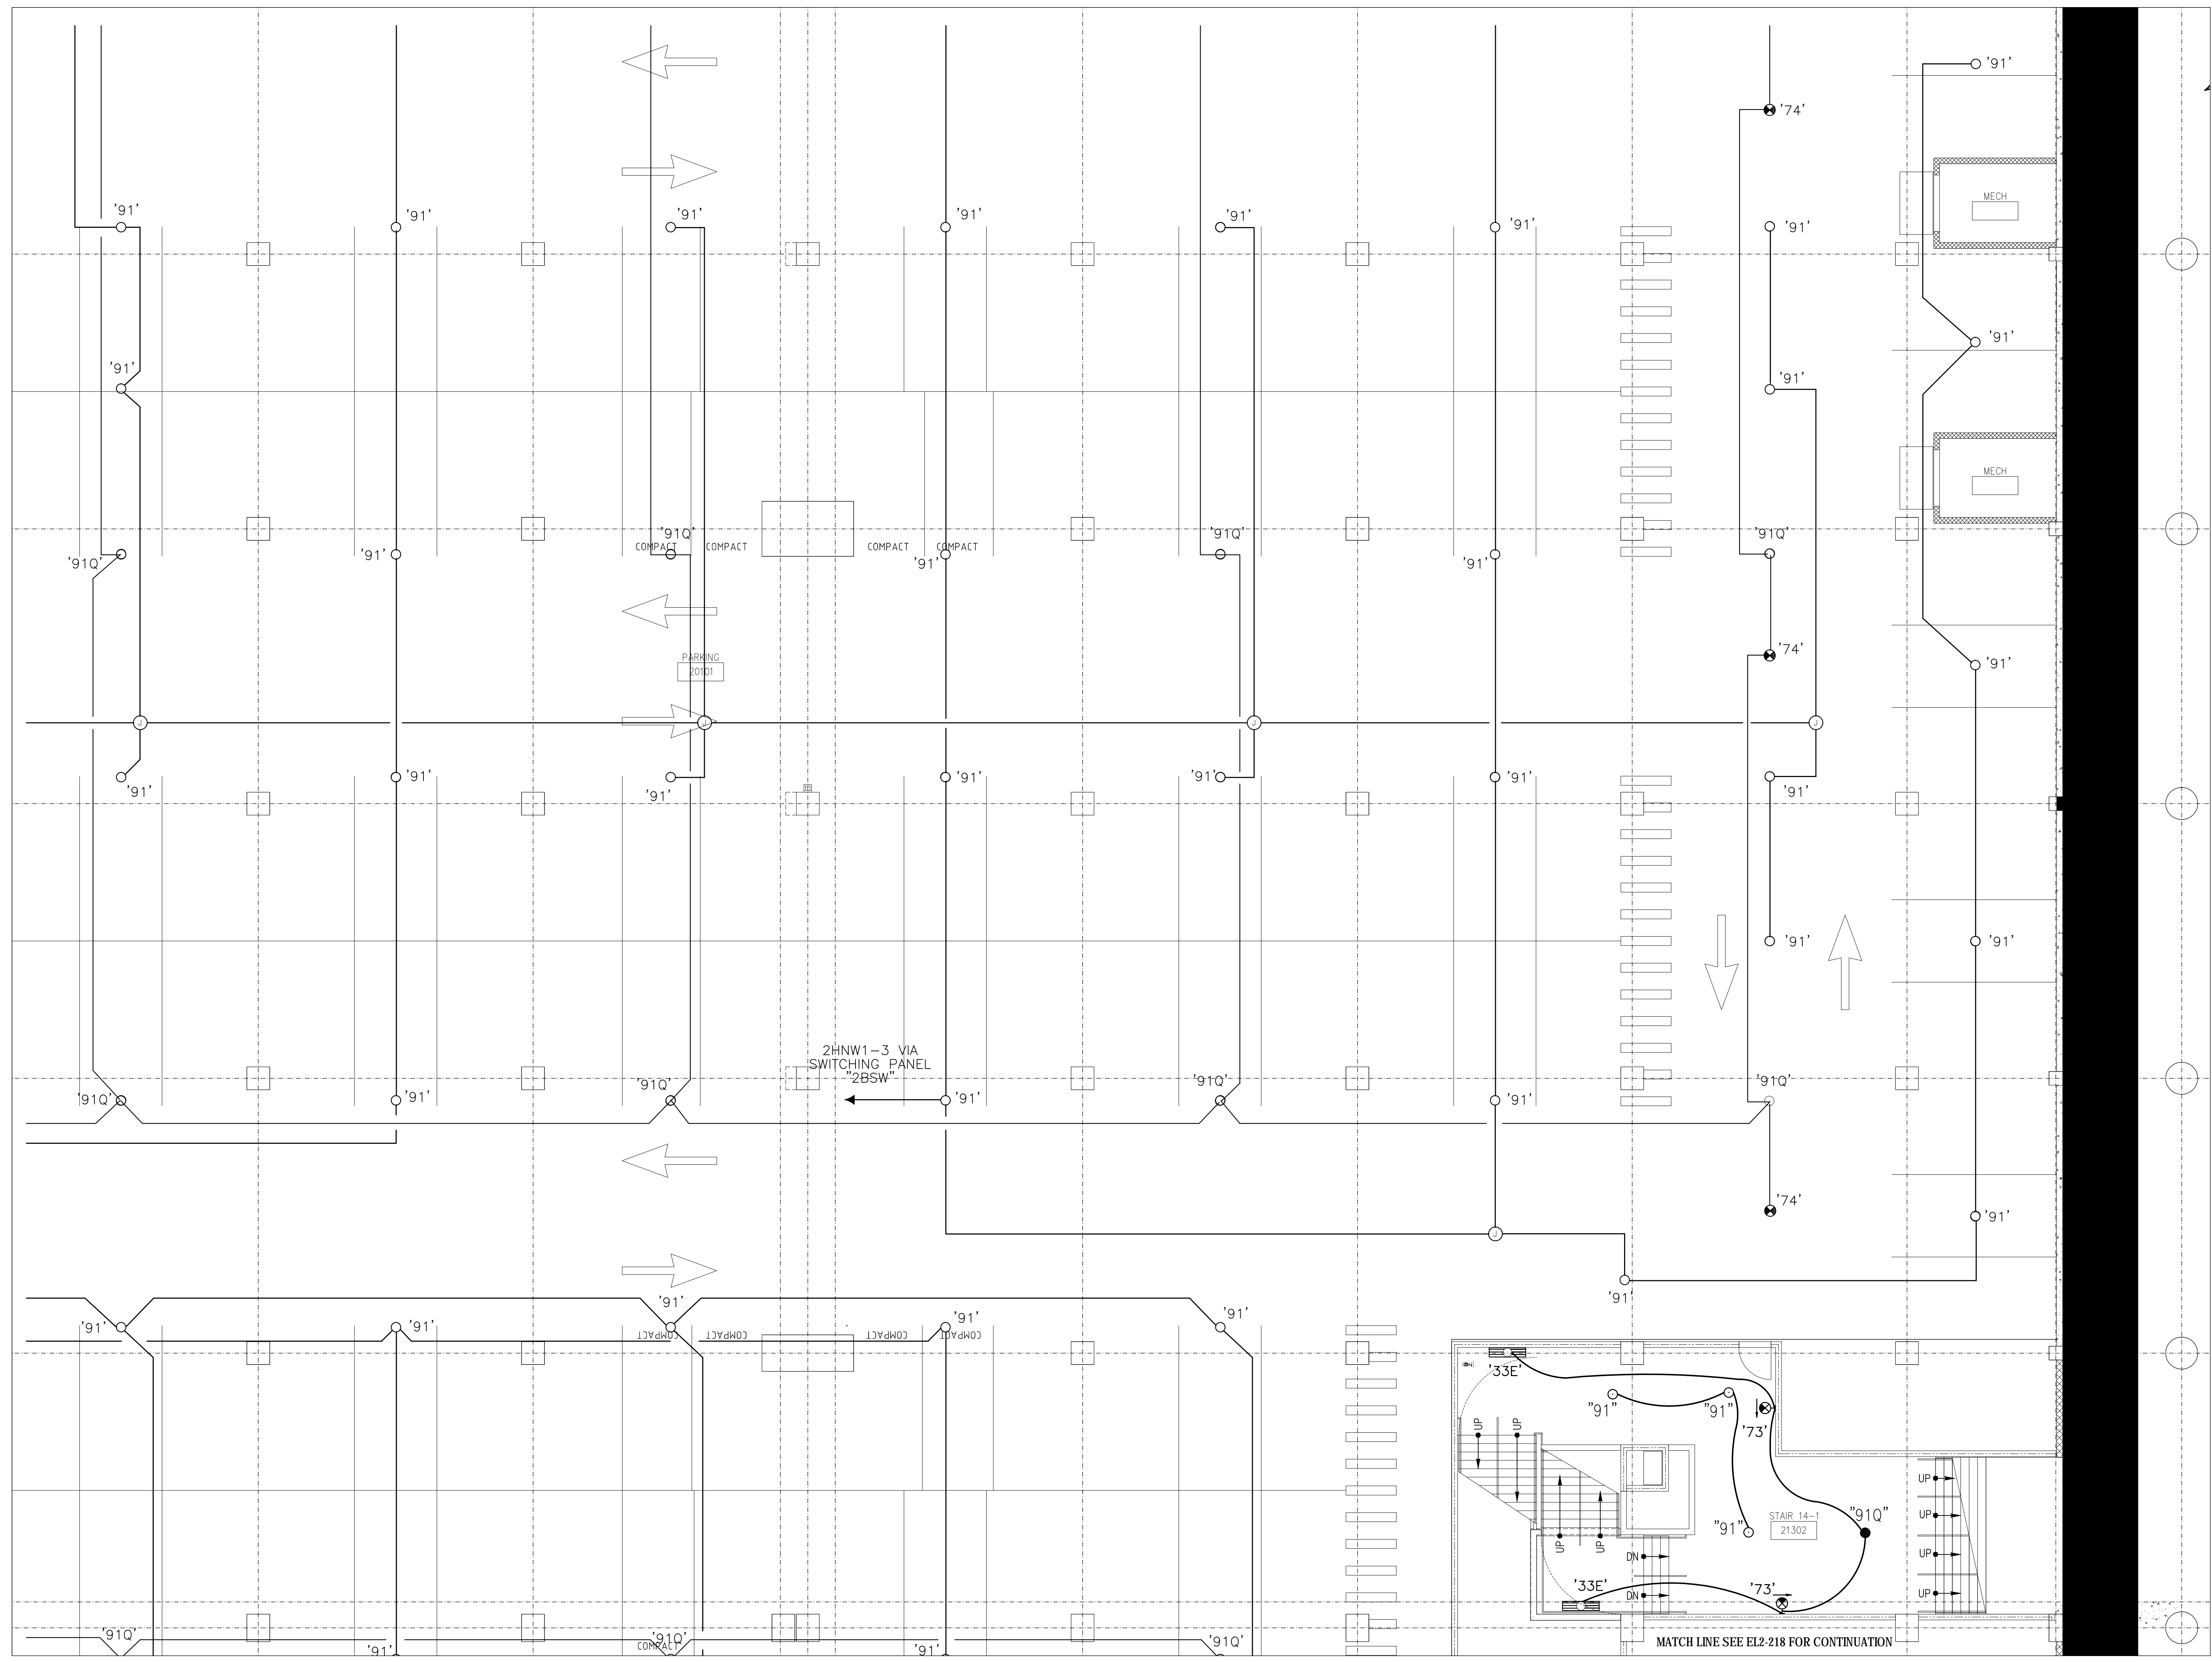


FILE PATH FOR CAD OPERATOR USE ONLY: C:\Users\Conti\Documents\Projects\Music City Center\As-Built\4-13-12\Zone 2 Lighting\Subarea For Opening

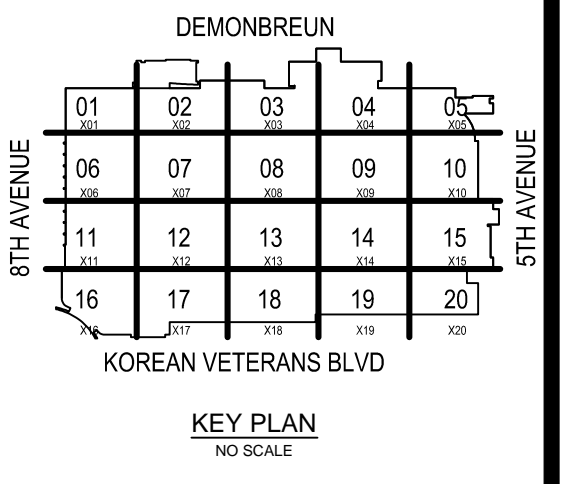

COORDINATION SIGN-OFF	
DATE	/ /
NAME	/ /
TRADE	ELEC.
COMPANY	CONTI

Music City Center
 Nashville, Tennessee

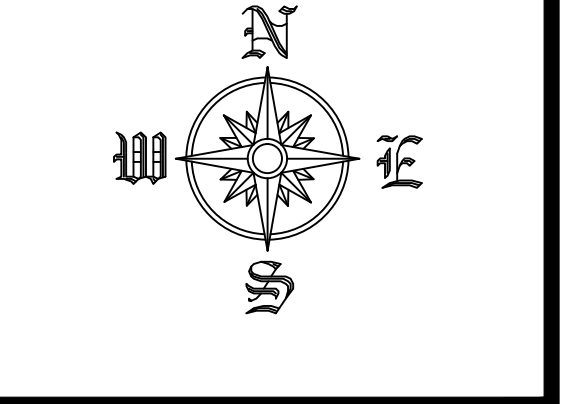

REVISIONS		
NO.	DATE	DESCRIPTION

RECORD DRAWINGS STAMP

CONTI ELECTRIC DATE (Last Update):
 2/21/2012 10:47 AM

DRAWING FILE NAME:
 EL2-14

CAD OPERATOR:
 GREGG

PRINTED BY:
 FREDMAN GREGG


PLOT DATE:
 2/21/2012 2:00 PM

SUBMITTED BY:
 GREGG


ASSIGNED TO:

LEVEL 2 LIGHTING
 ZONE 14
 SCALE: 1/8" = 1'-0"

EL2-214

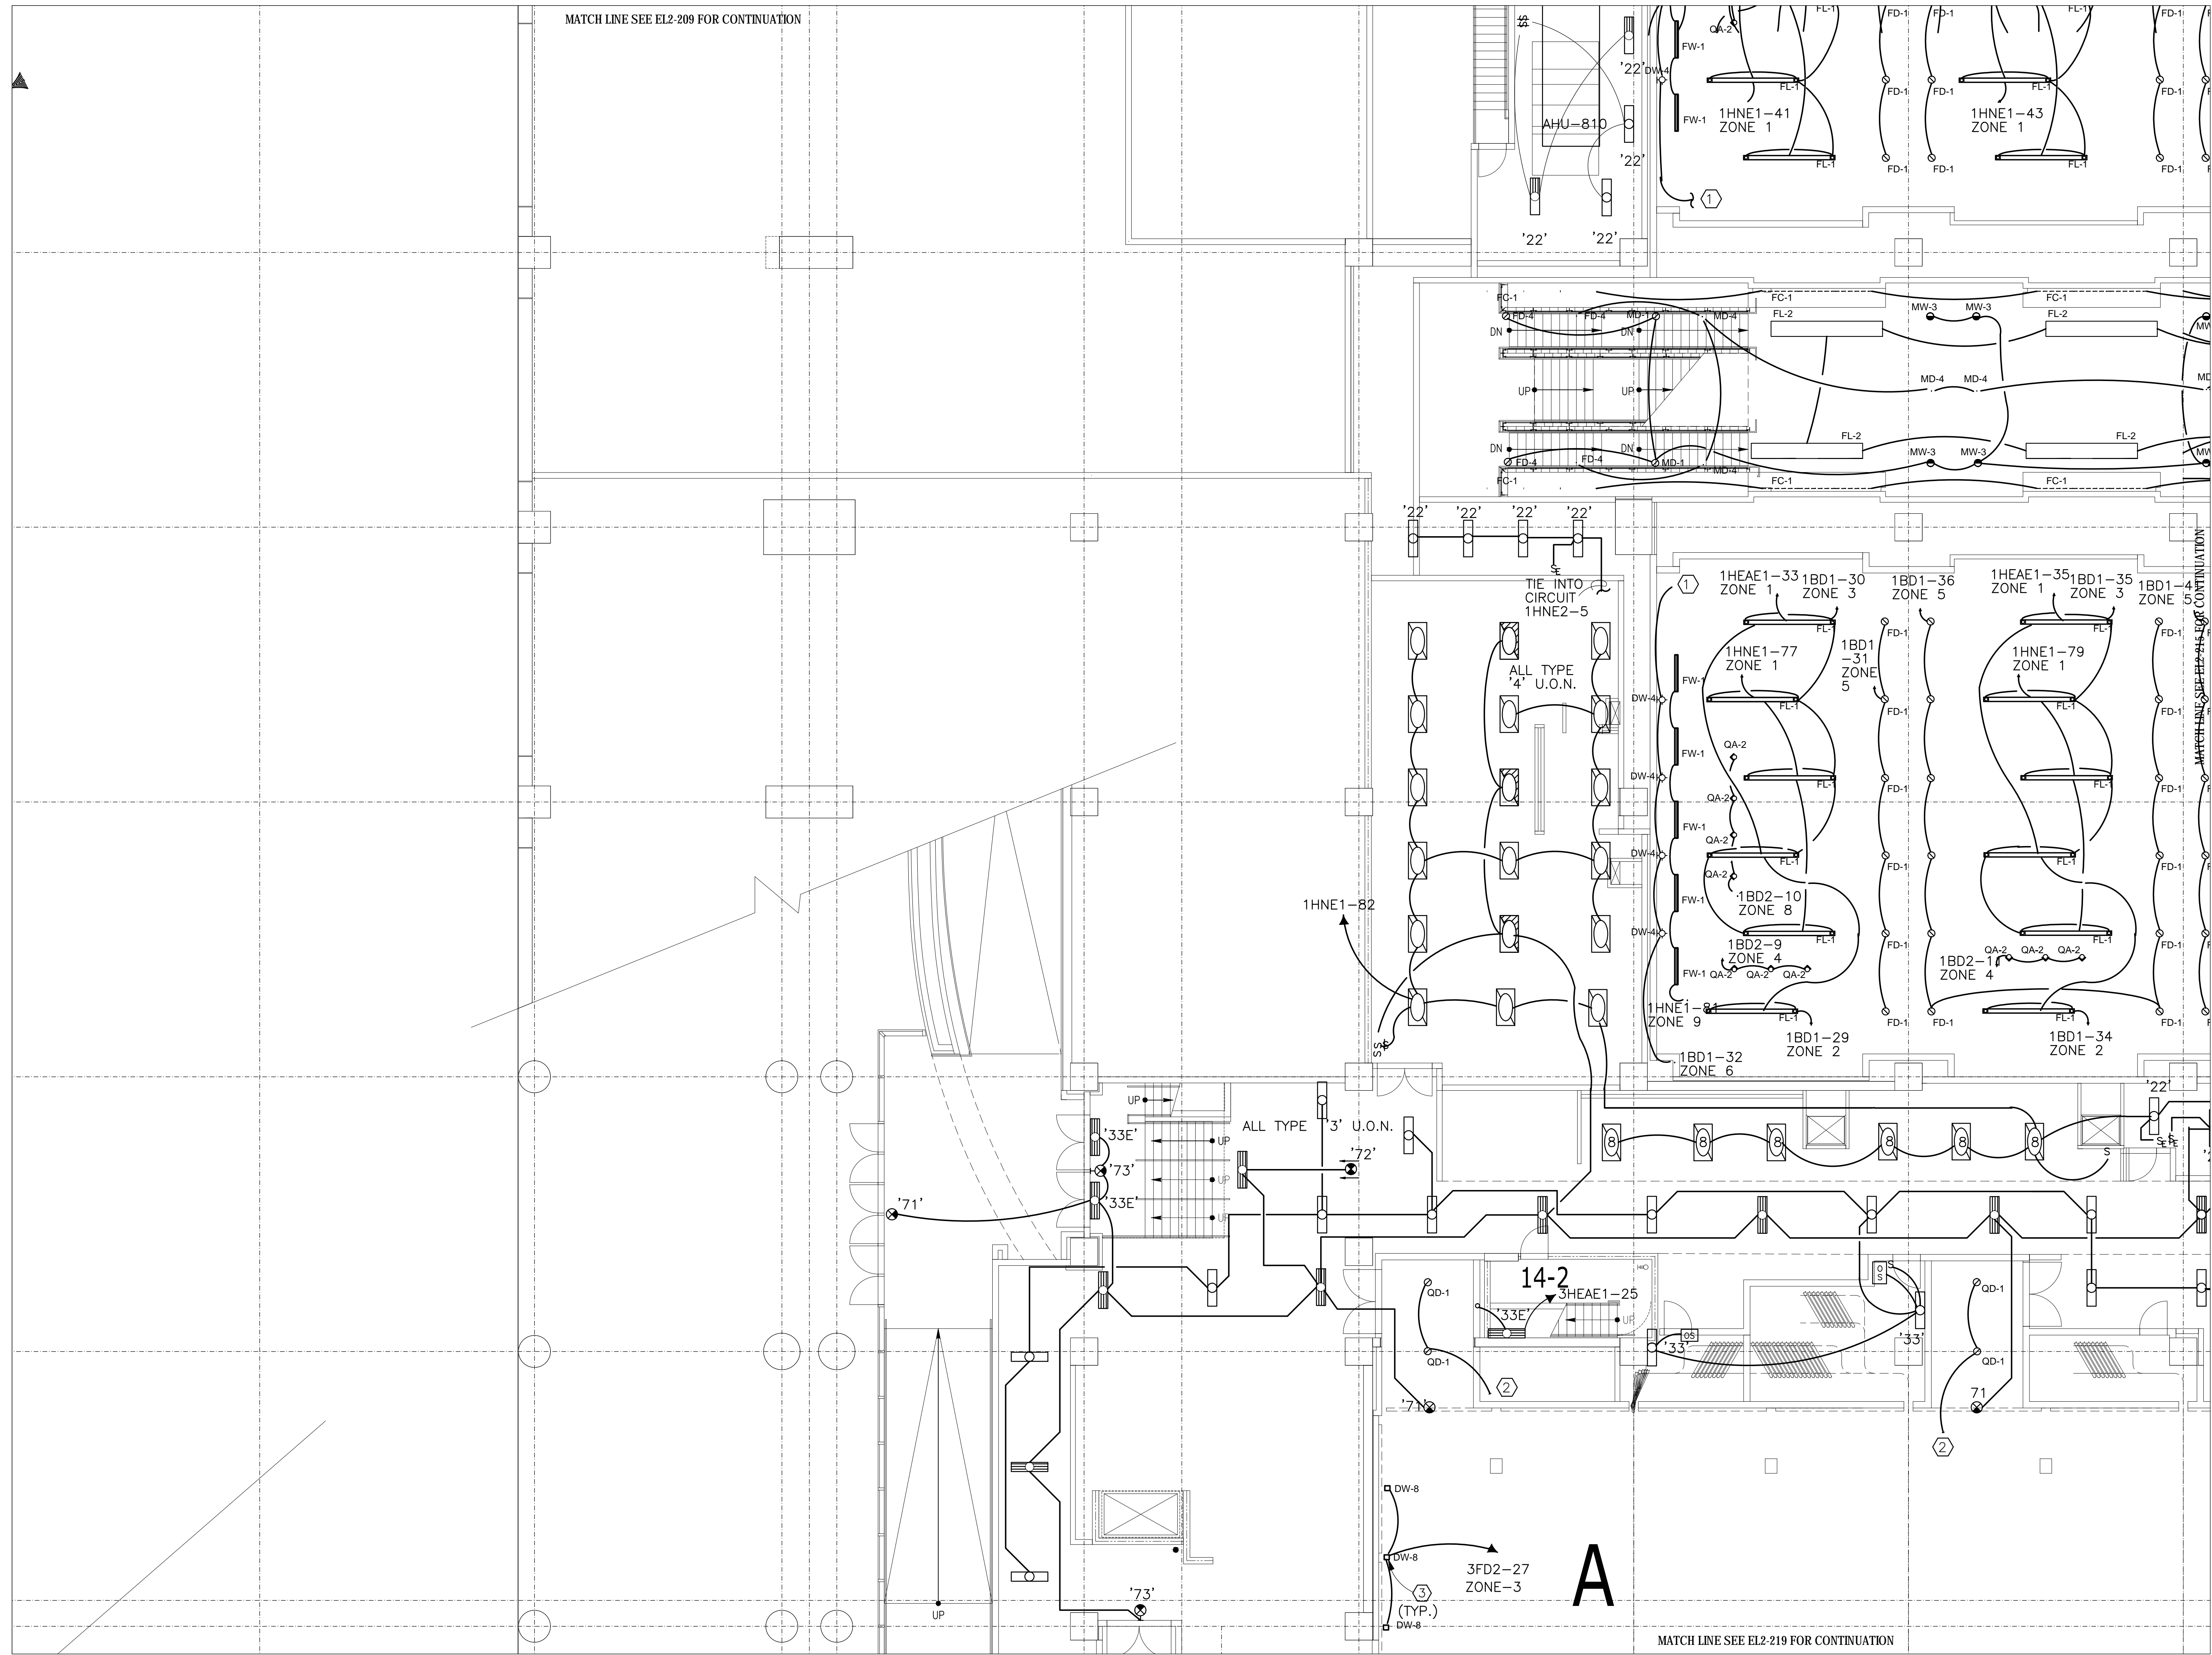


FILE PATH FOR CAD OPERATOR USE ONLY: C:\Users\Conti\Desktop\Projects\MusicCity\Level 2 Lighting\Zone 14 For Opening

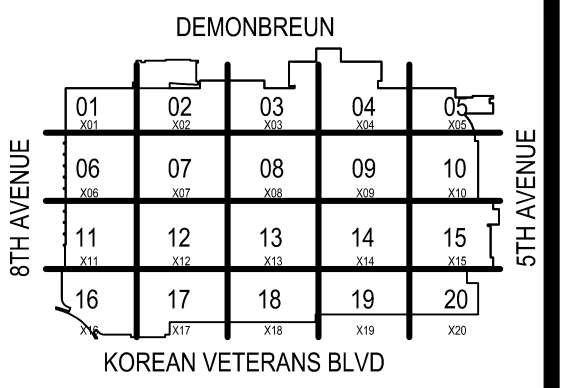

COORDINATION SIGN-OFF

COMPANY	TRADE	ELEC.	DATE	NAME
CONTI			/ /	
			/ /	
			/ /	
Music City Center
 Nashville, Tennessee

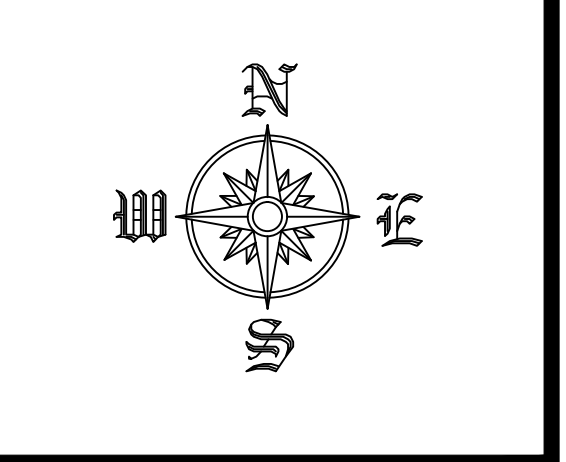

REVISIONS


NO.	DATE	DESCRIPTION


RECORD DRAWINGS STAMP

CONTI ELECTRIC DATE (Last Update): 2/21/2012 10:47 AM
 DRAWING FILE NAME: EL2-15
 CAD OPERATOR: GERRITMAN
 PRINTED BY: FREDMAN, GREGG
 PLOT DATE: 2/21/2012 2:00 PM
 SUBMITTED BY: G.P.F.
 ASSIGNED TO:

LEVEL 2 LIGHTING
 ZONE 15
 SCALE: 1/8" = 1'-0"

EL2-215

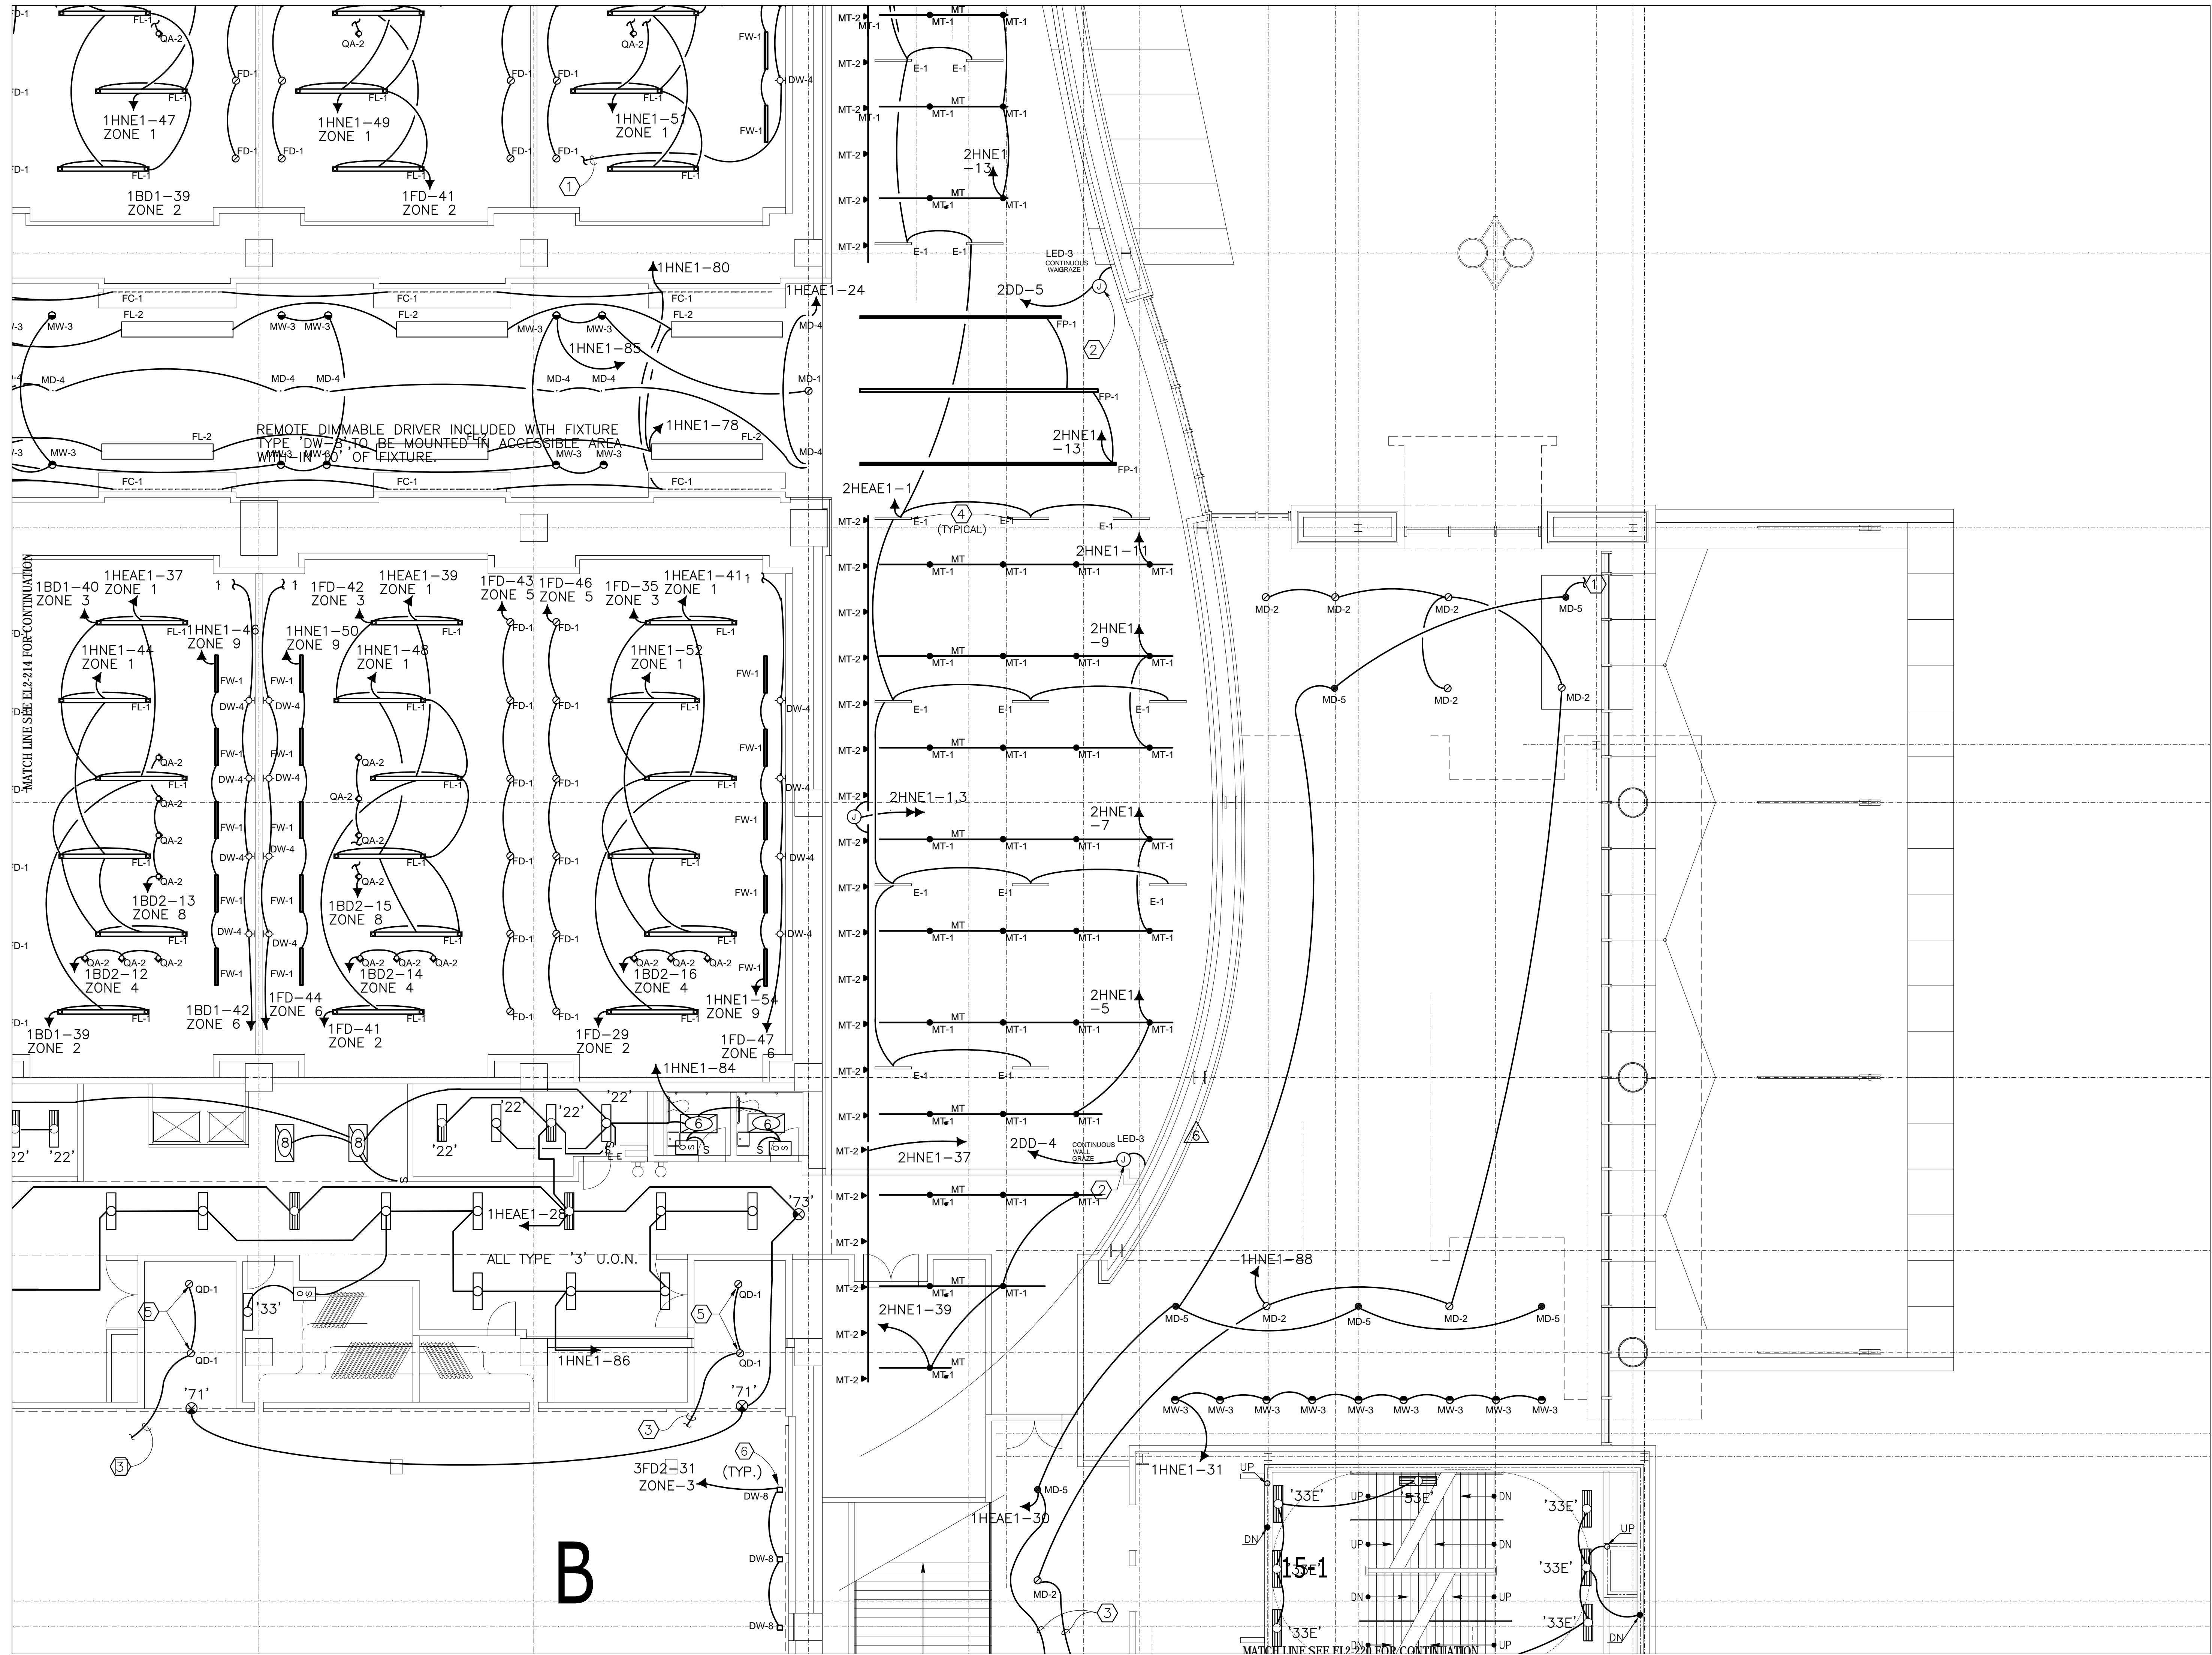


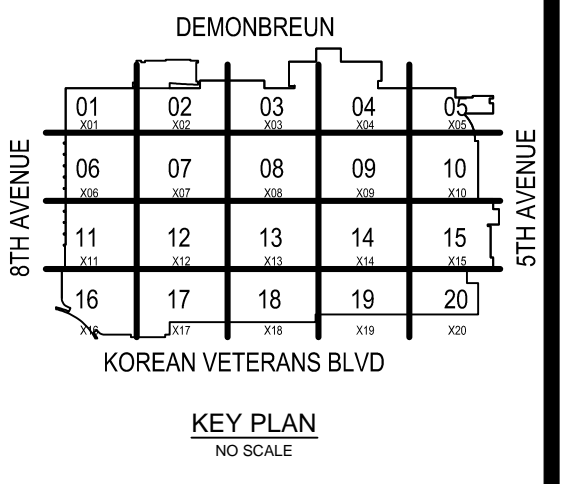

COORDINATION SIGN-OFF

COMPANY	TRADE	DATE
CONTI	ELEC.	/ /
		/ /
		/ /
Music City Center
 Nashville, Tennessee

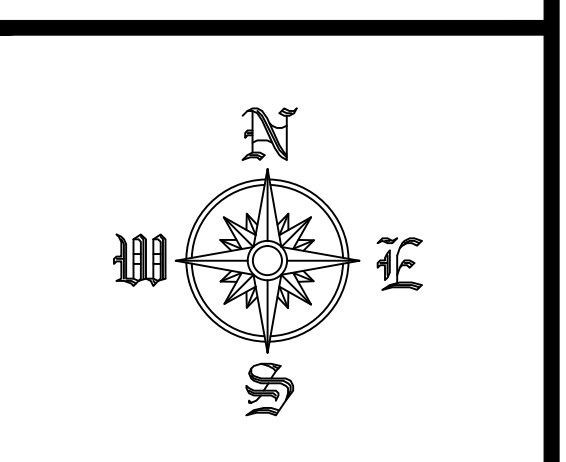

REVISIONS

NO.	DATE	DESCRIPTION

RECORD DRAWINGS STAMP

CONTI ELECTRIC DATE (Last Update):
 2/21/2012 12:44 PM

DRAWING FILE NAME:
 EL2-217

CAD OPERATOR:
 GIBBYAN

PRINTED BY:
 FREDMAN, GREGG


PLOT DATE:
 2/21/2012 2:00 PM

SUBMITTED BY:
 G.P.F.


ASSIGNED TO:

LEVEL 2 LIGHTING
 ZONE 17
 SCALE: 1/8" = 1'-0"

EL2-217

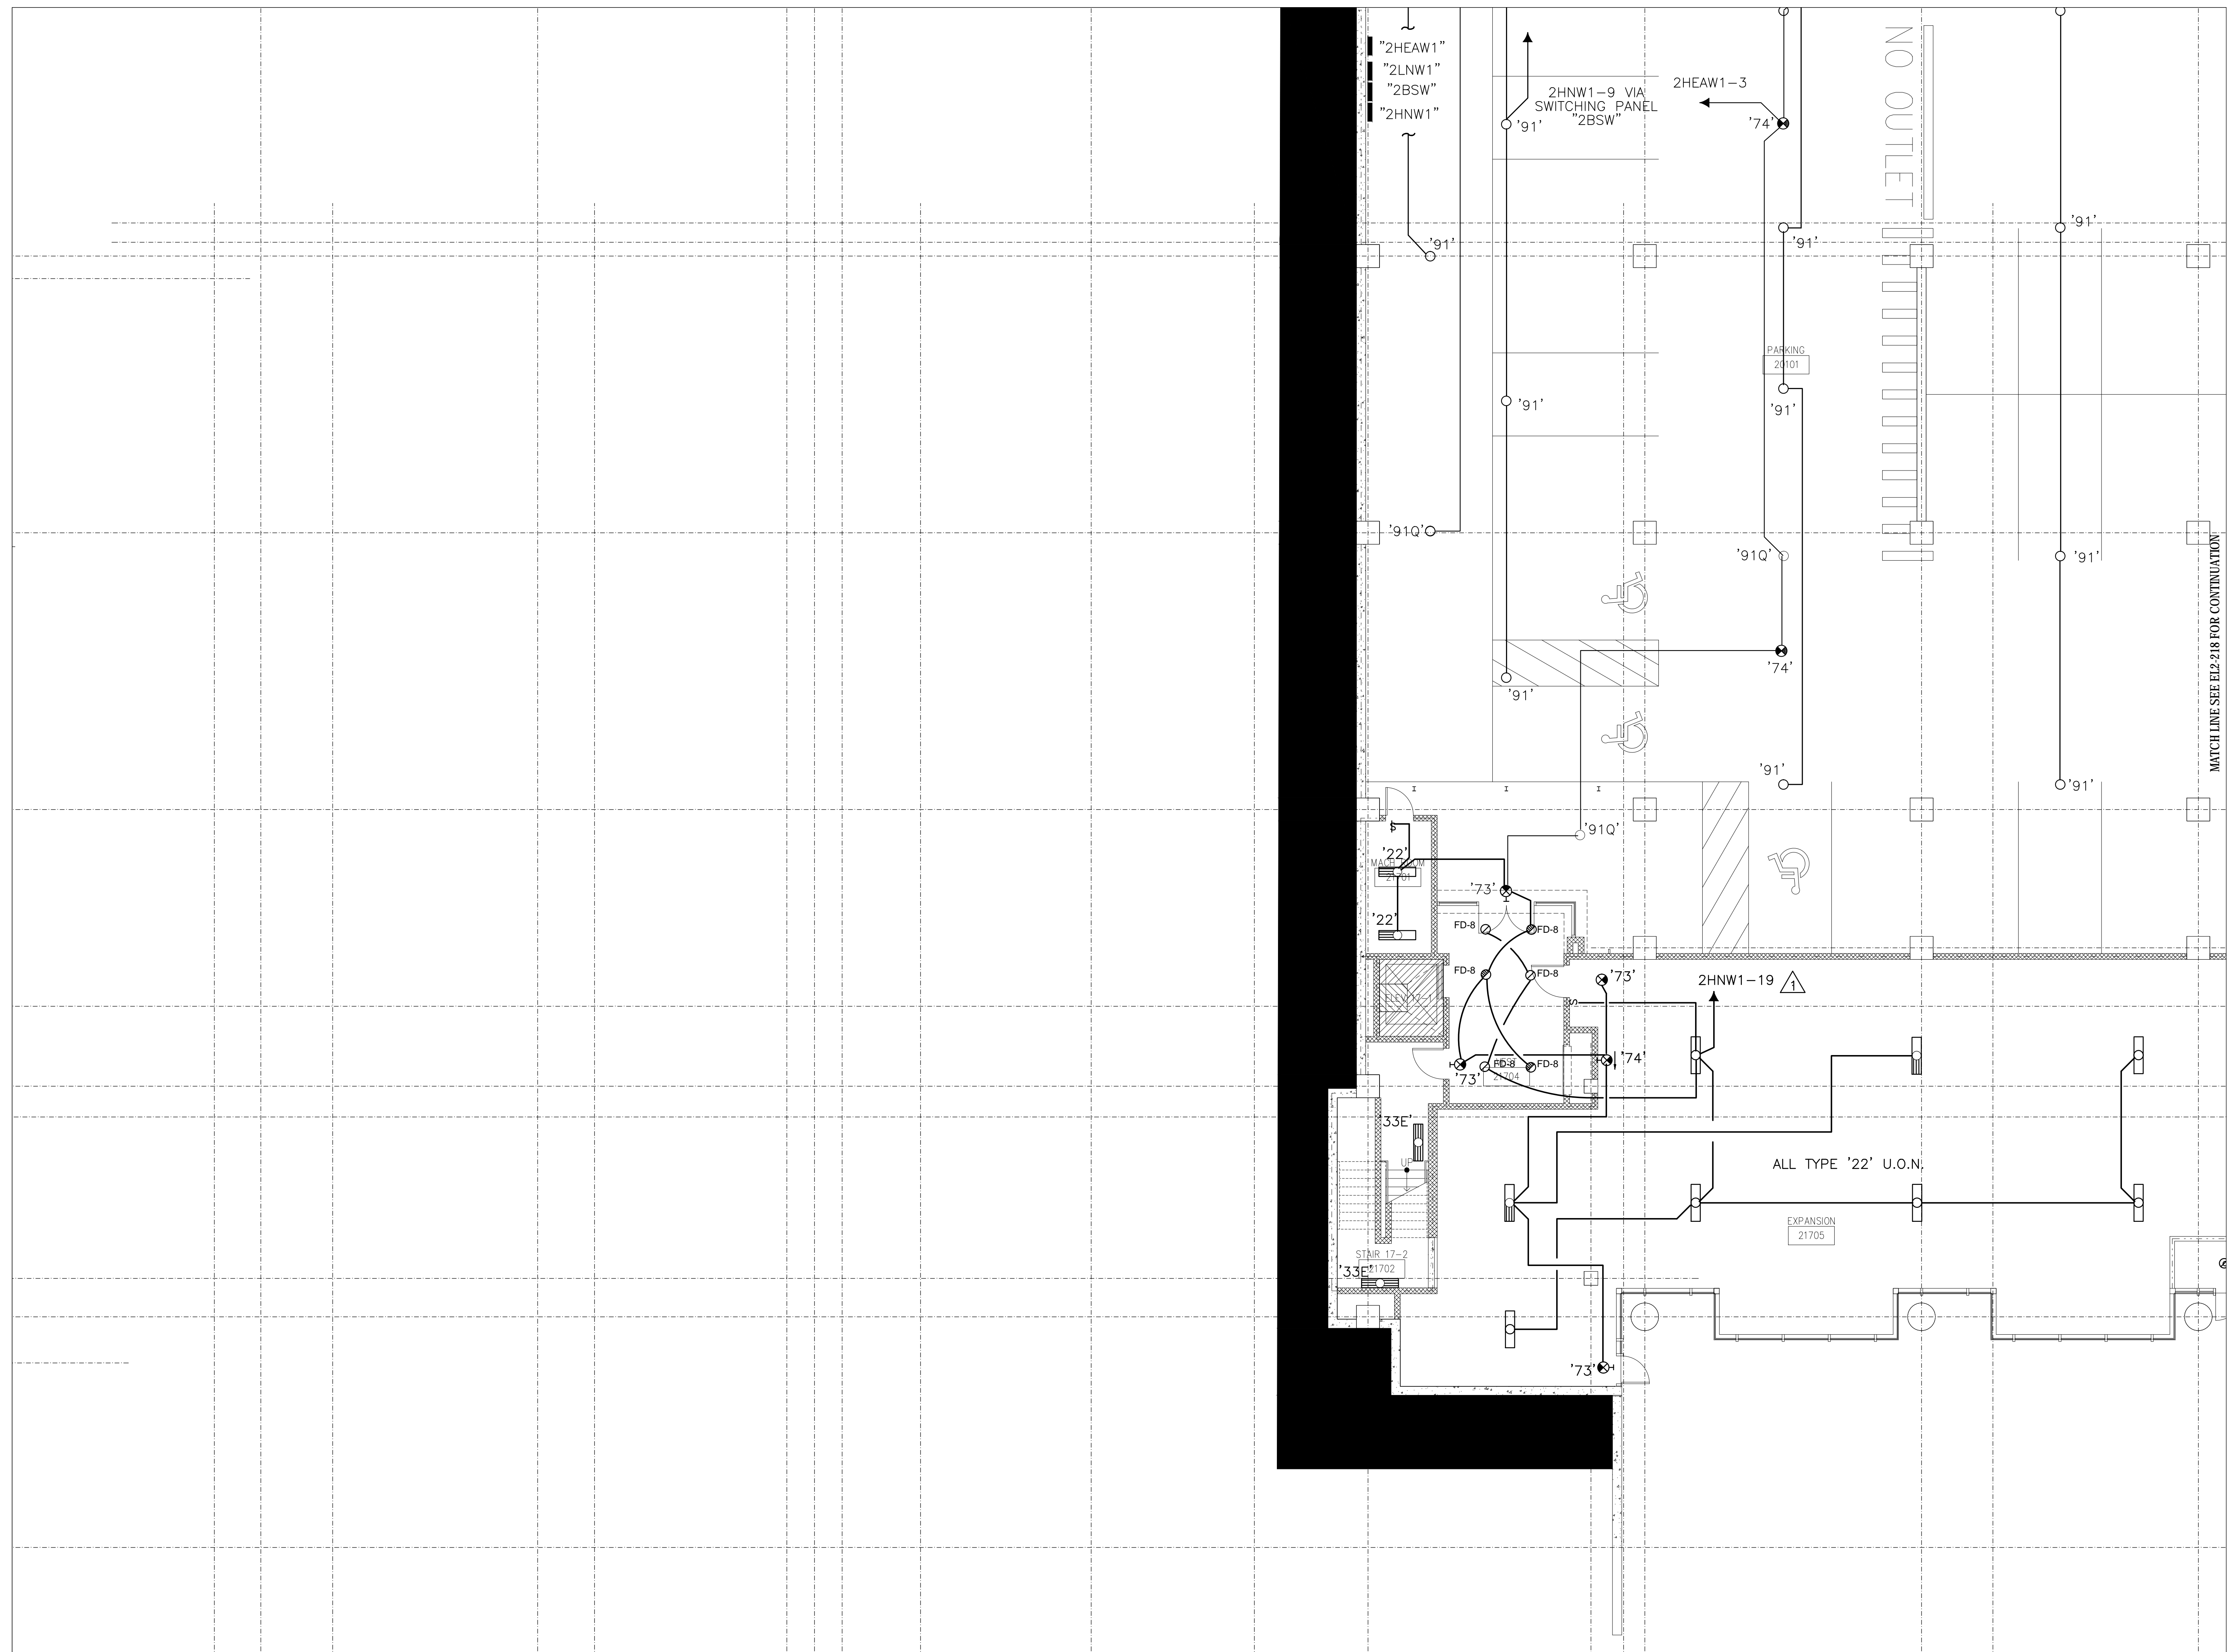


FILE PATH FOR CAD DEPARTMENT USE ONLY: C:\Users\Conti\Documents\Projects\Music City Center\As-Built\4-13-12\Zone 2 Lighting\Zone 2 Lighting.dwg

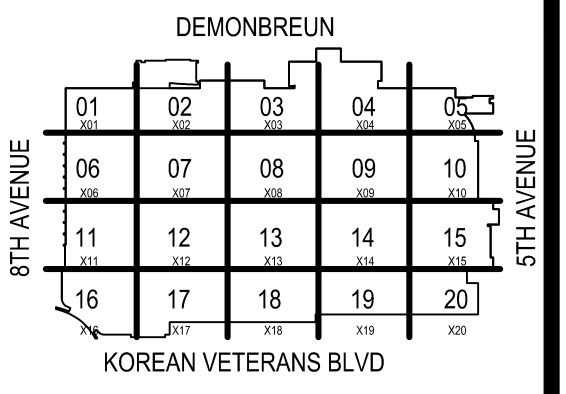

COORDINATION SIGN-OFF	
DATE	/// / /
NAME	/// / /
TRADE	/// / /
ELEC.	/// / /
COMPANY	/// / /
CONTI	/// / /

Music City Center
 Nashville, Tennessee

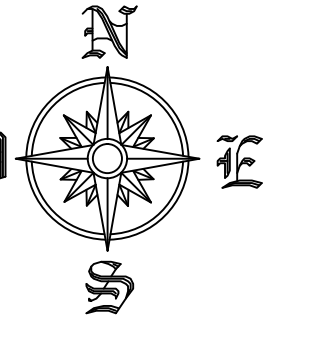


REVISIONS		
NO.	DATE	DESCRIPTION


RECORD DRAWINGS STAMP

CONTELECTRIC DATE (Last Update): 2/21/2012 12:44 PM
 DRAWING FILE NAME: EL2-18
 CAD OPERATOR: GEMMAN
 PRINTED BY: GEMMAN, GREGG
 PLOT DATE: 2/21/2012 2:00 PM
 SUBMITTED BY: GEMMAN
 ASSIGNED TO:

LEVEL 2 LIGHTING
 ZONE 18
 SCALE: 1/8" = 1'-0"


EL2-218

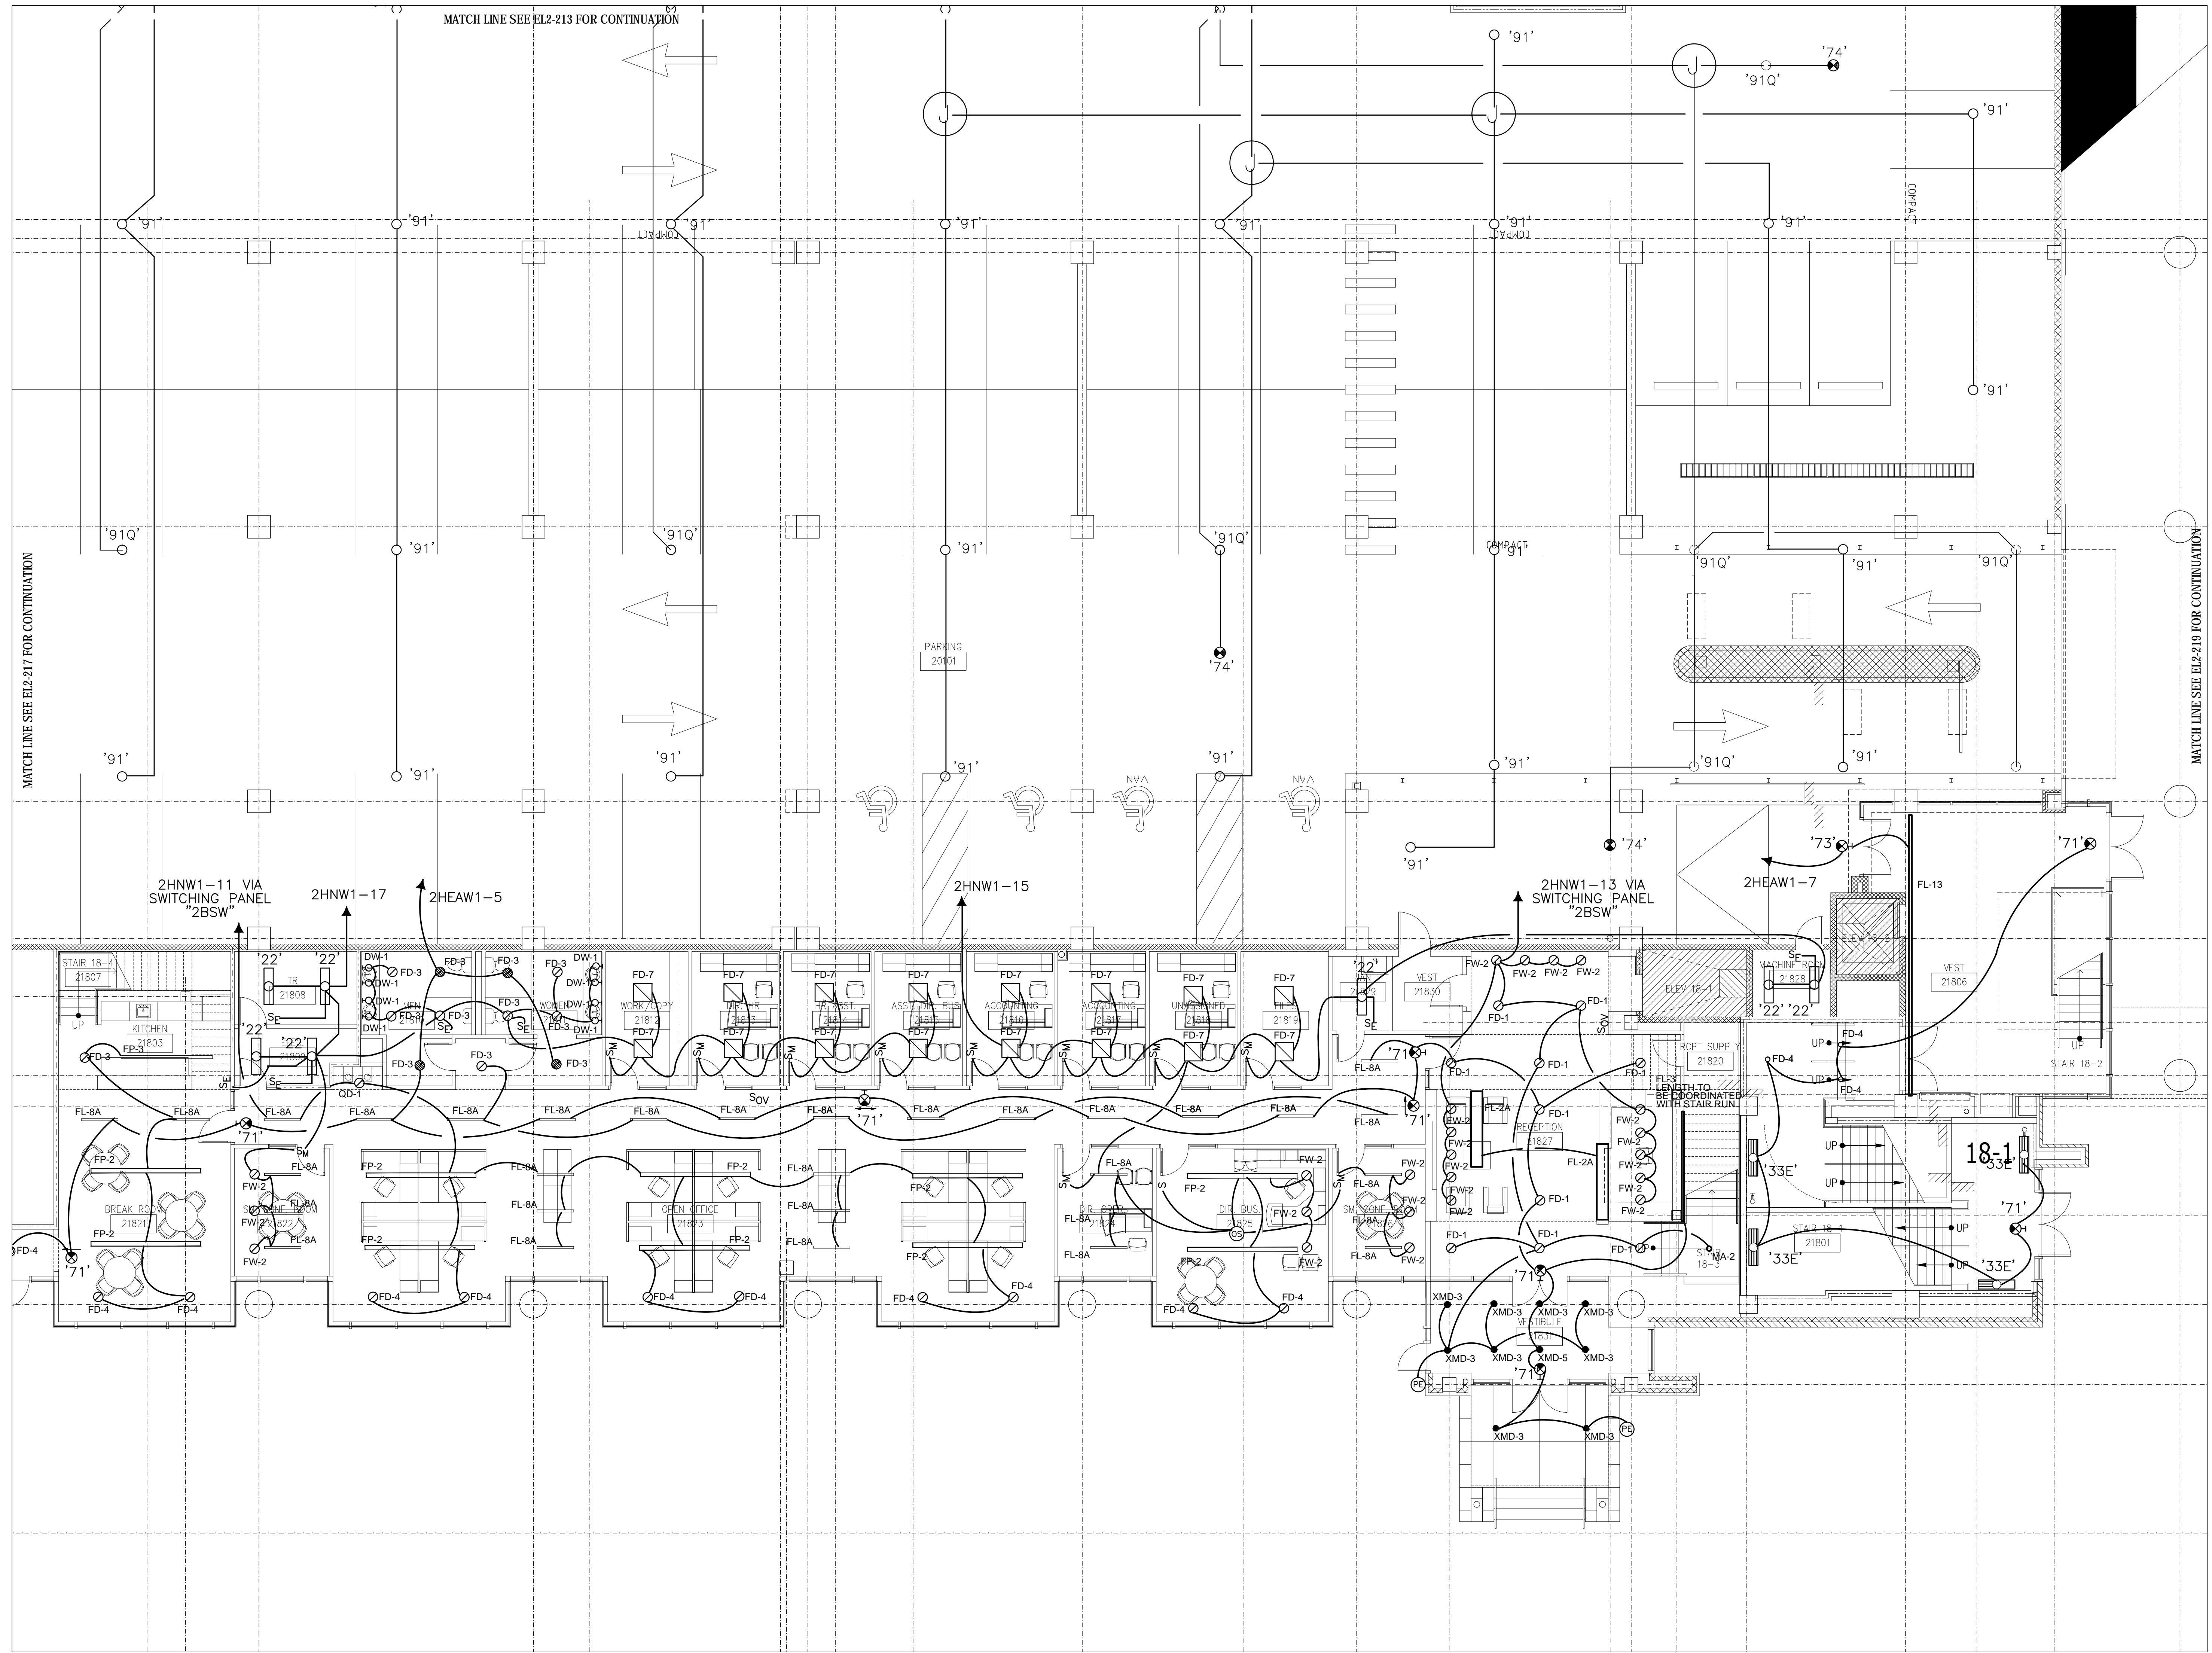

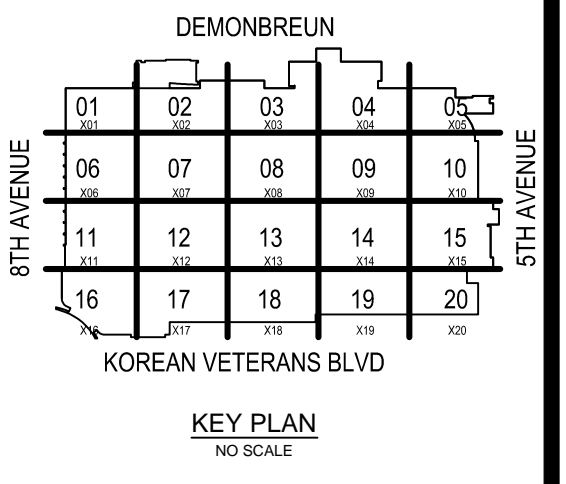

COORDINATION SIGN-OFF	
COMPANY	DATE
NAME	/ /
TRADE	/ /
ELEC.	/ /
CONTI	/ /

Music City Center
 Nashville, Tennessee

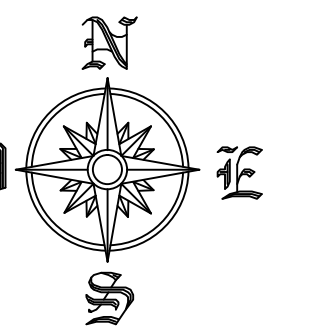

REVISIONS		
NO.	DATE	DESCRIPTION

RECORD DRAWINGS STAMP

CONTI ELECTRIC DATE (Last Update):
 2/21/2012 10:47 AM

DRAWING FILE NAME:
 EL2-19

CAD OPERATOR:
 GERRITMAN

PRINTED BY:
 FREDMAN, GREG


PLOT DATE:
 2/21/2012 2:00 PM


SUBMITTED BY:
 G.L.P.

ASSIGNED TO:

LEVEL 2 LIGHTING
 ZONE 19
 SCALE: 1/8" = 1'-0"

EL2-219

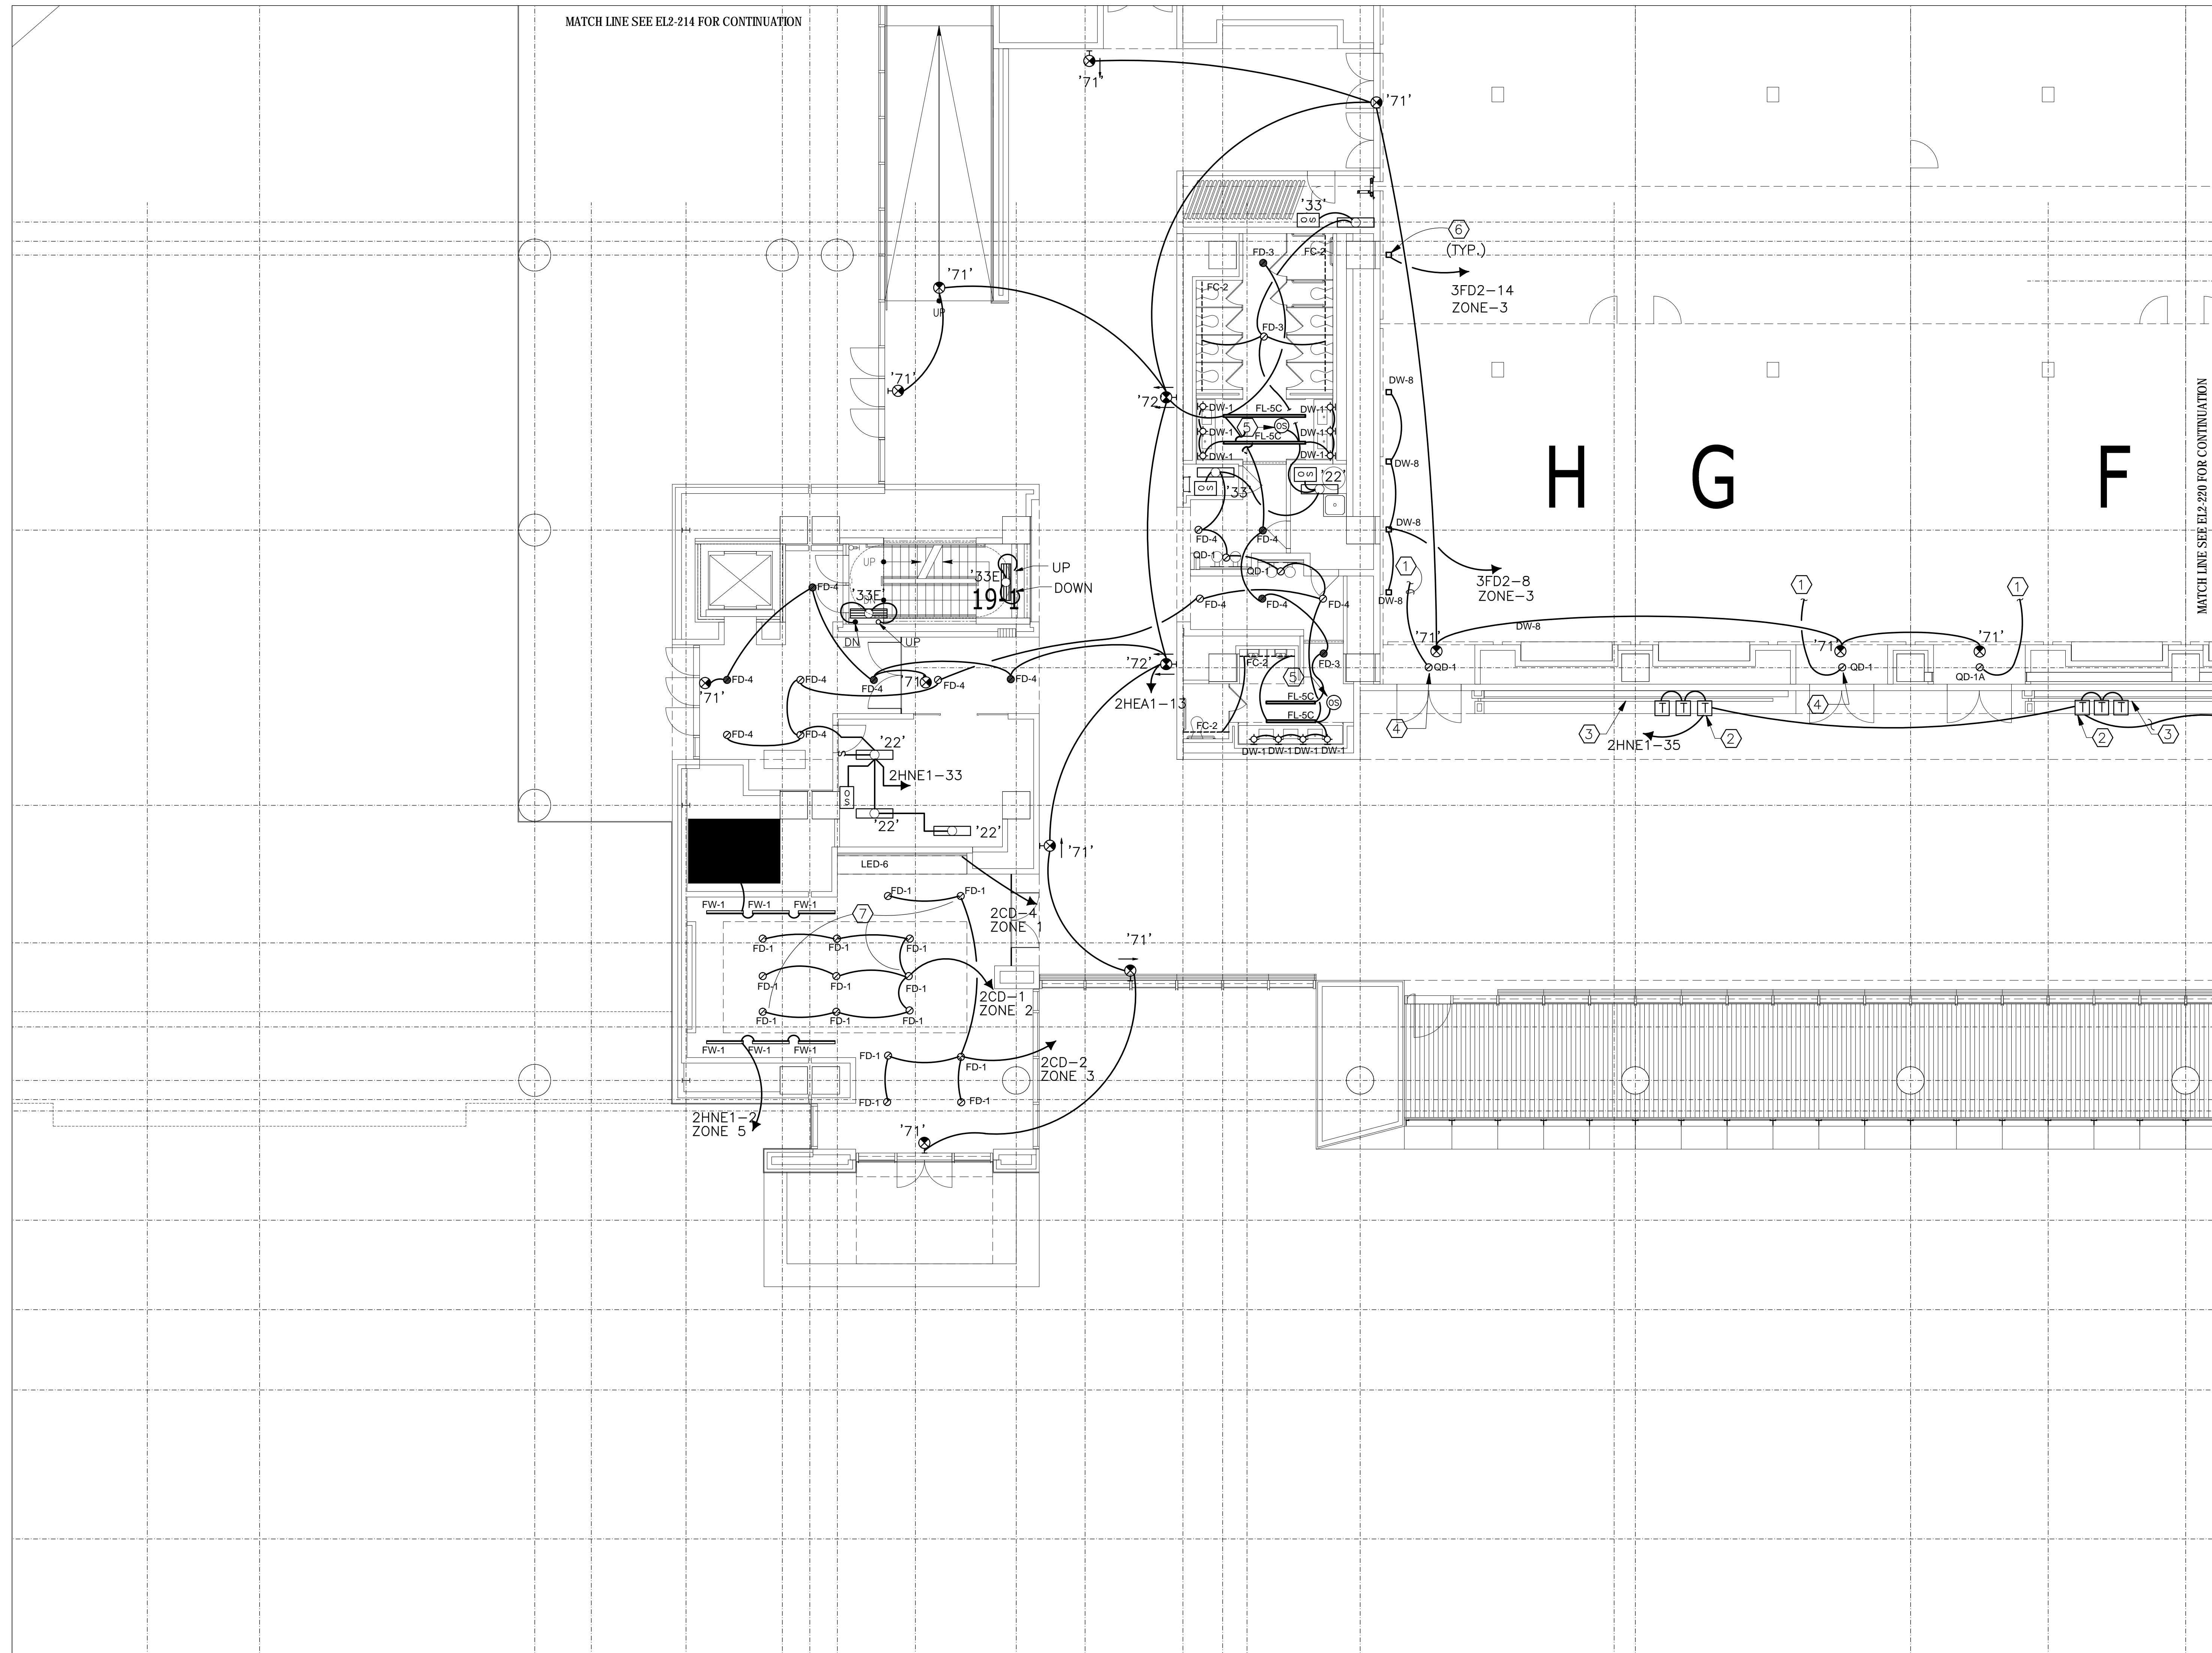


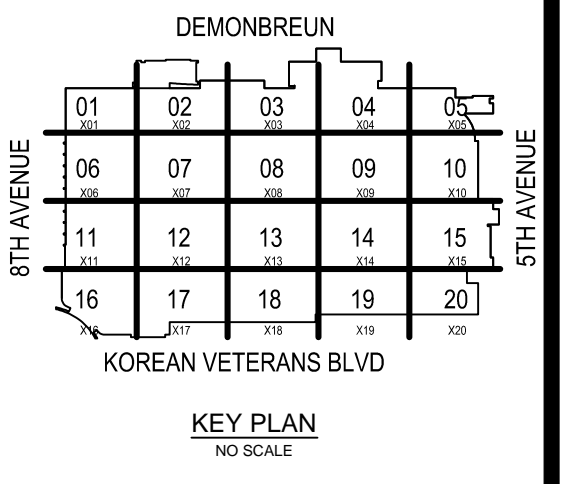

COORDINATION SIGN-OFF

COMPANY	TRADE	DATE
CONTI	ELEC.	/ /
		/ /
		/ /
		/ /
		/ /

Music City Center
 Nashville, Tennessee

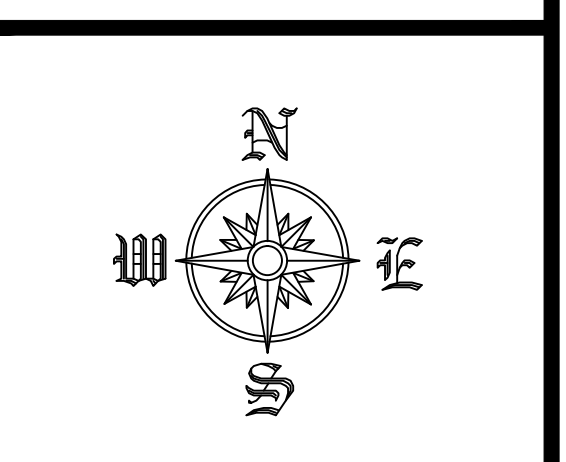

REVISIONS

NO.	DATE	DESCRIPTION

RECORD DRAWINGS STAMP

CONTELECTRIC DATE (Last Update):
 2/21/2012 10:47 AM

DRAWING FILE NAME:
 EL2-20

CAD OPERATOR:
 GERTMAN

PRINTED BY:
 FREDMAN, GREG

PLOT DATE:
 2/21/2012 2:00 PM

SUBMITTED BY:
 G.P.

ASSIGNED TO:

LEVEL 2 LIGHTING
 ZONE 20
 SCALE: 1/8" = 1'-0"

EL2-220

