


COORDINATION SIGN-OFF

COMPANY	TRADE	NAME	DATE
CONTI	ELEC.		/ /
			/ /
			/ /
			/ /
			/ /

Music City Center  
Nashville, Tennessee

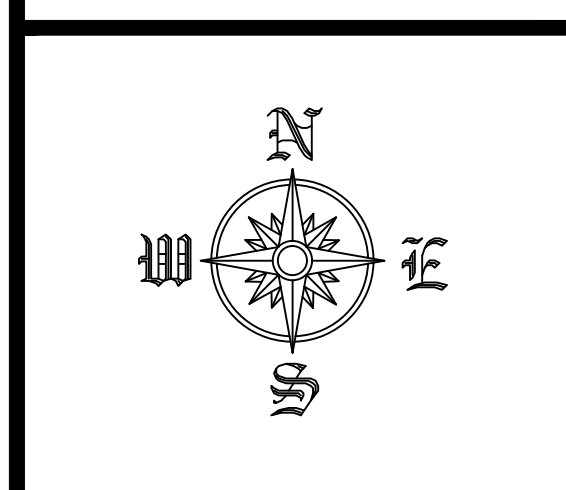

REVISIONS

NO.	DATE	DESCRIPTION



RECORD DRAWINGS STAMP

CONTI ELECTRIC DATE (Last Update): 2/21/2012 11:00 AM  
 DRAWING FILE NAME: E22-301  
 CAD OPERATOR: GERRMAN  
 PRINTED BY: FREYMAN, GREGG  
 PLOT DATE: 2/21/2012 2:02 PM  
 SUBMITTED BY: G.L.F.  
 ASSIGNED TO:

LEVEL 3 LIGHTING  
 ZONE 1  
 SCALE: 1/8" = 1'-0"


EL2-301

FILE PATH FOR CAD OPERATOR USE ONLY: P:\2008\Conti Electric\Nashville\_MusicCity\_City Center As-Built\4-301\Zone 1 Lighting\_Schedule For Opening.dwg

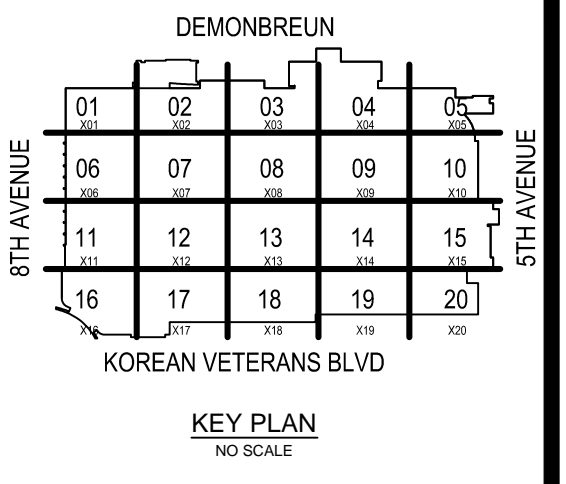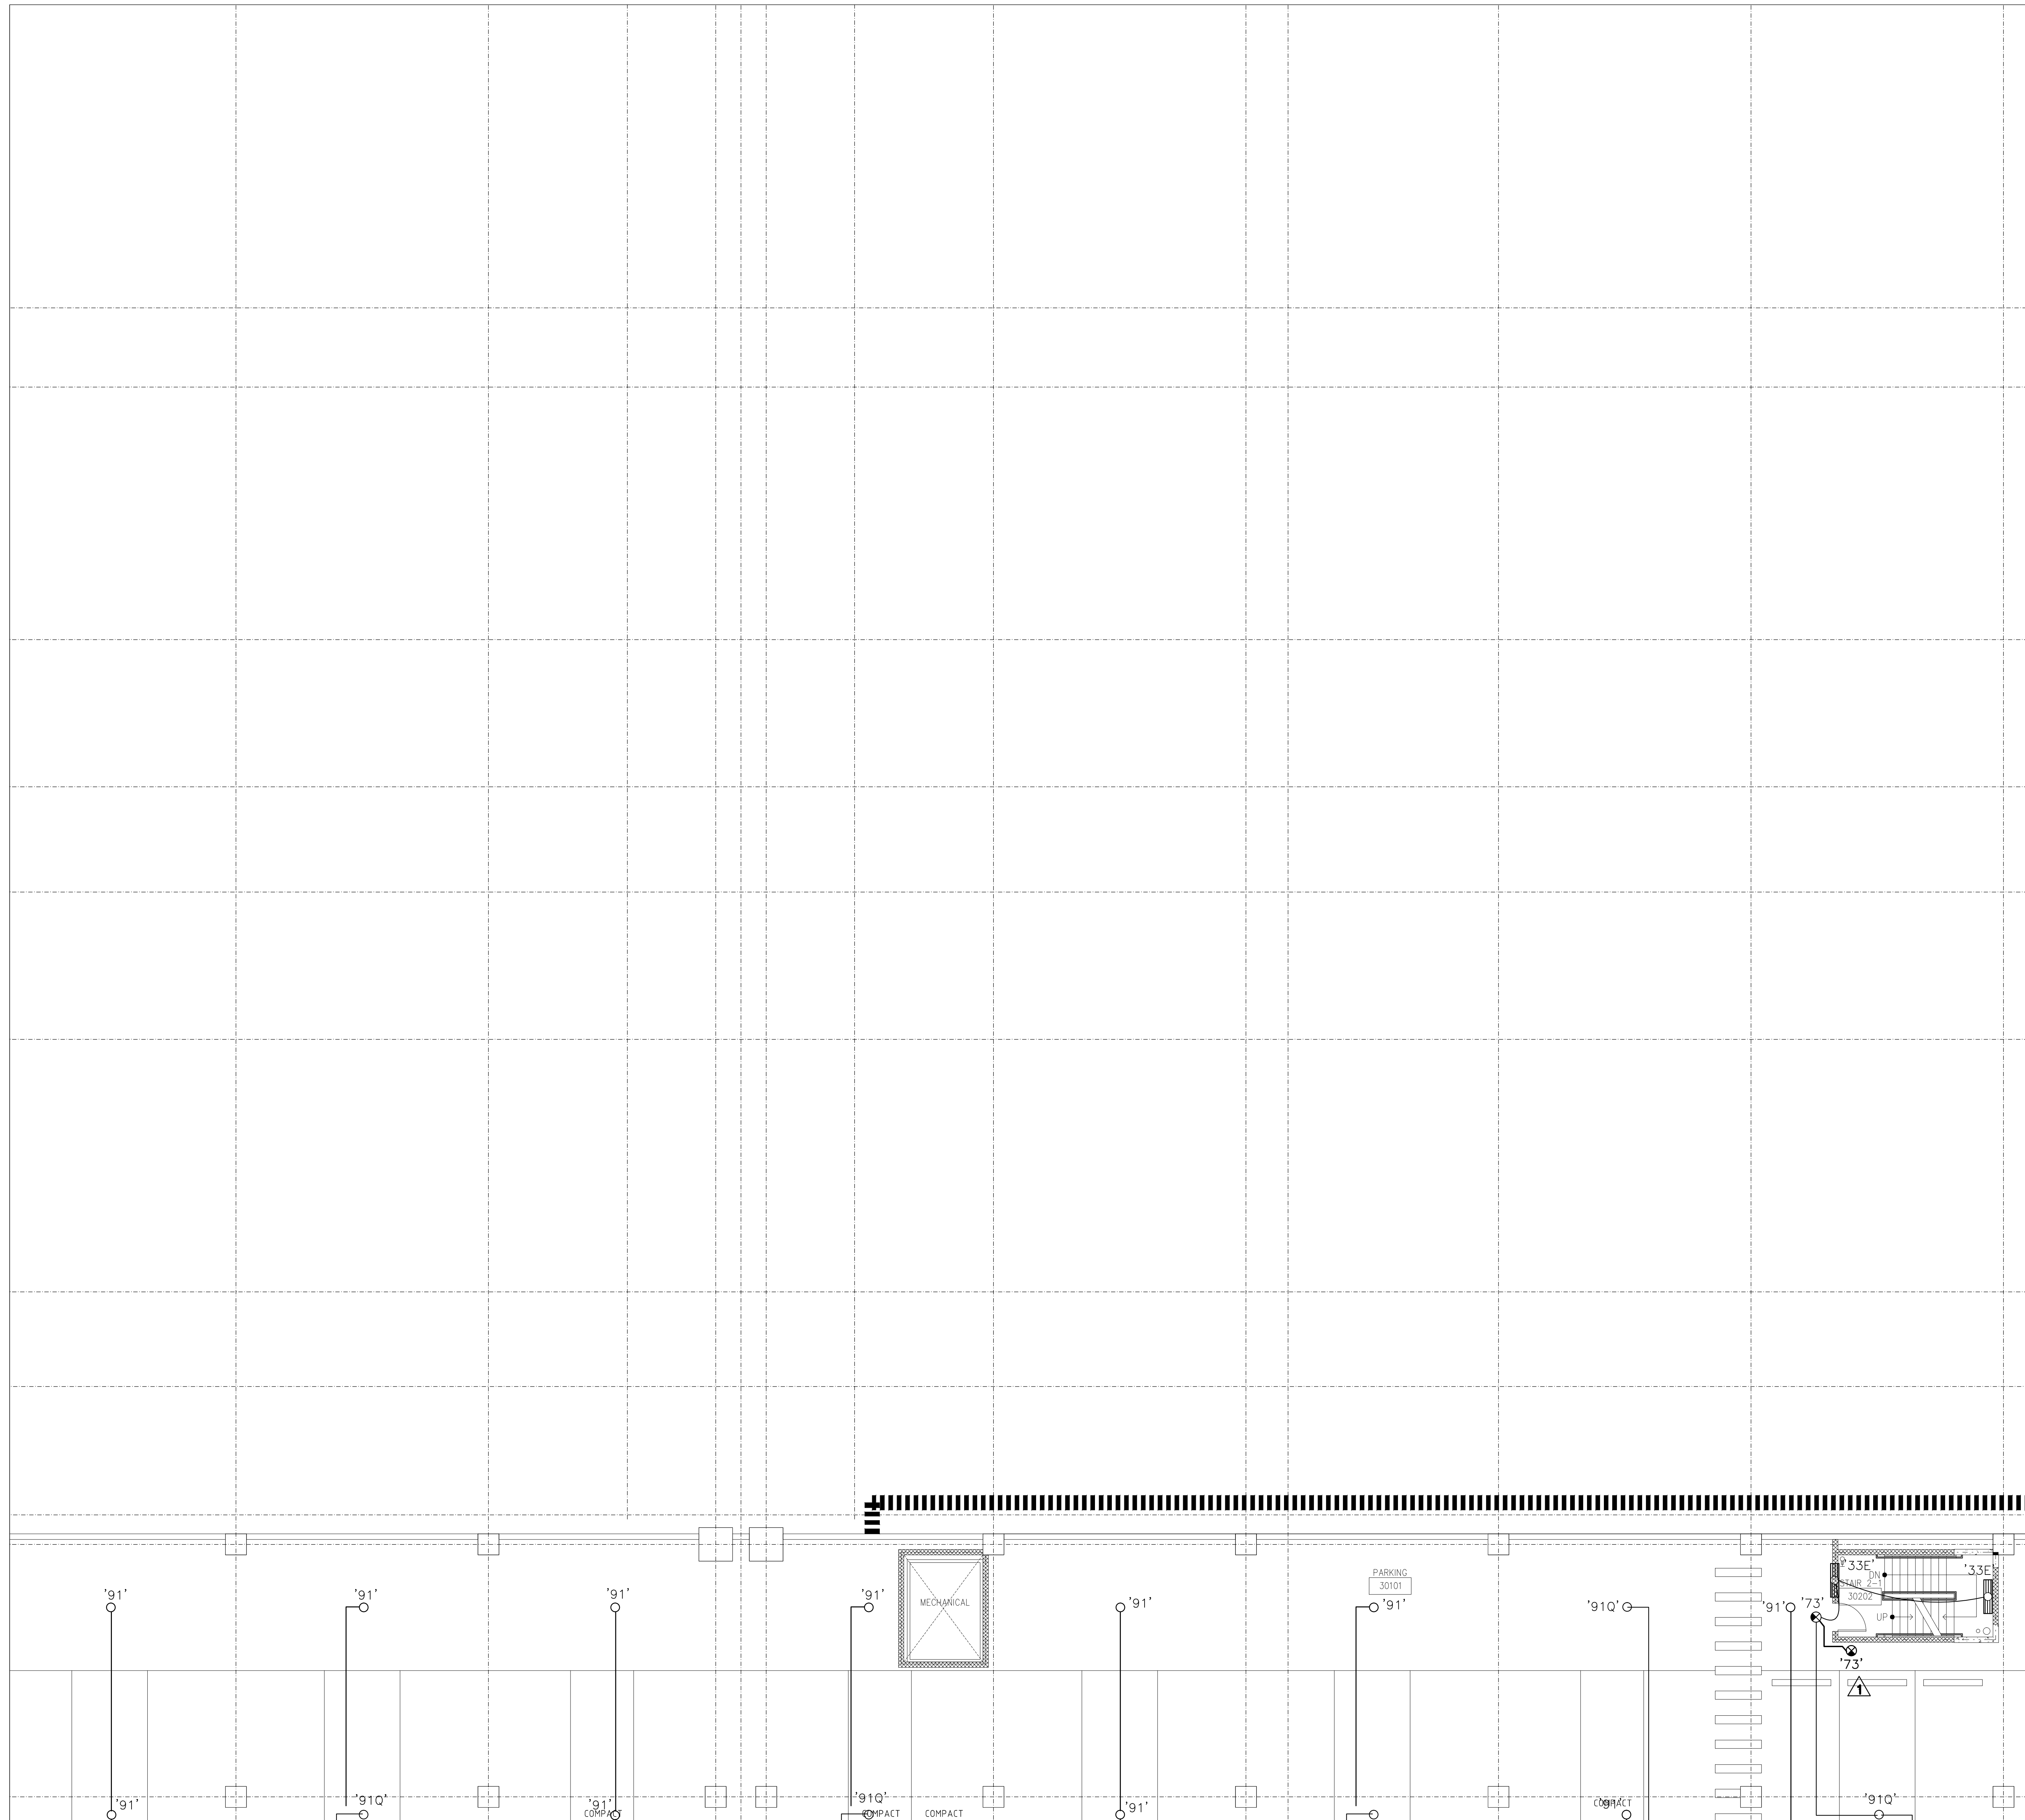

COORDINATION SIGN-OFF				
COMPANY	TRADE	NAME	DATE	
CONTI	ELEC.		/ /	
			/ /	
			/ /	
			/ /	
			/ /	

**Music City Center**  
Nashville, Tennessee

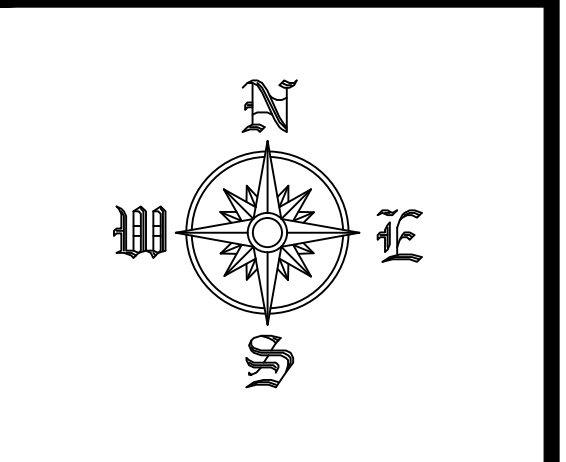

REVISIONS		
NO.	DATE	DESCRIPTION



**RECORD DRAWINGS STAMP**

CONTI ELECTRIC DATE (Last Update): 2/21/2012 11:00 AM  
 DRAWING FILE NAME: E2-302  
 CAD OPERATOR: GERTMAN  
 PRINTED BY: FREDMAN, GREG  
 PLOT DATE: 2/21/2012 2:02 PM  
 SUBMITTED BY: G.P.  
 ASSIGNED TO:

LEVEL 3 LIGHTING  
 ZONE 2  
 SCALE: 1/8" = 1'-0"


EL2-302

FILE PATH FOR CAD OPERATOR USE ONLY: P:\2008\Conti Electric\Nashville MusicCity\Level 3 Lighting\Zone 2 Lighting.dwg

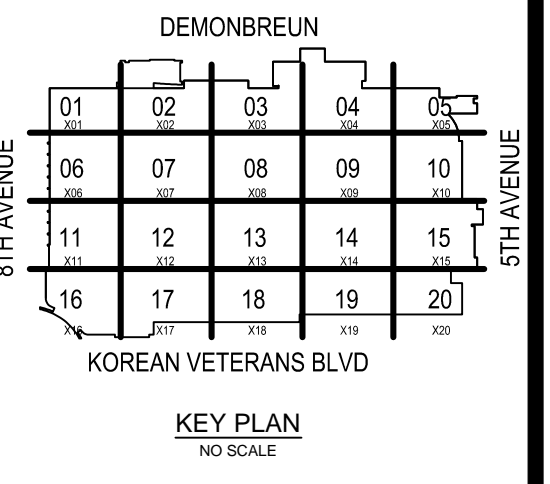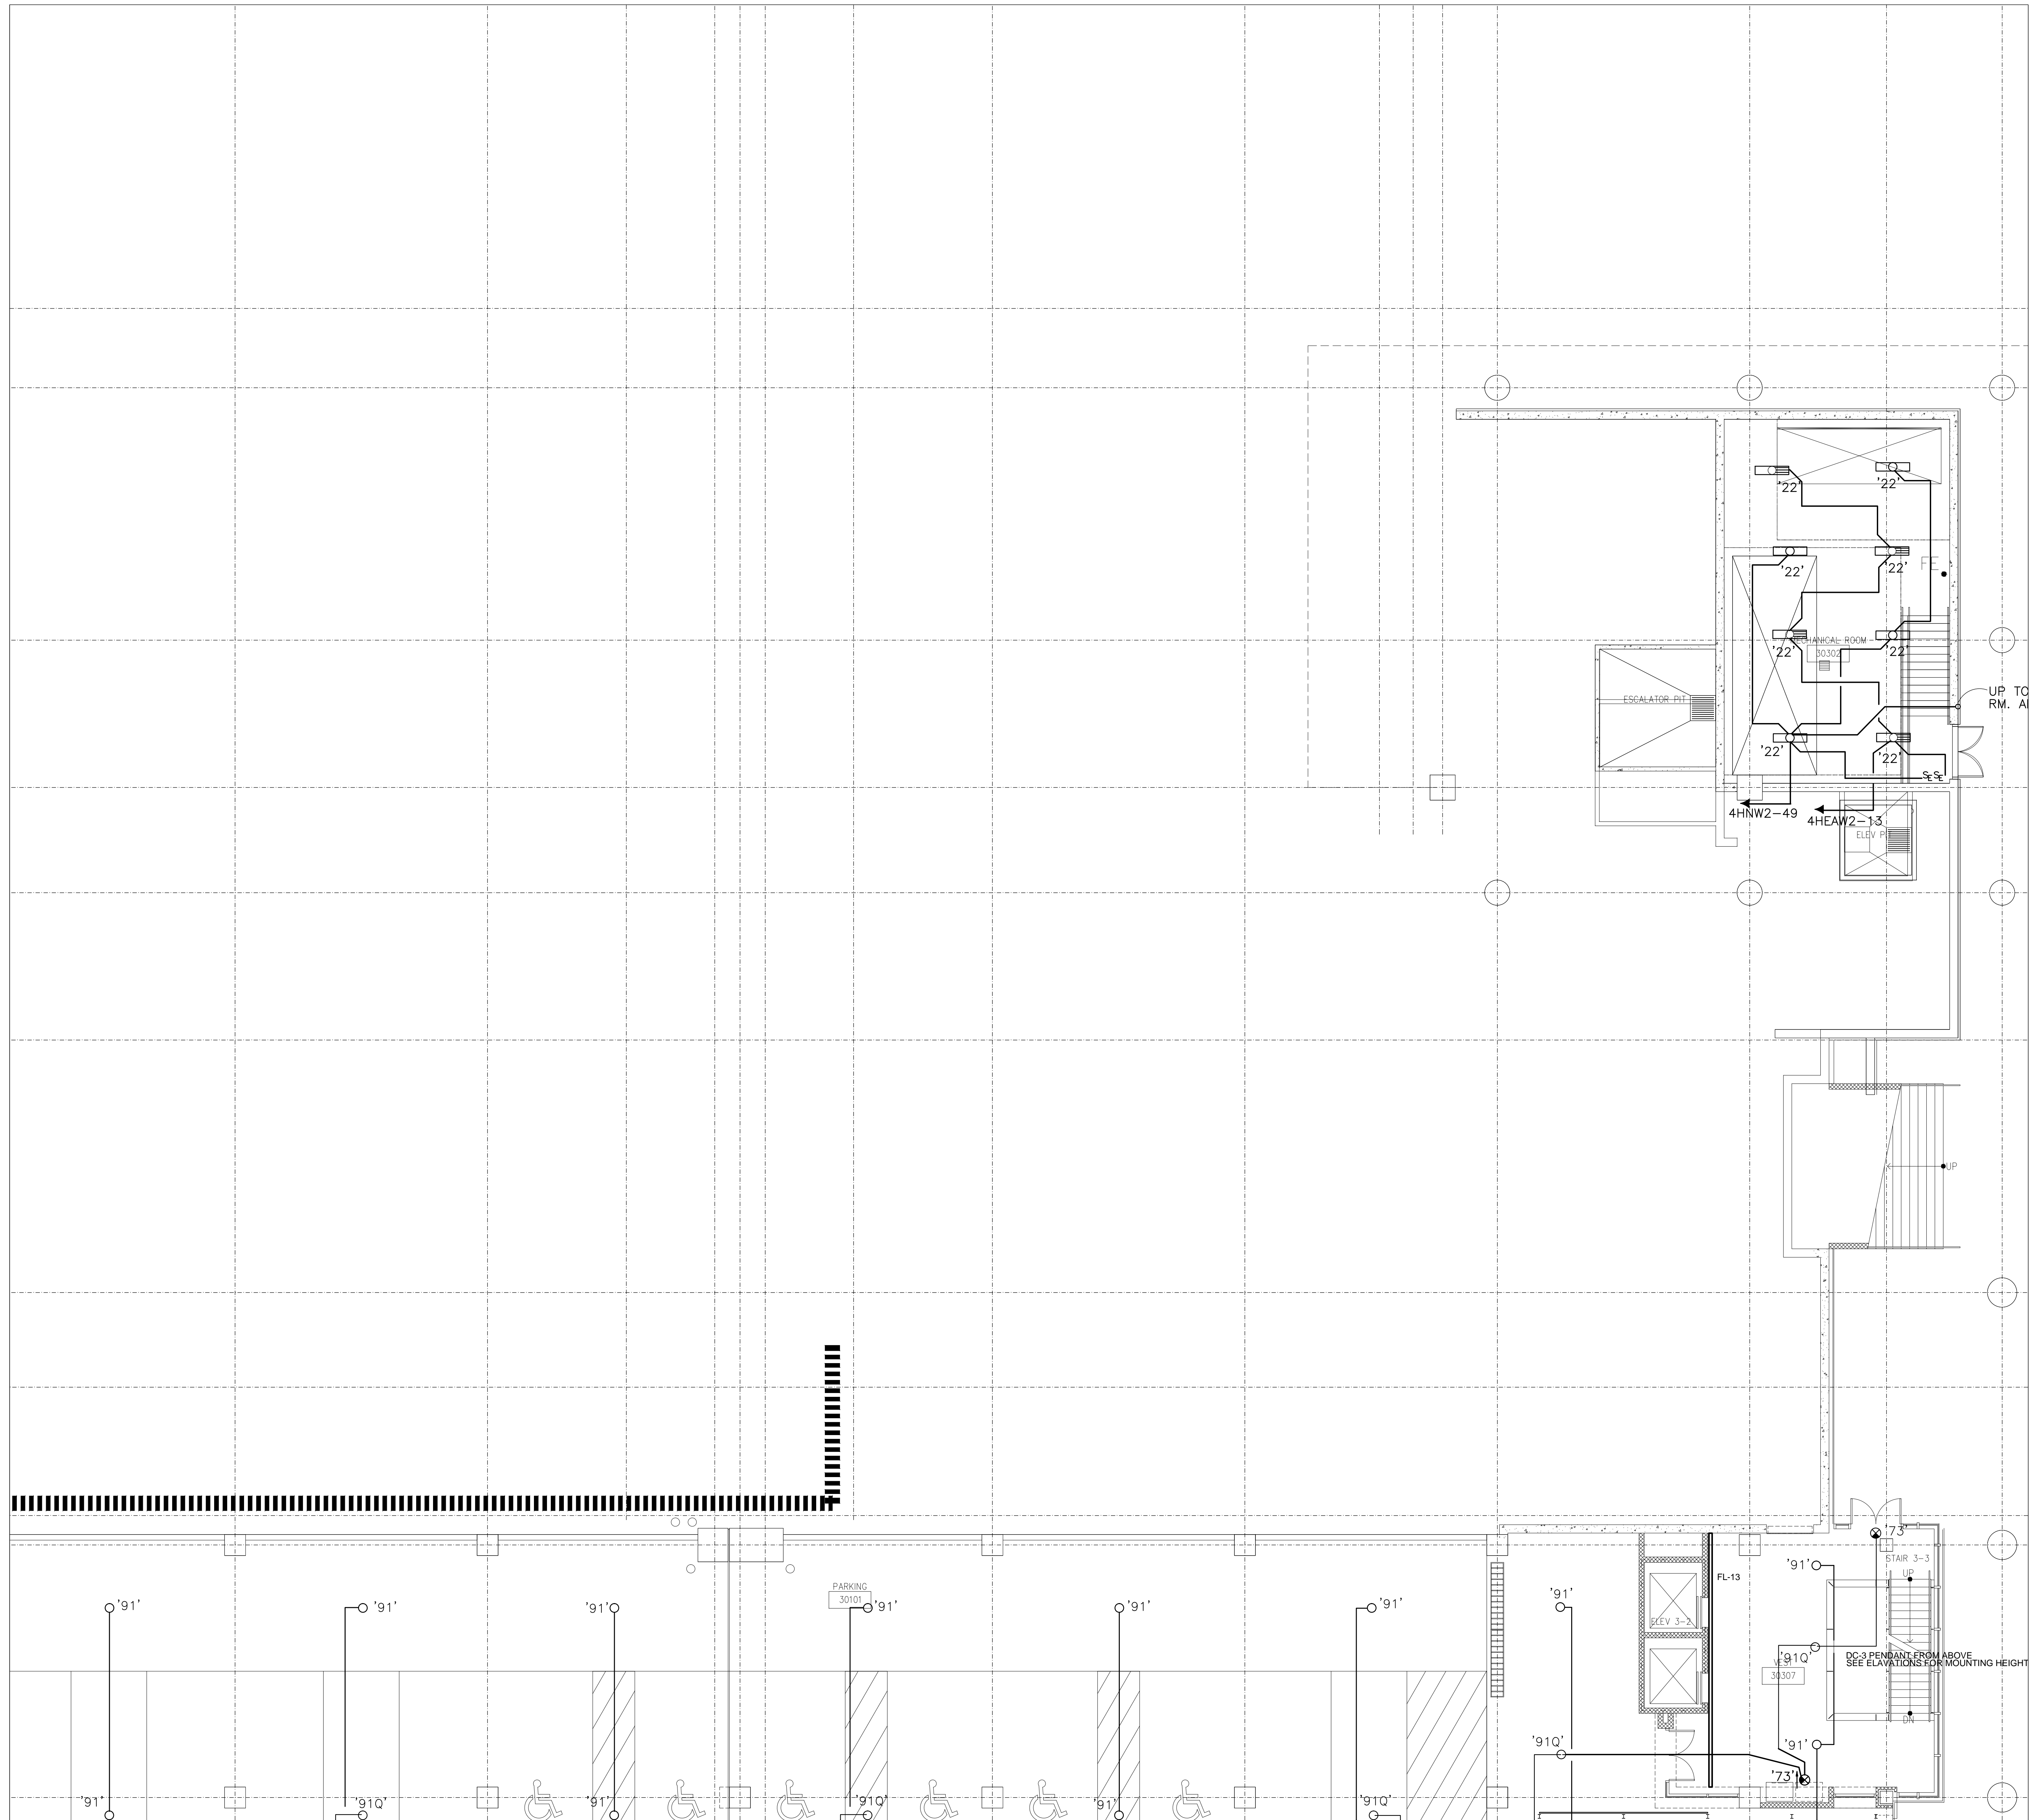

COORDINATION SIGN-OFF		DATE	DATE	DATE	DATE	DATE
COMPANY	TRADE	NAME	NAME	NAME	NAME	NAME
CONTI	ELEC.					

**Music City Center**  
Nashville, Tennessee

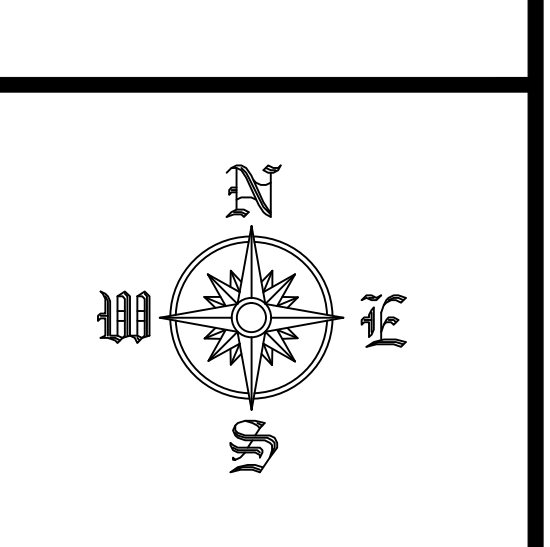

REVISIONS		
NO.	DATE	DESCRIPTION


**RECORD DRAWINGS STAMP**

CONTI ELECTRIC DATE (Last Update): 2/21/2012 10:00 AM  
 DRAWING FILE NAME: E22-303  
 CAD OPERATOR: GERTMAN  
 PRINTED BY: FREDMAN, GREGG  
 PLOT DATE: 2/21/2012 2:02 PM  
 SUBMITTED BY: G.P.F.  
 ASSIGNED TO:

LEVEL 3 LIGHTING  
 ZONE 3  
 SCALE: 1/8" = 1'-0"


EL2-303

FILE PATH: P:\CD\SPRINTMKT\USE ONLY - E:\303\Conti Electric\Nashville MusicCityCenter\_Cty Center As-Built\41313\Level 3 Lighting\_Schedule For Opening.dwg

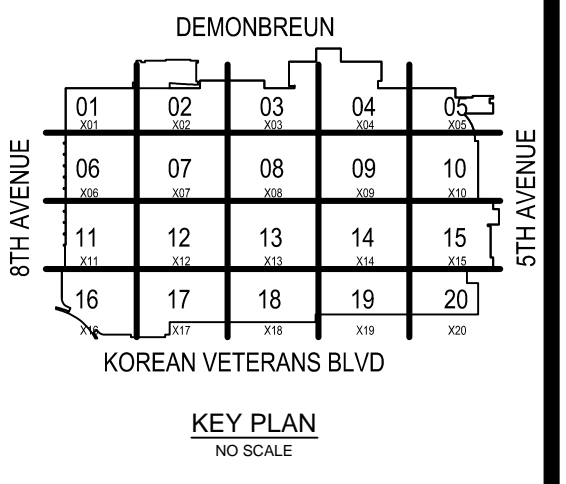

COORDINATION SIGN-OFF		DATE	NAME
COMPANY	TRADE	/ /	
CONTI	ELEC.	/ /	
		/ /	
		/ /	
		/ /	

**Music City Center**  
Nashville, Tennessee

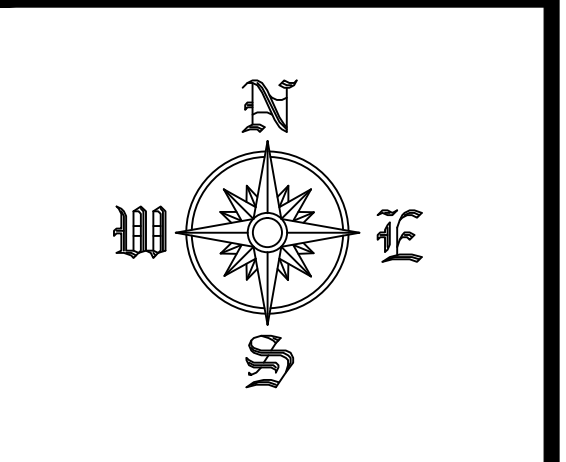


REVISIONS		
NO.	DATE	DESCRIPTION

RECORD DRAWINGS STAMP	
CONTI ELECTRIC DATE (Last Update):	2/21/2012 10:00 AM
DRAWING FILE NAME:	EL2-304
CAD OPERATOR:	SEYMEN
PRINTED BY:	SEYMEN, GREGG
PLOT DATE:	2/21/2012 2:02 PM
SUBMITTED BY:	ELF
ASSIGNED TO:	

LEVEL 3 LIGHTING  
 ZONE 4  
 SCALE: 1/8" = 1'-0"



EL2-304

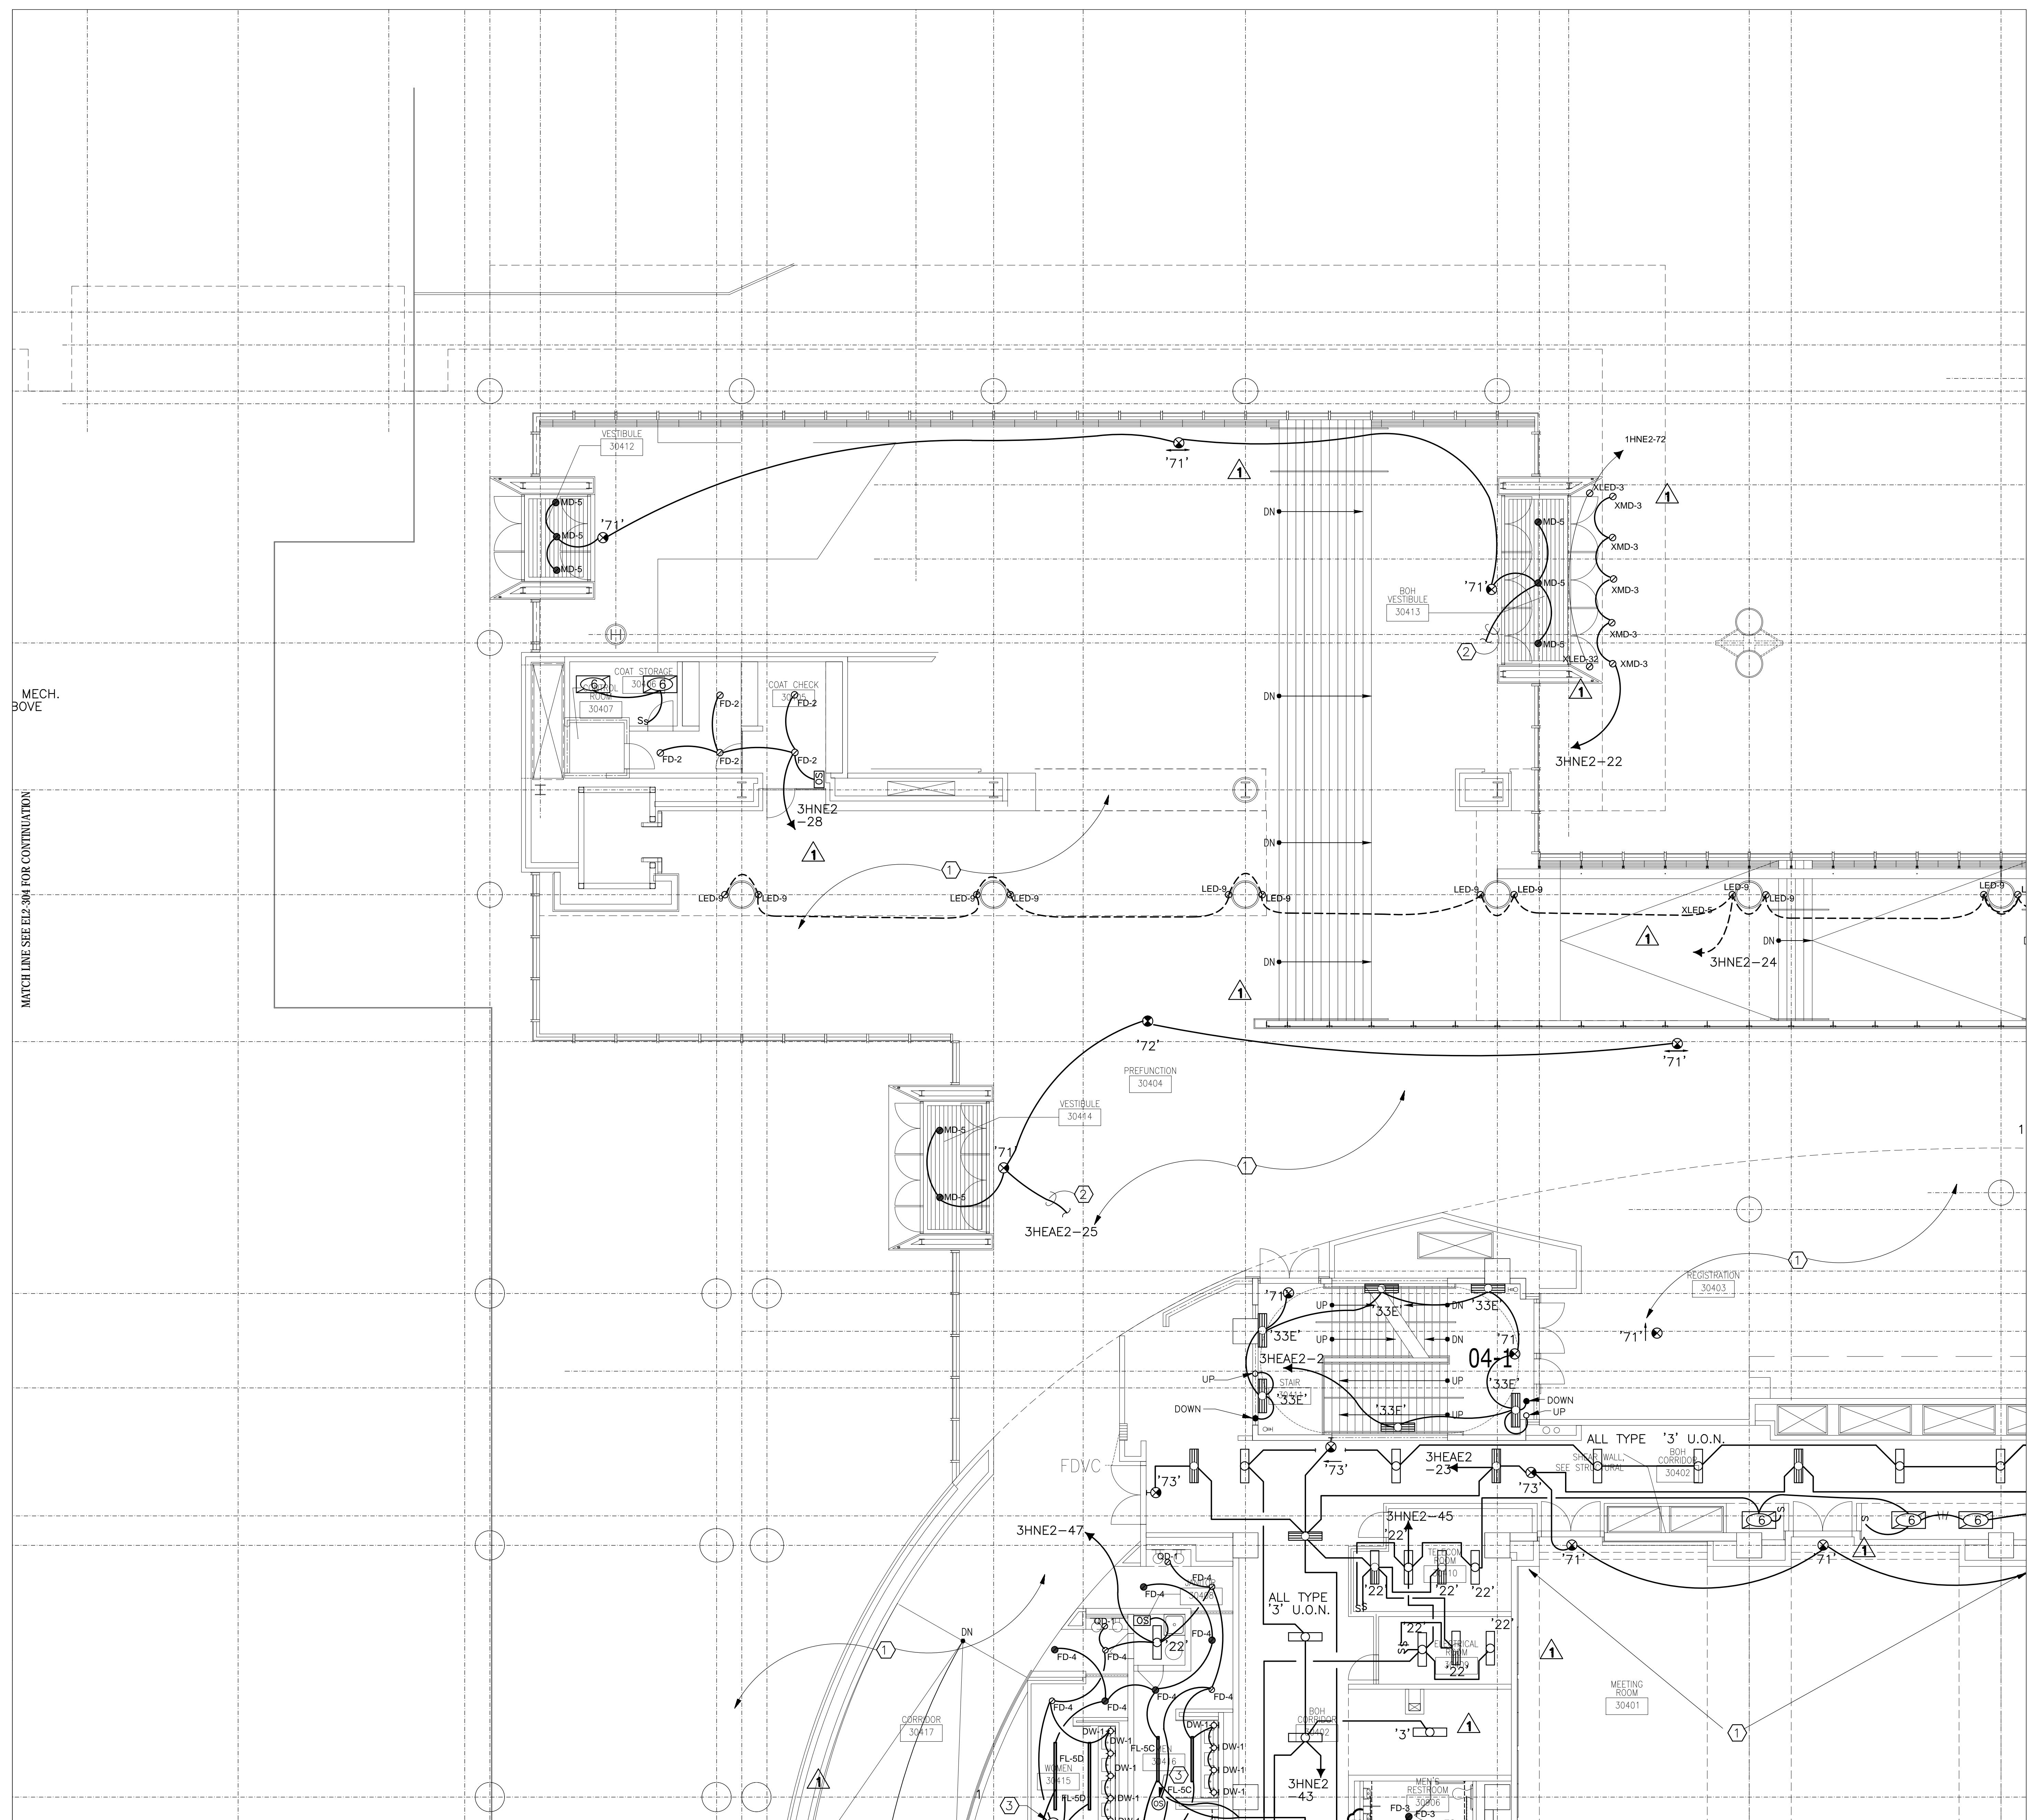

MECH. BOVE


MATCH LINE SEE EL2-304 FOR CONTINUATION

FILE PATH FOR CAD OPERATOR USE ONLY: P:\3000\Conti\Bids\Nashville\_MCC\Zone 4\Bids\4\EL2\Zone 4 Lighting Symbols For Opening

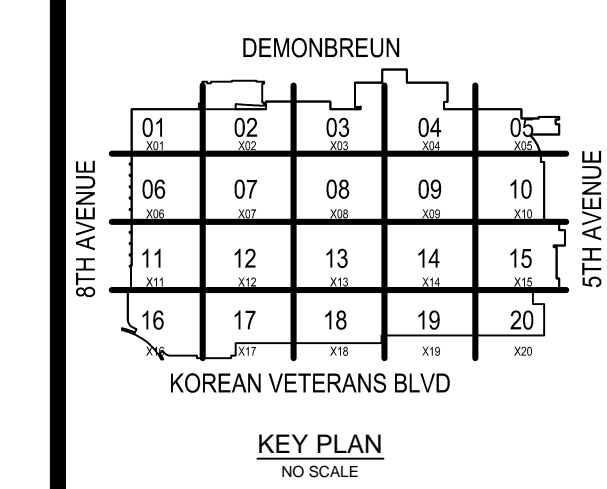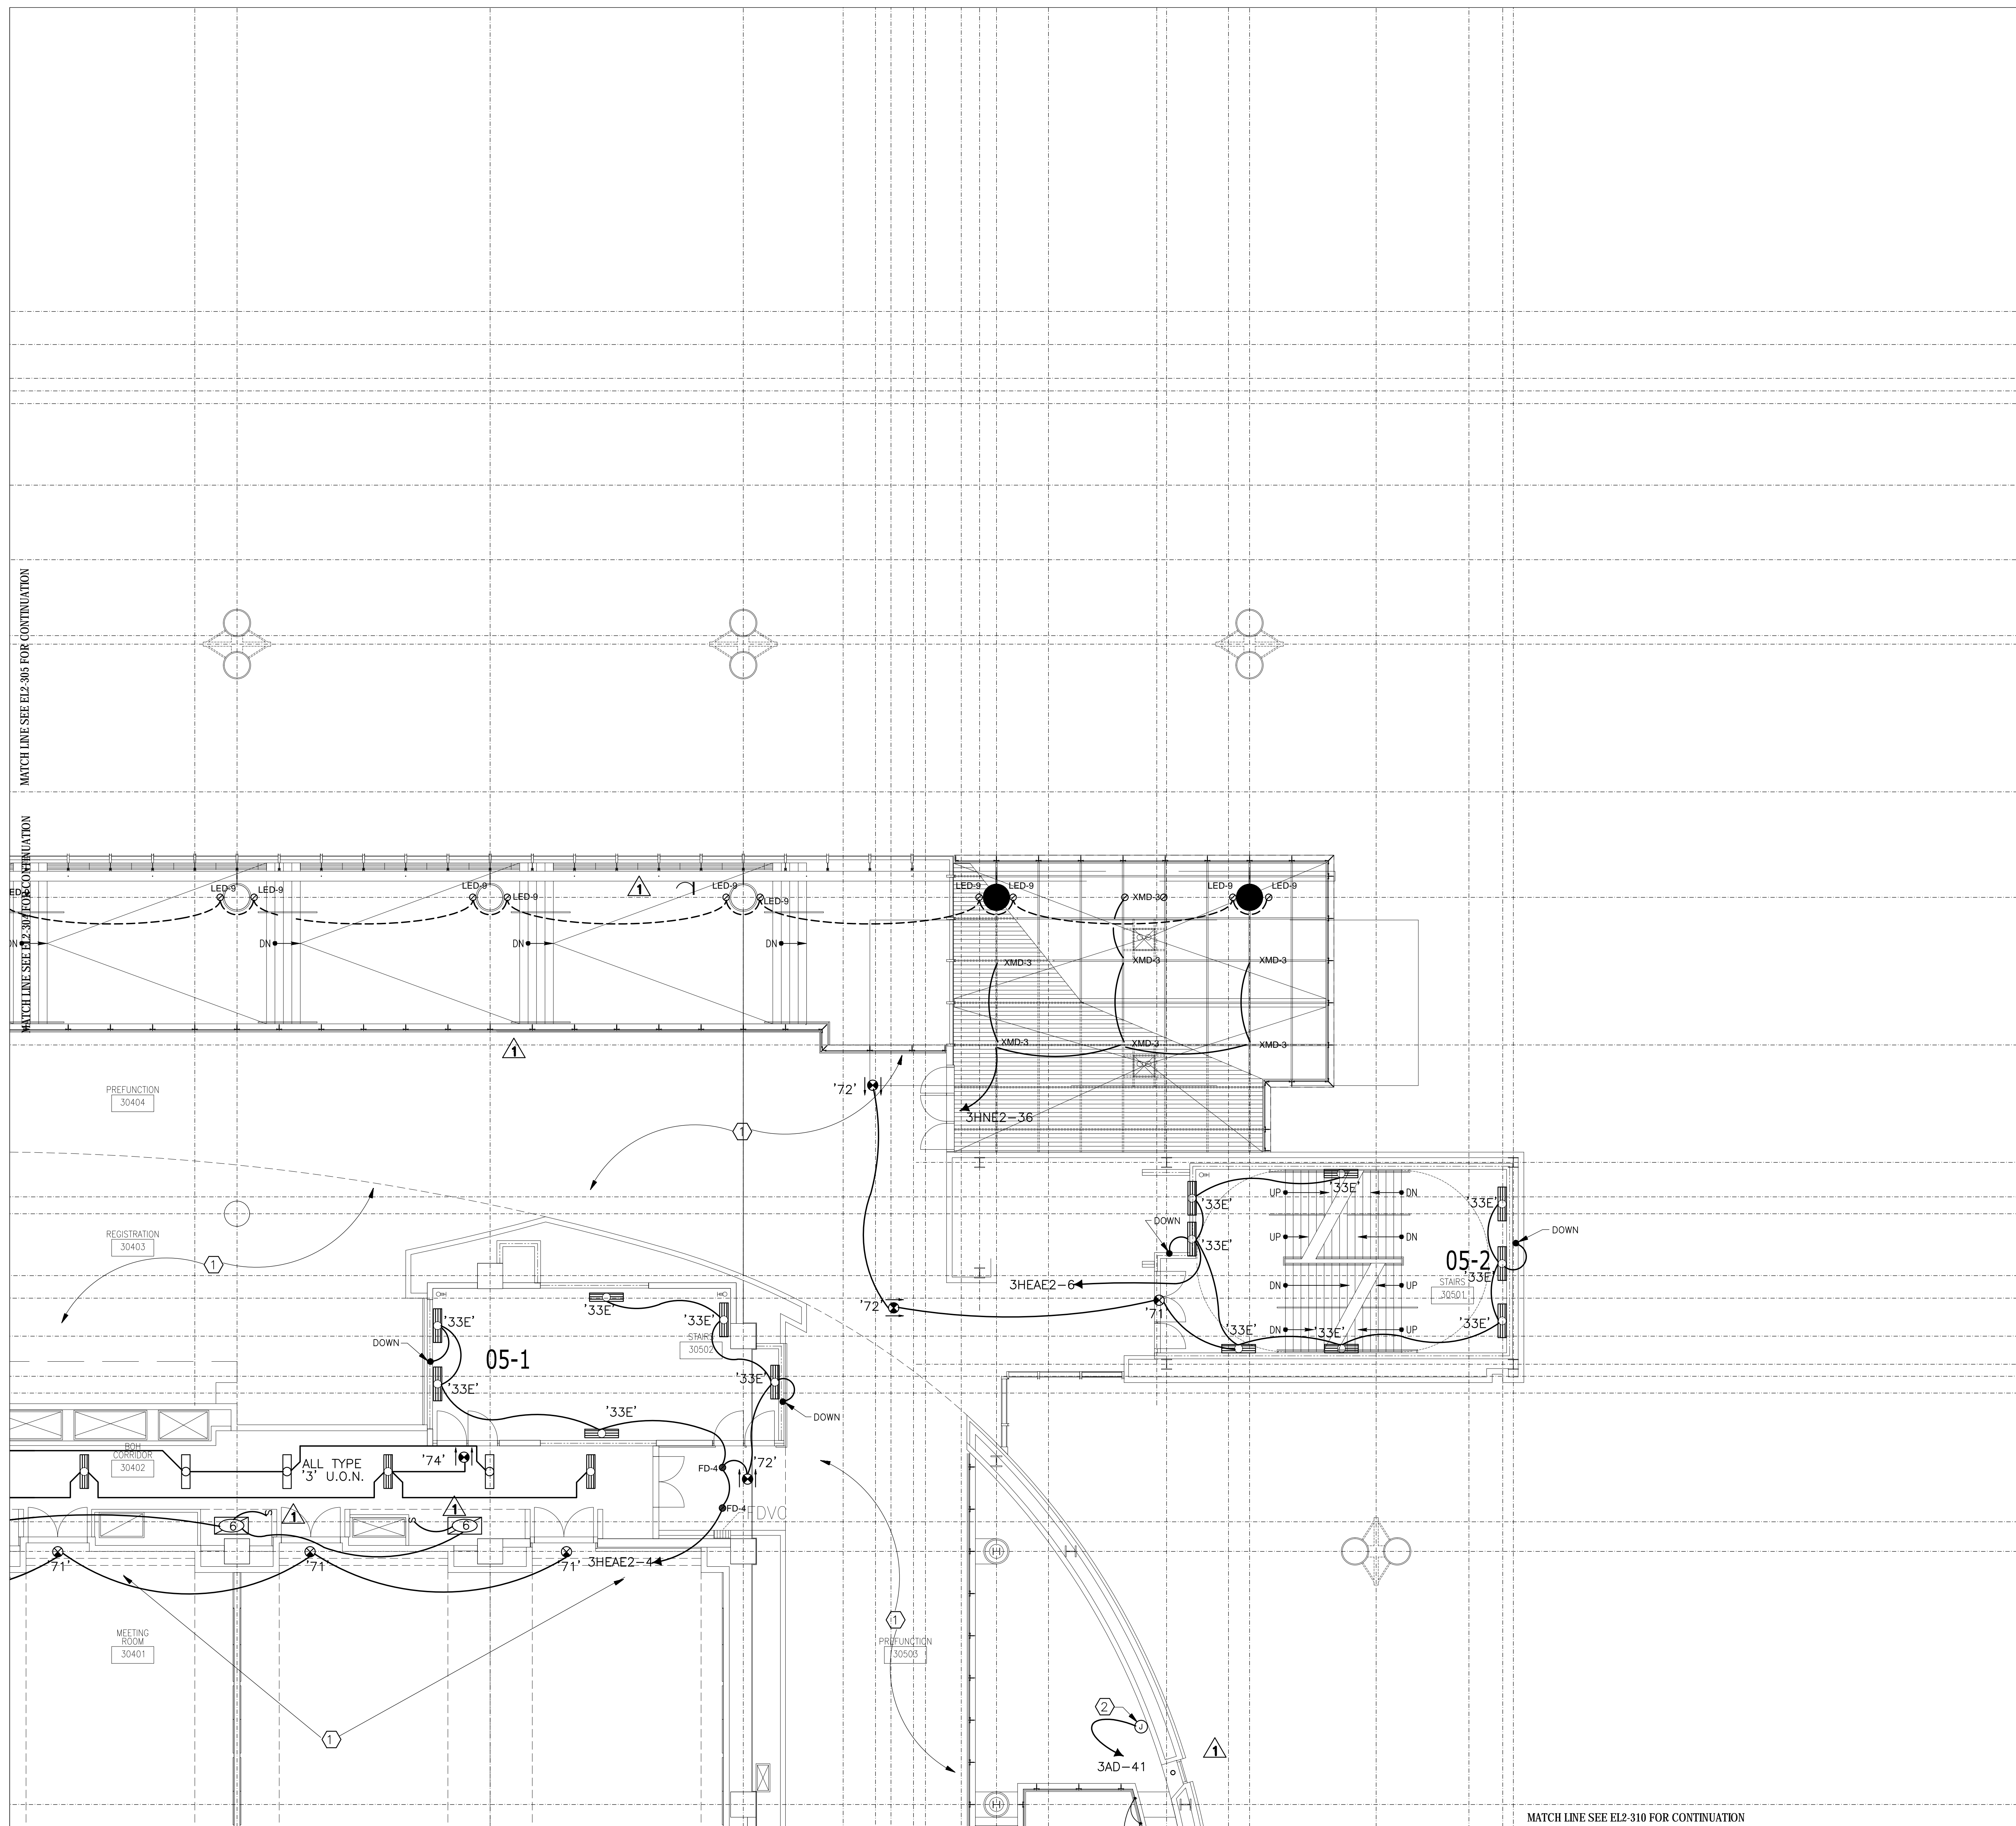

COORDINATION SIGN-OFF		DATE	NAME	TRADE
COMPANY	CONTI	/ /		ELEC.
		/ /		
		/ /		
		/ /		
		/ /		

**Music City Center**  
 Nashville, Tennessee

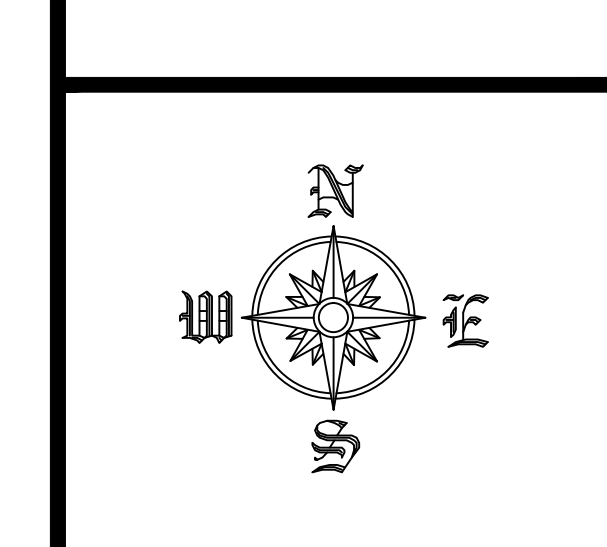

REVISIONS		
NO.	DATE	DESCRIPTION


**RECORD DRAWINGS STAMP**

CONTI ELECTRIC DATE (Last Update): 2/21/2012 10:00 AM  
 DRAWING FILE NAME: EL2-305  
 CAD OPERATOR: GERRITMAN  
 PRINTED BY: FREDMAN, GREGG  
 PLOT DATE: 2/21/2012 2:02 PM  
 SUBMITTED BY: G.L.P.  
 ASSIGNED TO:

LEVEL 3 LIGHTING  
 ZONE 5  
 SCALE: 1/8" = 1'-0"


EL2-305

FILE PATH FOR CAD OPERATOR USE ONLY: P:\305\Conti\Bldg\305\Zone 5\Bldg 4\305\Zone 5 Lighting\Zone 5 For Operating

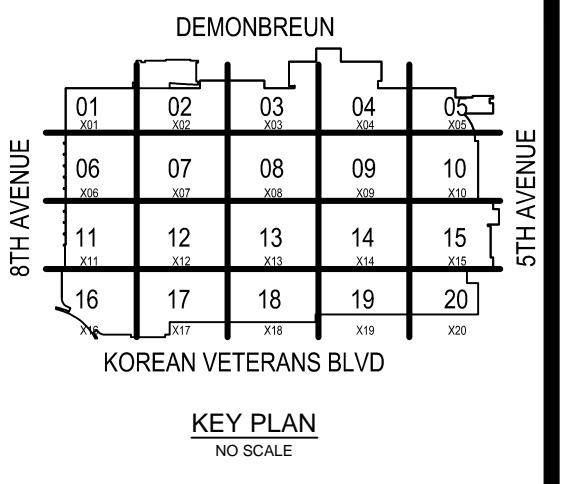

COORDINATION SIGN-OFF	
COMPANY	DATE
CONTE	/ /
TRADE	/ /
ELEC.	/ /
NAME	/ /

**Music City Center**  
Nashville, Tennessee

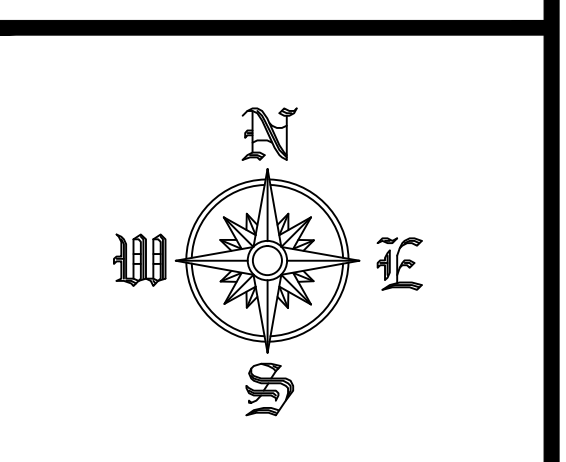

REVISIONS		
NO.	DATE	DESCRIPTION

**RECORD DRAWINGS STAMP**

CONTELECTRIC DATE (Last Update):  
2/21/2012 10:00 AM

DRAWING FILE NAME:  
EL2-306

CAD OPERATOR:  
GERTMAN

PRINTED BY:  
FREDMAN, GREGG


PLOT DATE:  
2/21/2012 2:02 PM

SUBMITTED BY:  
G.L.F.

ASSIGNED TO:


LEVEL 3 LIGHTING  
 ZONE 6  
 SCALE: 1/8" = 1'-0"

EL2-306

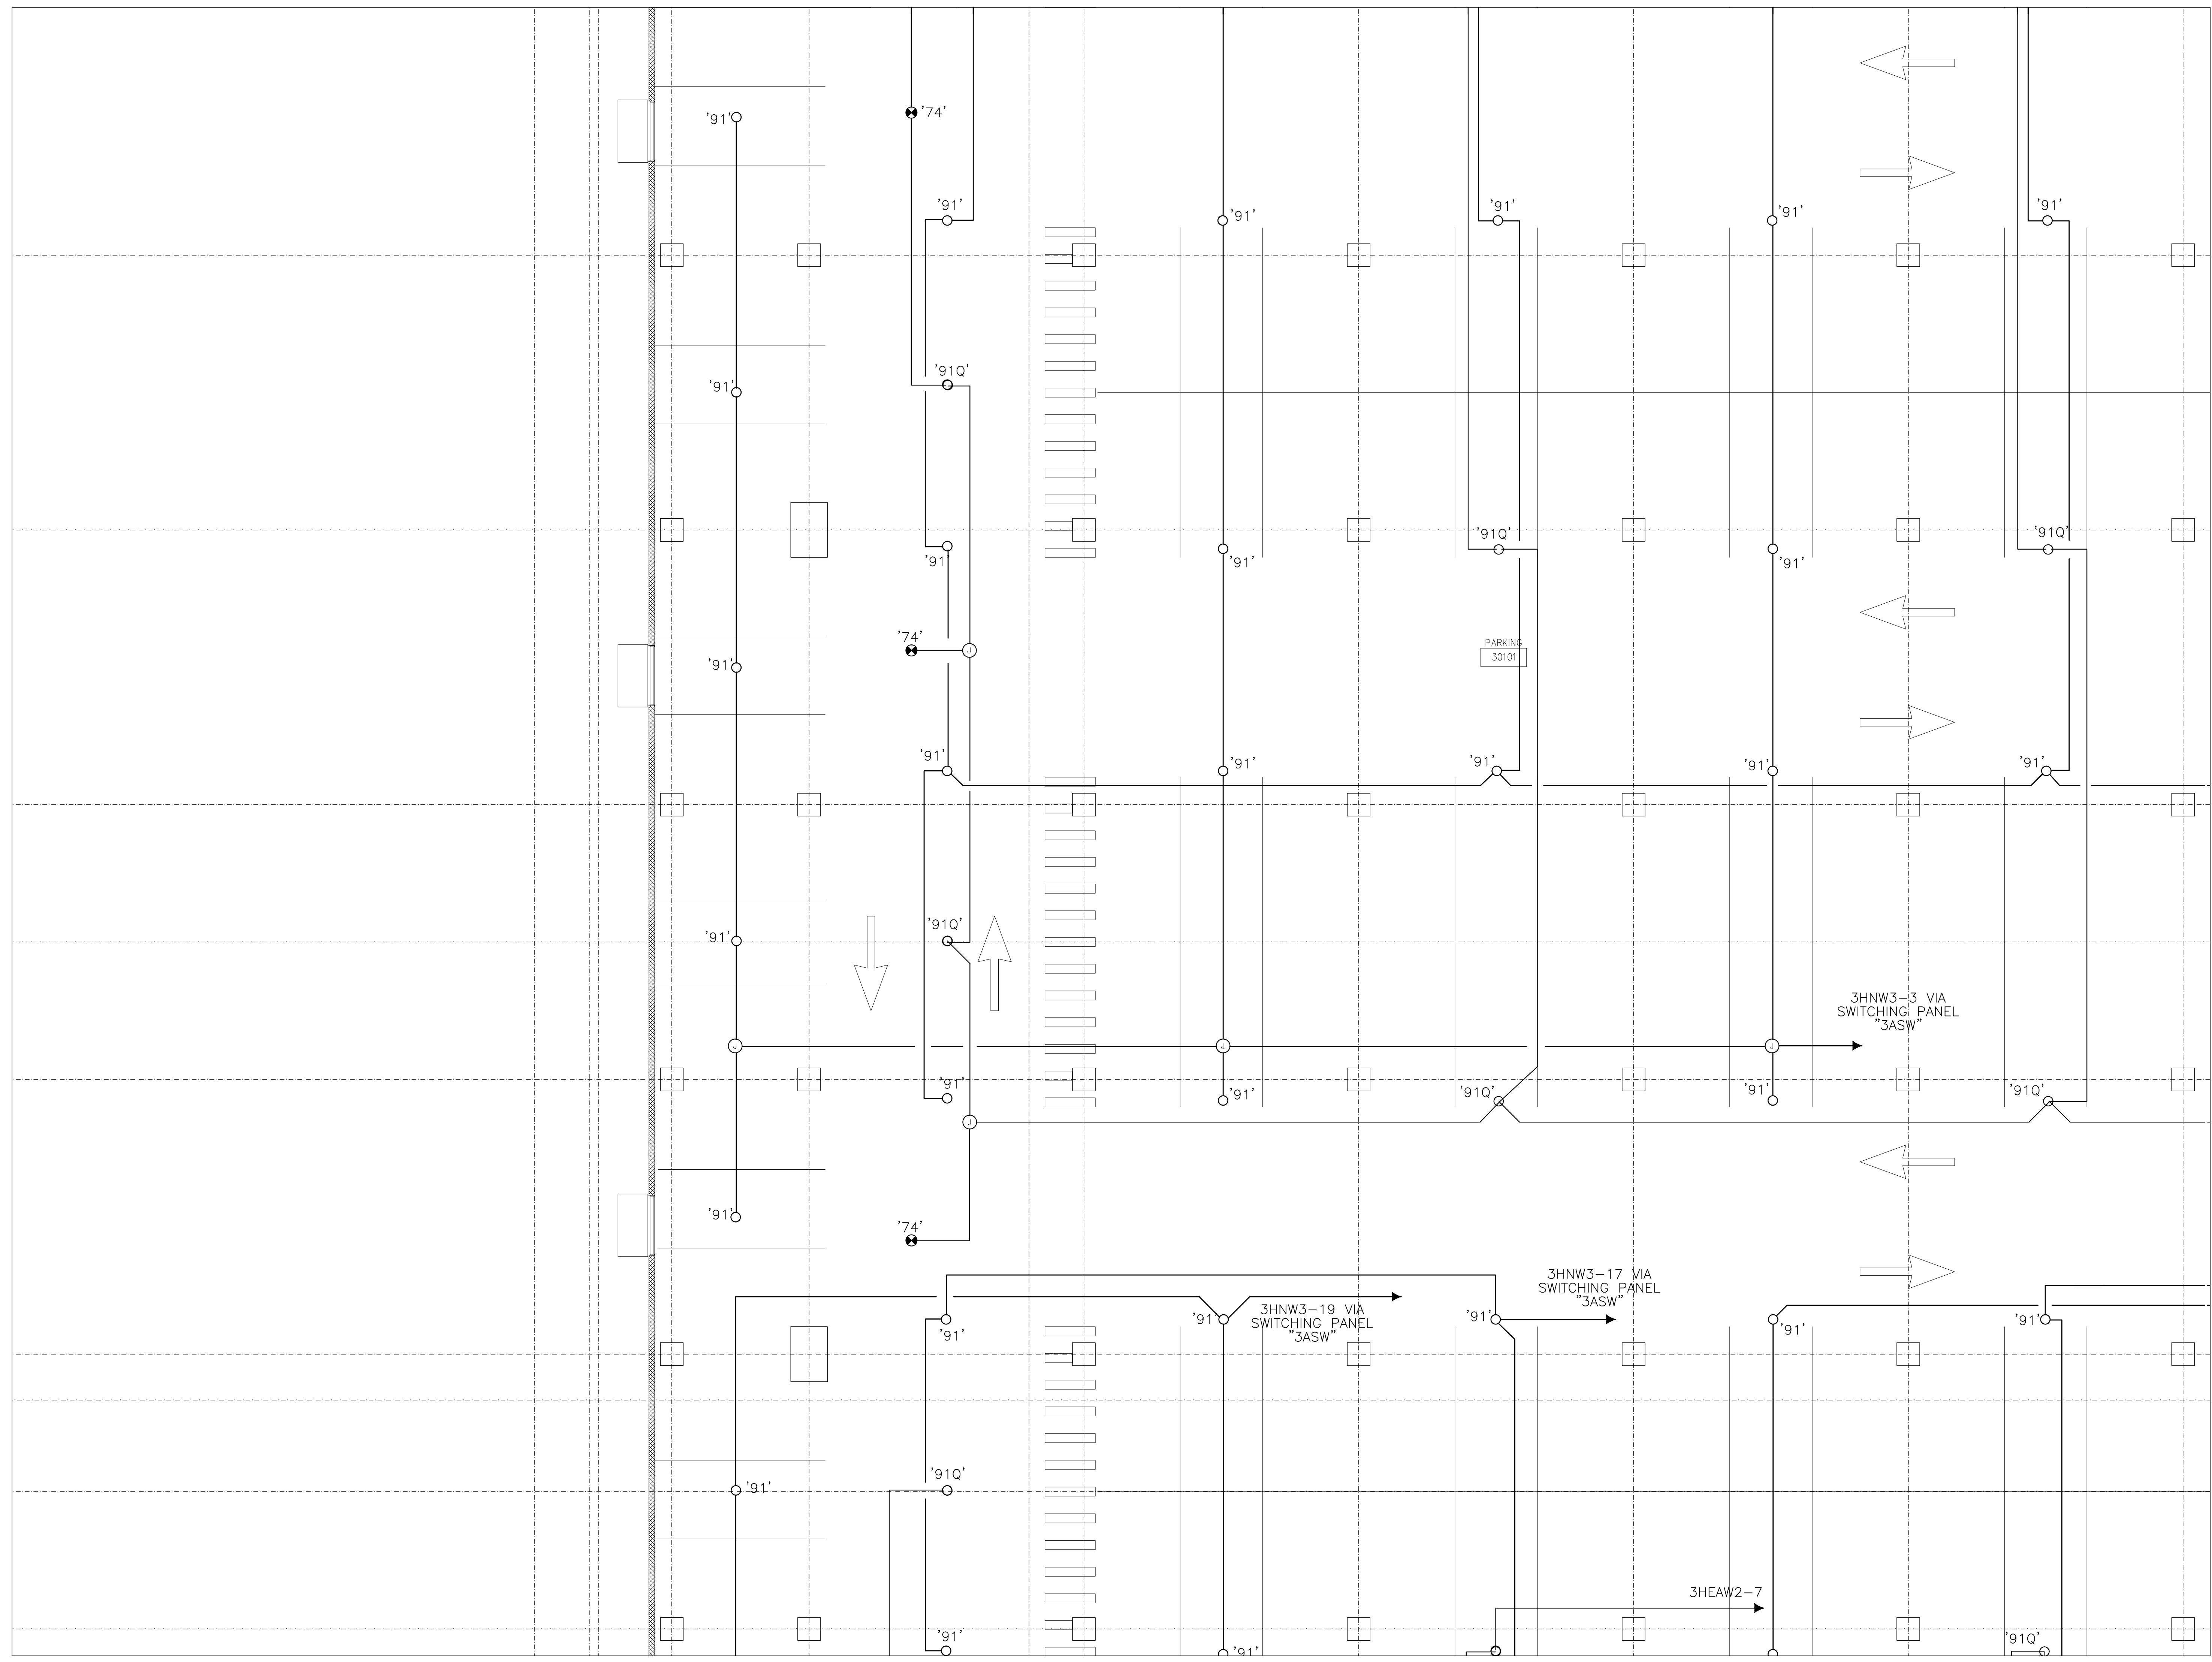

FILE PATH FOR CAD OPERATOR USE ONLY: P:\306\Conti\Bldg\Nashville\_MCC\Level\_03\Lighting\Zone6 For Operating




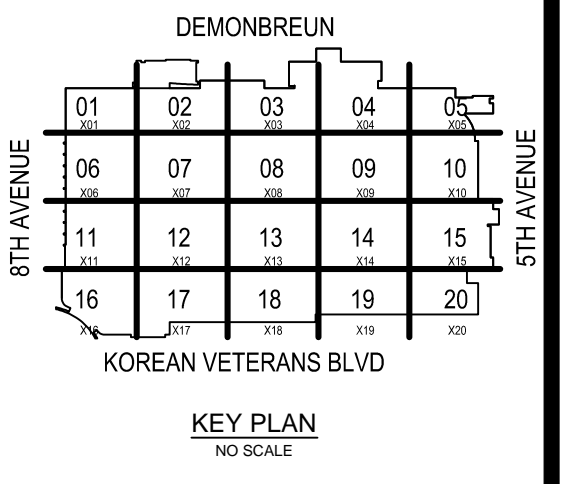

COORDINATION SIGN-OFF

COMPANY	TRADE	DATE
CONTI	ELEC.	/ /
		/ /
		/ /
		/ /
		/ /

**Music City Center**  
 Nashville, Tennessee

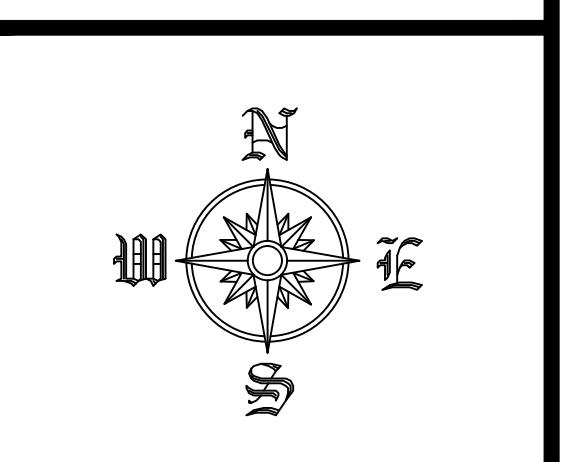

REVISIONS

NO.	DATE	DESCRIPTION

**RECORD DRAWINGS STAMP**

CONTELECTRIC DATE (Last Update):  
 2/21/2012 10:00 AM

DRAWING FILE NAME:  
 EL2-308

CAD OPERATOR:  
 GERRITAN

PRINTED BY:  
 FREDMAN, GREGG


PLOT DATE:  
 2/21/2012 2:02 PM

SUBMITTED BY:  
 G.P.


ASSIGNED TO:

LEVEL 3 LIGHTING  
 ZONE 8  
 SCALE: 1/8" = 1'-0"

EL2-308

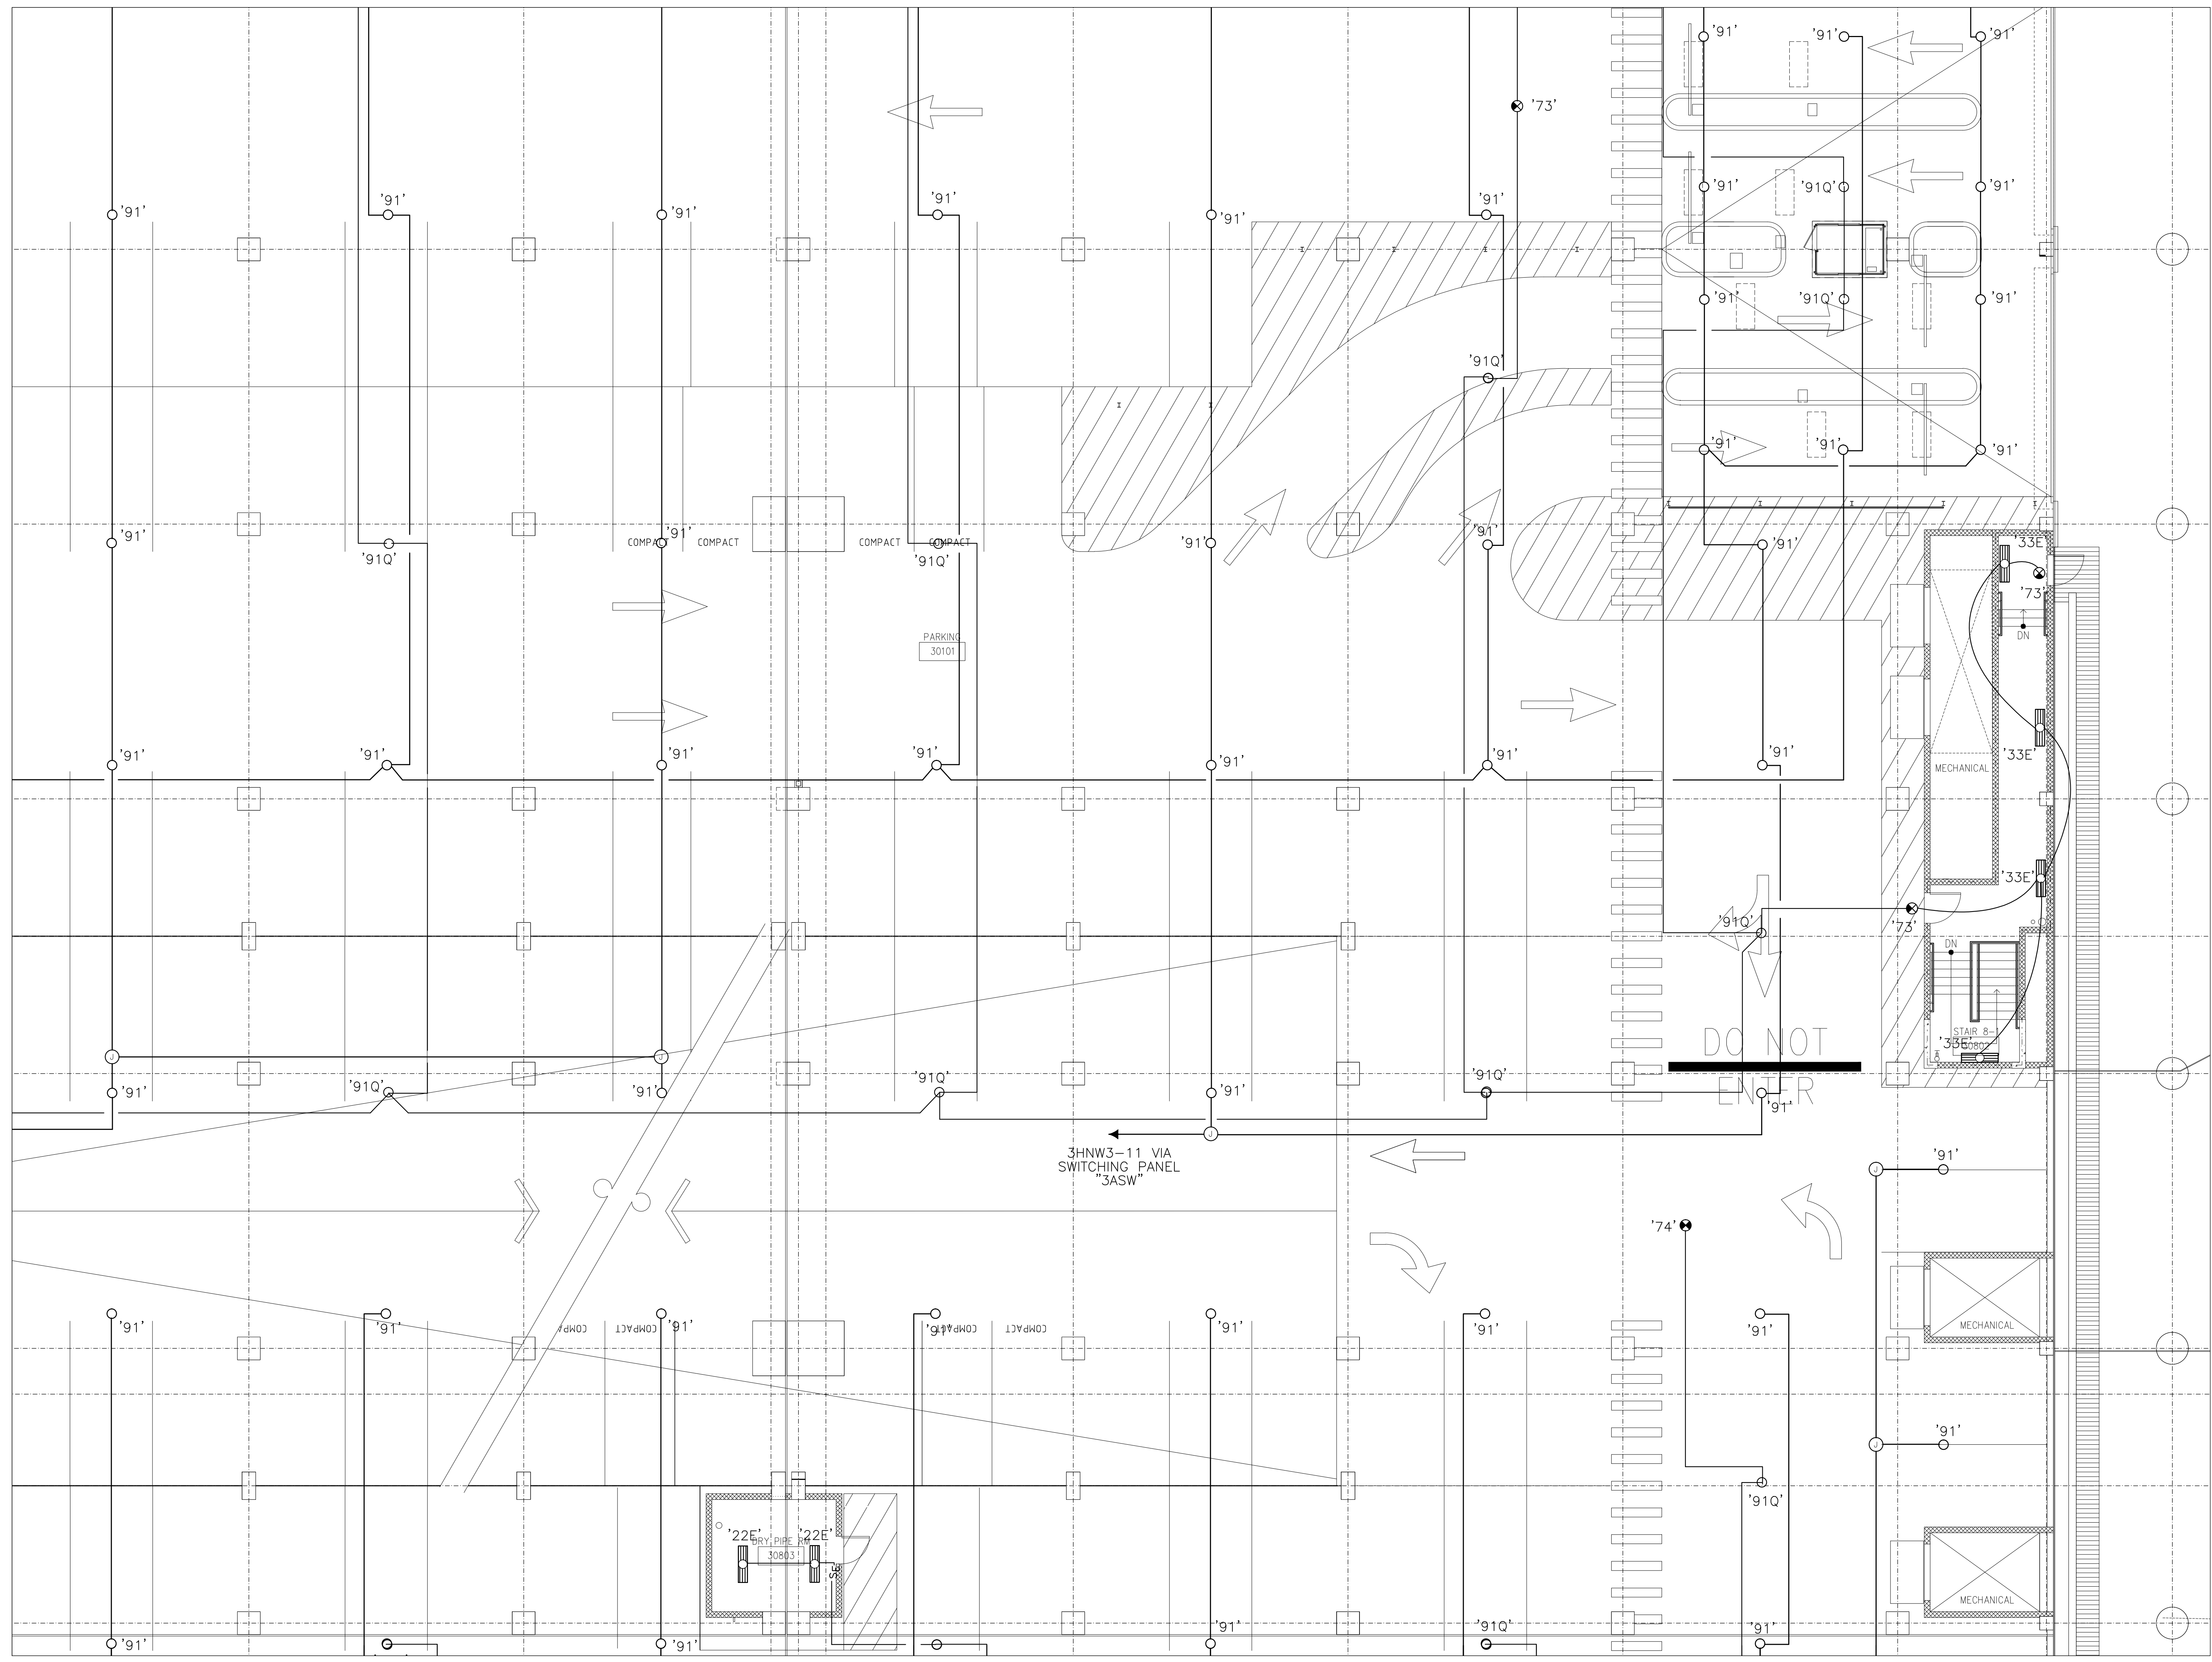




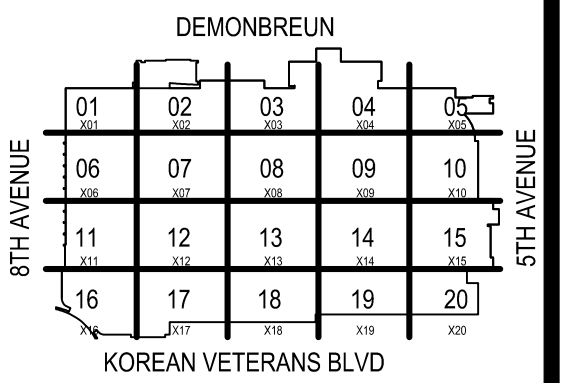

COORDINATION SIGN-OFF

COMPANY	TRADE	DATE
CONTI	ELEC.	/ /
		/ /
		/ /
**Music City Center**  
 Nashville, Tennessee

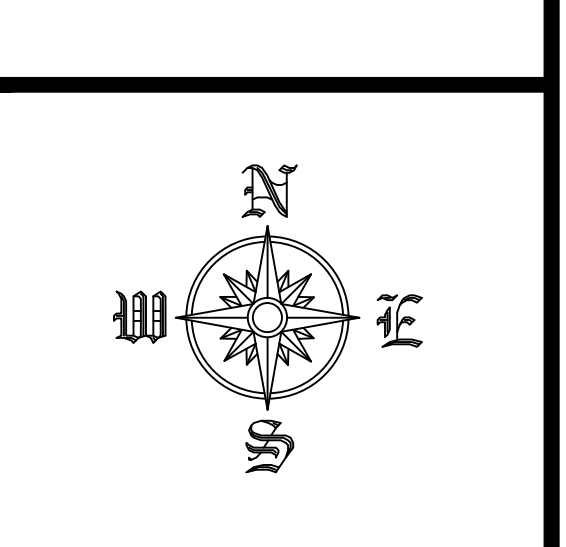

REVISIONS

NO.	DATE	DESCRIPTION

RECORD DRAWINGS STAMP

CONTELECTRIC DATE (Last Update):  
 2/21/2012 10:00 AM

DRAWING FILE NAME:  
 EL2-309


CAD OPERATOR:  
 GERRITMAN

PRINTED BY:  
 FREDMAN, GREGG

PLOT DATE:  
 2/21/2012 2:02 PM


SUBMITTED BY:  
 G.P.

ASSIGNED TO:

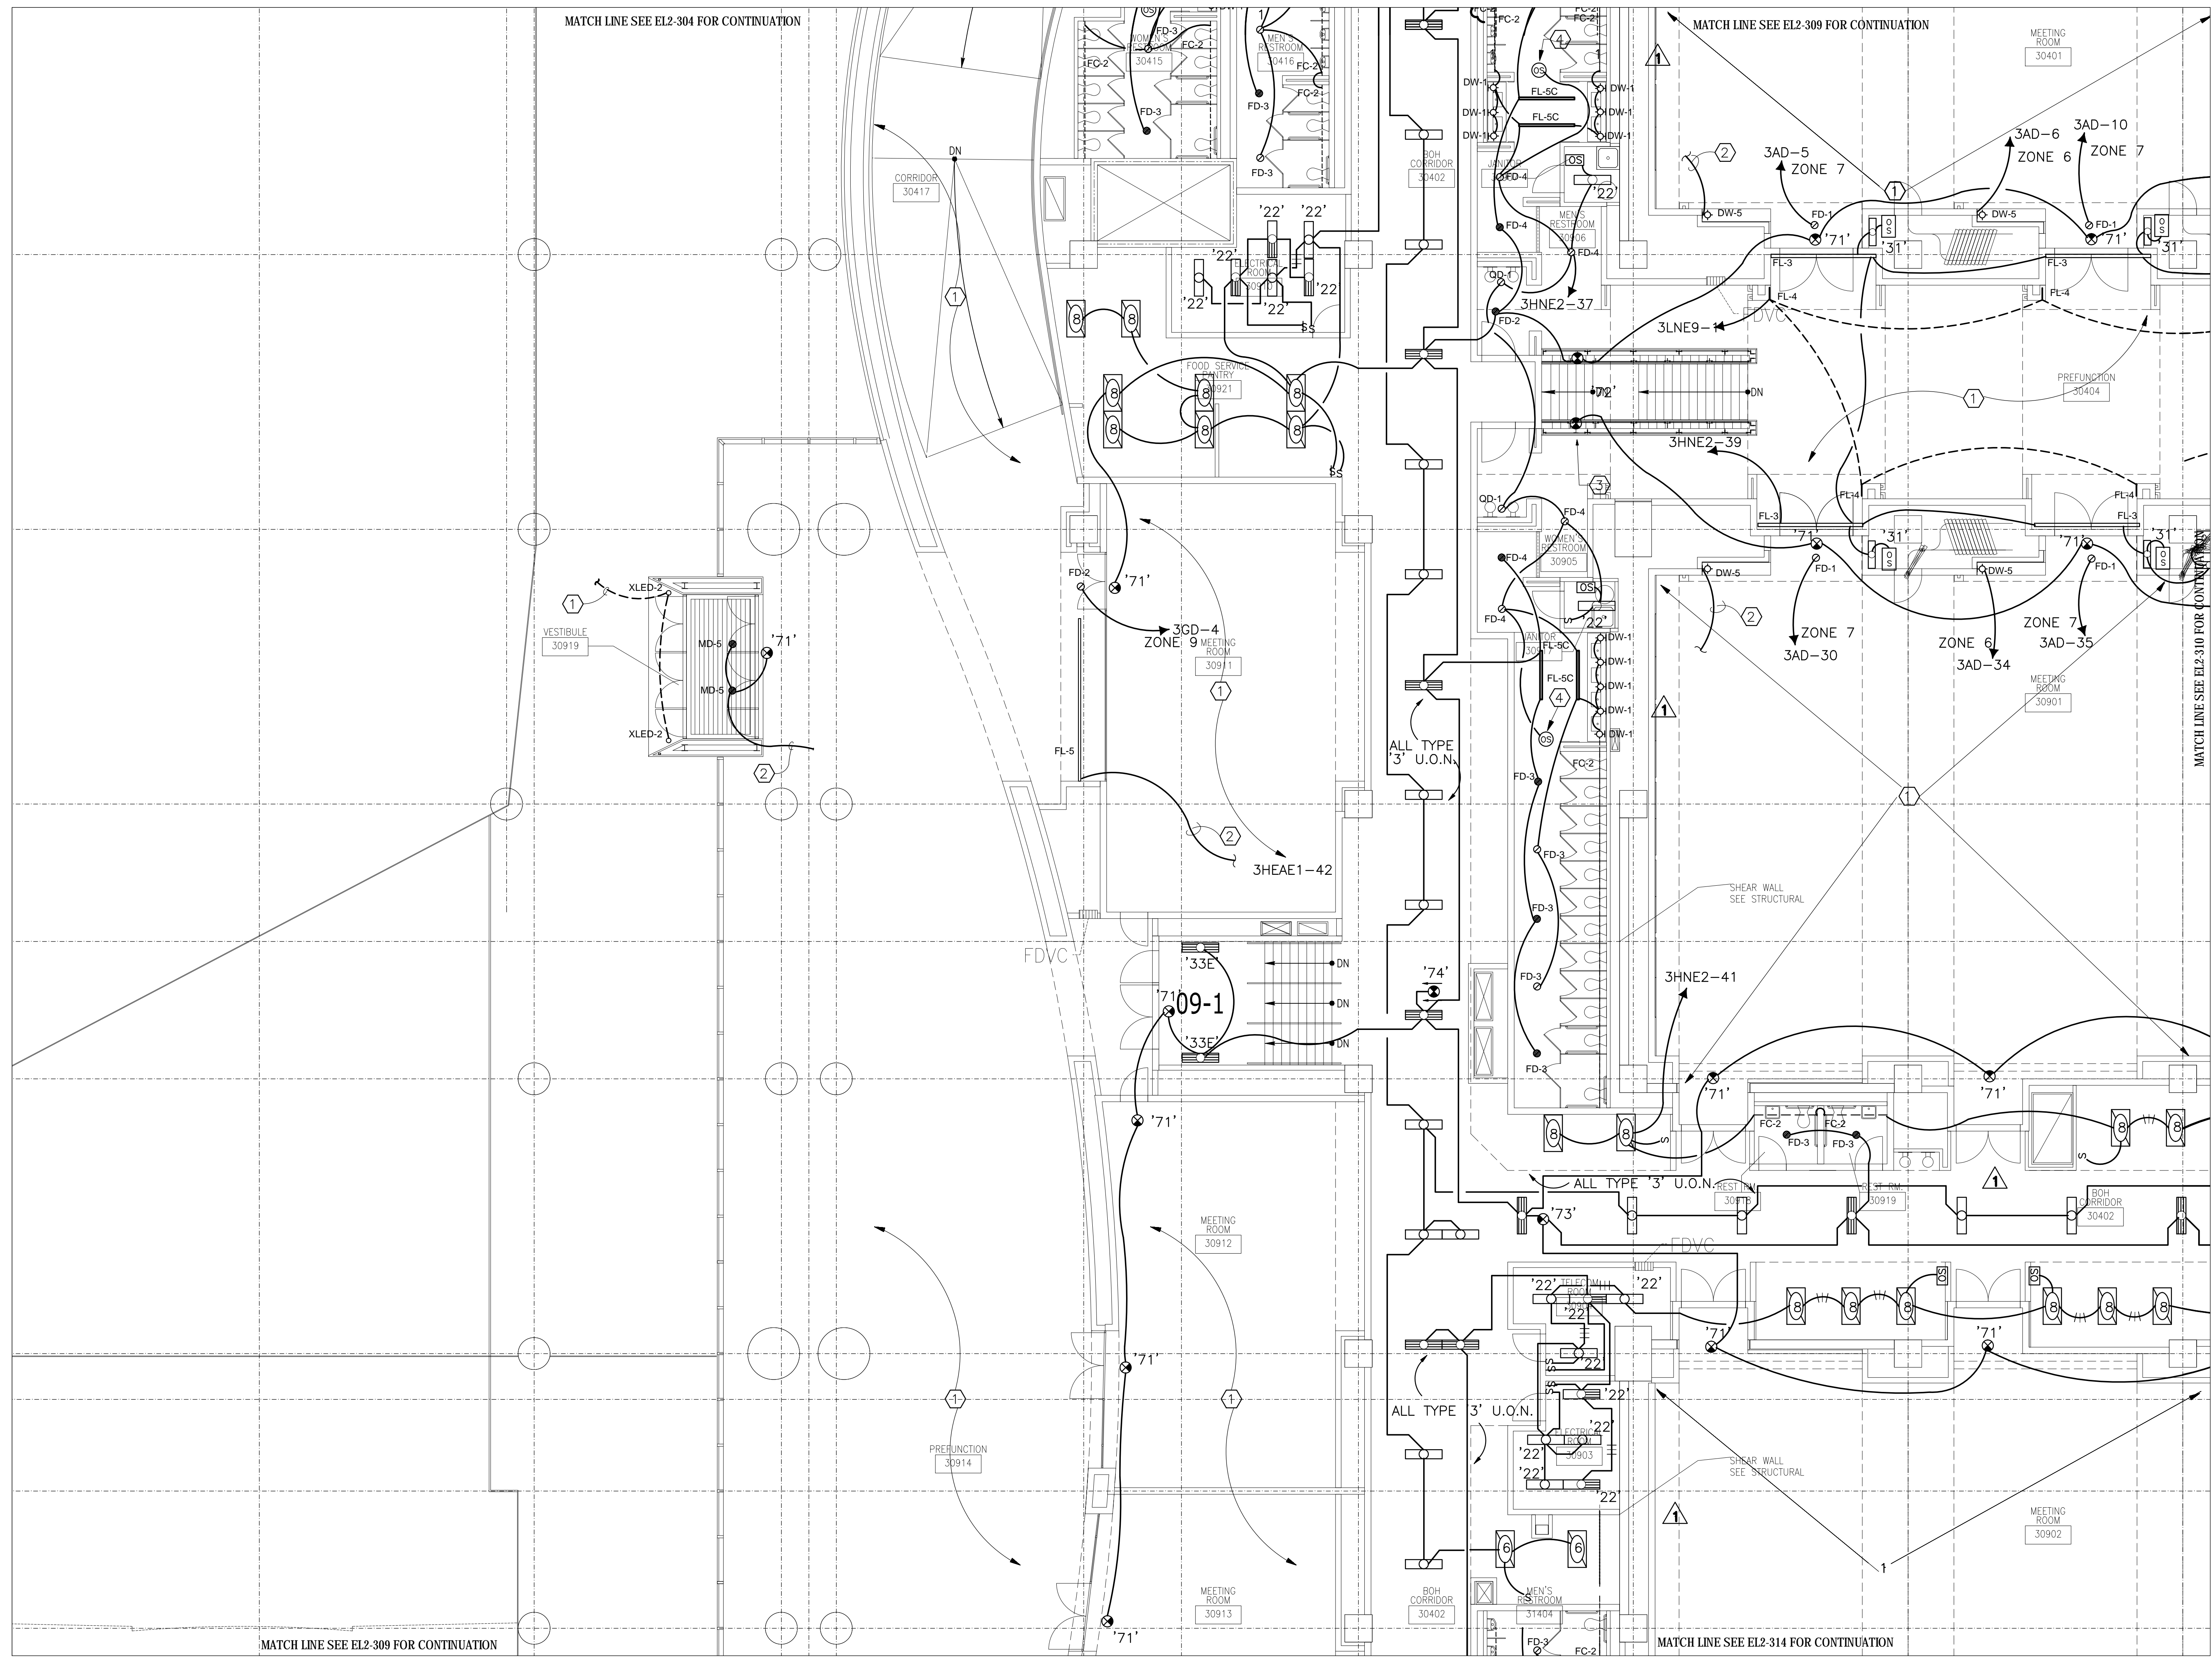


LEVEL 3 LIGHTING  
 ZONE 9  
 SCALE: 1/8" = 1'-0"

EL2-309

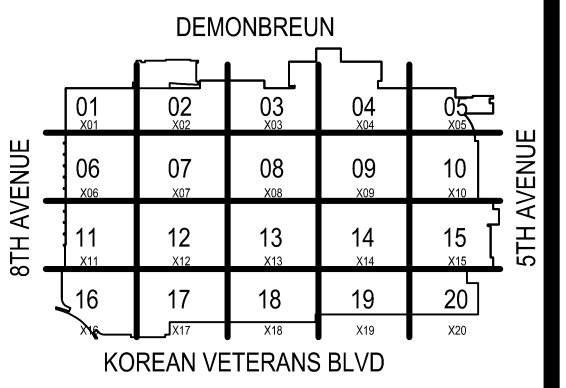

COORDINATION SIGN-OFF		DATE	DATE	DATE	DATE	DATE
COMPANY	NAME	/ /	/ /	/ /	/ /	/ /
TRADE	ELEC.					
CONTI						

**Music City Center**  
 Nashville, Tennessee

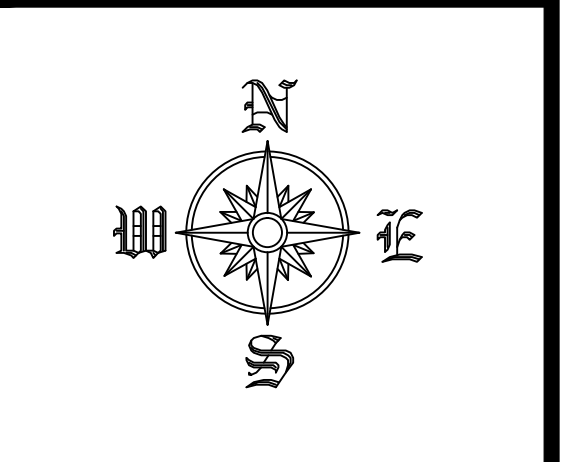


REVISIONS		
NO.	DATE	DESCRIPTION


RECORD DRAWINGS STAMP	
CONTELECTRIC DATE (Last Update):	2/21/2012 10:00 AM
DRAWING FILE NAME:	EL2-310
CAD OPERATOR:	GERMAN
PRINTED BY:	FREMAN, GREGG
PLOT DATE:	2/21/2012 2:02 PM
SUBMITTED BY:	ELC
ASSIGNED TO:	

LEVEL 3 LIGHTING  
 ZONE 10  
 SCALE: 1/8" = 1'-0"

EL2-310

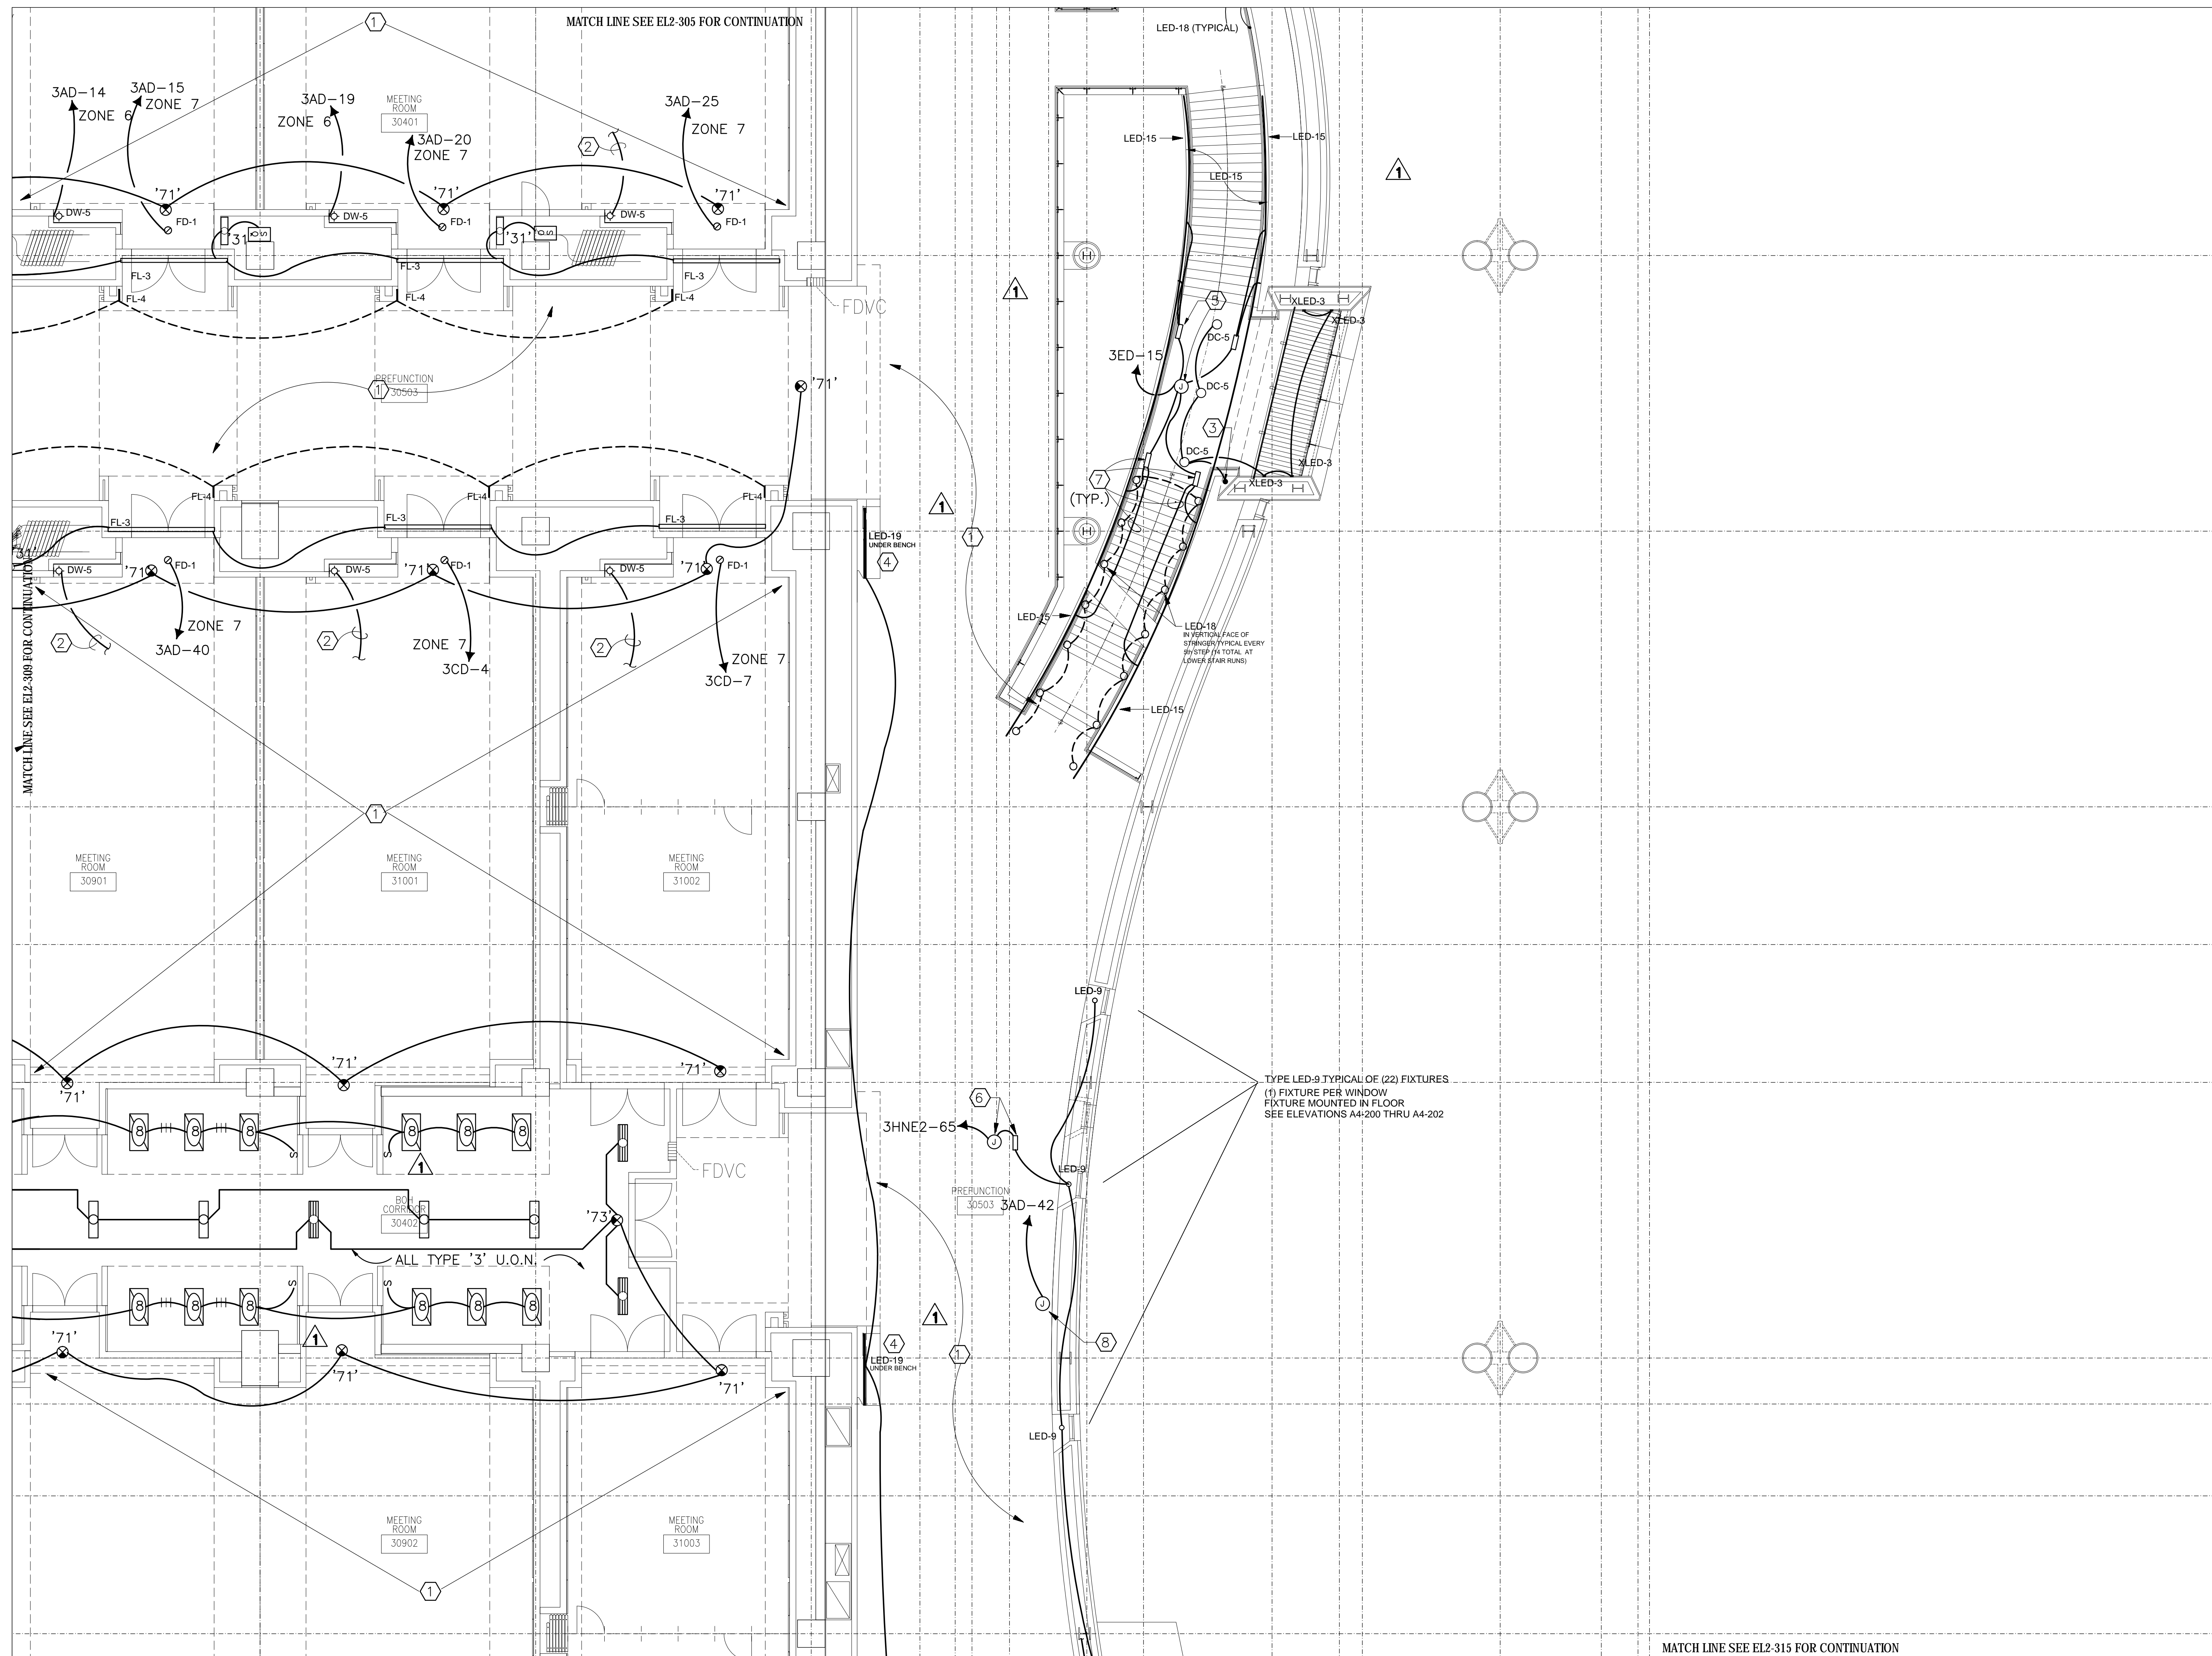


FILE PATH FOR CAD DEPARTMENT USE ONLY: P:\30503\Conti\Bids\310\Zone 10\Level 3 Lighting\Zone 10 Lighting.dwg

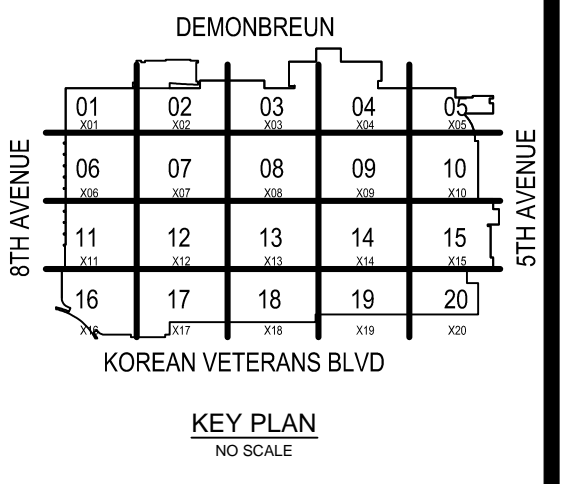

COORDINATION SIGN-OFF

COMPANY	TRADE	DATE
CONTI	ELEC.	///
		///
		///
**Music City Center**  
Nashville, Tennessee

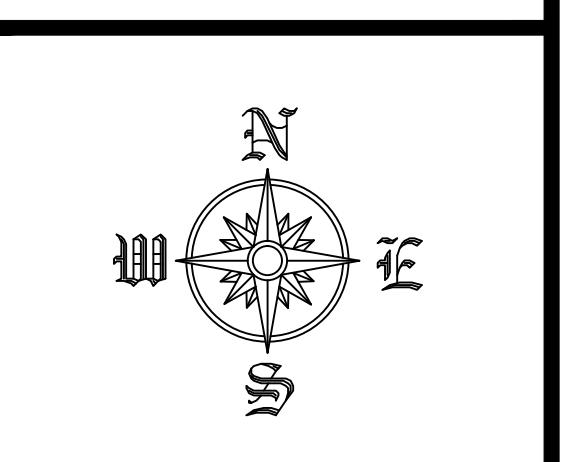

REVISIONS

NO.	DATE	DESCRIPTION

RECORD DRAWINGS STAMP

CONTI ELECTRIC DATE (Last Update):  
2/21/2012 10:00 AM

DRAWING FILE NAME:  
EL2-311

CAD OPERATOR:  
GERTMAN

PRINTED BY:  
FREDMAN, GREGG


PLOT DATE:  
2/21/2012 2:02 PM


SUBMITTED BY:  
G.E.P.

ASSIGNED TO:

LEVEL 3 LIGHTING  
 ZONE 11  
 SCALE: 1/8" = 1'-0"

EL2-311

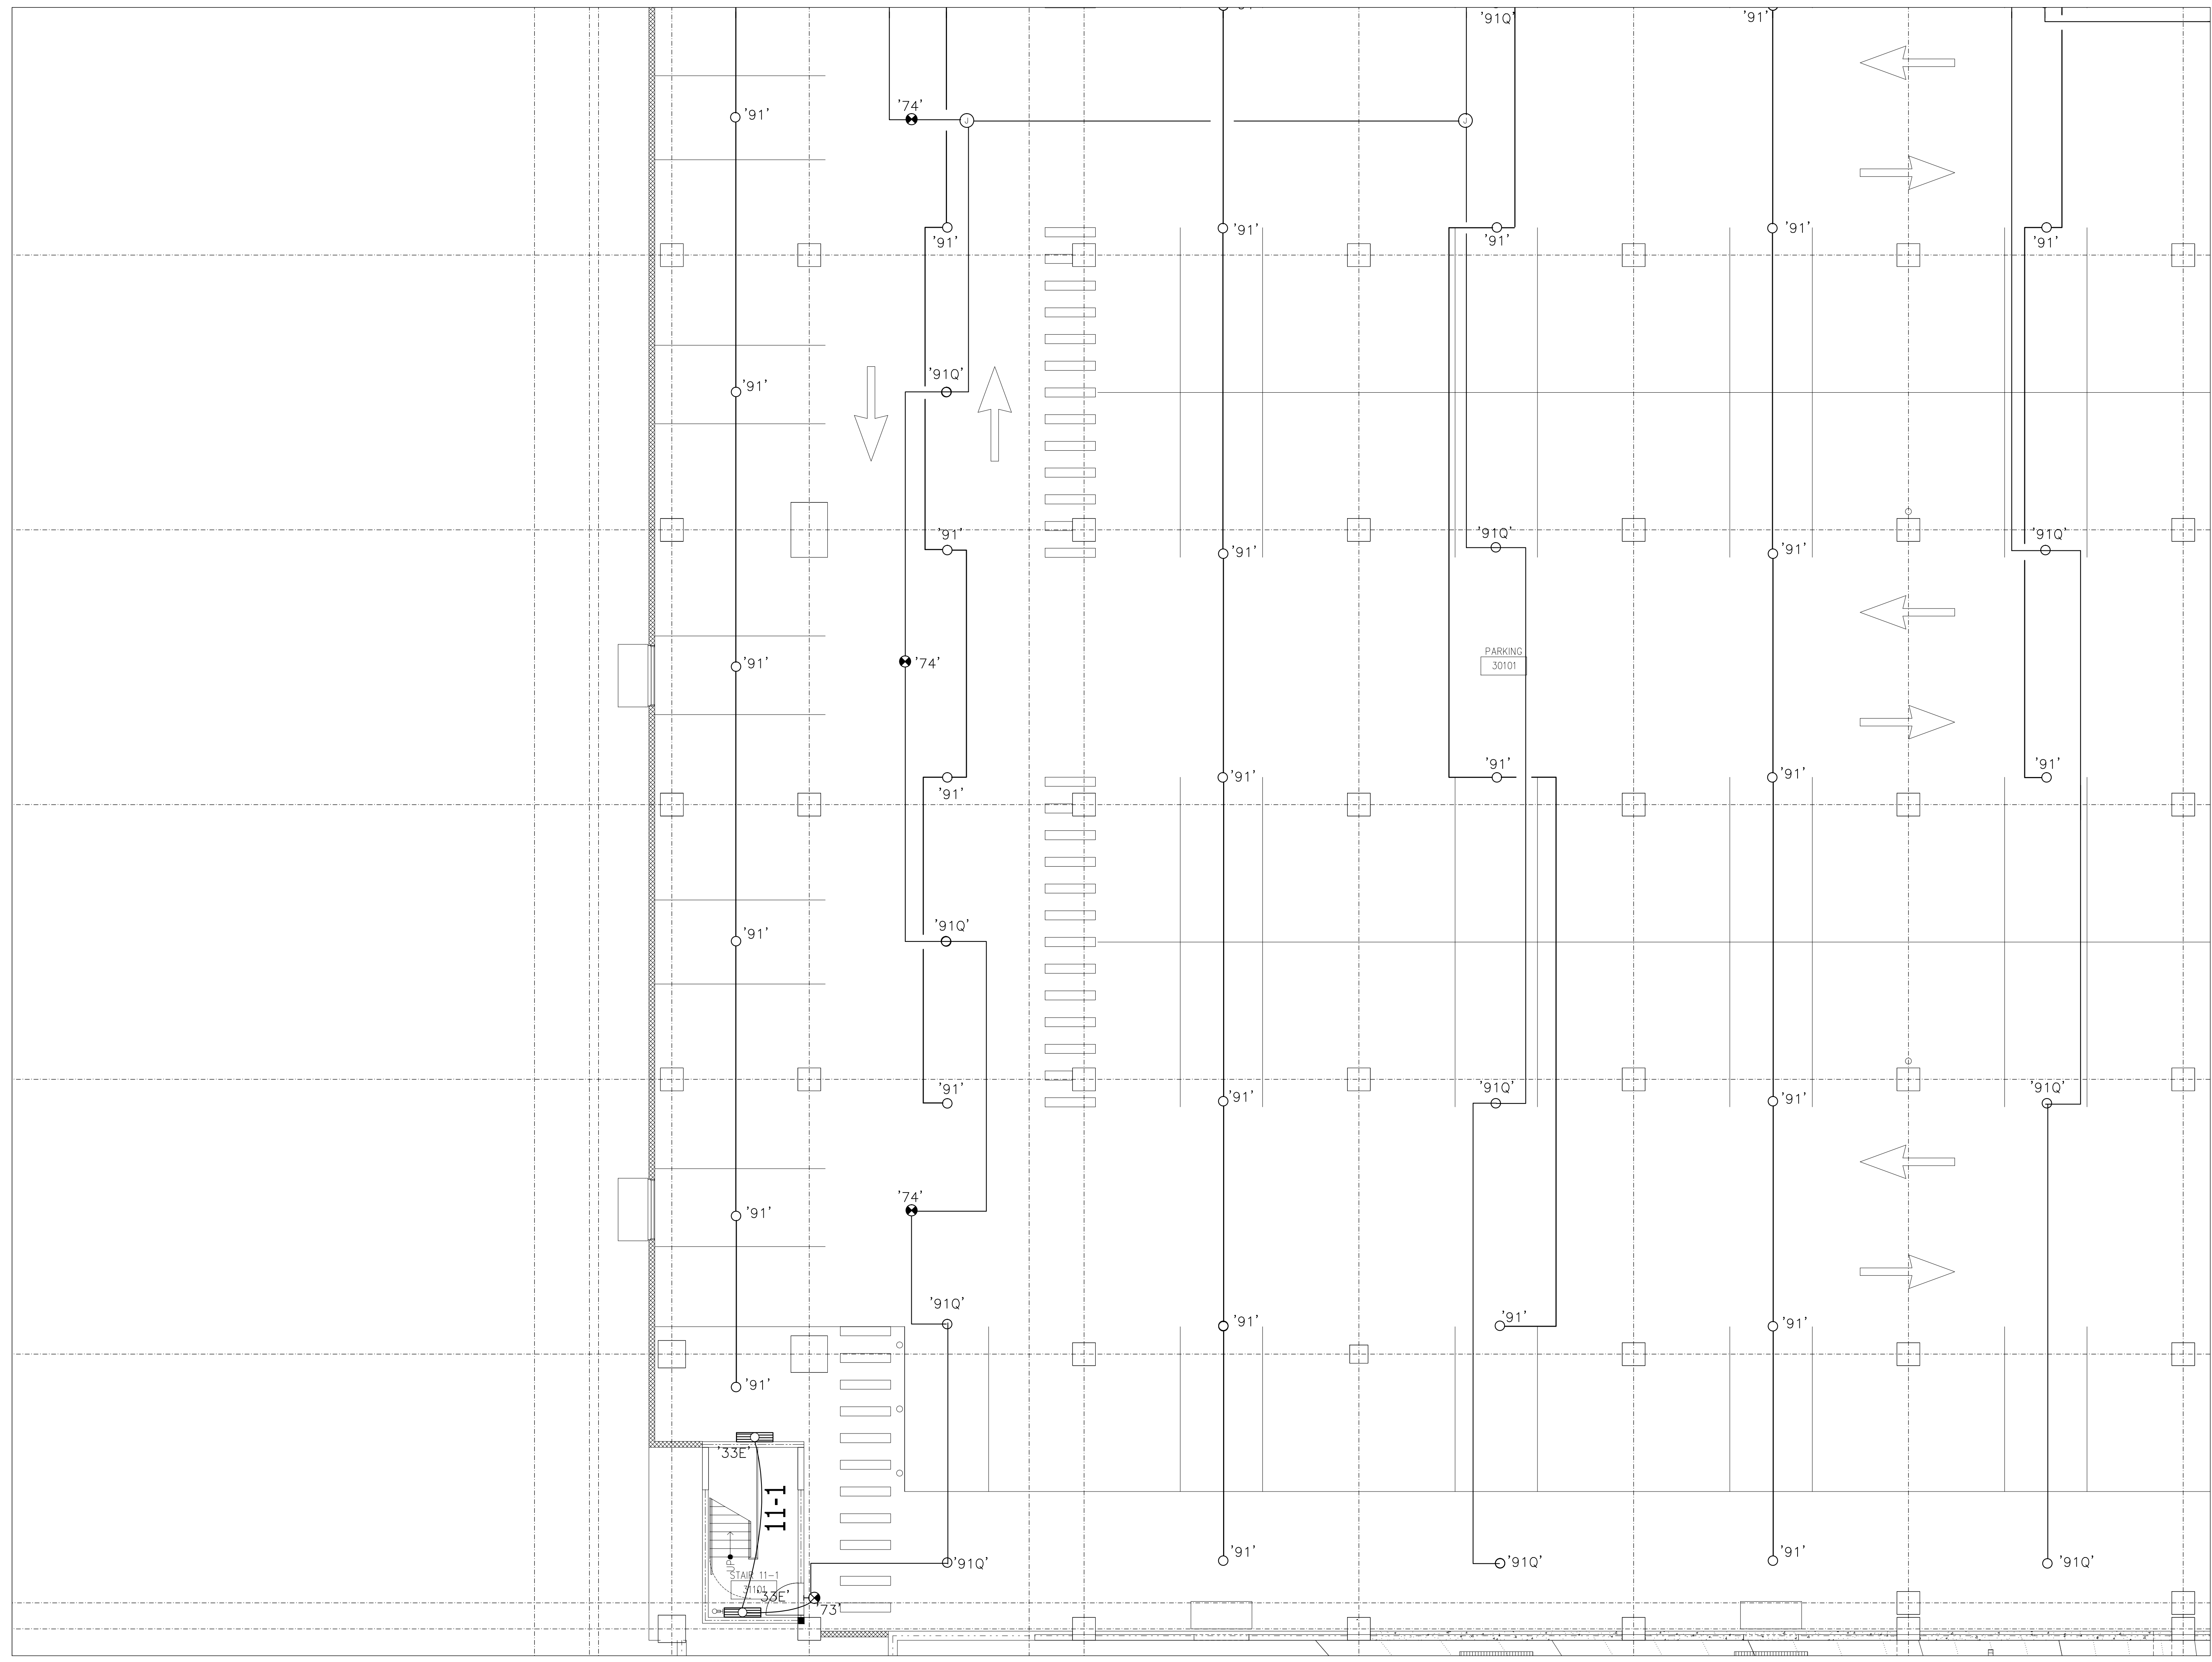


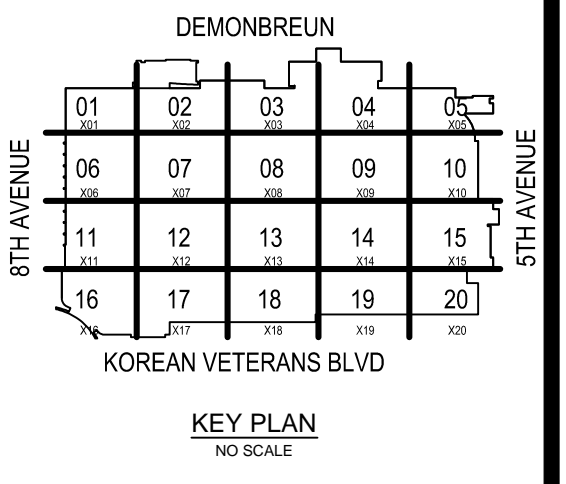

COORDINATION SIGN-OFF

COMPANY	TRADE	DATE
CONTI	ELEC.	/ /
		/ /
		/ /
**Music City Center**  
 Nashville, Tennessee

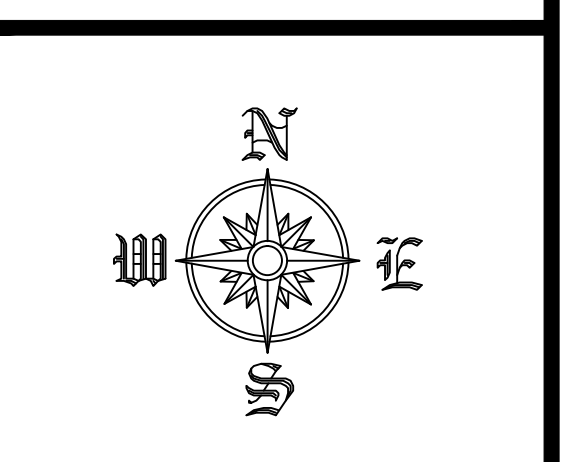

REVISIONS


NO.	DATE	DESCRIPTION


RECORD DRAWINGS STAMP

CONTI ELECTRIC DATE (Last Update): 2/21/2012 10:00 AM  
 DRAWING FILE NAME: EL2-312  
 CAD OPERATOR: GERTMAN  
 PRINTED BY: FREDMAN, GREG  
 PLOT DATE: 2/21/2012 2:02 PM  
 SUBMITTED BY: G.P.  
 ASSIGNED TO:

LEVEL 3 LIGHTING  
 ZONE 12  
 SCALE: 1/8" = 1'-0"


EL2-312

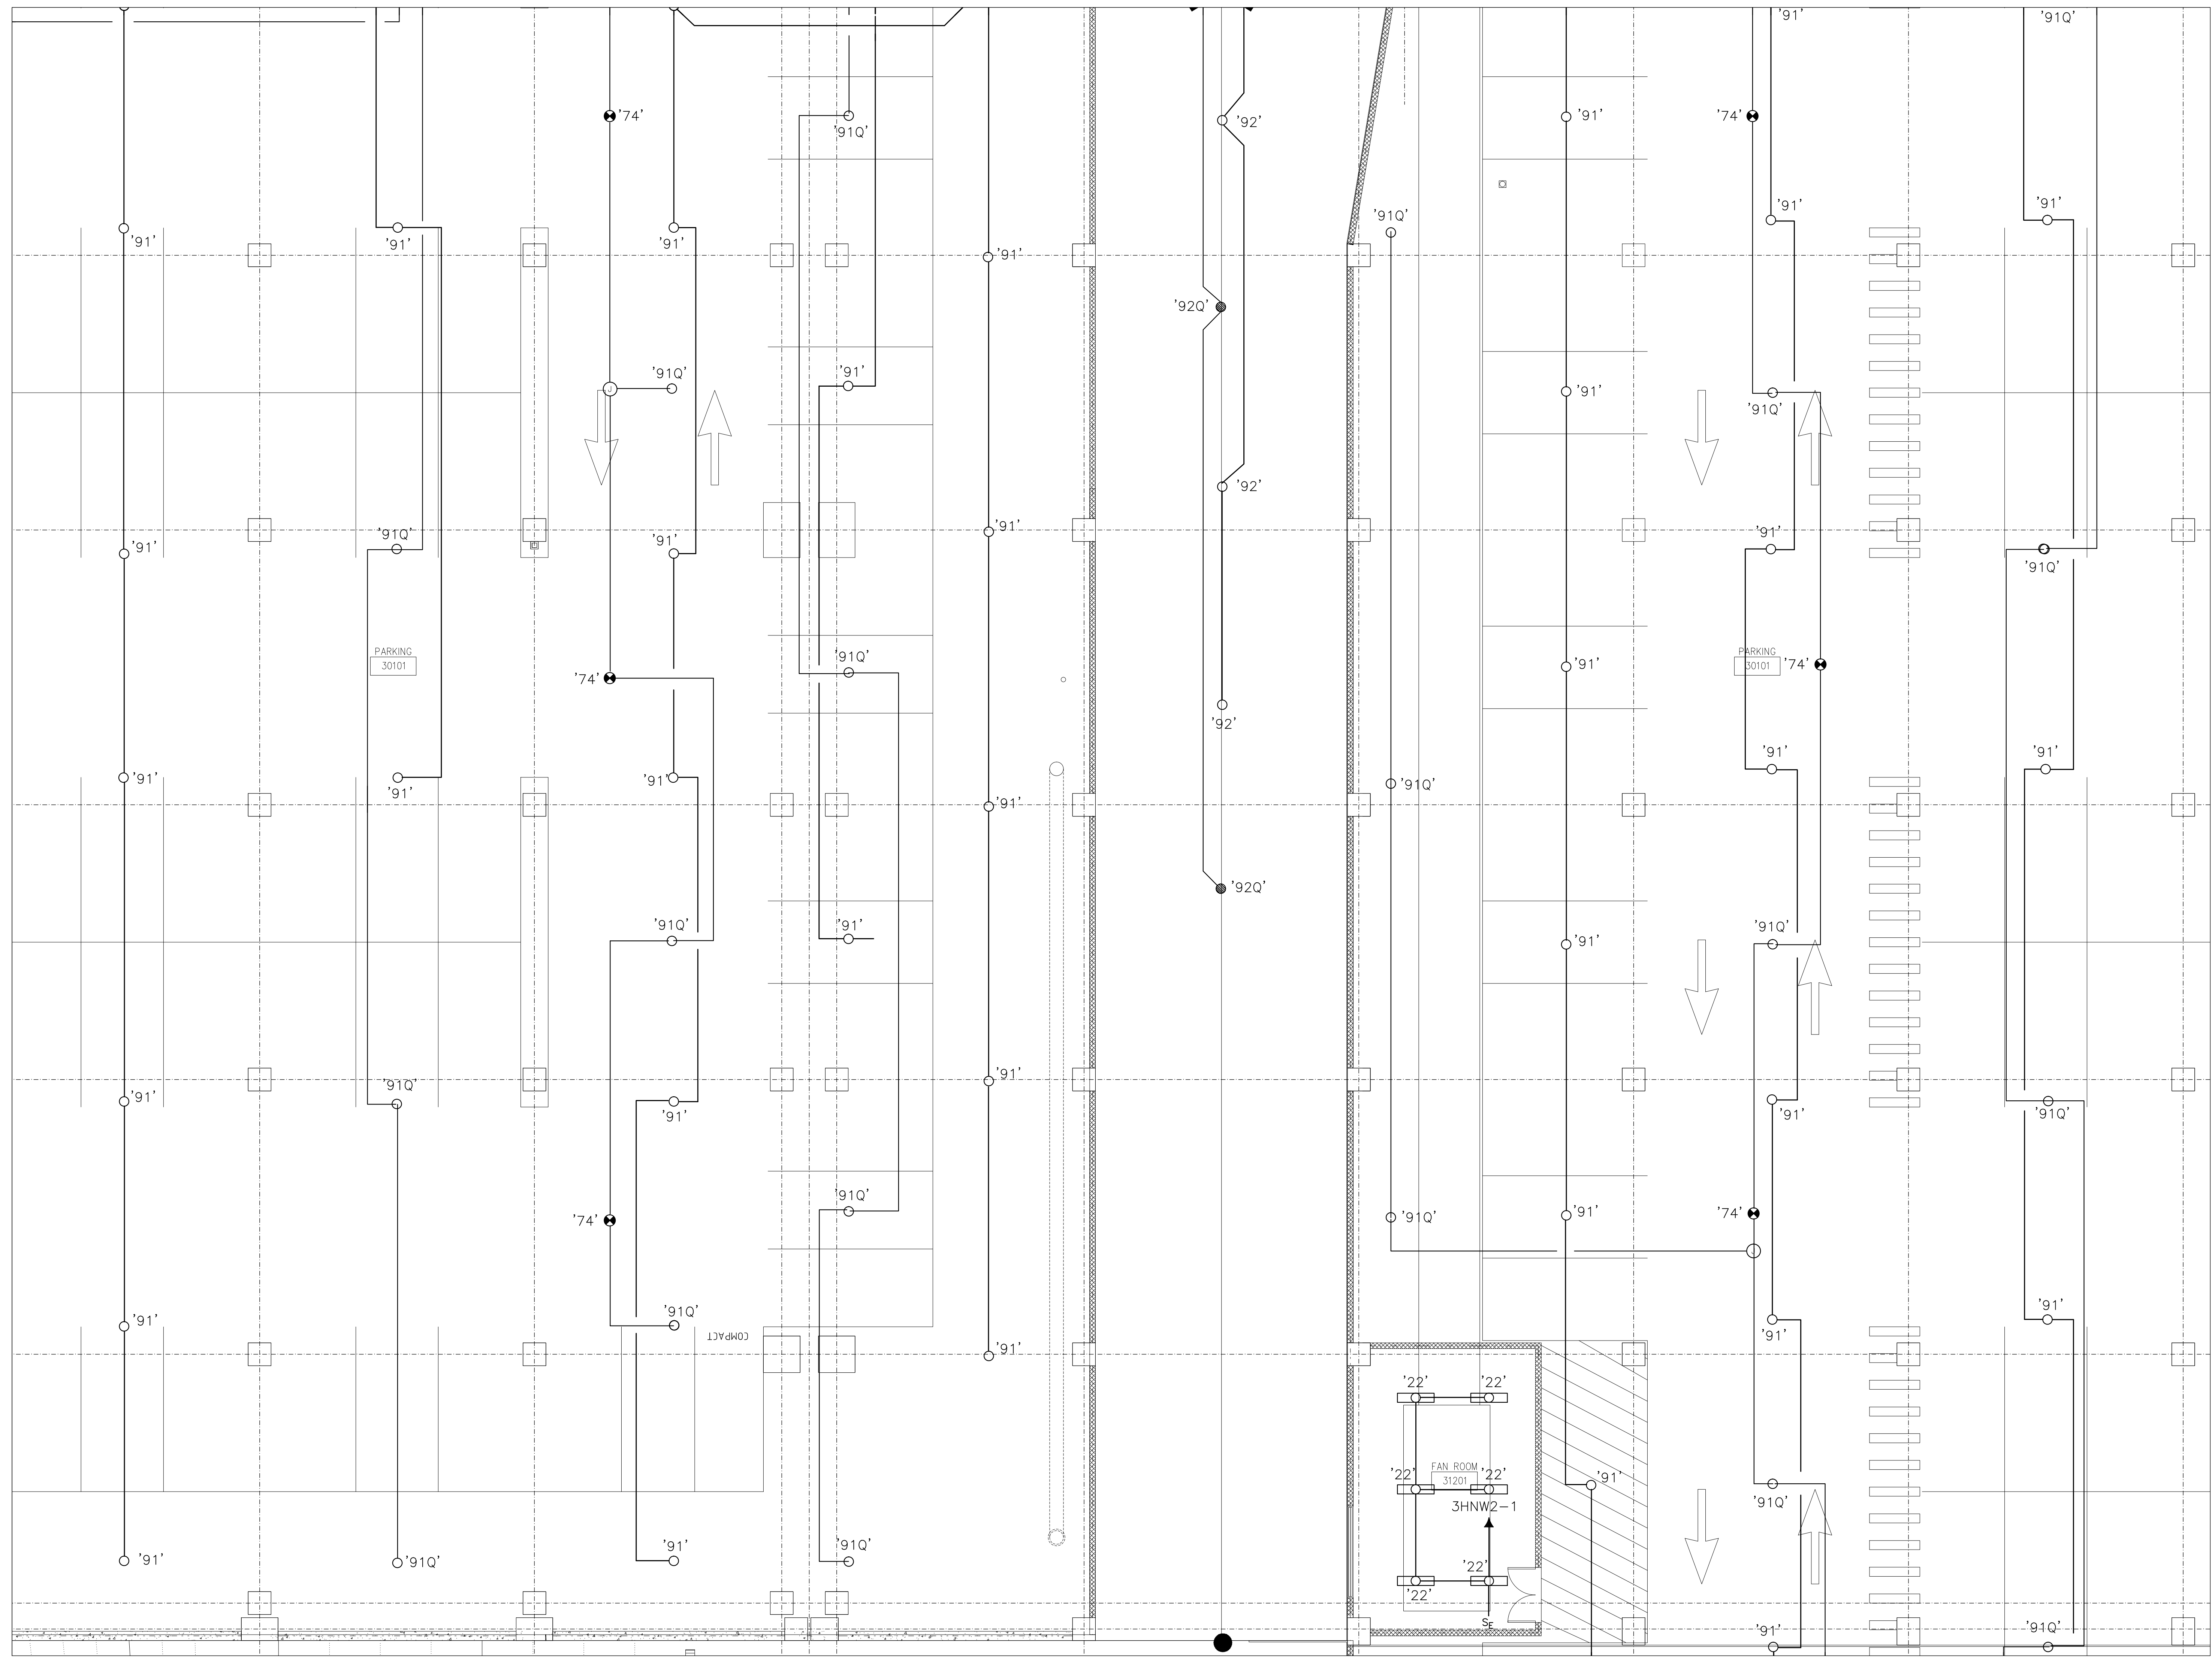

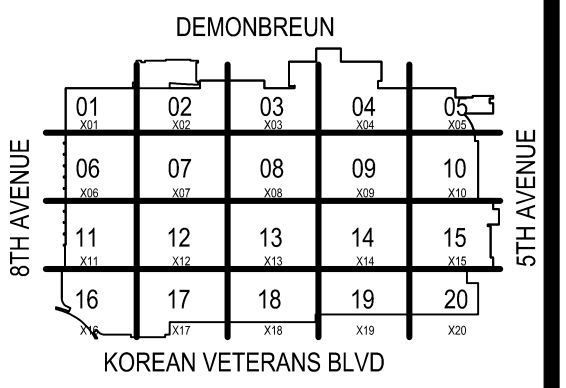

COORDINATION SIGN-OFF		DATE	NAME	TRADE
COMPANY	CONTI	/ /		ELEC.
		/ /		
		/ /		
		/ /		
		/ /		

**Music City Center**  
Nashville, Tennessee

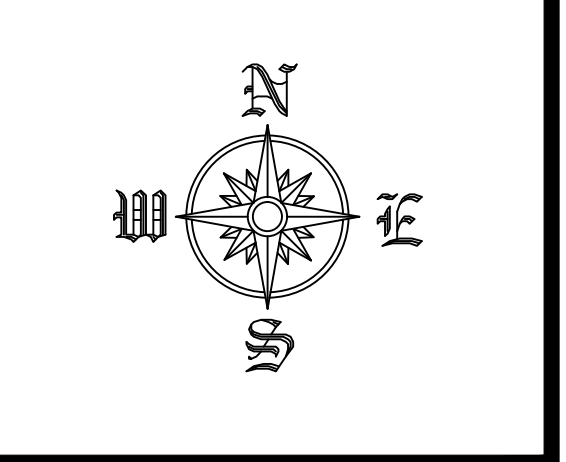


REVISIONS		
NO.	DATE	DESCRIPTION

**RECORD DRAWINGS STAMP**

CONTELECTRIC DATE (Last Update): 2/21/2012 10:00 AM  
 DRAWING FILE NAME: E22-14  
 CAD OPERATOR: GEMMAN  
 PRINTED BY: FREDMAN, GREGG  
 PLOT DATE: 2/21/2012 2:02 PM  
 SUBMITTED BY: GEM  
 ASSIGNED TO:

LEVEL 3 LIGHTING  
 ZONE 13  
 SCALE: 1/8" = 1'-0"


EL2-313

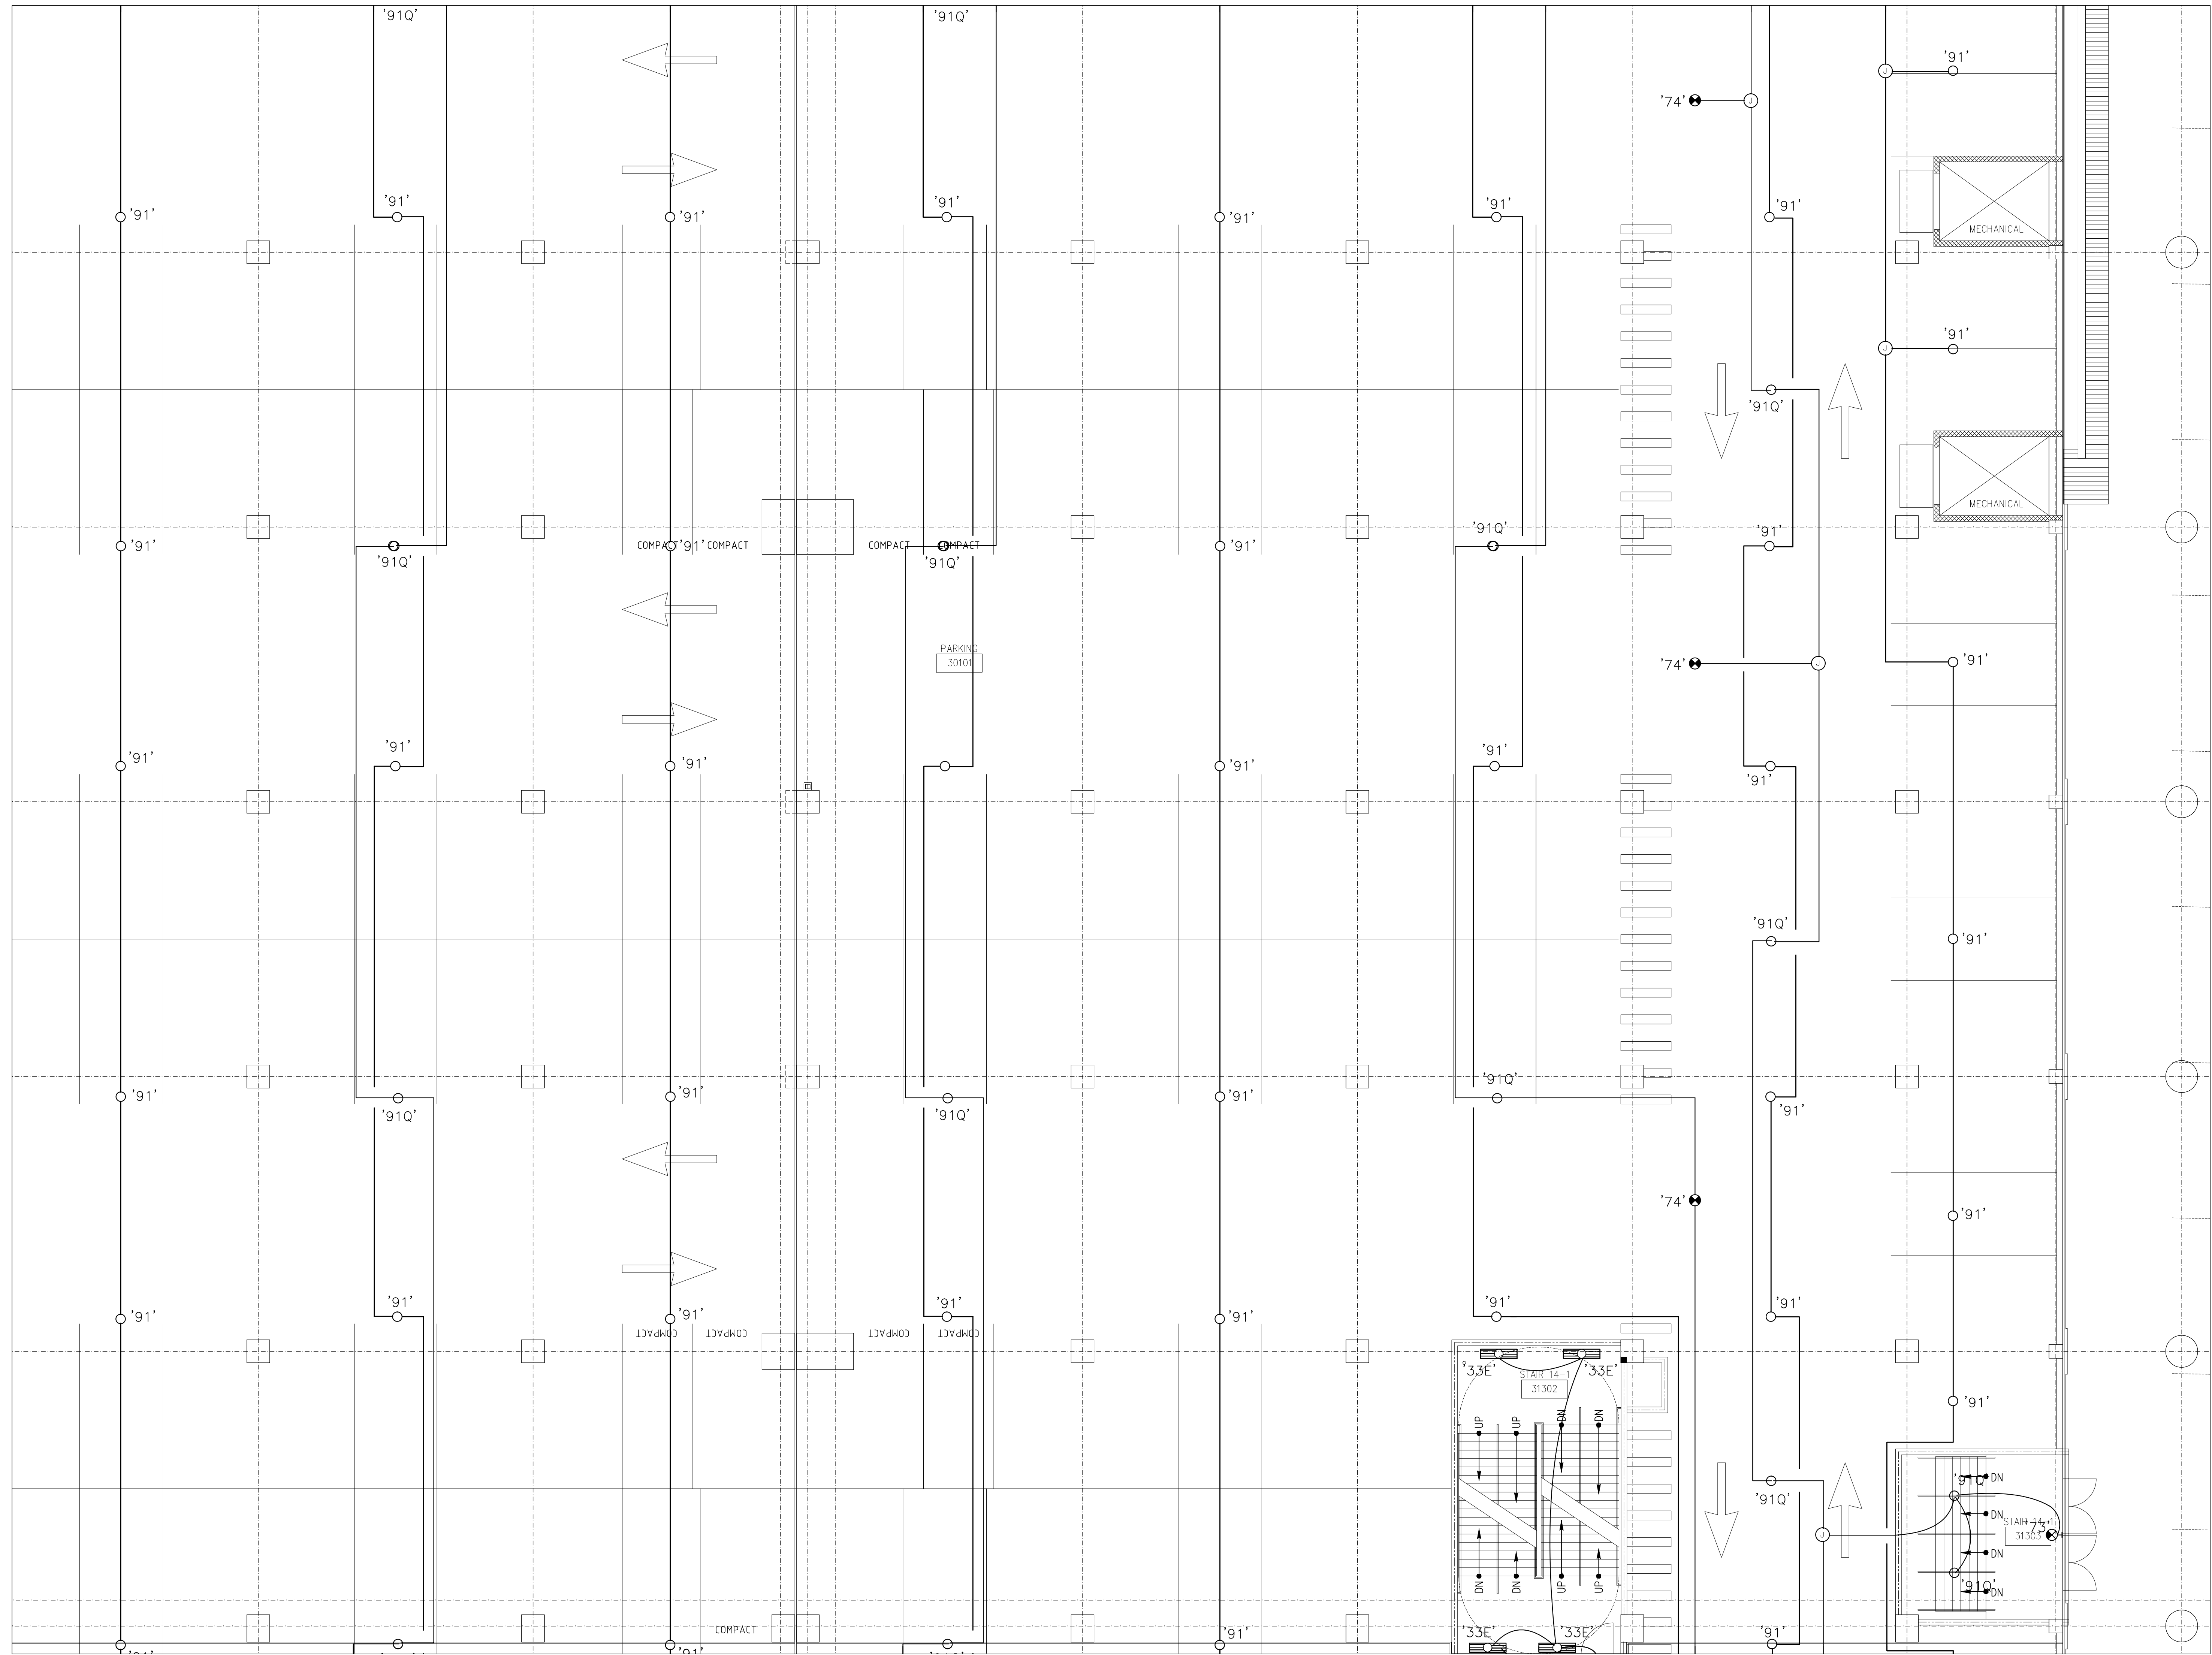

FILE PATH FOR CAD OPERATOR USE ONLY: P:\2012\Conti Electric\Nashville\_MCC\Zone 13 - Conti As-Built - E22-14\Zone 13 Lighting Symbols For Overlay.dwg

COORDINATION SIGN-OFF	
DATE	NAME
TRADE	ELEC.
COMPANY	


**Music City Center**  
 Nashville, Tennessee

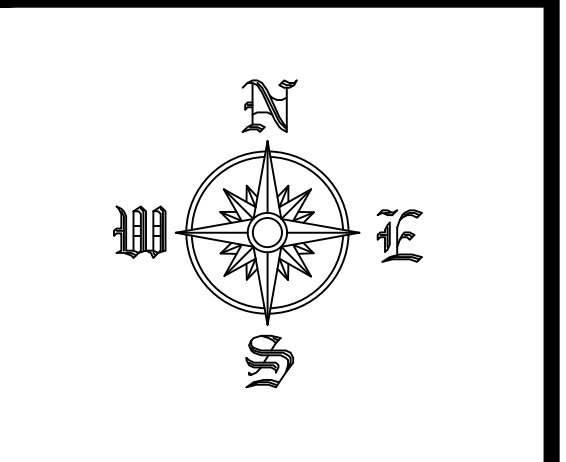REVISIONS		
NO.	DATE	DESCRIPTION

**RECORD DRAWINGS STAMP**


CONTI ELECTRIC DATE (Last Update):  
 2/21/2012 1:02 PM  
 DRAWING FILE NAME:  
 EL2-314  
 CAD OPERATOR:  
 GREGG  
 PRINTED BY:  
 FREDMAN, GREGG  
 PLOT DATE:  
 2/21/2012 1:02 PM  
 SUBMITTED BY:  
 GREGG  
 ASSIGNED TO:

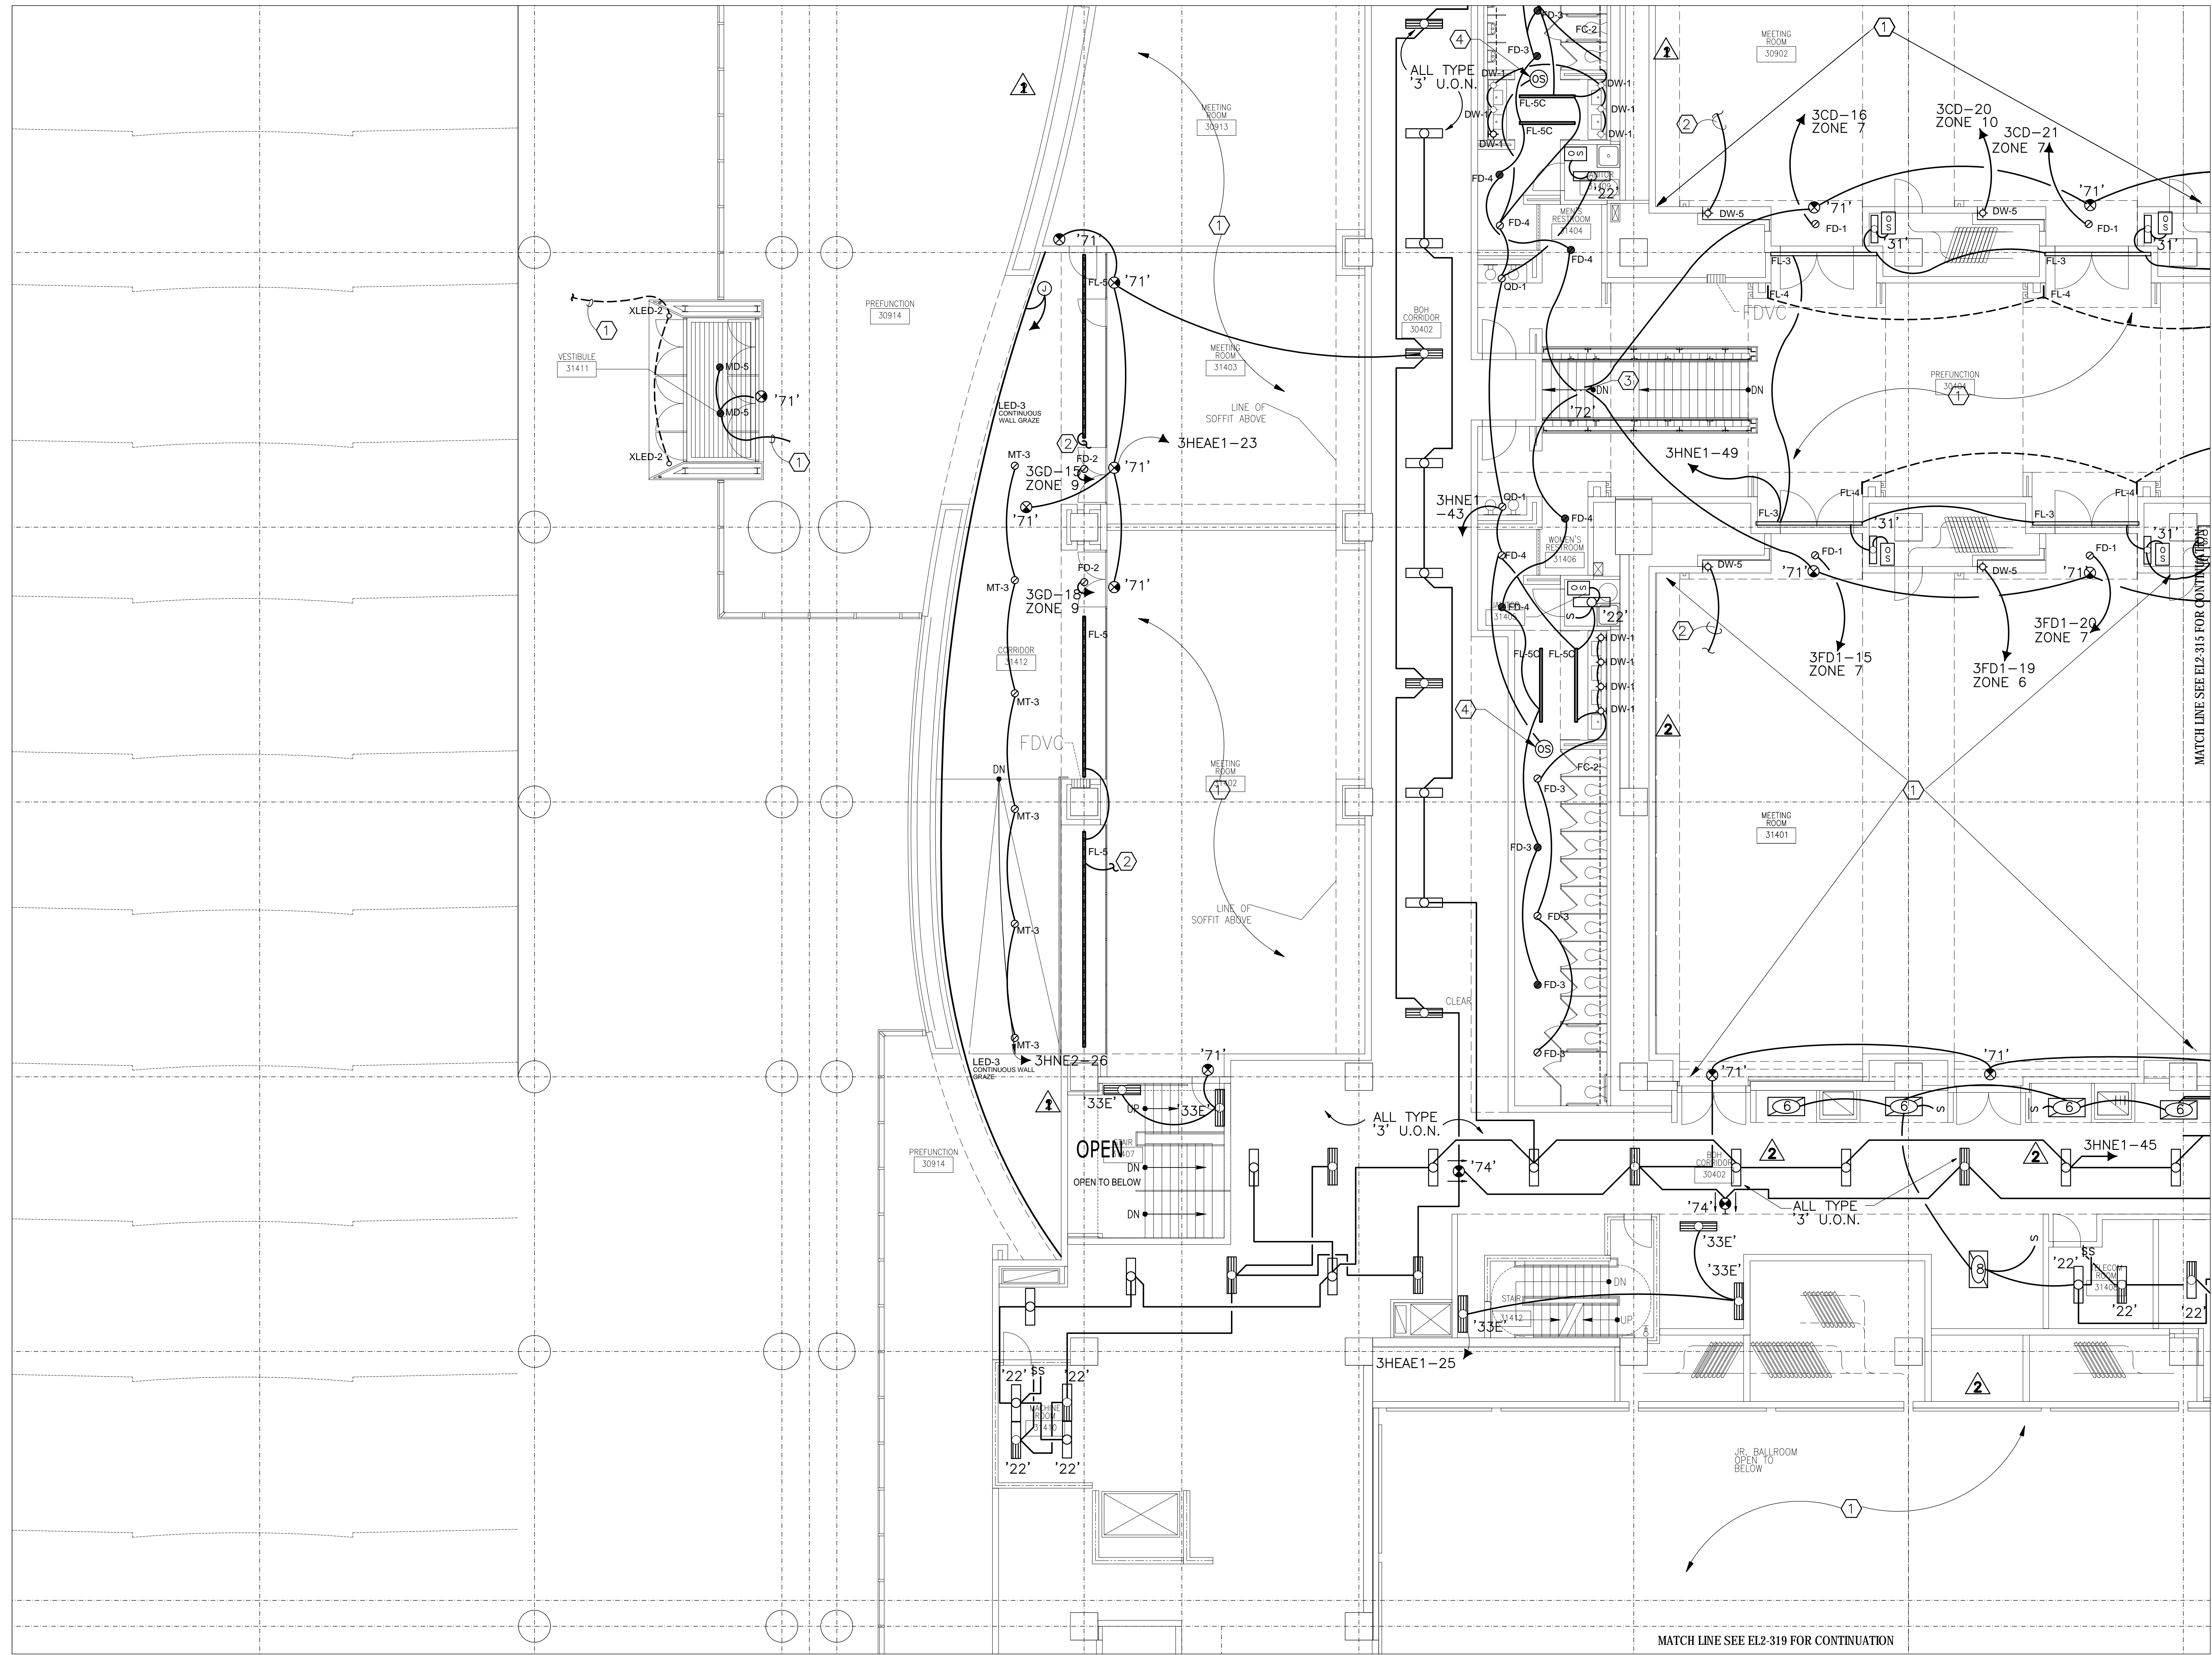

LEVEL 3 LIGHTING  
 ZONE 14  
 SCALE: 1/8" = 1'-0"


EL2-314

FILE PATH FOR CAD OPERATOR USE ONLY: P:\3000\Conti Electric\Projects\MusicCity\Level 3 Lighting\Subarea For Opening.dwg

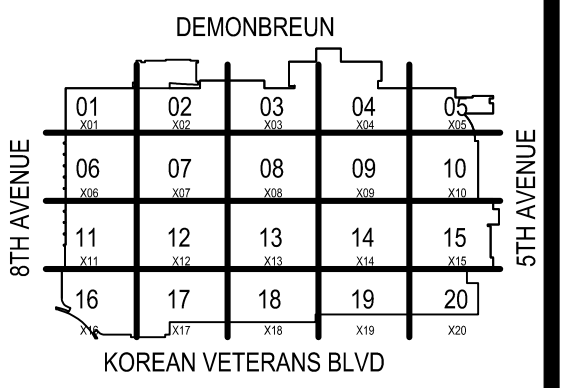

COORDINATION SIGN-OFF	
DATE	NAME
/ /	/ /
/ /	/ /
COMPANY	TRADE
CONTI	ELEC.

Music City Center  
Nashville, Tennessee

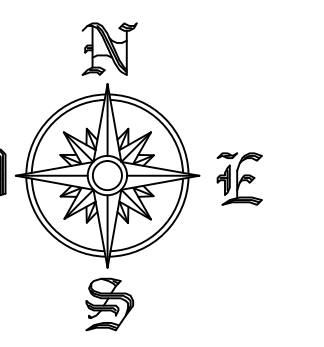


REVISIONS		
NO.	DATE	DESCRIPTION


RECORD DRAWINGS STAMP	
CONTRACT DATE (Last Update):	2/21/2012 10:00 AM
DRAWING FILE NAME:	EL2-315
CAD OPERATOR:	SEYMEN
PRINTED BY:	SEYMEN, GREGG
PLOT DATE:	2/21/2012 2:02 PM
SUBMITTED BY:	ELP
ASSIGNED TO:	

LEVEL 3 LIGHTING  
ZONE 15  
SCALE: 1/8" = 1'-0"

EL2-315

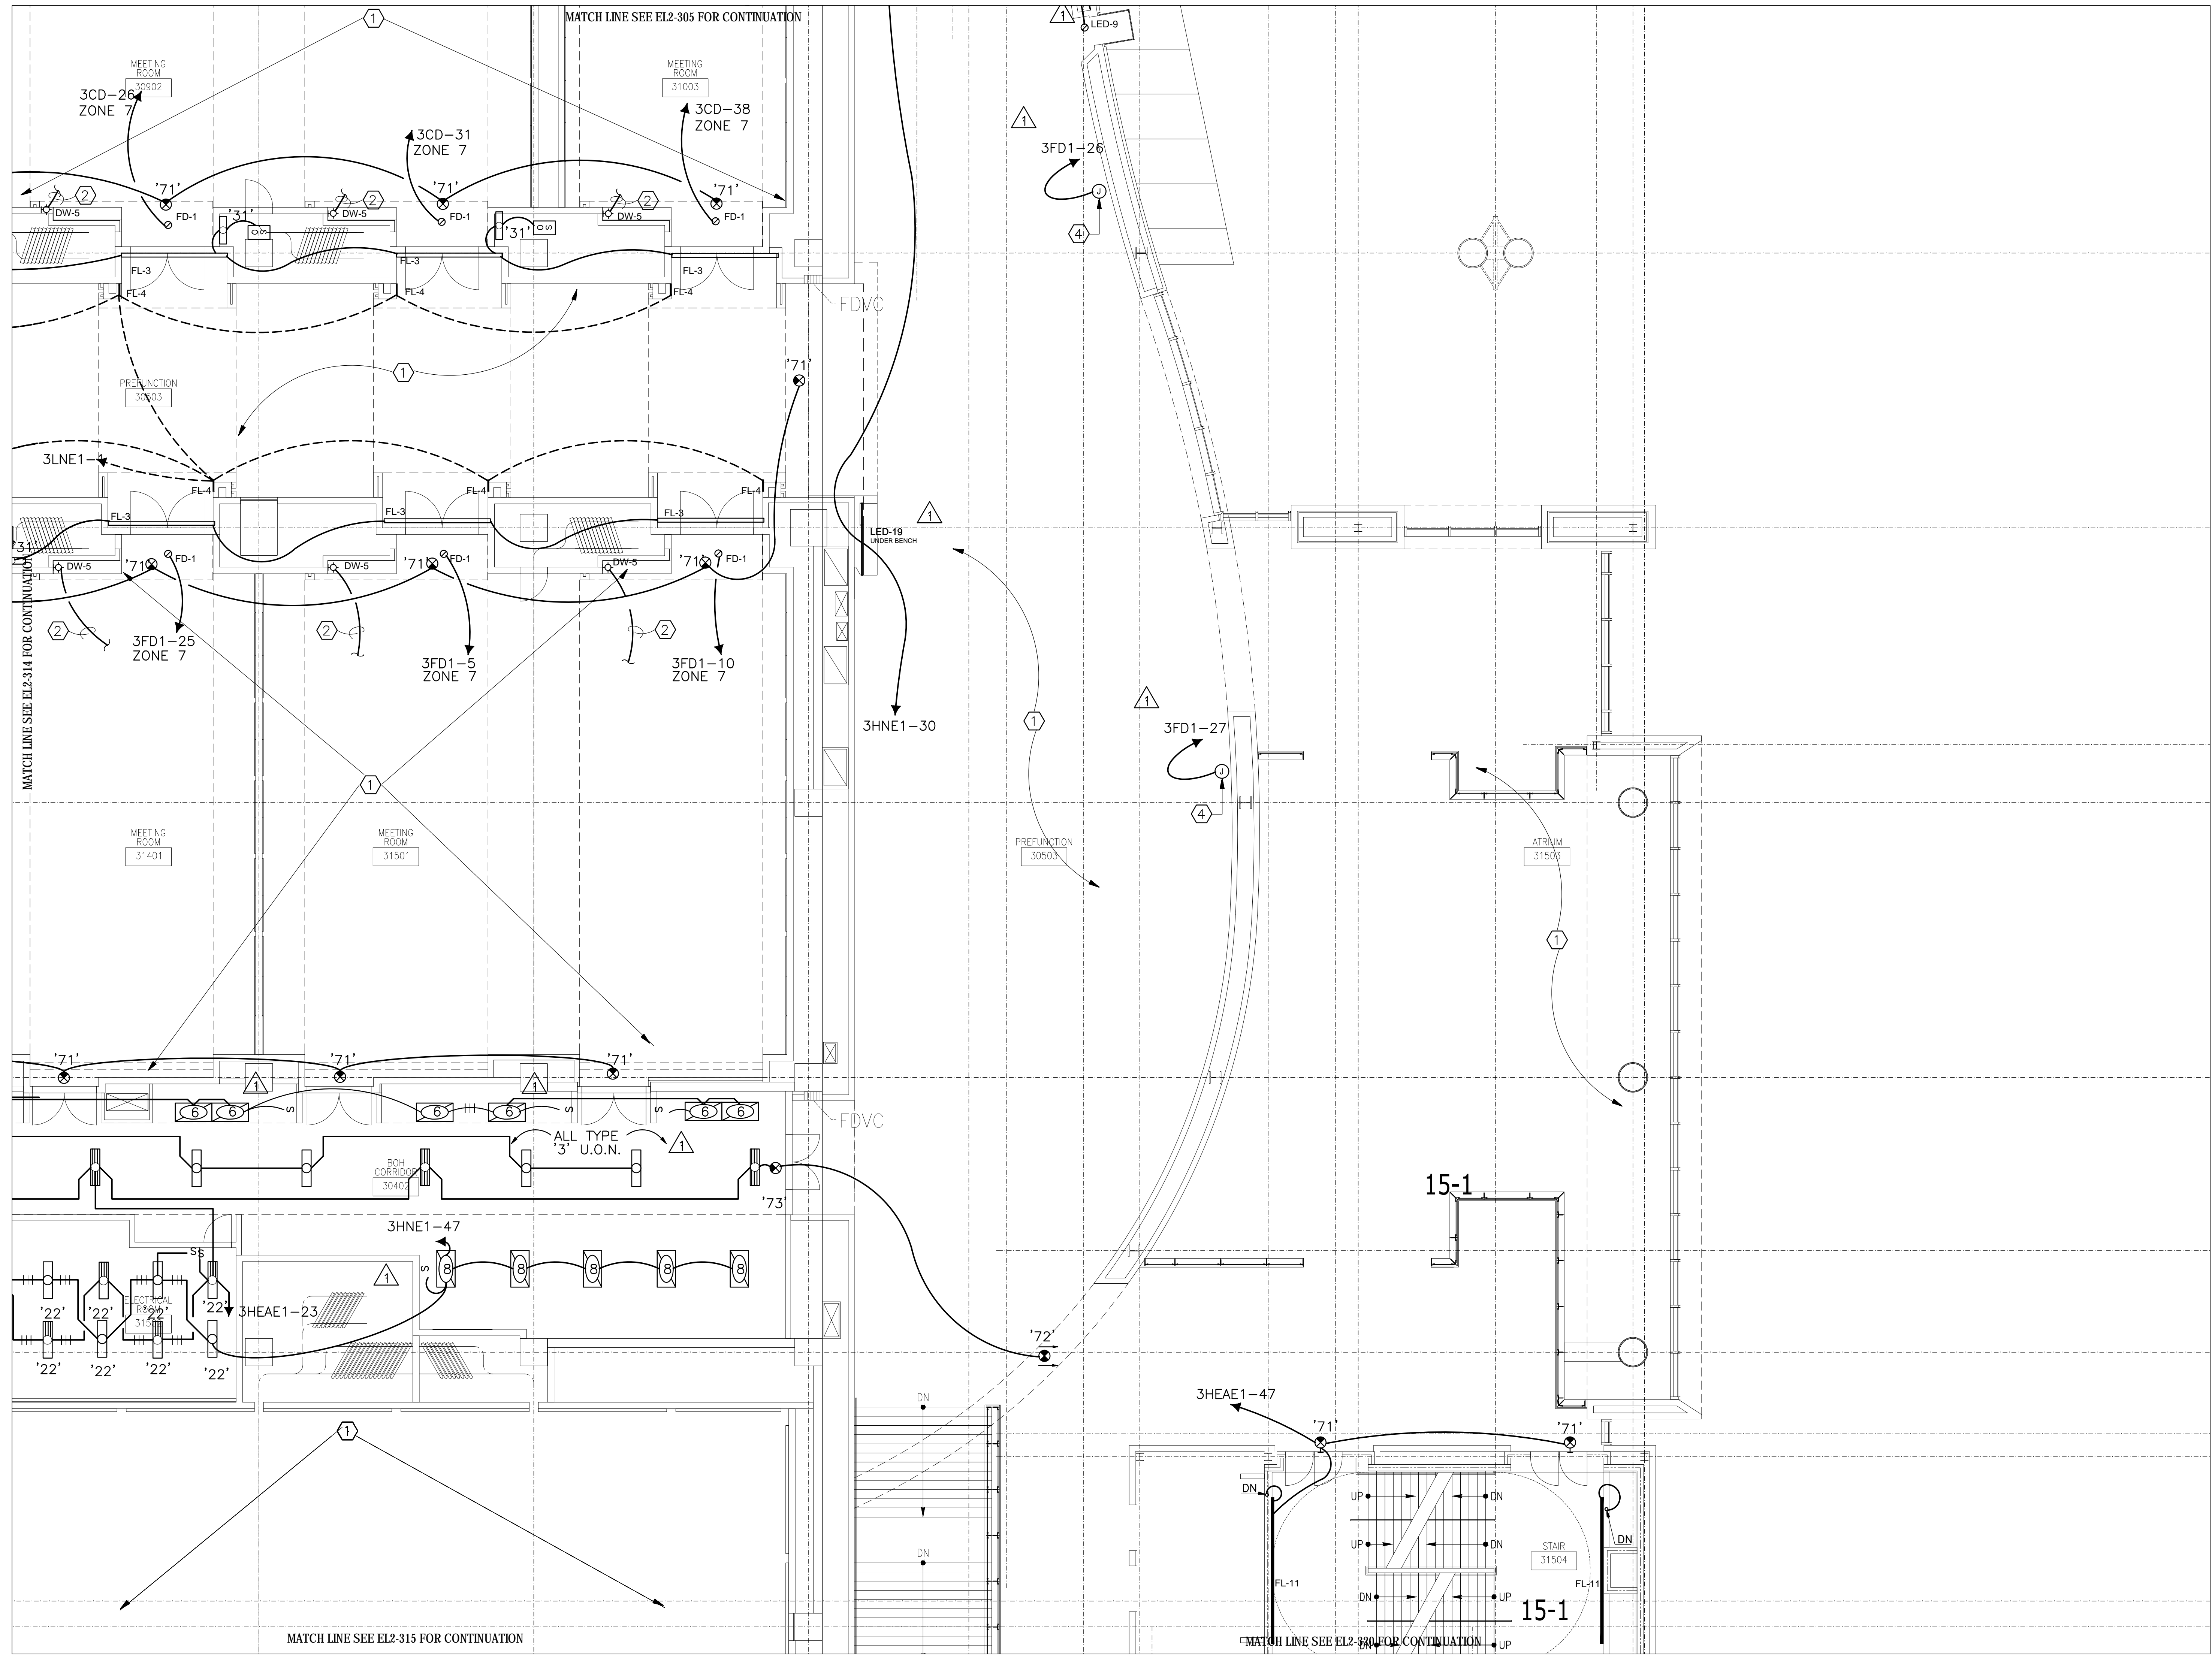


FILE PATH FOR CAD DEPARTMENT USE ONLY: C:\Users\Conti\Desktop\Projects\MusicCity\Level 3 Lighting\Zone 15 For Opening

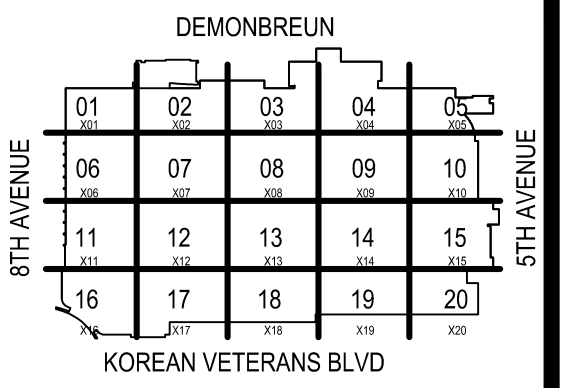

COORDINATION SIGN-OFF

COMPANY	TRADE	DATE
CONTI	ELEC.	/ /
		/ /
		/ /
**Music City Center**  
 Nashville, Tennessee

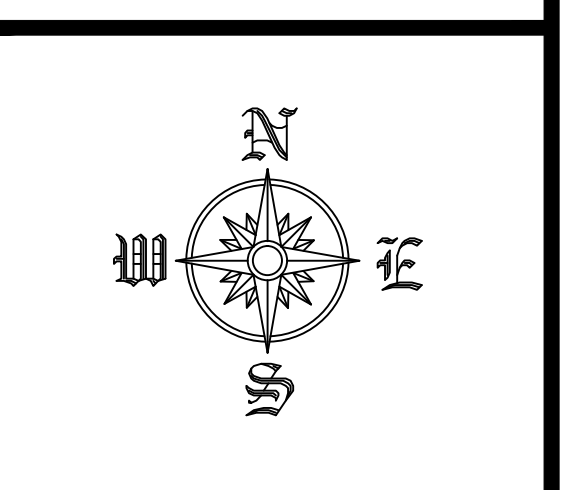

REVISIONS


NO.	DATE	DESCRIPTION

**RECORD DRAWINGS STAMP**

CONTRACT DATE (Last Update): 2/20/2012 10:00 AM  
 DRAWING FILE NAME: E2-19  
 CAD OPERATOR: GEMMAN  
 PRINTED BY: FREDMAN, GREGG  
 PLOT DATE: 2/21/2012 2:02 PM  
 SUBMITTED BY: G.P.  
 ASSIGNED TO:


LEVEL 3 LIGHTING  
 ZONE 17  
 SCALE: 1/8" = 1'-0"

EL2-317

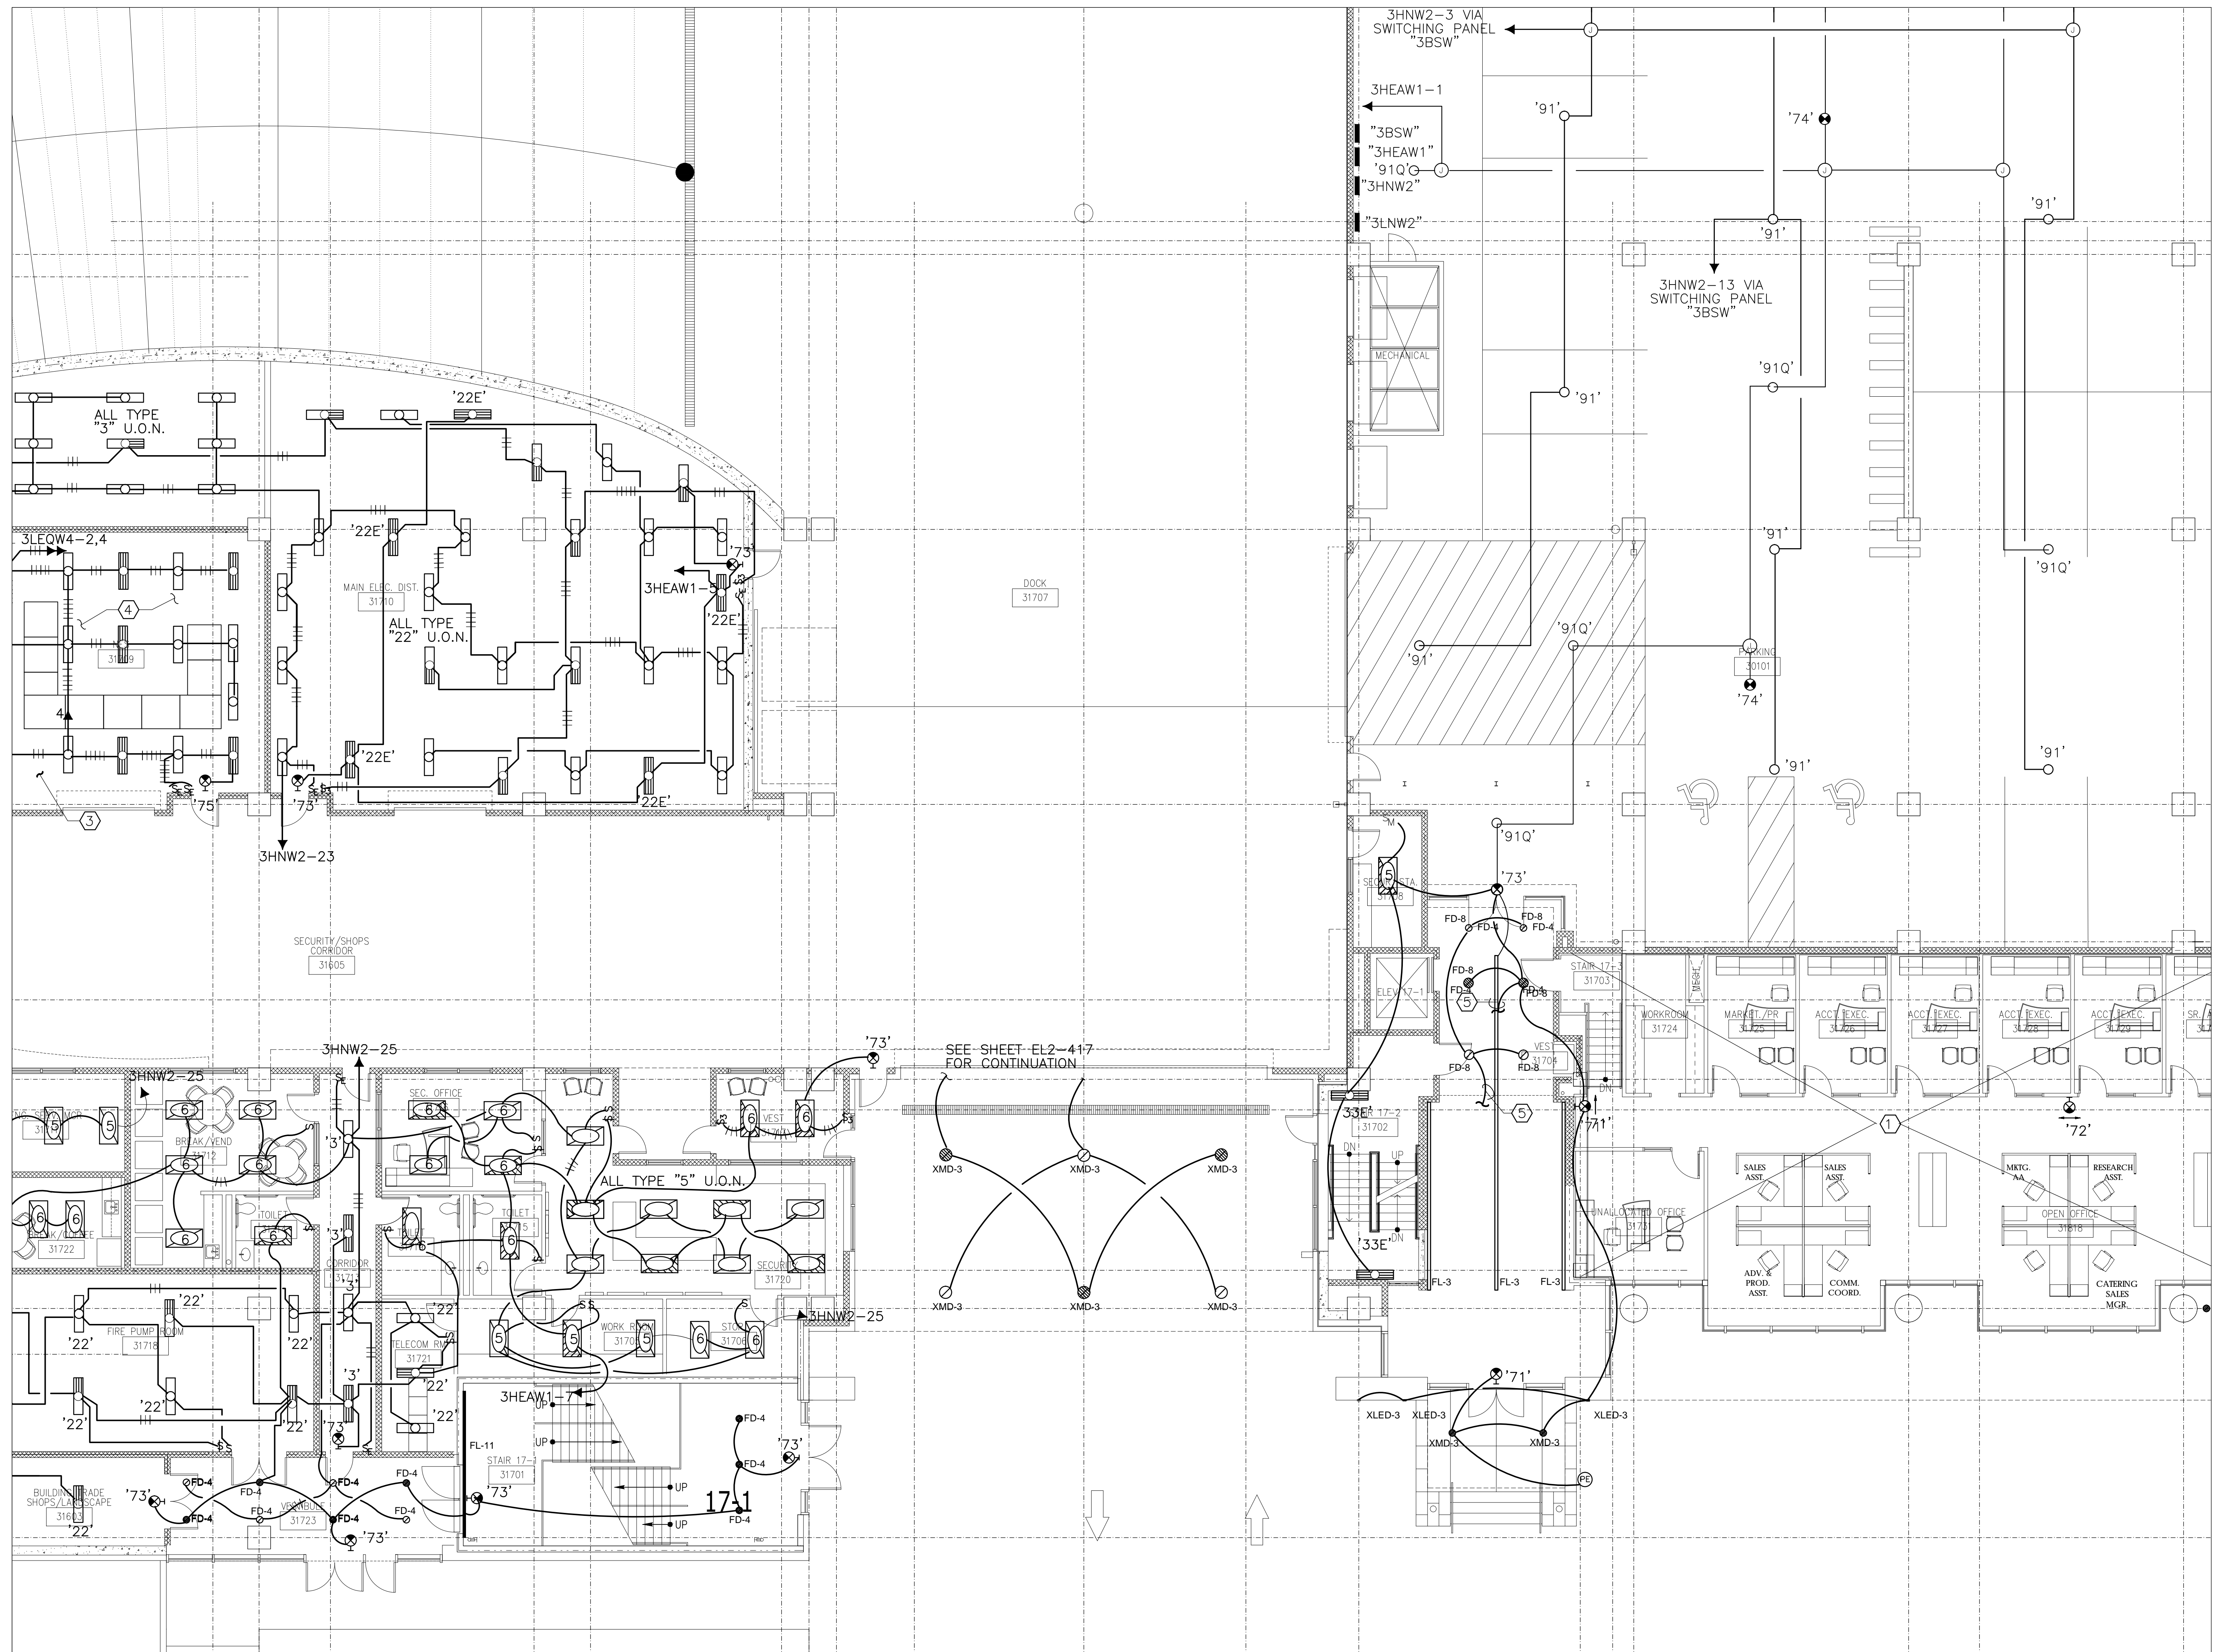

FILE PATH FOR CAD OPERATOR USE ONLY: P:\3100\Conti\Bldg\3100\Zone 17\Zone 17 Lighting\Zone 17 Lighting.dwg




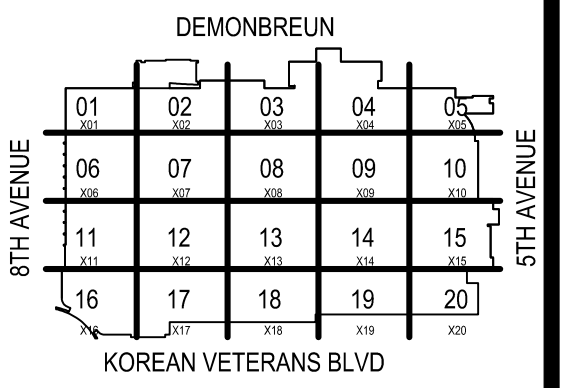

KEY PLAN  
NO SCALE

COORDINATION SIGN-OFF	
DATE	NAME
COMPANY	TRADE
	ELEC.

**Music City Center**  
Nashville, Tennessee

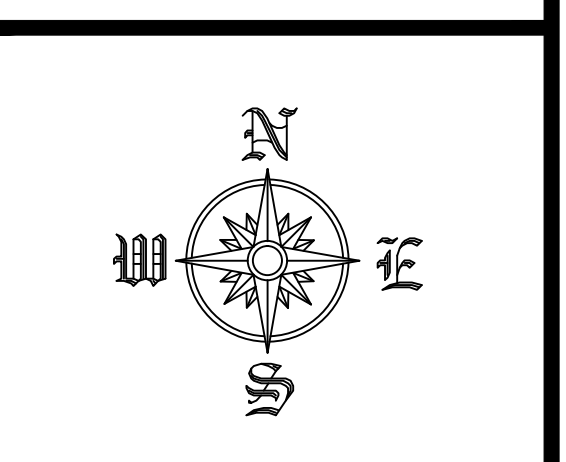


REVISIONS		
NO.	DATE	DESCRIPTION

**RECORD DRAWINGS STAMP**


CONTI ELECTRIC DATE (Last Update):  
 2/21/2012 10:00 AM  
 DRAWING FILE NAME:  
 E2-318  
 CAD OPERATOR:  
 GERTMAN  
 PRINTED BY:  
 FREDMAN, GREGG  
 PLOT DATE:  
 2/21/2012 2:02 PM  
 SUBMITTED BY:  
 G.L.P.  
 ASSIGNED TO:

LEVEL 3 LIGHTING  
 ZONE 18  
 SCALE: 1/8" = 1'-0"

EL2-318

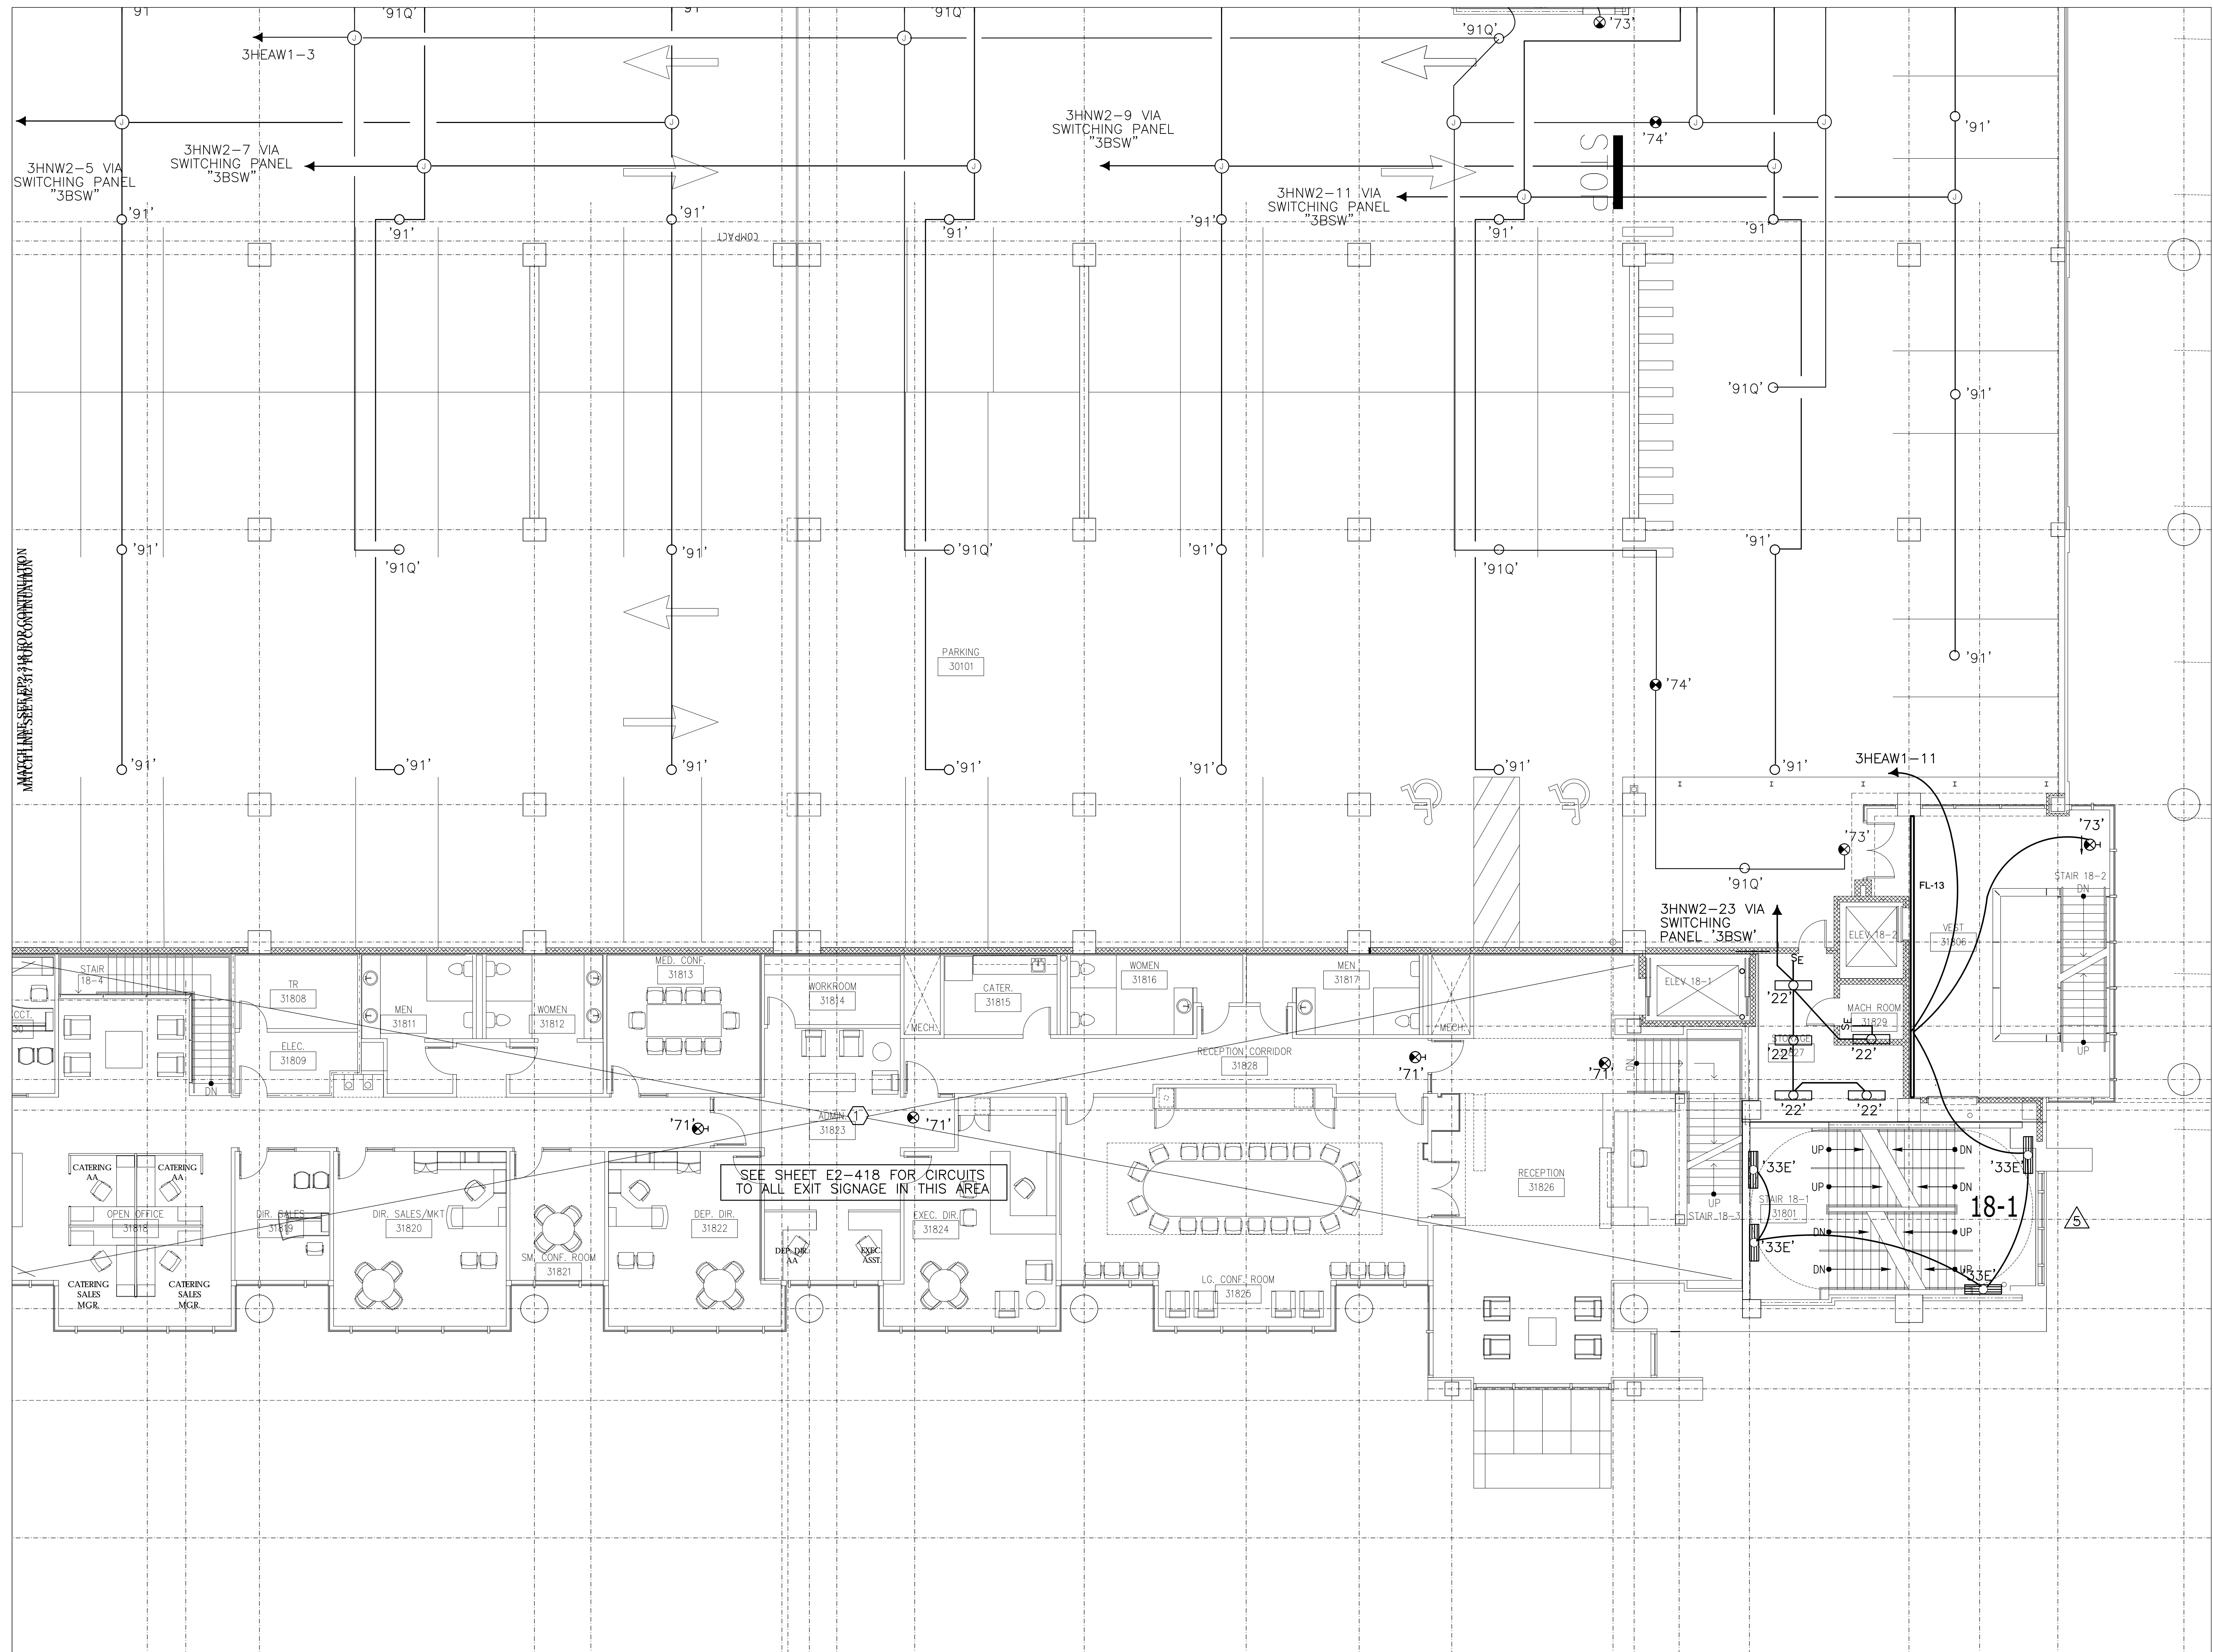


FILE PATH FOR CAD OPERATOR USE ONLY: C:\Users\Gertman\Documents\Projects\Level 3 Lighting\Zone 18 For Operating

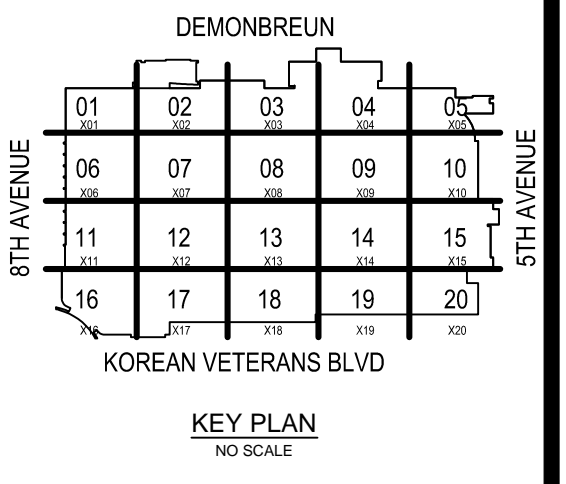

COORDINATION SIGN-OFF

COMPANY	TRADE	DATE
CONTI	ELEC.	/ /
		/ /
		/ /
**Music City Center**  
 Nashville, Tennessee

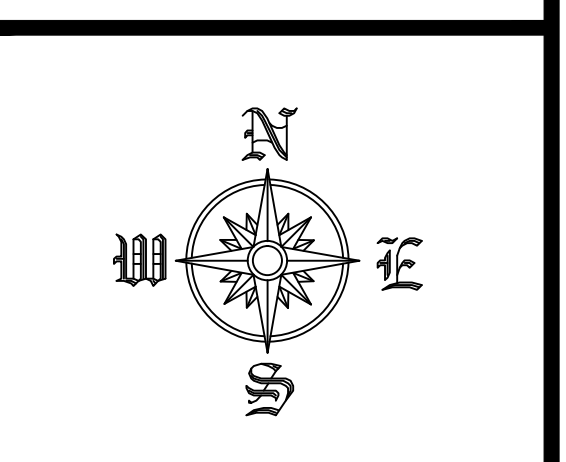

REVISIONS


NO.	DATE	DESCRIPTION

RECORD DRAWINGS STAMP

CONTI ELECTRIC DATE (Last Update): 2/21/2012 11:00 AM  
 DRAWING FILE NAME: EL2-319  
 CAD OPERATOR: GERTMAN  
 PRINTED BY: FREDMAN, GREGG  
 PLOT DATE: 2/21/2012 2:02 PM  
 SUBMITTED BY: G.L.P.  
 ASSIGNED TO:

LEVEL 3 LIGHTING  
 ZONE 19  
 SCALE: 1/8" = 1'-0"

EL2-319

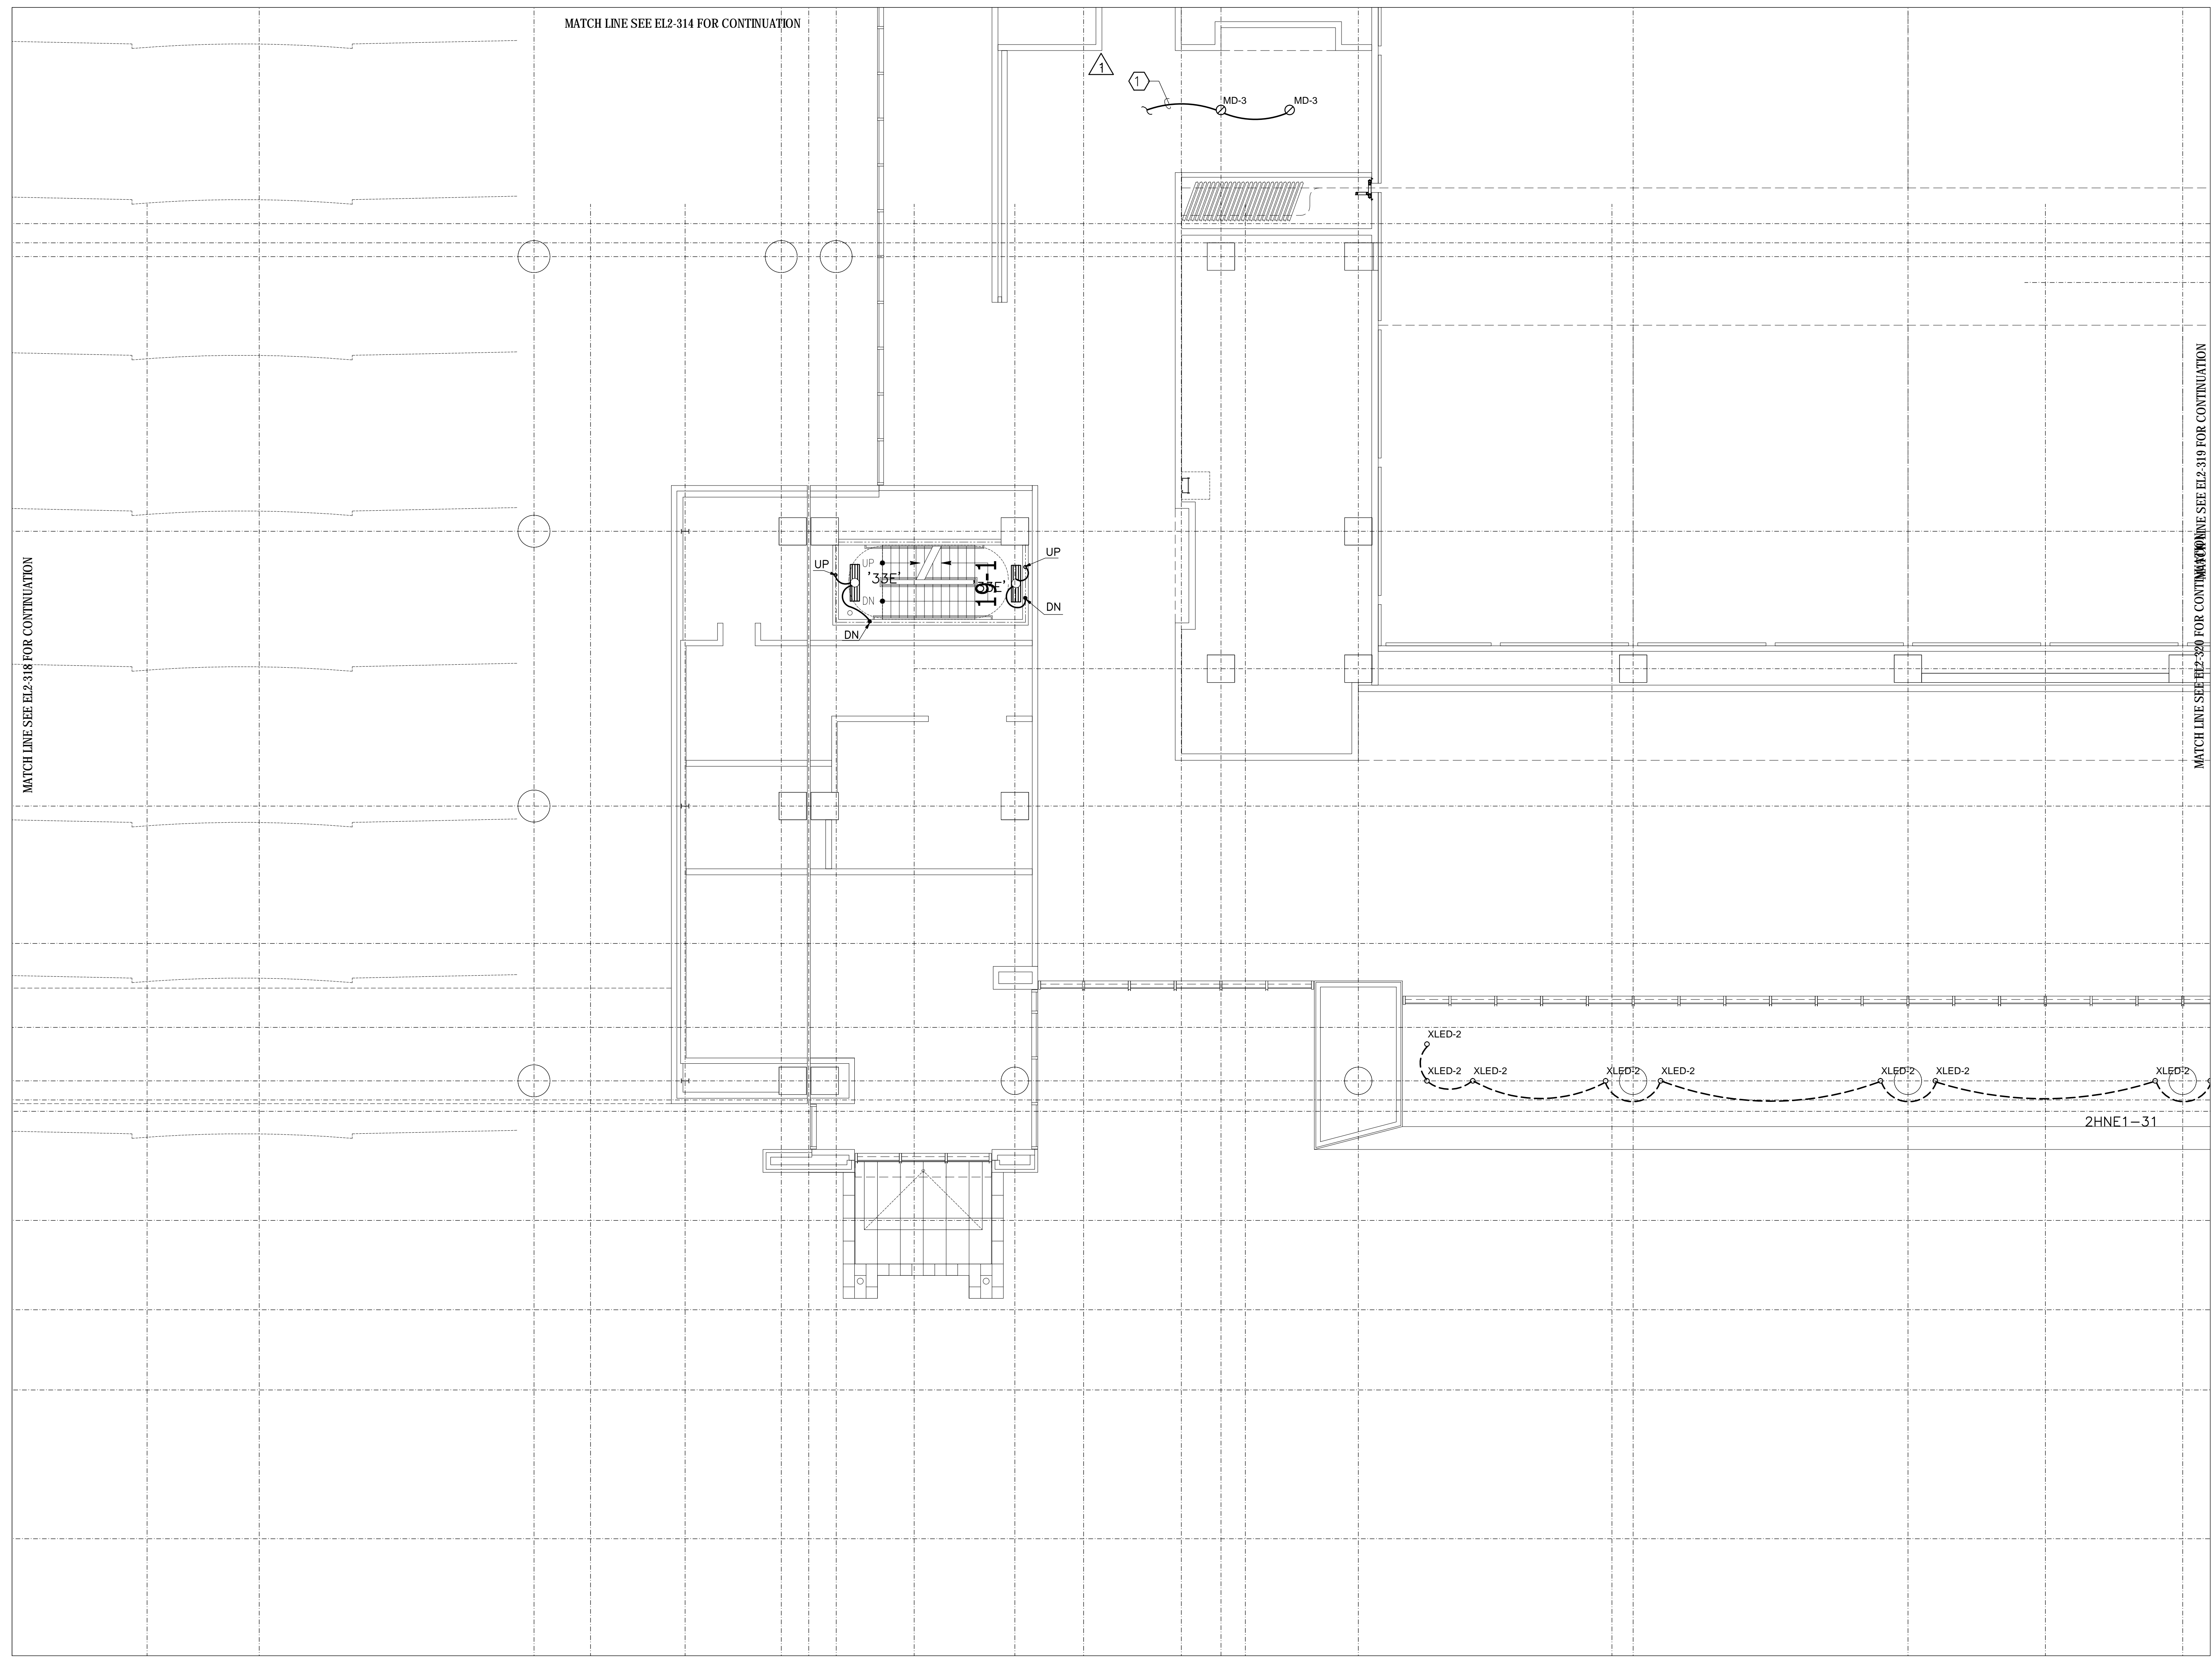


MATCH LINE SEE EL2-318 FOR CONTINUATION

MATCH LINE SEE EL2-314 FOR CONTINUATION

MATCH LINE SEE EL2-319 FOR CONTINUATION


FILE PATH FOR CAD OPERATOR USE ONLY: C:\Users\Gertman\Documents\Projects\Level 3 Lighting\Zone 19 Lighting\Zone 19 Lighting.dwg

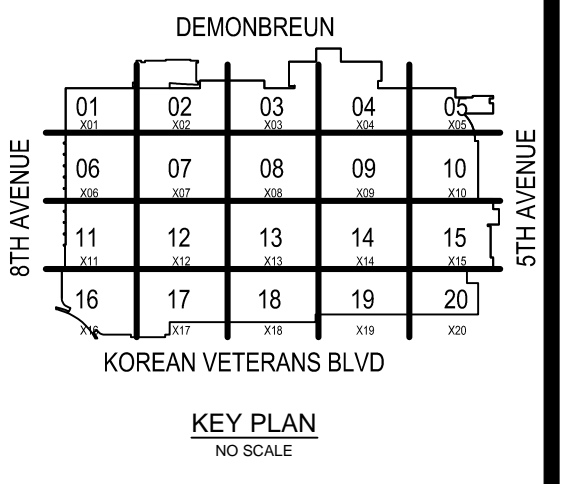

COORDINATION SIGN-OFF

COMPANY	TRADE	DATE
CONTI	ELEC.	/ /
		/ /
		/ /
		/ /
		/ /

**Music City Center**  
 Nashville, Tennessee

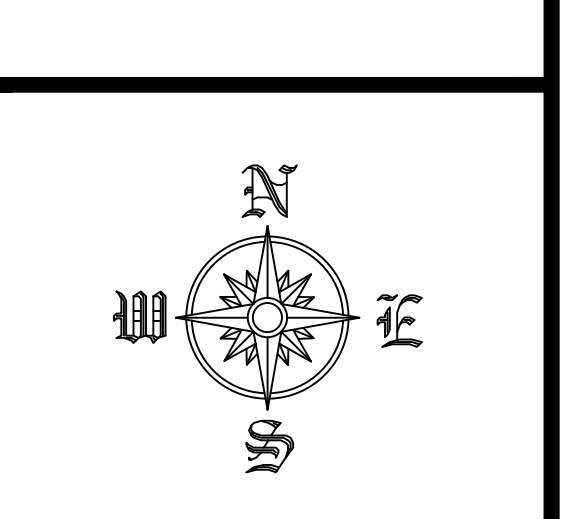

REVISIONS


NO.	DATE	DESCRIPTION

RECORD DRAWINGS STAMP


CONTI ELECTRIC DATE (Last Update): 2/21/2012 10:00 AM  
 DRAWING FILE NAME: EL2-30  
 CAD OPERATOR: GREGG  
 PRINTED BY: GREGG  
 PLOT DATE: 2/21/2012 2:02 PM  
 SUBMITTED BY: GREGG  
 ASSIGNED TO:

LEVEL 3 LIGHTING  
 ZONE 20  
 SCALE: 1/8" = 1'-0"

EL2-320

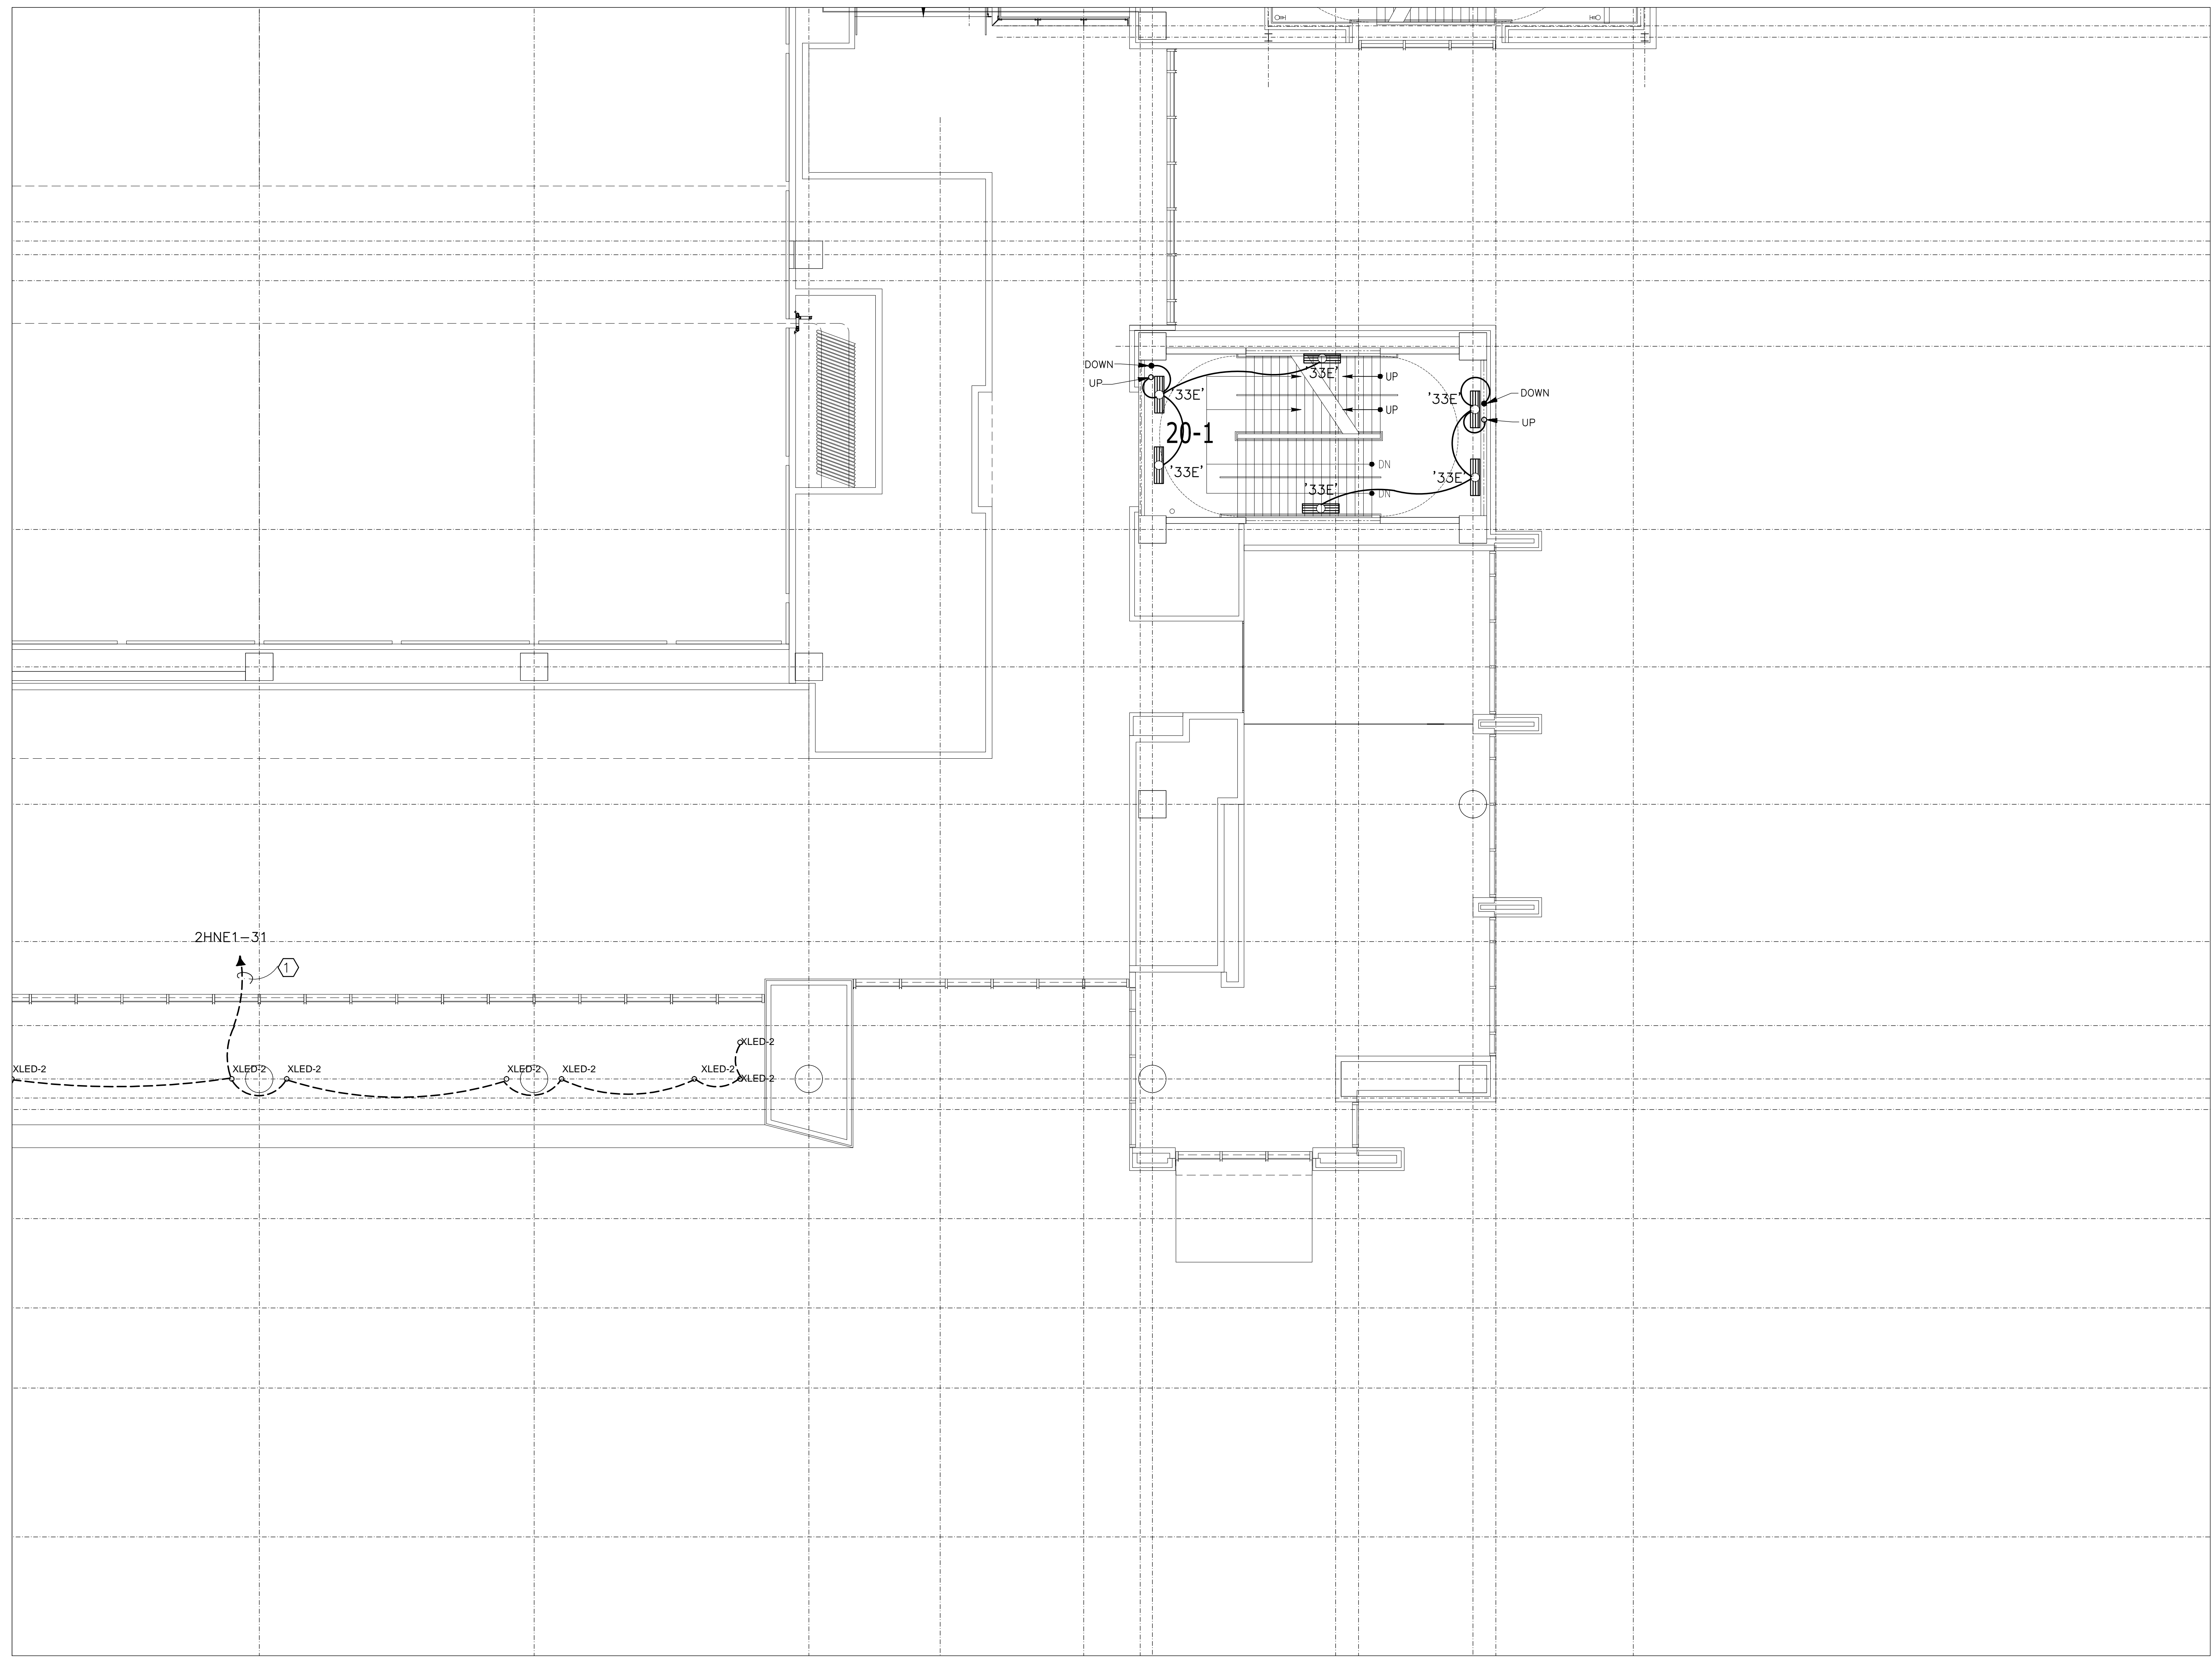


FILE PATH FOR CAD OPERATOR USE ONLY: P:\2012\Conti Electric\Nashville MusicCityCenter\_City Center As-Built\_4.13.12\Level 3 Lighting\_Schedule For Opening

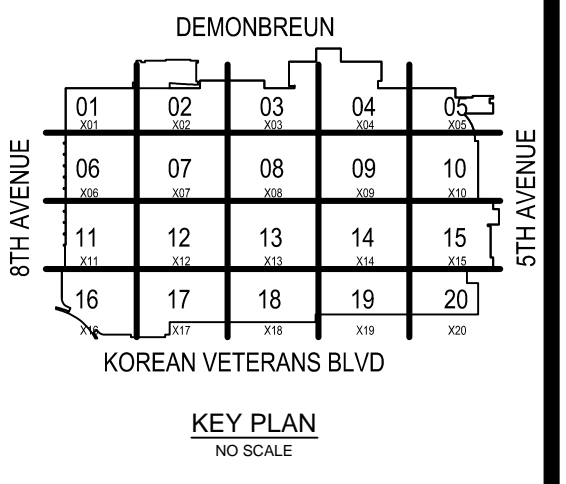

COORDINATION SIGN-OFF

COMPANY	TRADE	NAME	DATE
CONTI	ELEC.		/ /
			/ /
			/ /
			/ /
			/ /

**Music City Center**  
Nashville, Tennessee

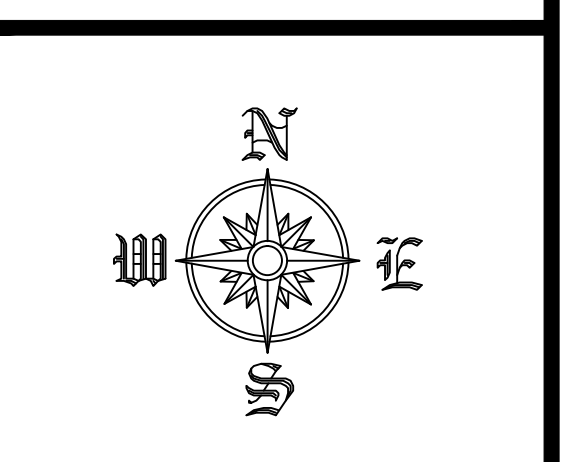

REVISIONS


NO.	DATE	DESCRIPTION

RECORD DRAWINGS STAMP

CONTI ELECTRIC DATE (Last Update): 2/21/2012 10:00 AM  
 DRAWING FILE NAME: EL2-316  
 CAD OPERATOR: GERTMAN  
 PRINTED BY: FREDMAN, GREG  
 PLOT DATE: 2/21/2012 2:02 PM  
 SUBMITTED BY: G.P.  
 ASSIGNED TO:

LEVEL 3 LIGHTING  
 ZONE 16  
 SCALE: 1/8" = 1'-0"

EL2-316

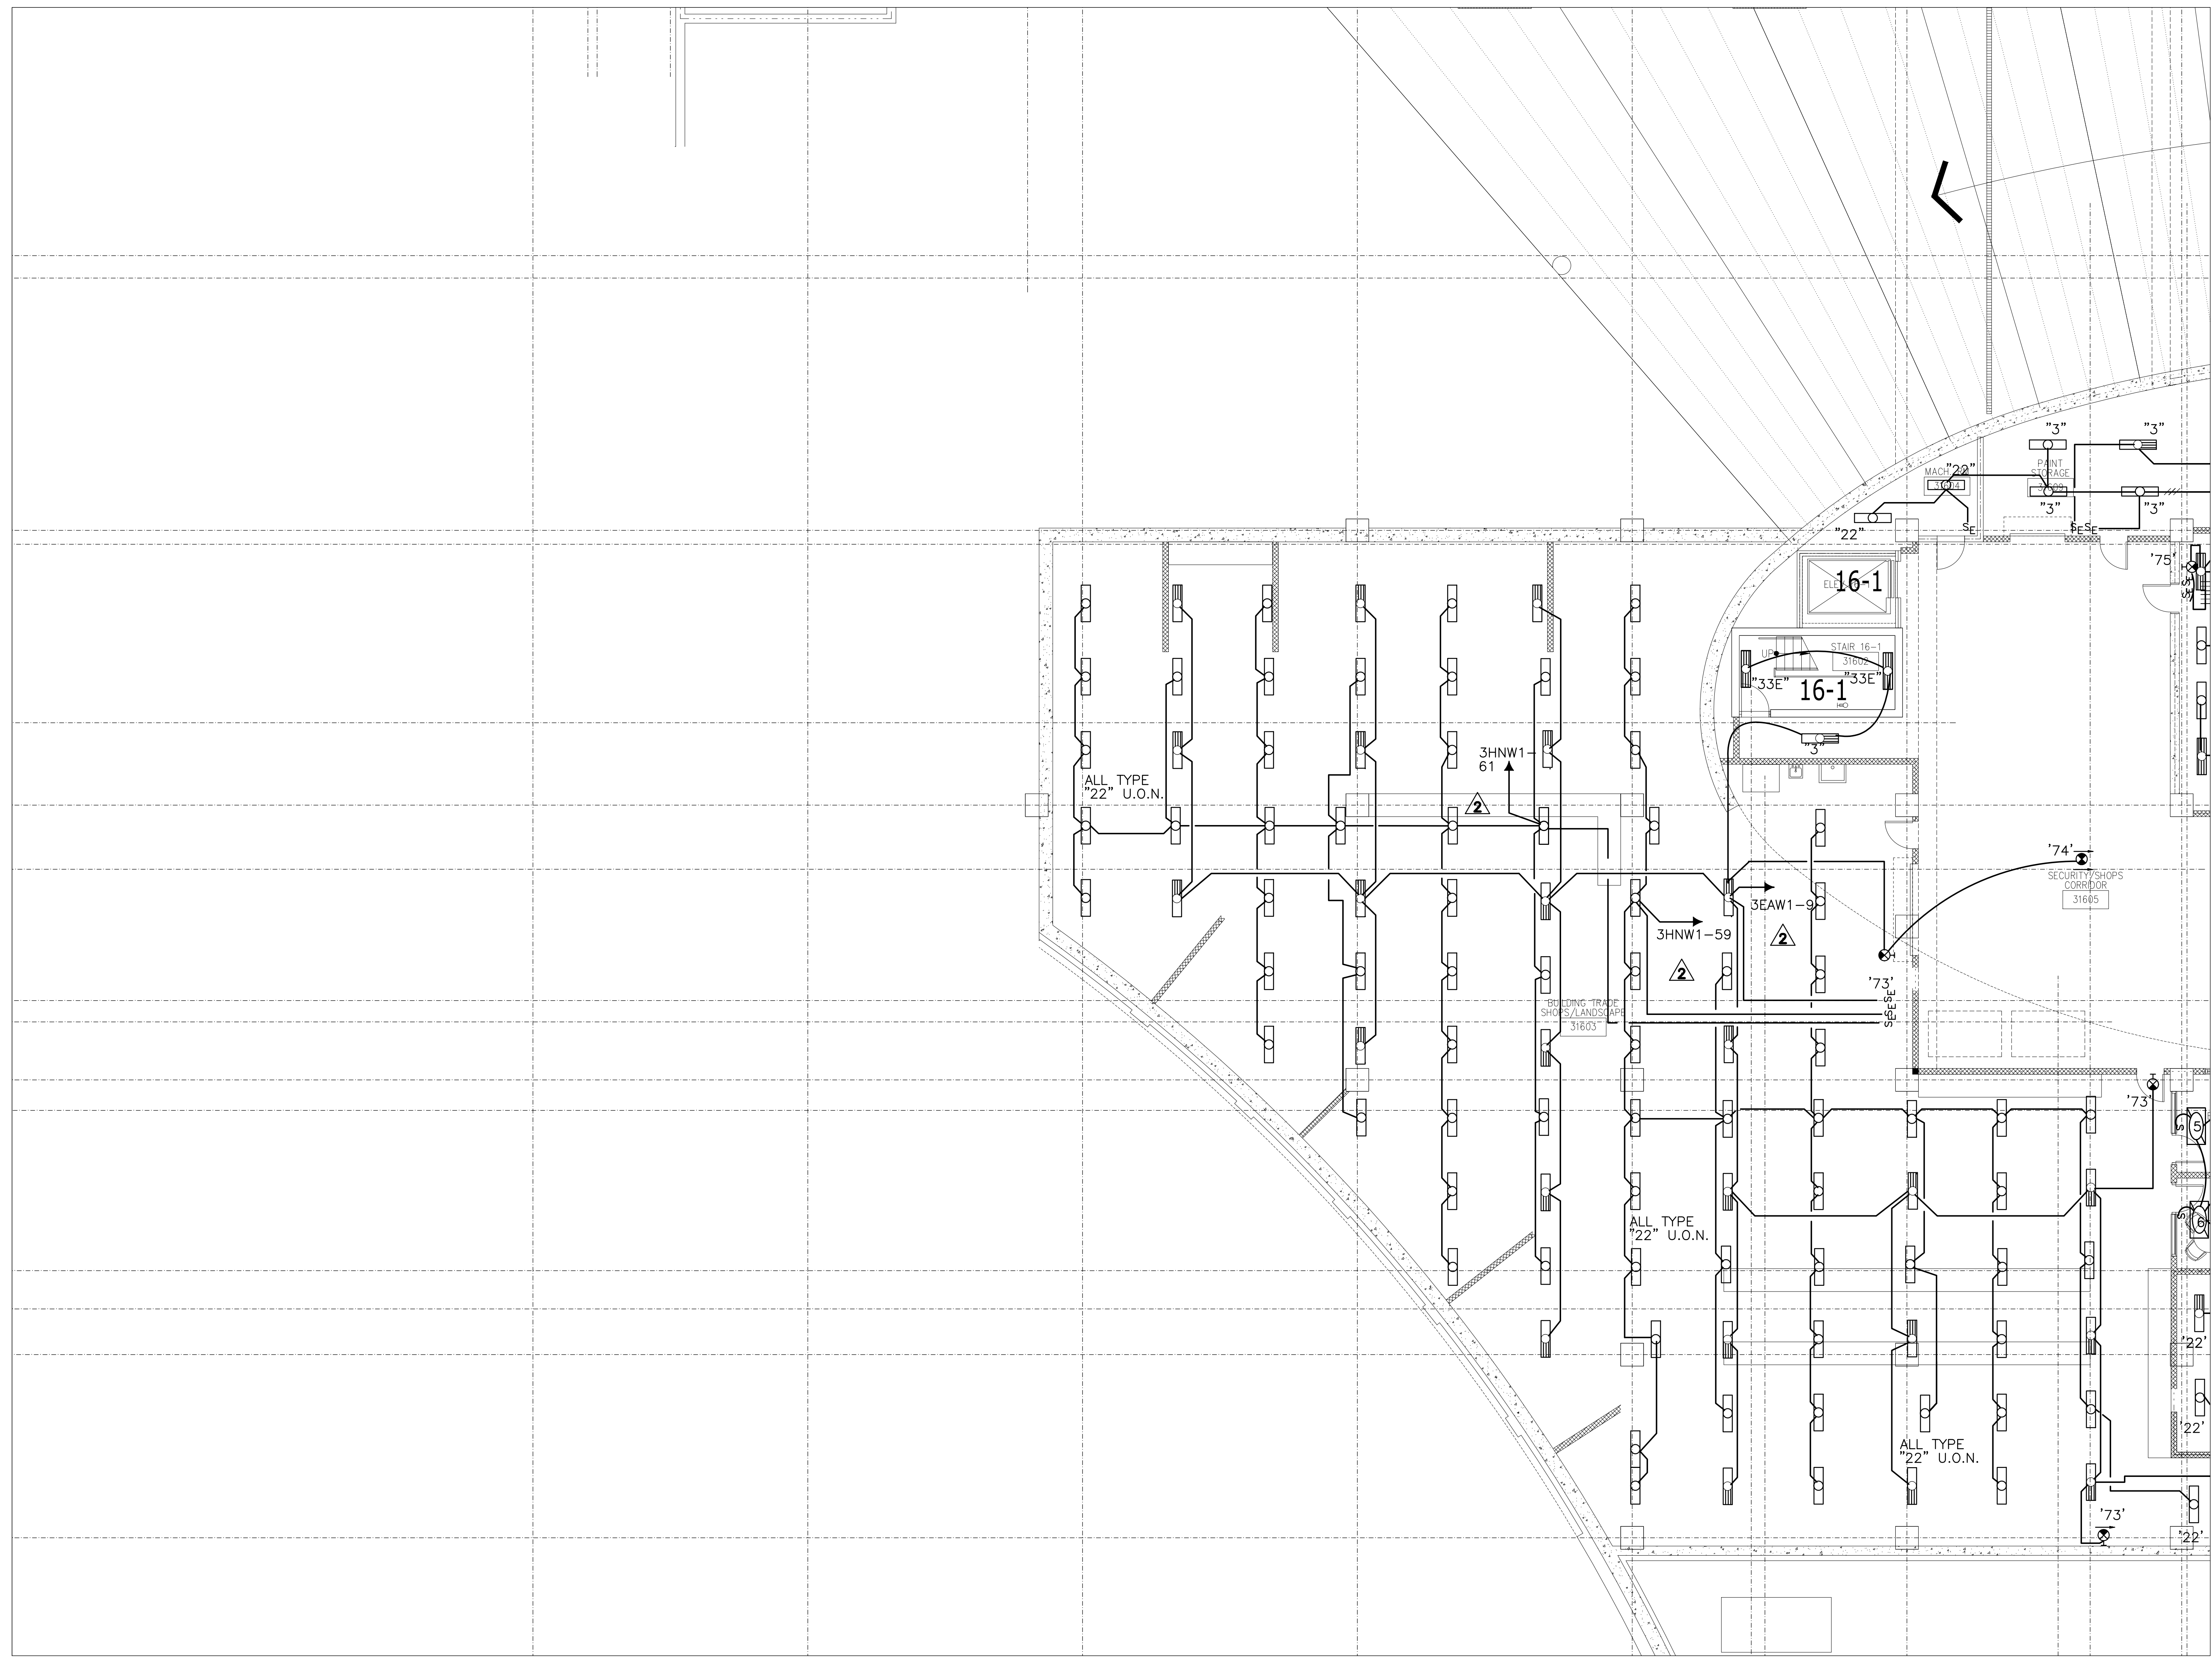

FILE PATH FOR CAD DEPARTMENT USE ONLY: P:\3085\Conti Electric\Projects\MCC\Zone 16 - Center At Ballin 4.13.12\Zone 3 Lighting\Zone 3 Lighting.dwg