


| COORDINATION SIGN-OFF |       | DATE | NAME | TRADE |
|-----------------------|-------|------|------|-------|
| COMPANY               | CONTI | / /  |      | ELEC. |
|                       |       | / /  |      |       |
|                       |       | / /  |      |       |
|                       |       | / /  |      |       |
|                       |       | / /  |      |       |

**Music City Center**  
Nashville, Tennessee

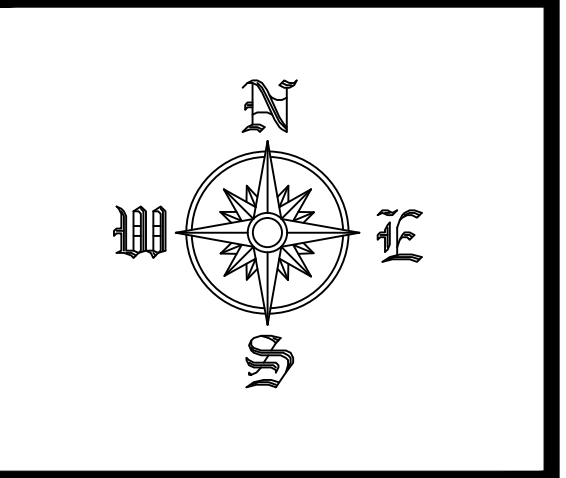


| REVISIONS |      |             |
|-----------|------|-------------|
| NO.       | DATE | DESCRIPTION |
|           |      |             |
|           |      |             |
**RECORD DRAWINGS STAMP**

CONTELECTRIC DATE (Last Update): 2/29/2012 5:06 PM  
 DRAWING FILE NAME: E22-401  
 CAD OPERATOR: GERTMAN  
 PRINTED BY: FREDMAN, GREG  
 PLOT DATE: 6/4/2012 8:11 AM  
 SUBMITTED BY: G.P.  
 ASSIGNED TO:

LEVEL 4 LIGHTING  
 ZONE 1  
 SCALE: 1/8" = 1'-0"


EL2-401

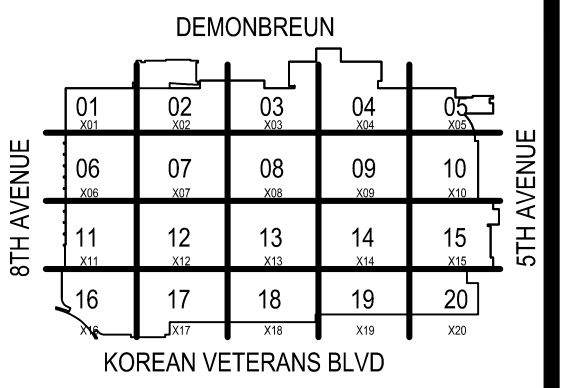

COORDINATION SIGN-OFF

| COMPANY | TRADE | DATE |
|---------|-------|------|
| CONTI   | ELEC. | / /  |
|         |       | / /  |
|         |       | / /  |
**Music City Center**  
 Nashville, Tennessee

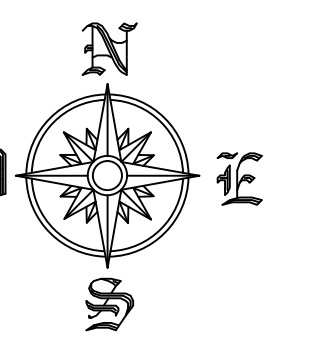

REVISIONS


| NO. | DATE | DESCRIPTION |
|-----|------|-------------|
|     |      |             |
|     |      |             |
RECORD DRAWINGS STAMP

|                                  |                   |
|----------------------------------|-------------------|
| CONTELECTRIC DATE (Last Update): | 2/20/2015 5:06 PM |
| DRAWING FILE NAME:               | EL2-402           |
| CAD OPERATOR:                    | GERMAN            |
| PRINTED BY:                      | FREMAN, GREGG     |
| PLOT DATE:                       | 6/4/2015 11:41 AM |
| SUBMITTED BY:                    | ELF               |
| ASSIGNED TO:                     |                   |


LEVEL 4 LIGHTING  
 ZONE 2  
 SCALE: 1/8" = 1'-0"

EL2-402

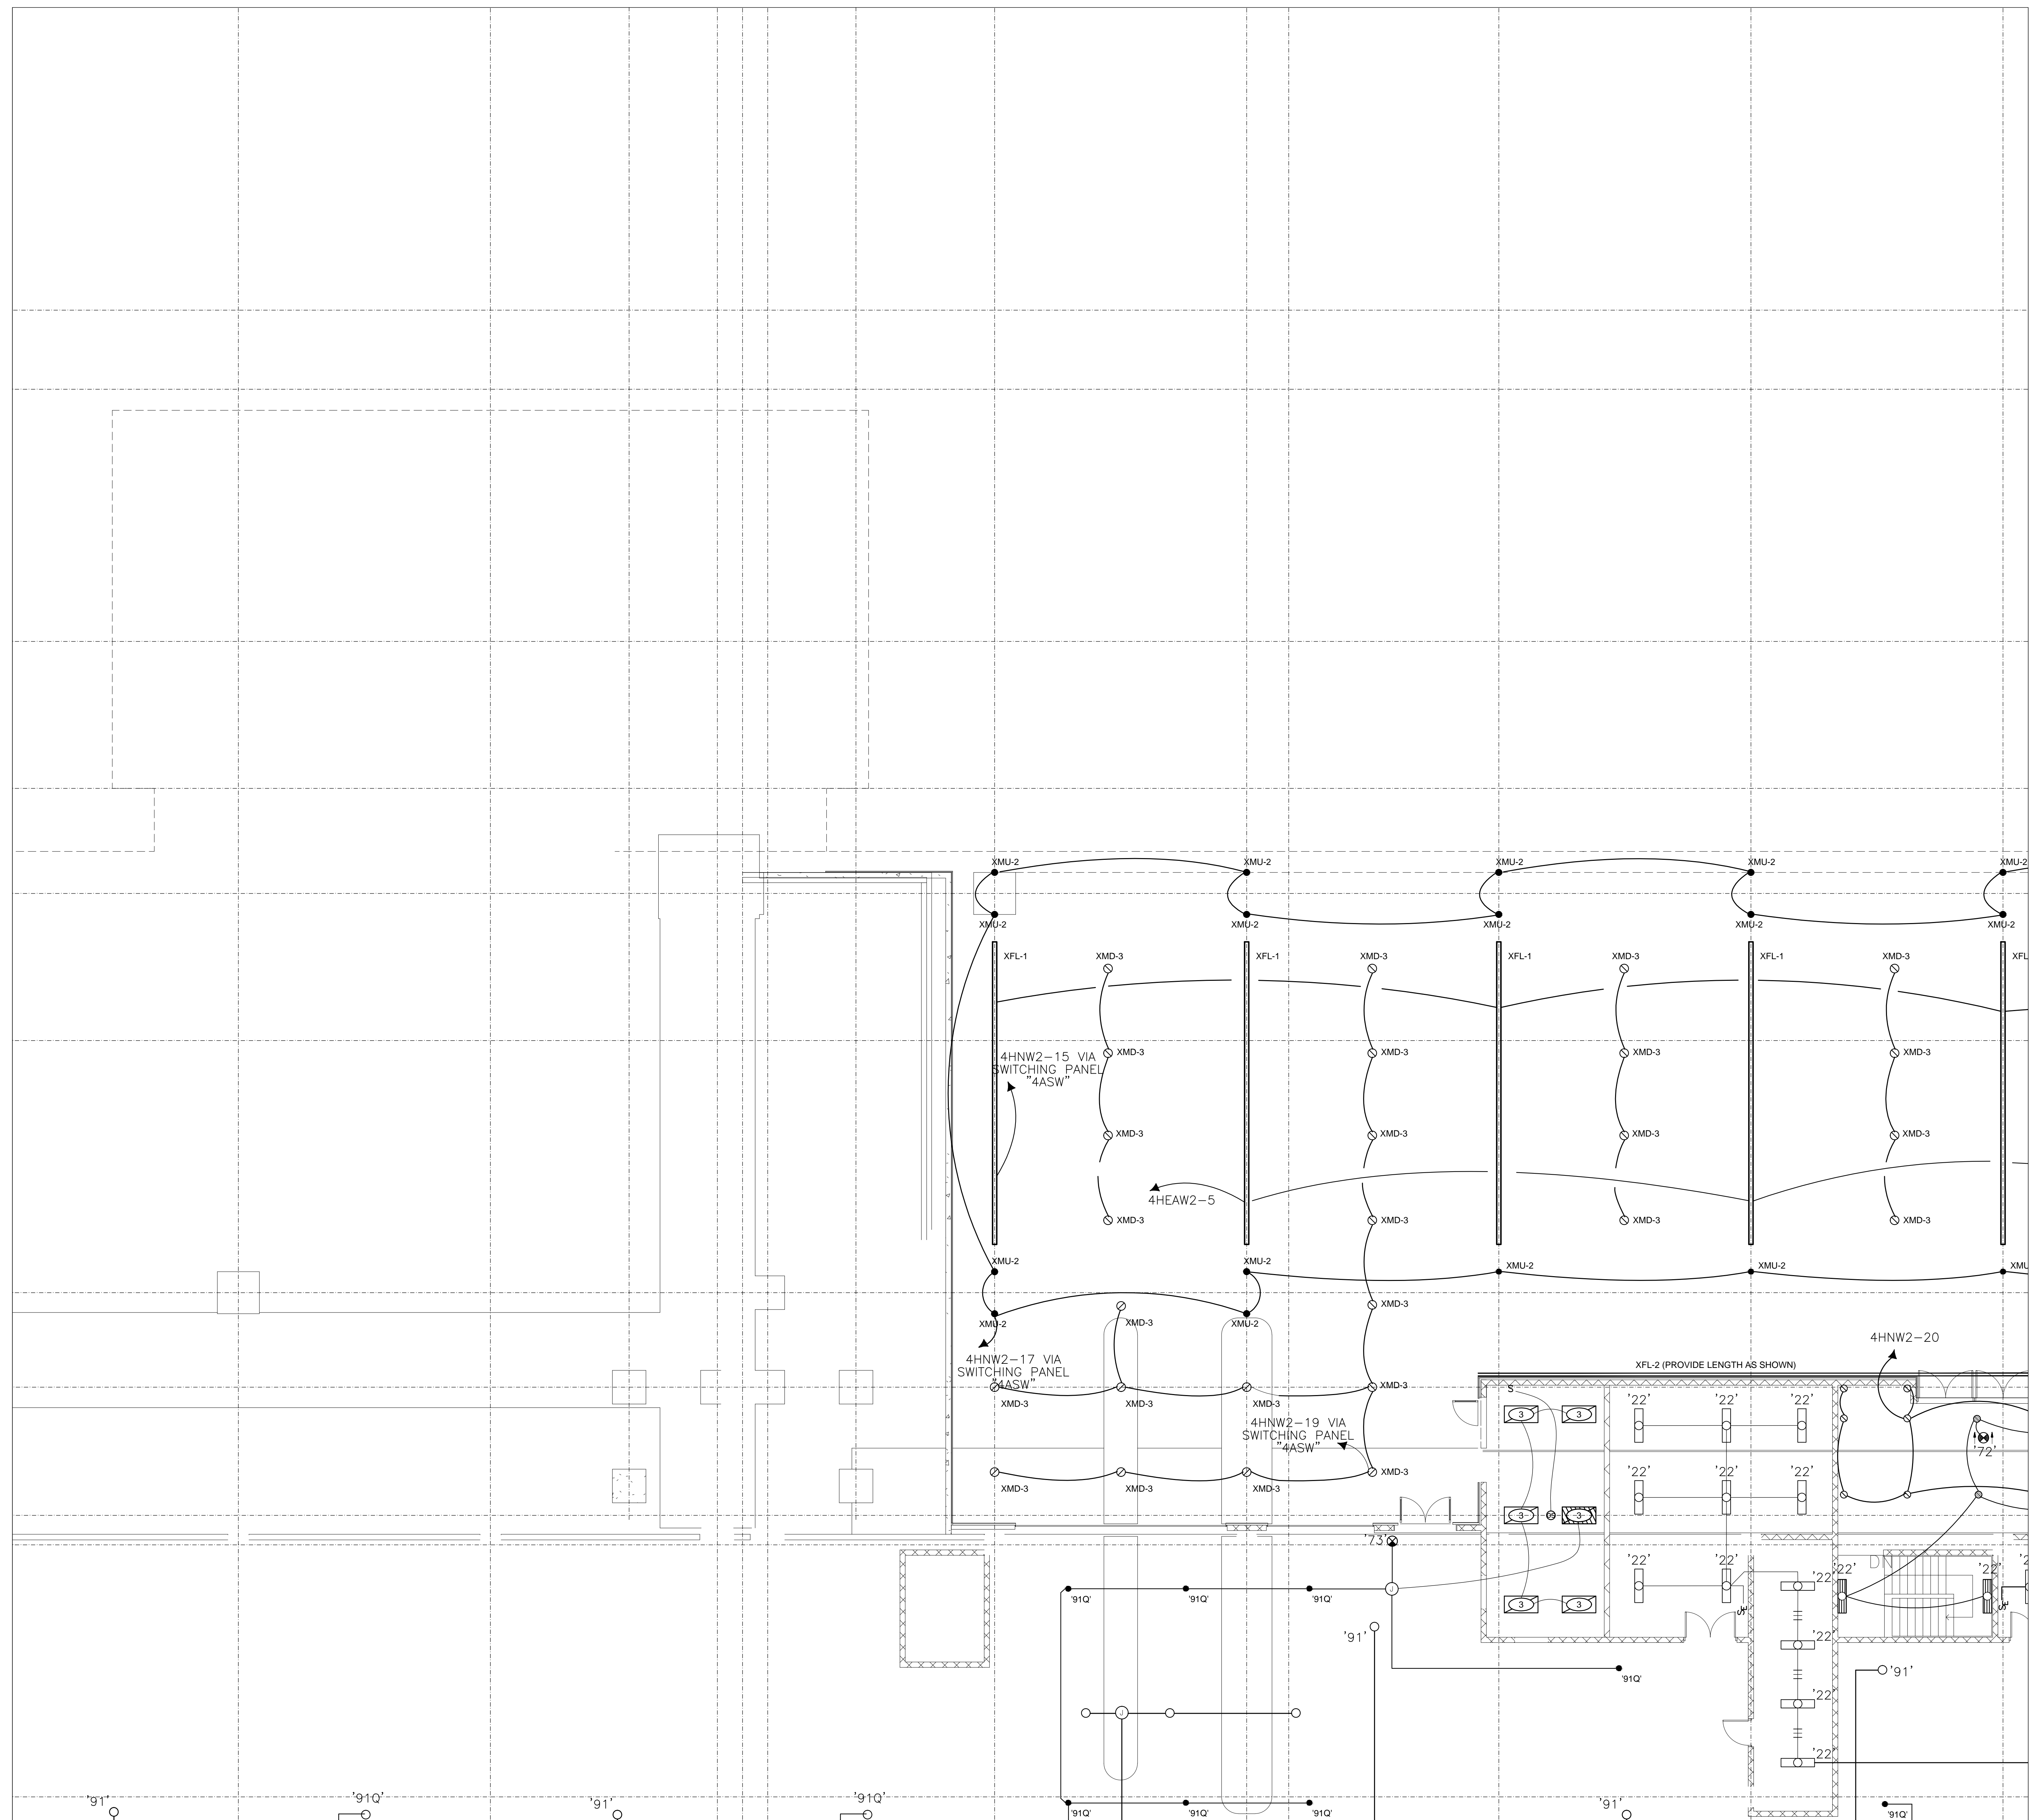


FILE PATH FOR CAD OPERATOR USE ONLY: C:\Users\Conti\Desktop\Projects\MCC\Level 4 Lighting\Zone 2 For Operating



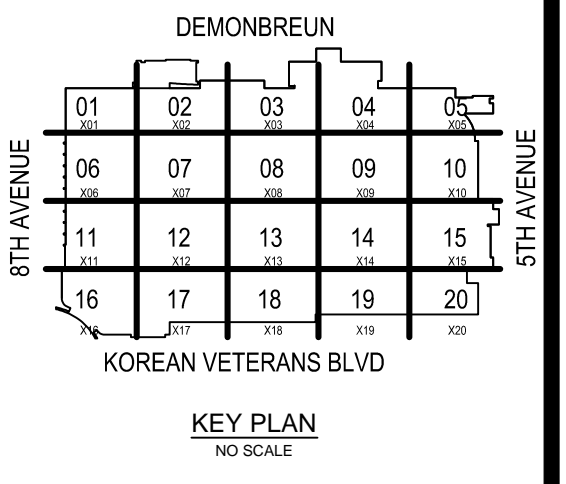

| COORDINATION SIGN-OFF |       | DATE | NAME |
|-----------------------|-------|------|------|
| COMPANY               | TRADE |      |      |
| CONTI                 | ELEC. |      |      |

**Music City Center**  
 Nashville, Tennessee

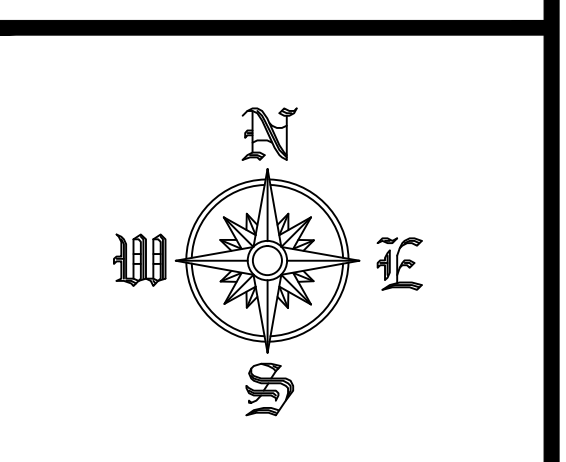


| REVISIONS |      |             |
|-----------|------|-------------|
| NO.       | DATE | DESCRIPTION |
|           |      |             |
|           |      |             |
|           |      |             |

**RECORD DRAWINGS STAMP**


CONTELECTRIC DATE (last Update):  
 2/29/2012 5:06:57 PM  
 DRAWING FILE NAME:  
 EL2-403  
 CAD OPERATOR:  
 GERRMAN  
 PRINTED BY:  
 FREDMAN GREGG  
 PLOT DATE:  
 6/4/2012 8:11 AM  
 SUBMITTED BY:  
 GELF  
 ASSIGNED TO:

LEVEL 4 LIGHTING  
 ZONE 3  
 SCALE: 1/8" = 1'-0"

EL2-403

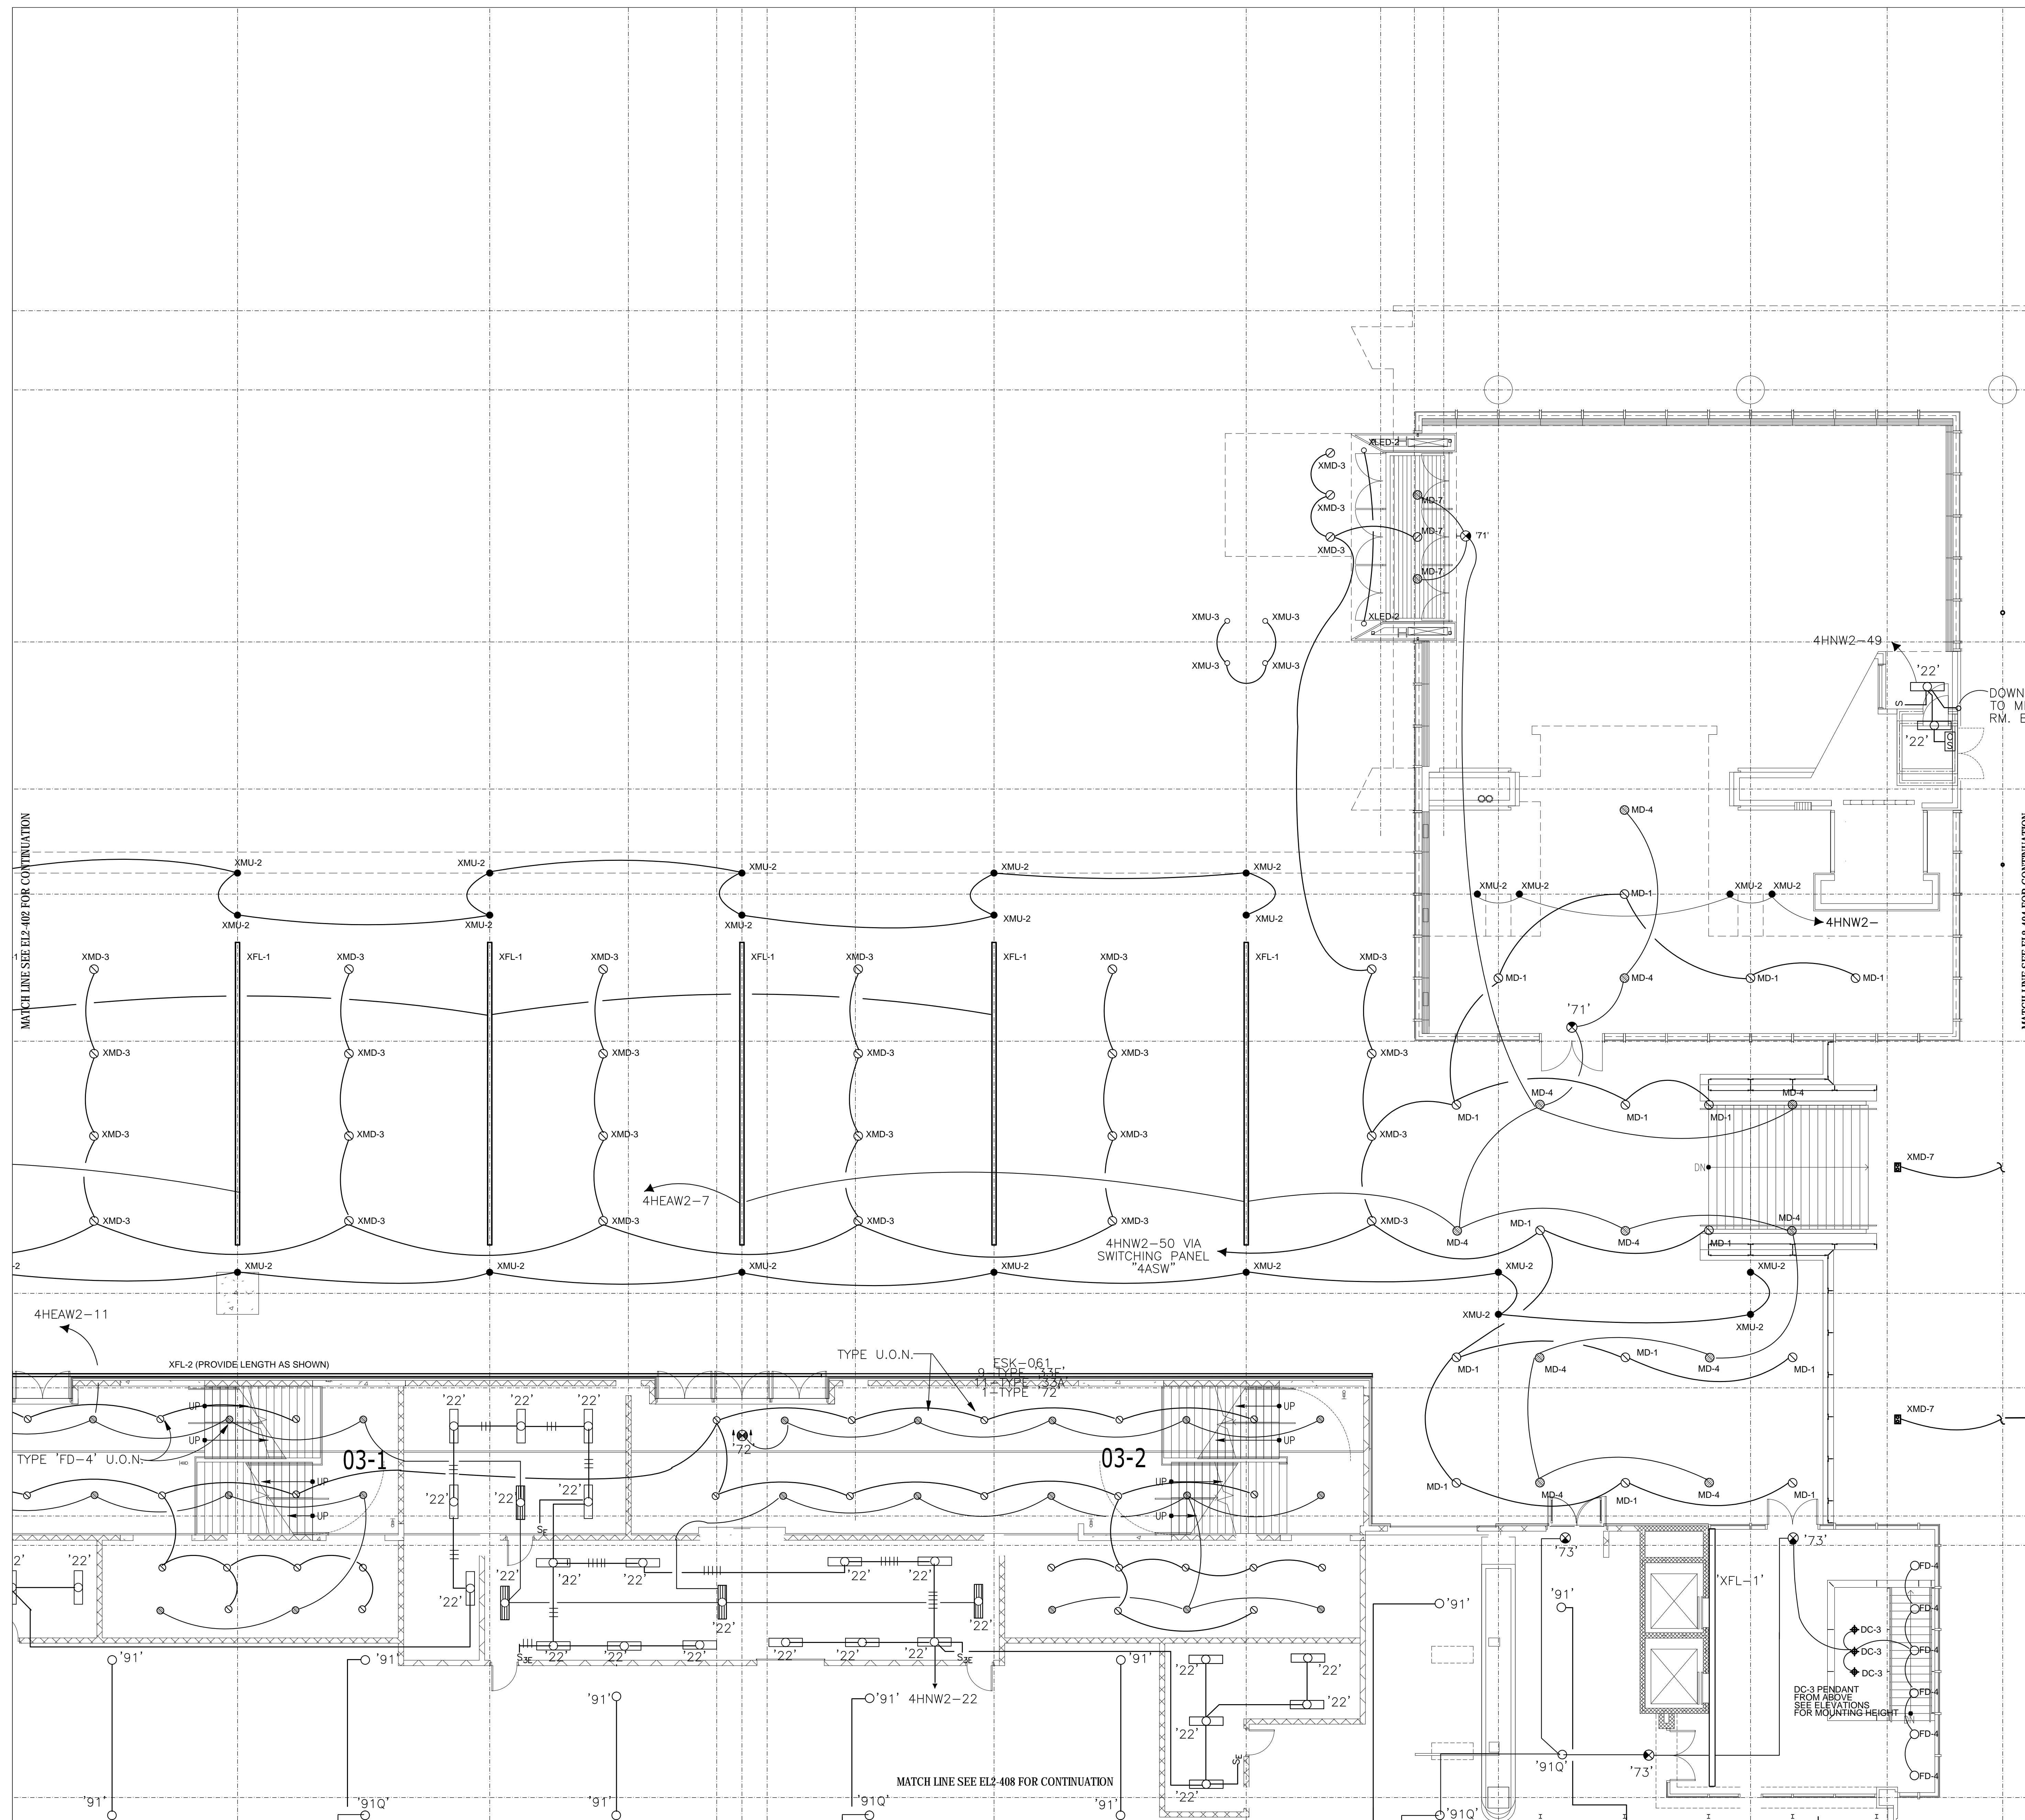




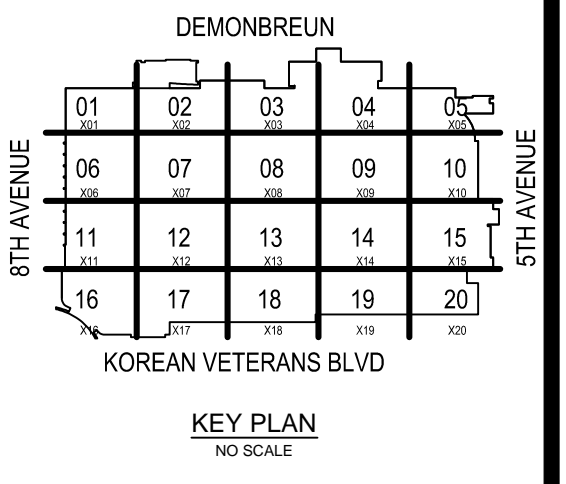

COORDINATION SIGN-OFF

| COMPANY | TRADE | DATE |
|---------|-------|------|
| CONTI   | ELEC. | / /  |
|         |       | / /  |
|         |       | / /  |
**Music City Center**  
 Nashville, Tennessee

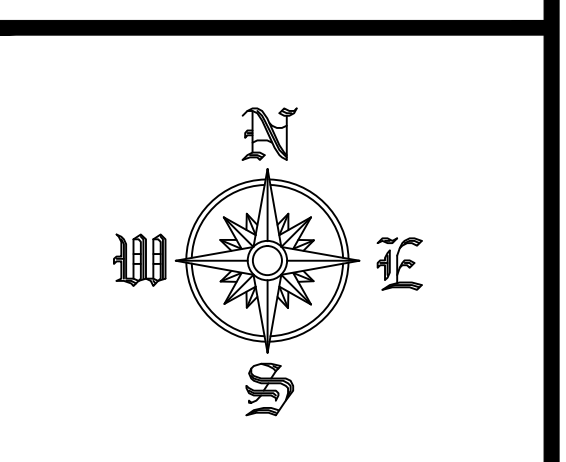

REVISIONS


| NO. | DATE | DESCRIPTION |
|-----|------|-------------|
|     |      |             |
|     |      |             |
|     |      |             |
|     |      |             |

RECORD DRAWINGS STAMP


CONTI ELECTRIC DATE (Last Update): 2/28/2012 5:04 PM  
 DRAWING FILE NAME: EL2-404  
 CAD OPERATOR: GERRITMAN  
 PRINTED BY: FREDMAN, GREGG  
 PLOT DATE: 6/4/2012 8:11 AM  
 SUBMITTED BY: GELF  
 ASSIGNED TO:

LEVEL 4 LIGHTING  
 ZONE 4  
 SCALE: 1/8" = 1'-0"

EL2-404

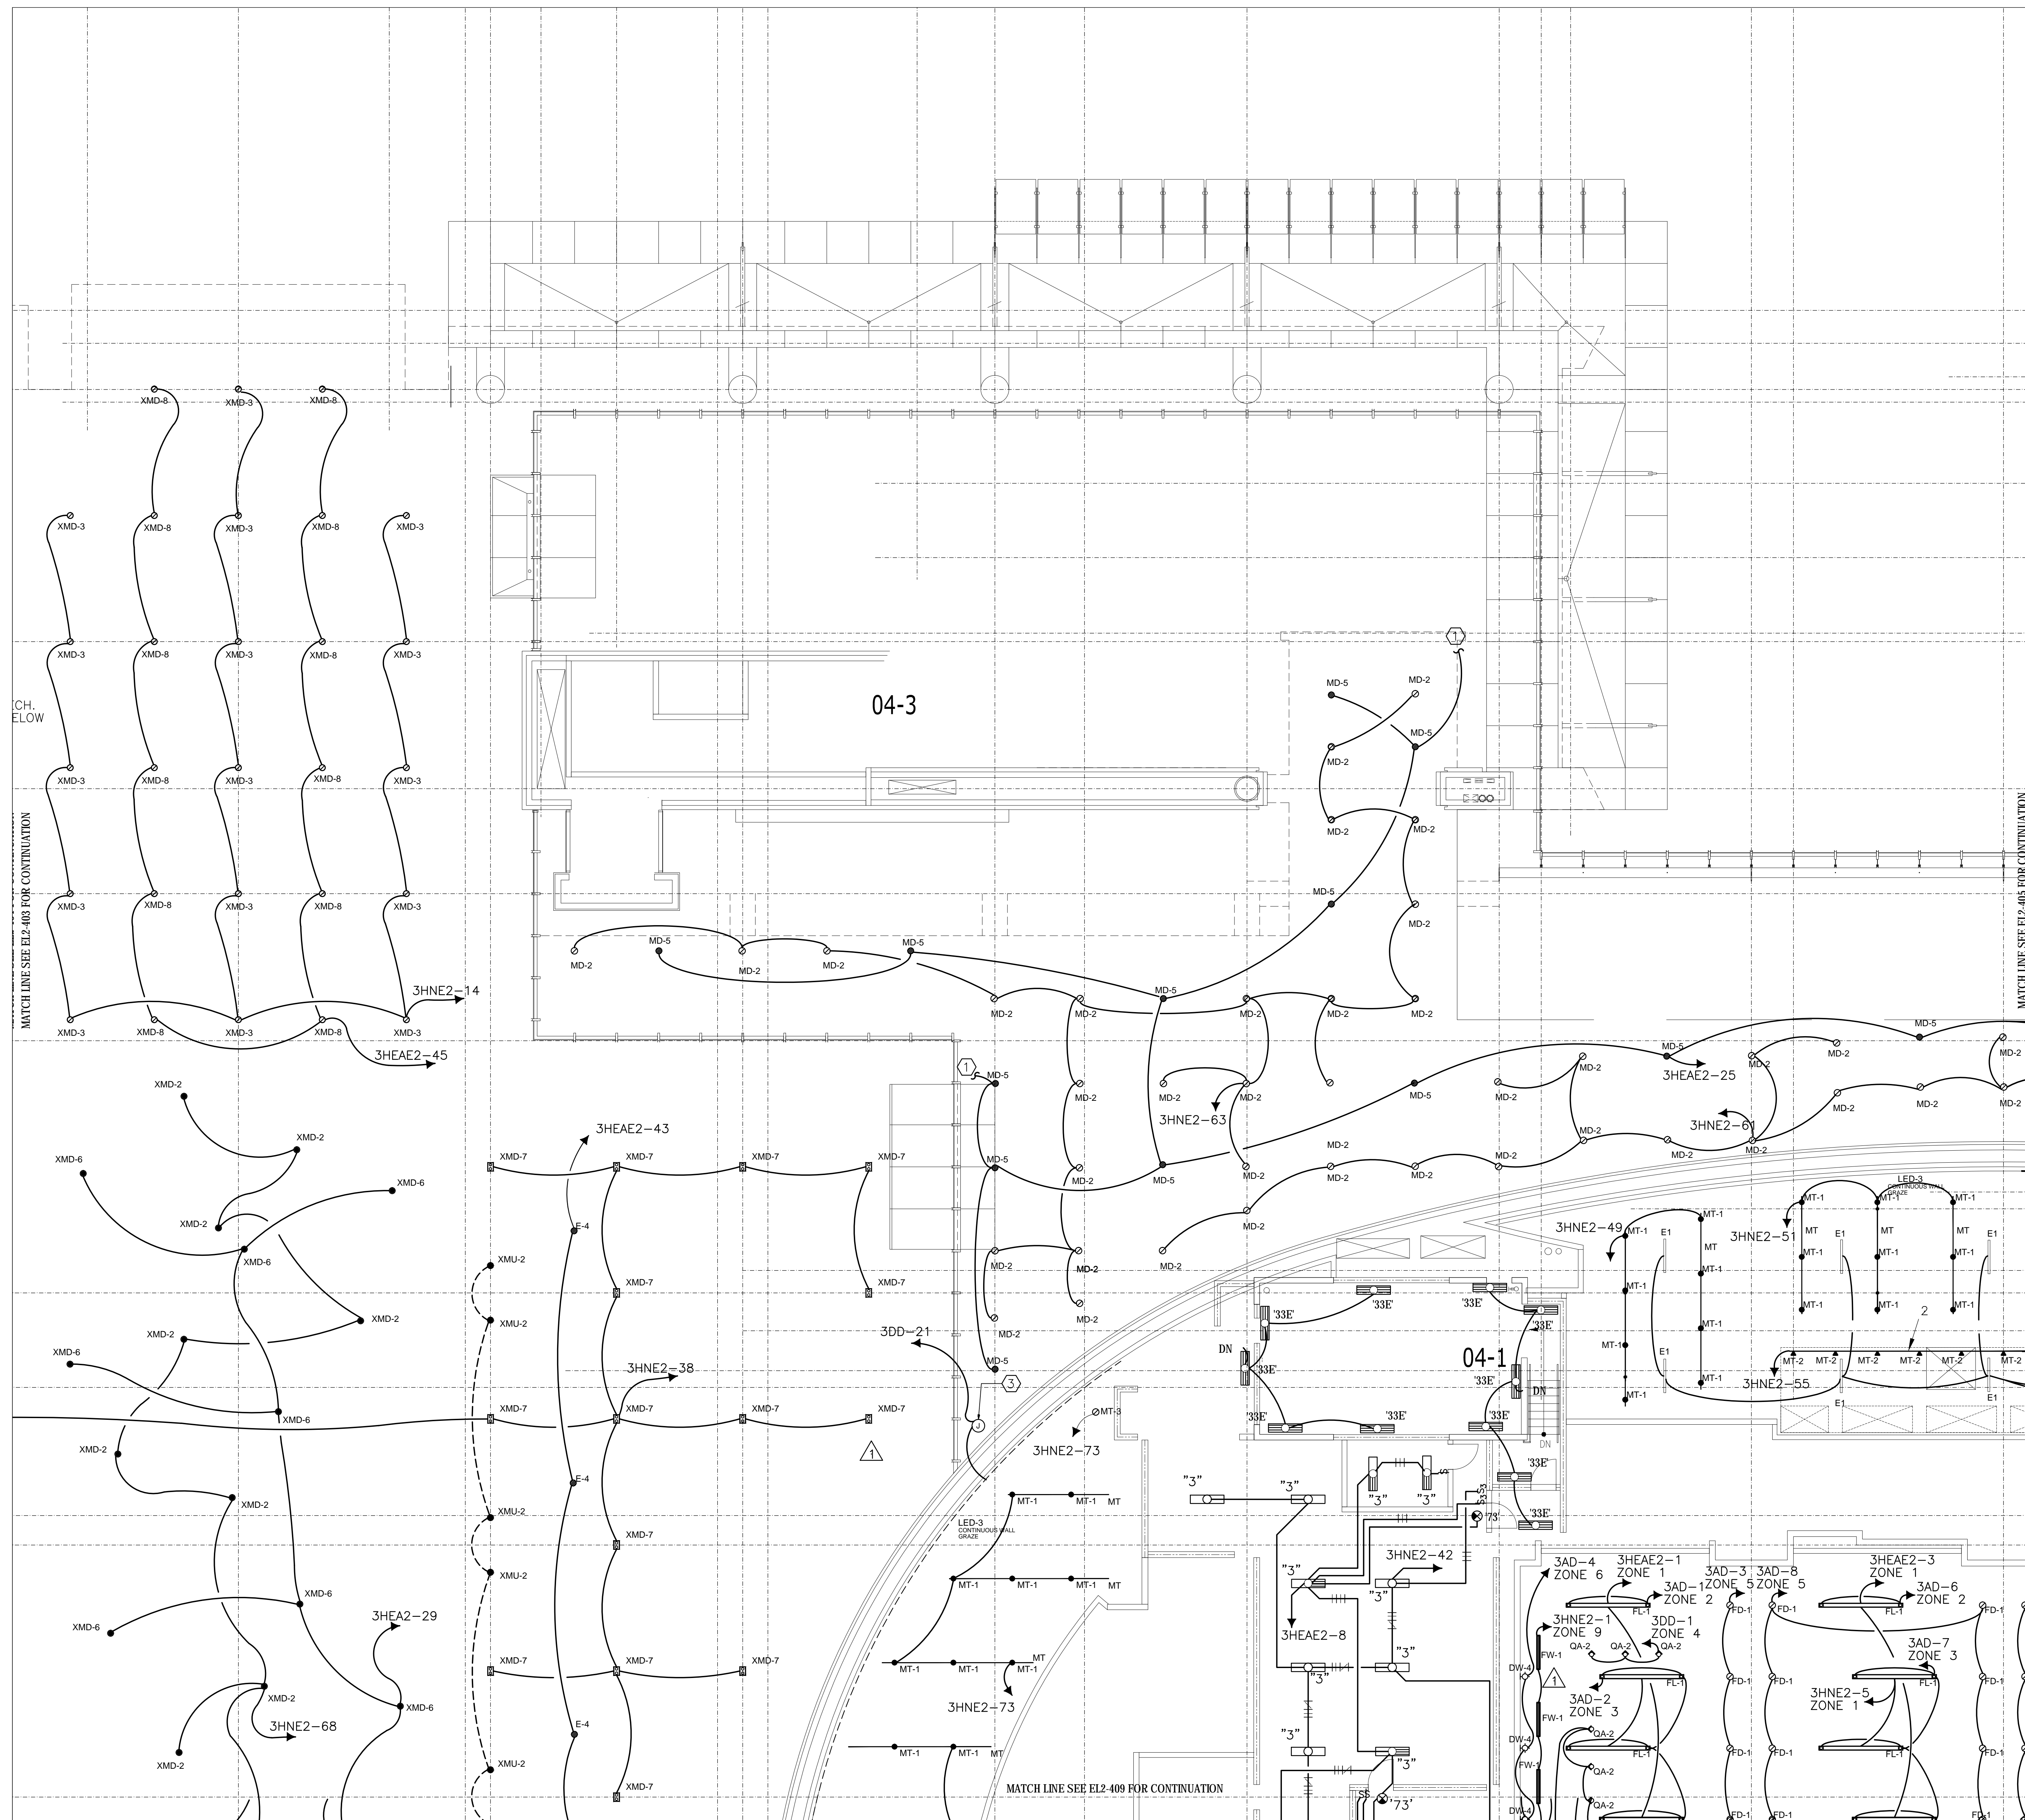




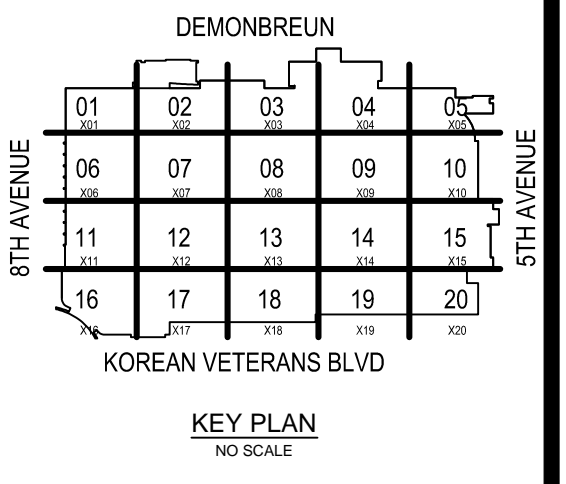

COORDINATION SIGN-OFF

| COMPANY | TRADE | DATE |
|---------|-------|------|
| CONTI   | ELEC. | / /  |
|         |       | / /  |
|         |       | / /  |
**Music City Center**  
 Nashville, Tennessee

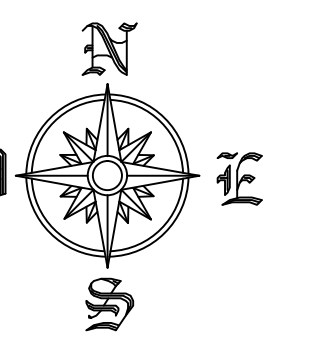

REVISIONS


| NO. | DATE | DESCRIPTION |
|-----|------|-------------|
|     |      |             |
|     |      |             |
RECORD DRAWINGS STAMP

CONTI ELECTRIC DATE (Last Update): 2/20/2015 5:06 PM  
 DRAWING FILE NAME: EL2-405  
 CAD OPERATOR: GERRITMAN  
 PRINTED BY: FREDMAN, GREGG  
 PLOT DATE: 6/4/2015 8:11 AM  
 SUBMITTED BY: GLENN  
 ASSIGNED TO:

LEVEL 4 LIGHTING  
 ZONE 5  
 SCALE: 1/8" = 1'-0"

EL2-405

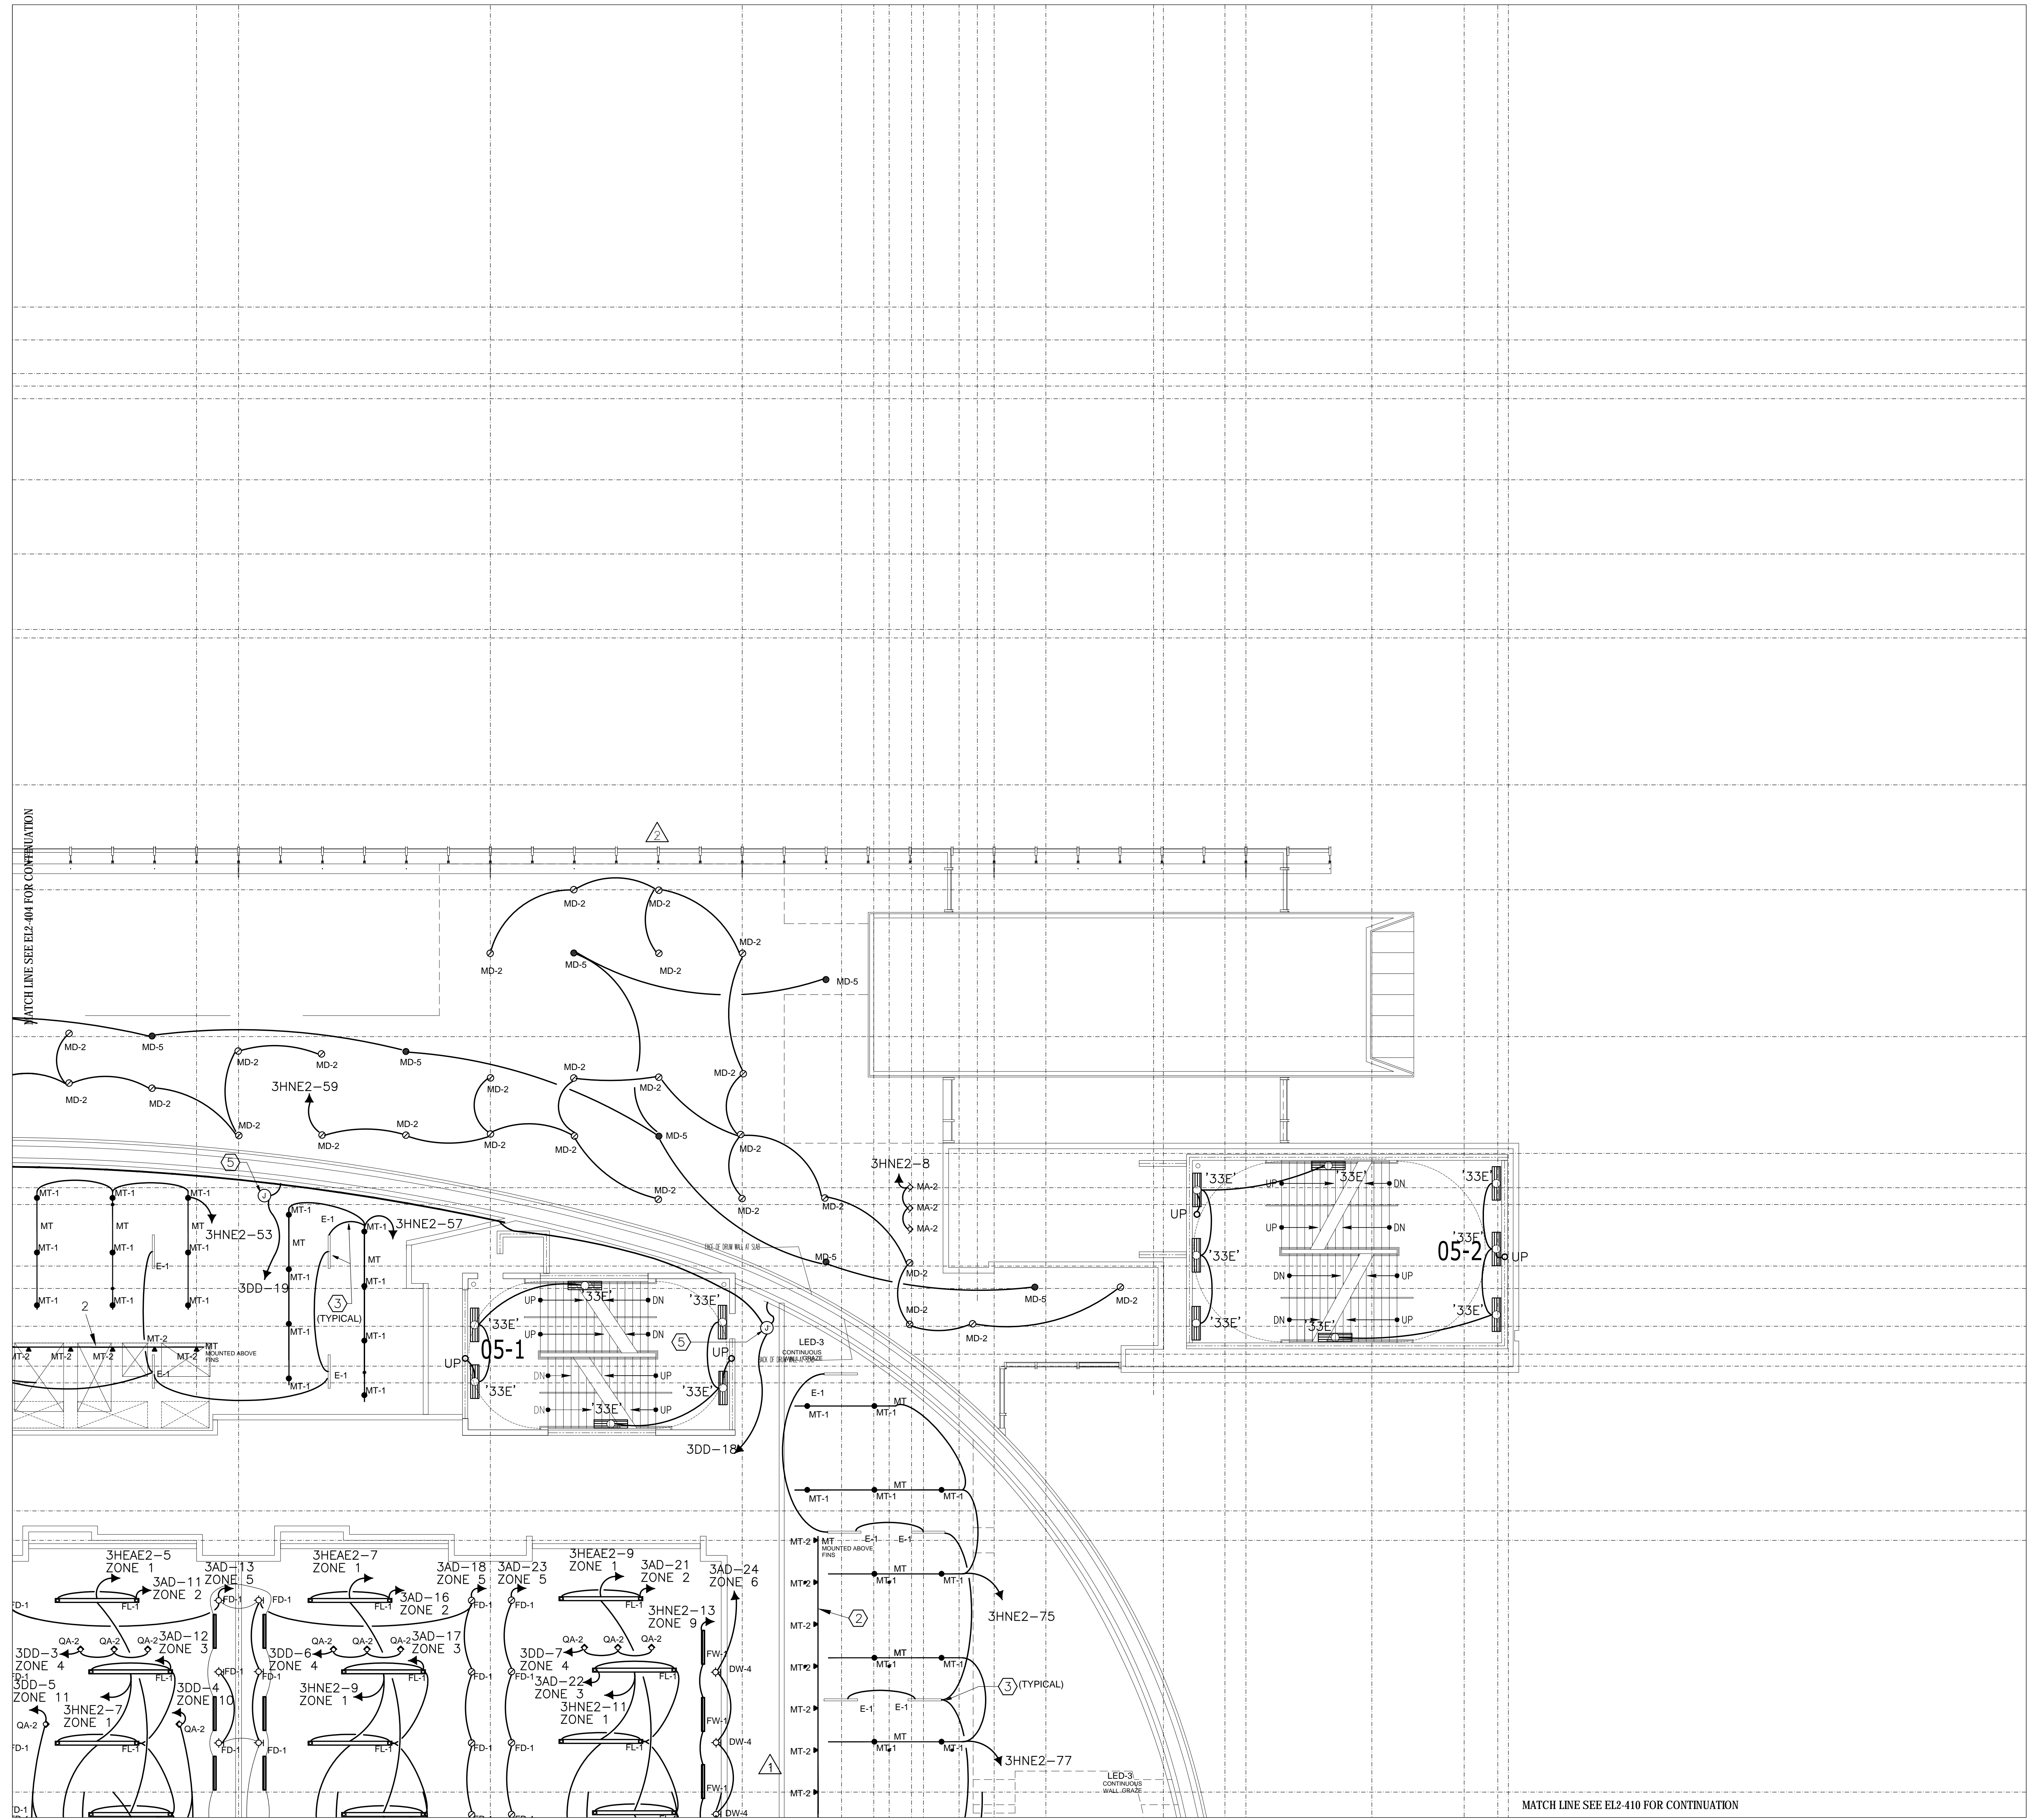


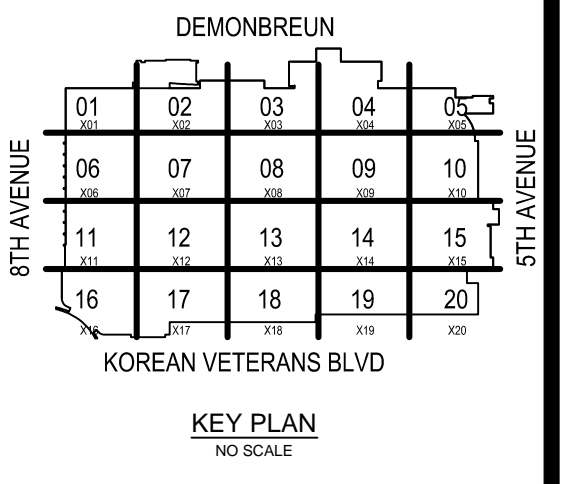

COORDINATION SIGN-OFF

| COMPANY | TRADE | DATE |
|---------|-------|------|
| CONTI   | ELEC. | / /  |
|         |       | / /  |
|         |       | / /  |
**Music City Center**  
 Nashville, Tennessee

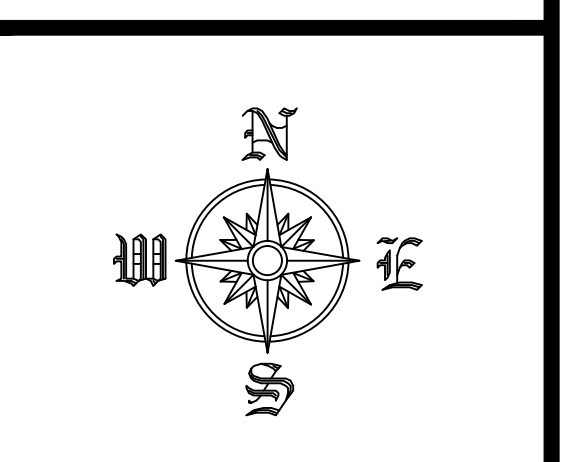

REVISIONS


| NO. | DATE | DESCRIPTION |
|-----|------|-------------|
|     |      |             |
|     |      |             |
RECORD DRAWINGS STAMP


CONTI ELECTRIC DATE (last Update): 2/29/2012 5:06 PM  
 DRAWING FILE NAME: ELEC-09  
 CAD OPERATOR: GERTMAN  
 PRINTED BY: FREDAN, GREG  
 PLOT DATE: 6/4/2012 8:11 AM  
 SUBMITTED BY: GLENN  
 ASSIGNED TO:

LEVEL 4 LIGHTING  
 ZONE 6  
 SCALE: 1/8" = 1'-0"

EL2-406

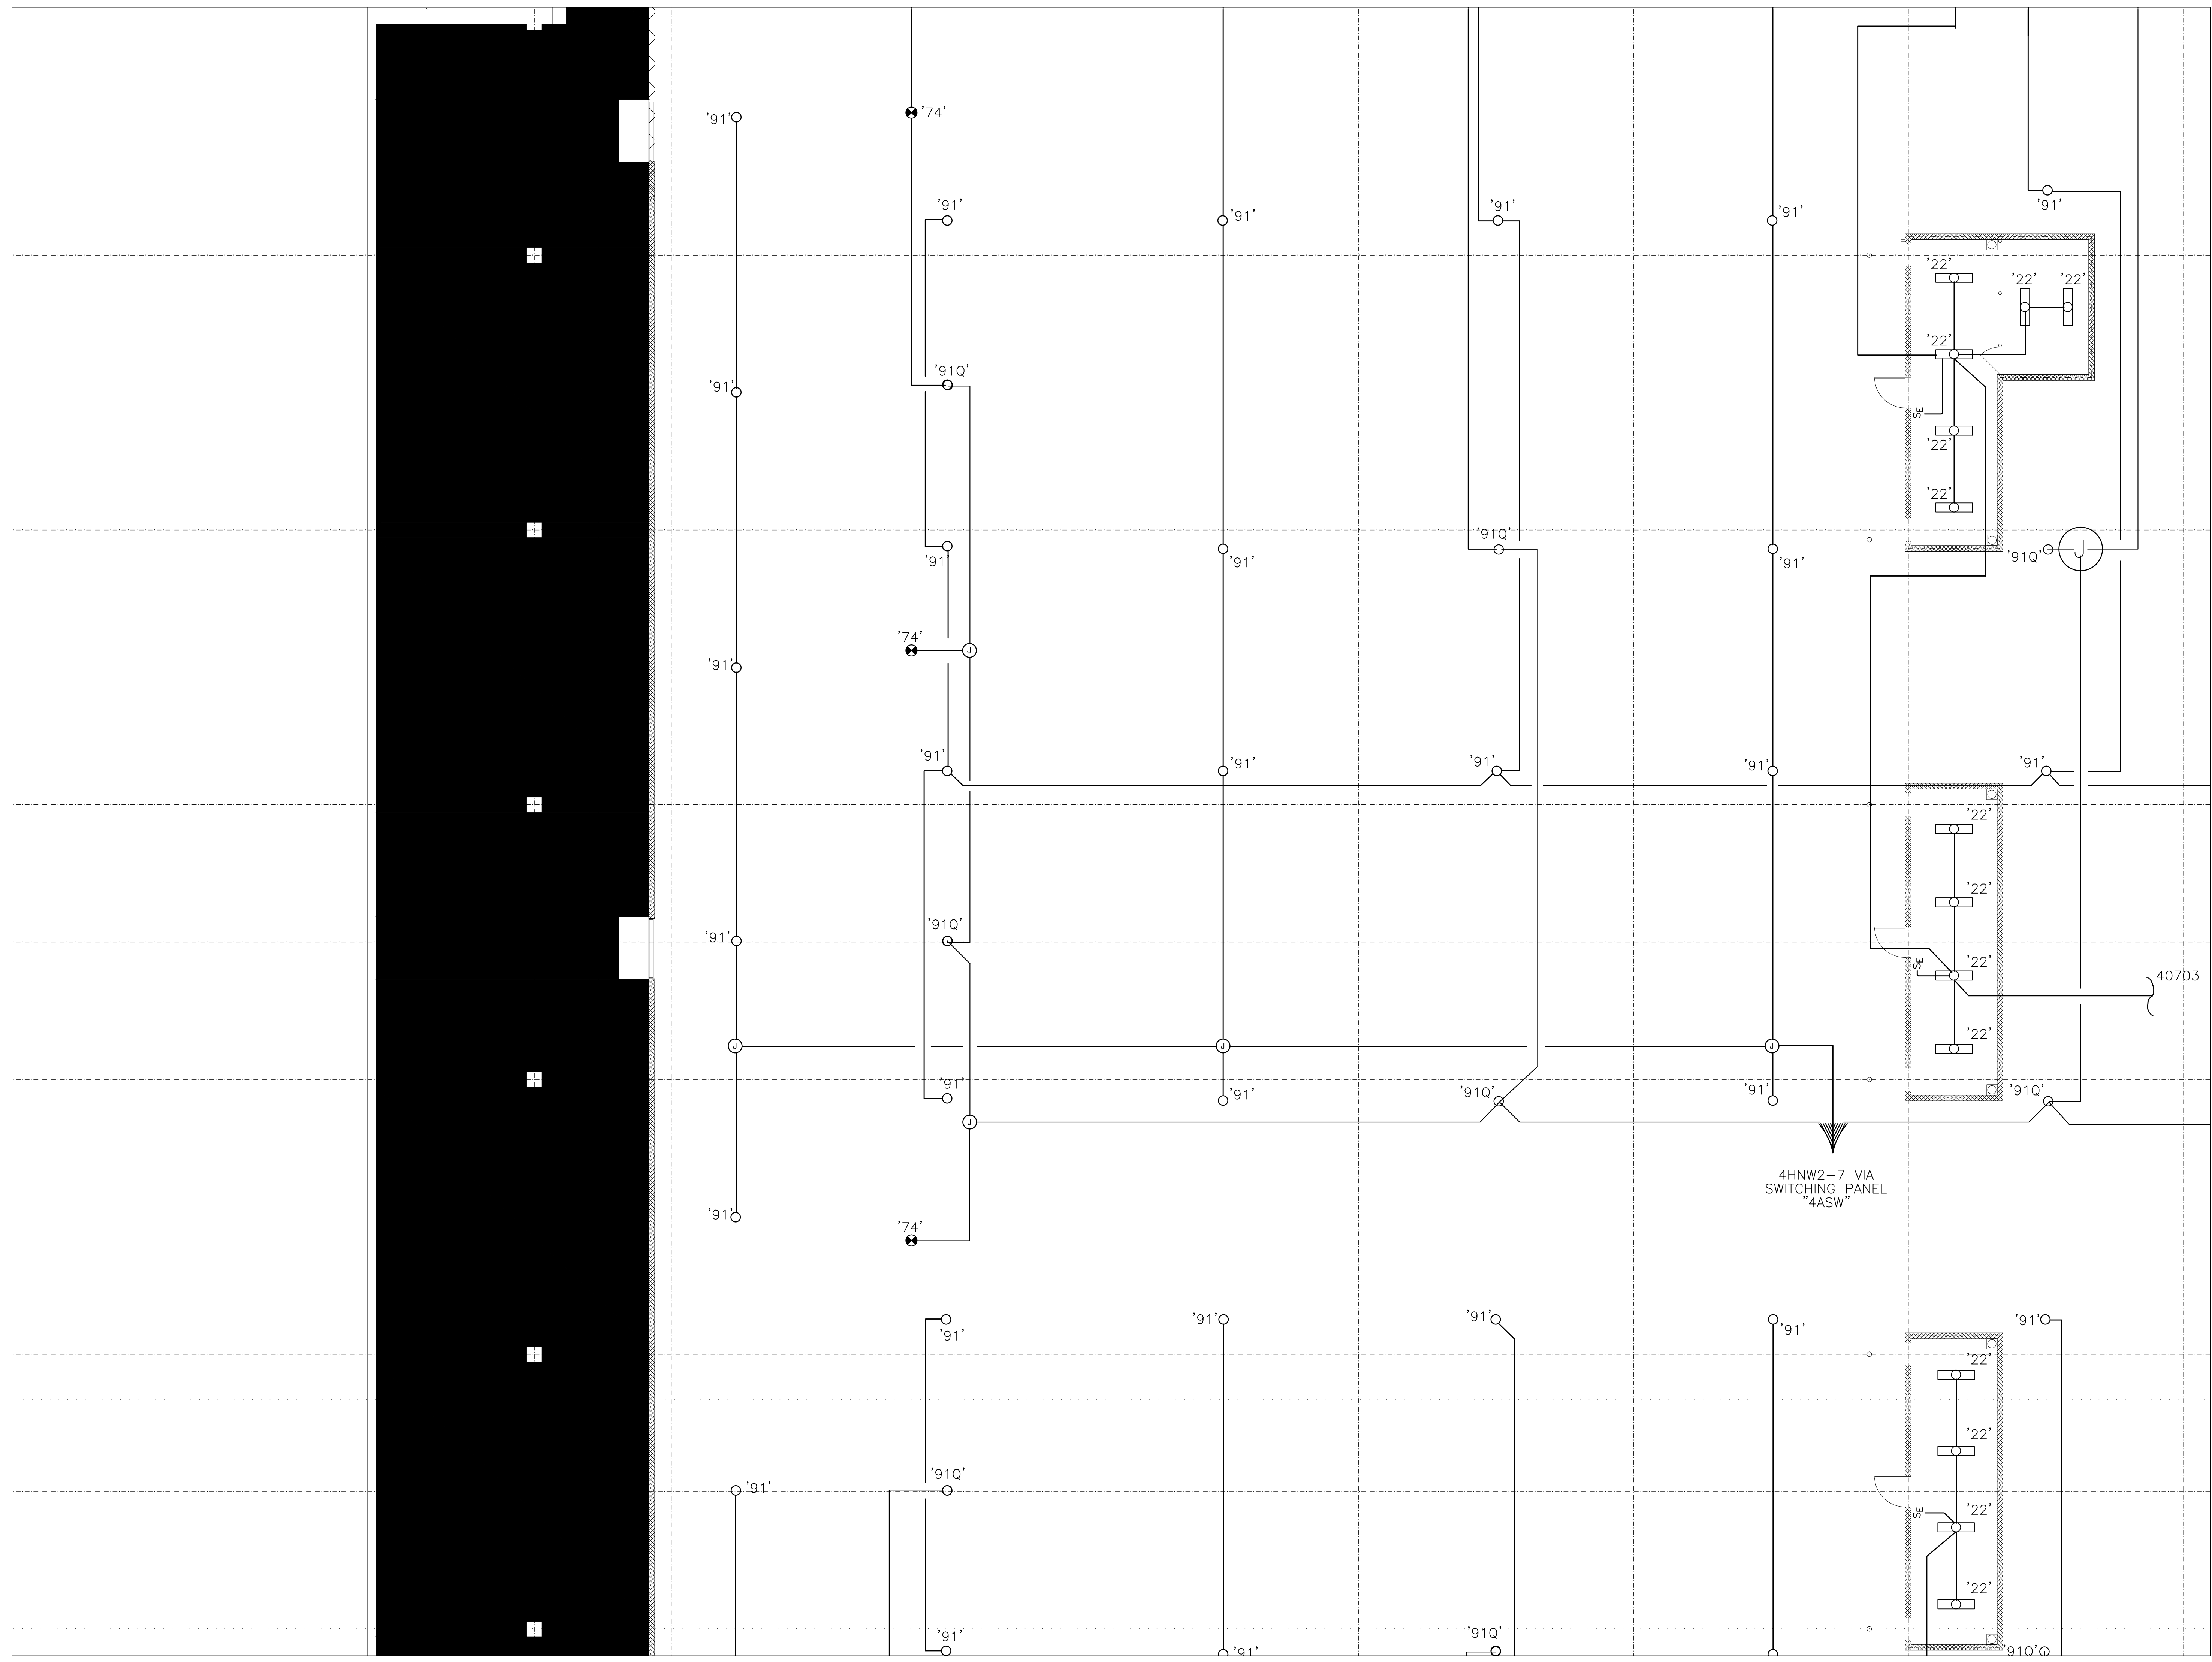




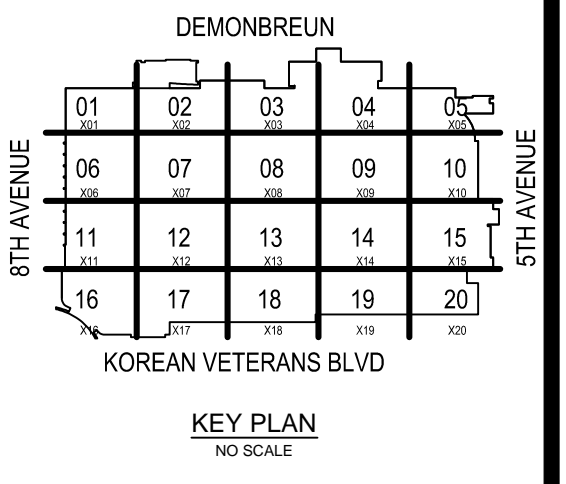

COORDINATION SIGN-OFF

| COMPANY | TRADE | DATE |
|---------|-------|------|
| CONTI   | ELEC. | / /  |
|         |       | / /  |
|         |       | / /  |
**Music City Center**  
 Nashville, Tennessee

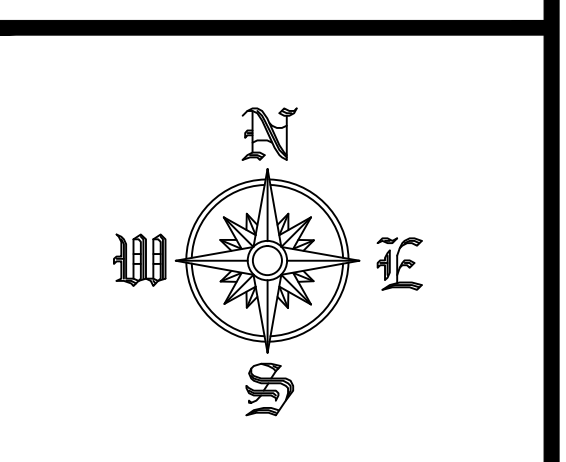

REVISIONS


| NO. | DATE | DESCRIPTION |
|-----|------|-------------|
|     |      |             |
|     |      |             |
RECORD DRAWINGS STAMP


|                                    |                   |
|------------------------------------|-------------------|
| CONTI ELECTRIC DATE (Last Update): | 2/29/2017 5:06 PM |
| DRAWING FILE NAME:                 | EL2-407           |
| CAD OPERATOR:                      | GERMAN            |
| PRINTED BY:                        | FREDMAN, GREGG    |
| PLOT DATE:                         | 6/4/2017 8:11 AM  |
| SUBMITTED BY:                      | ELF               |
| ASSIGNED TO:                       |                   |

LEVEL 4 LIGHTING  
 ZONE 7  
 SCALE: 1/8" = 1'-0"

EL2-407

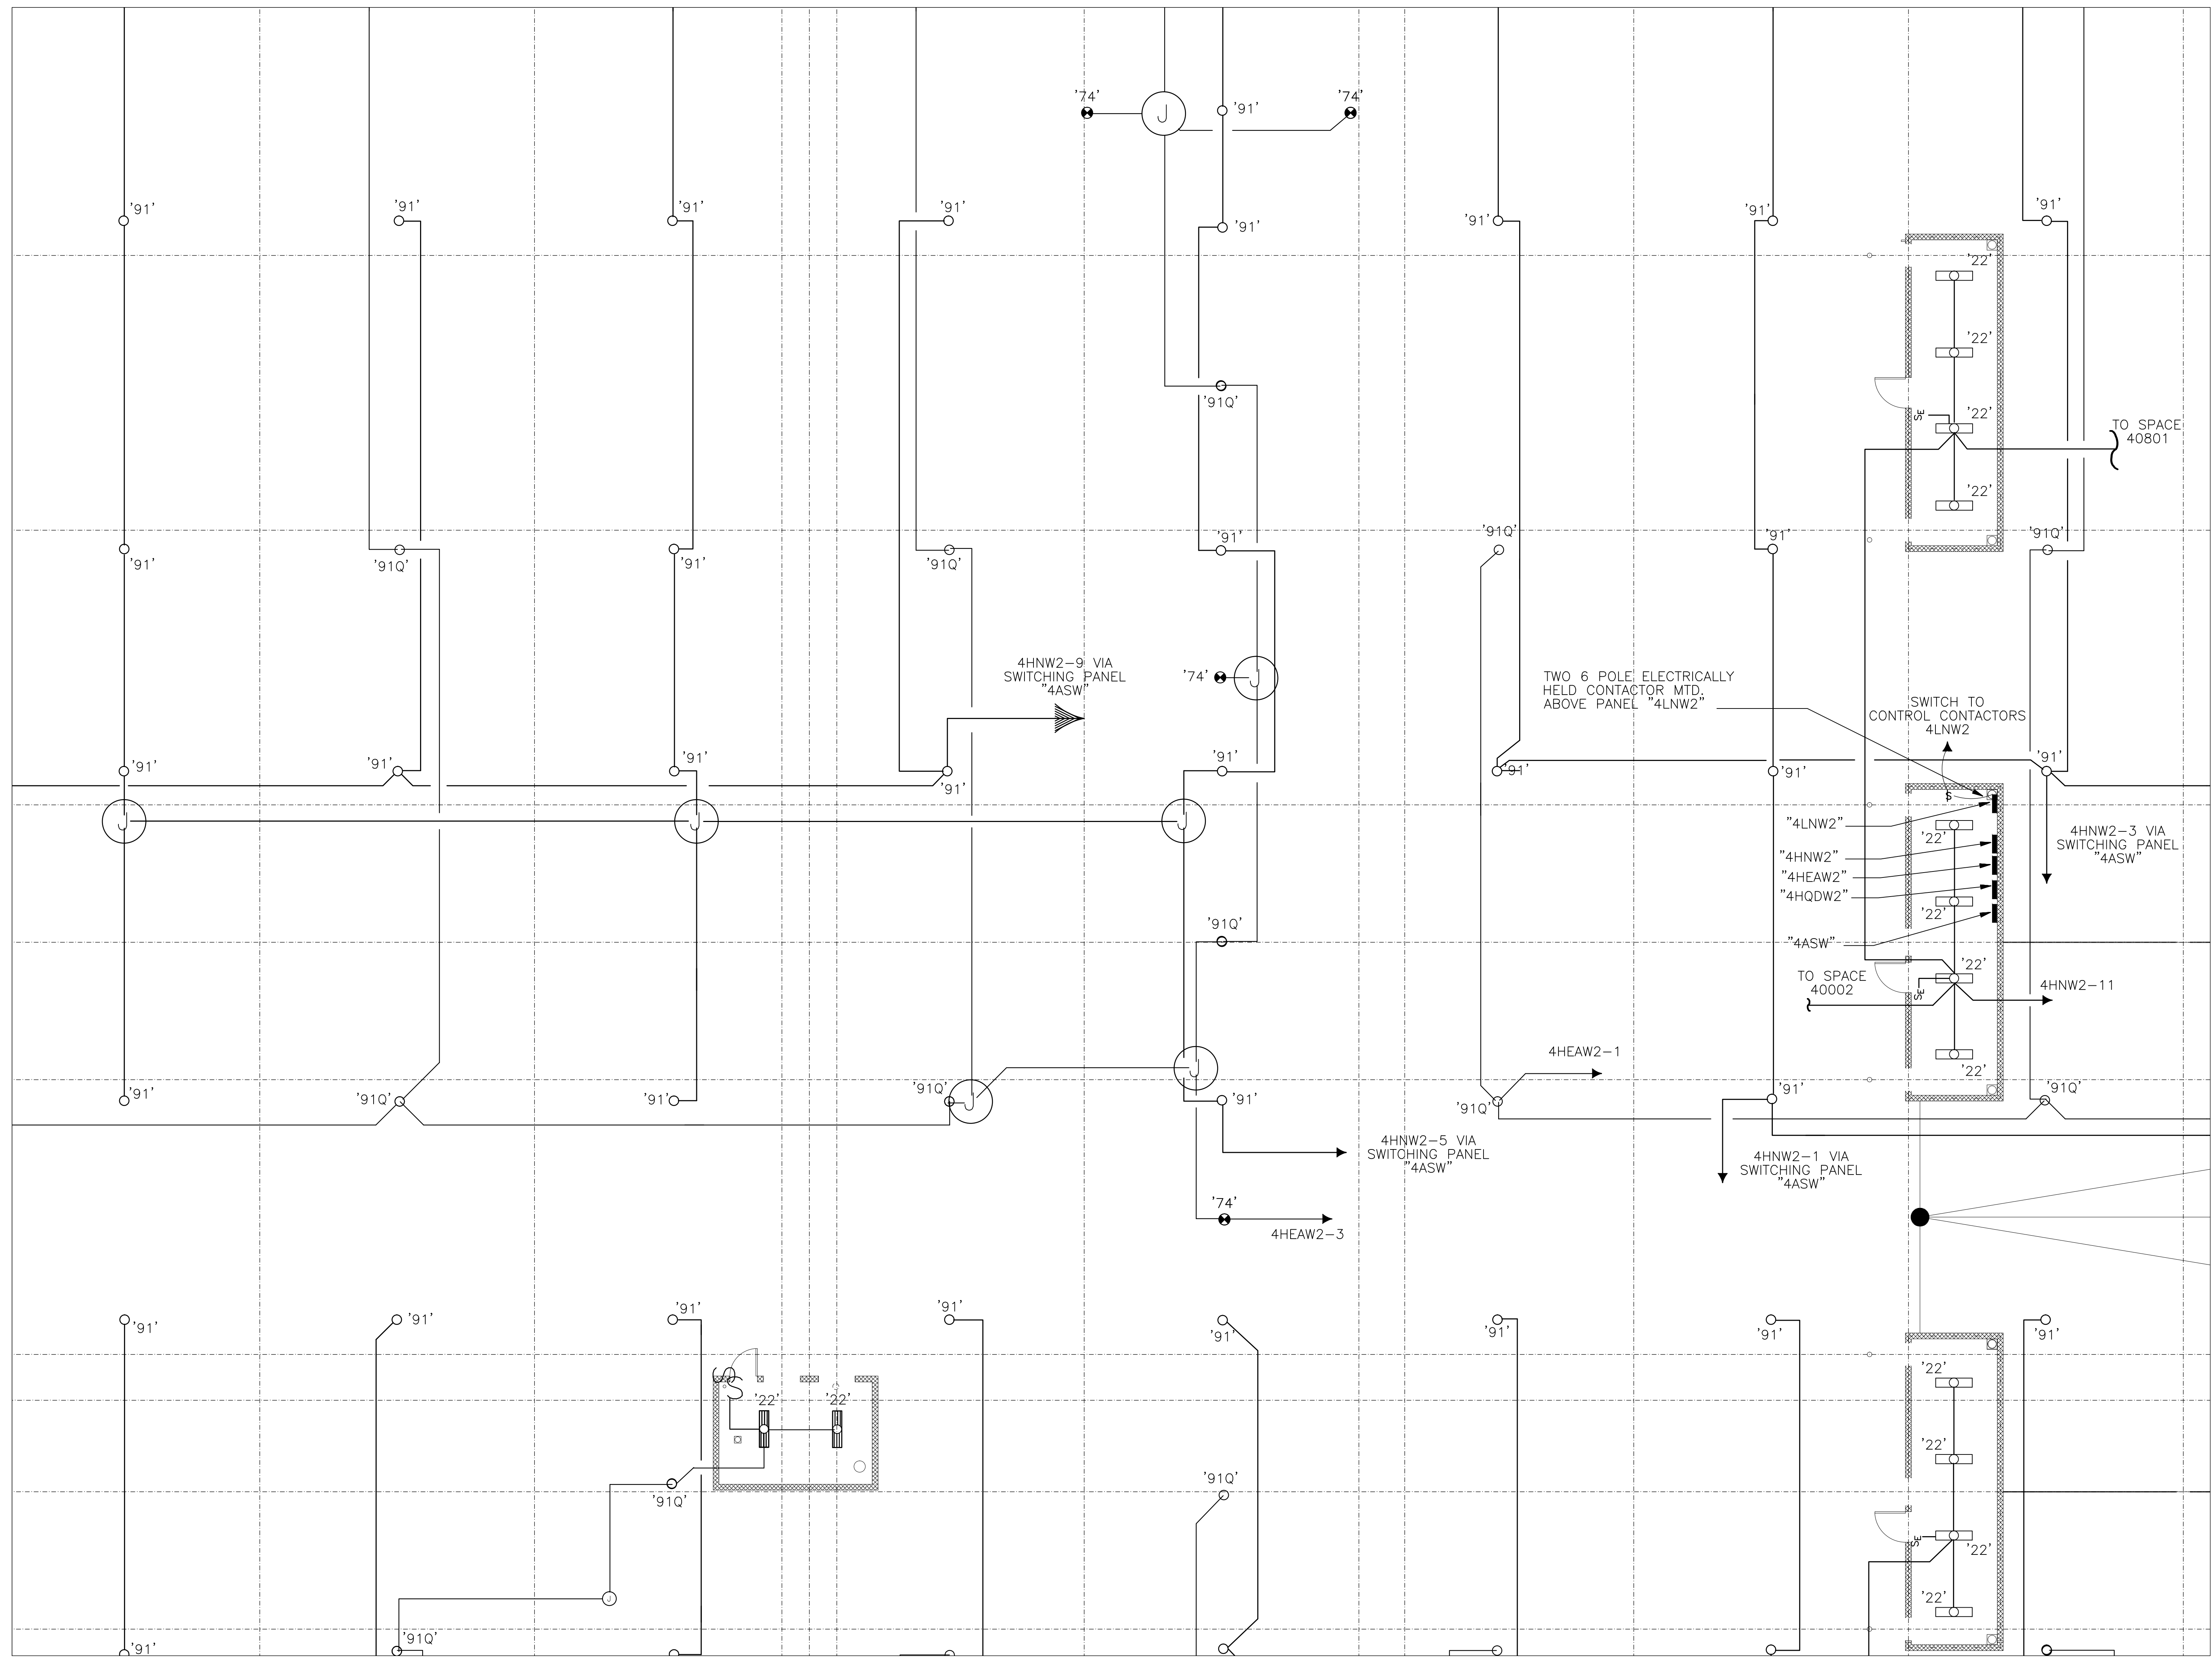


FILE PATH FOR CAD OPERATOR USE ONLY: P:\2017\Conti Electric\Projects\MusicCityCenter\407\Level 4 Lighting\Zone 7 For Owner.dwg

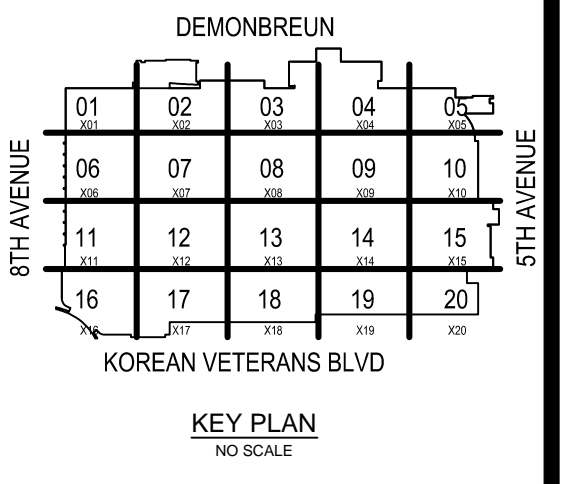

COORDINATION SIGN-OFF

| COMPANY | TRADE | DATE |
|---------|-------|------|
| CONTI   | ELEC. | / /  |
|         |       | / /  |
|         |       | / /  |
**Music City Center**  
 Nashville, Tennessee

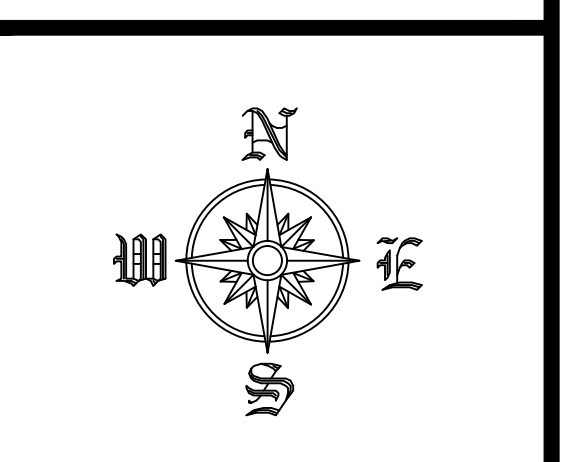

REVISIONS

| NO. | DATE | DESCRIPTION |
|-----|------|-------------|
|     |      |             |
|     |      |             |
RECORD DRAWINGS STAMP

CONTELECTRIC DATE (Last Update):  
 2/24/2015 5:06 PM

DRAWING FILE NAME:  
 EL2-408

CAD OPERATOR:  
 GERTMAN

PRINTED BY:  
 FREDMAN, GREGG


PLOT DATE:  
 6/4/2015 8:11 AM

SUBMITTED BY:  
 G.P.

ASSIGNED TO:


LEVEL 4 LIGHTING  
 ZONE 8  
 SCALE: 1/8" = 1'-0"

EL2-408

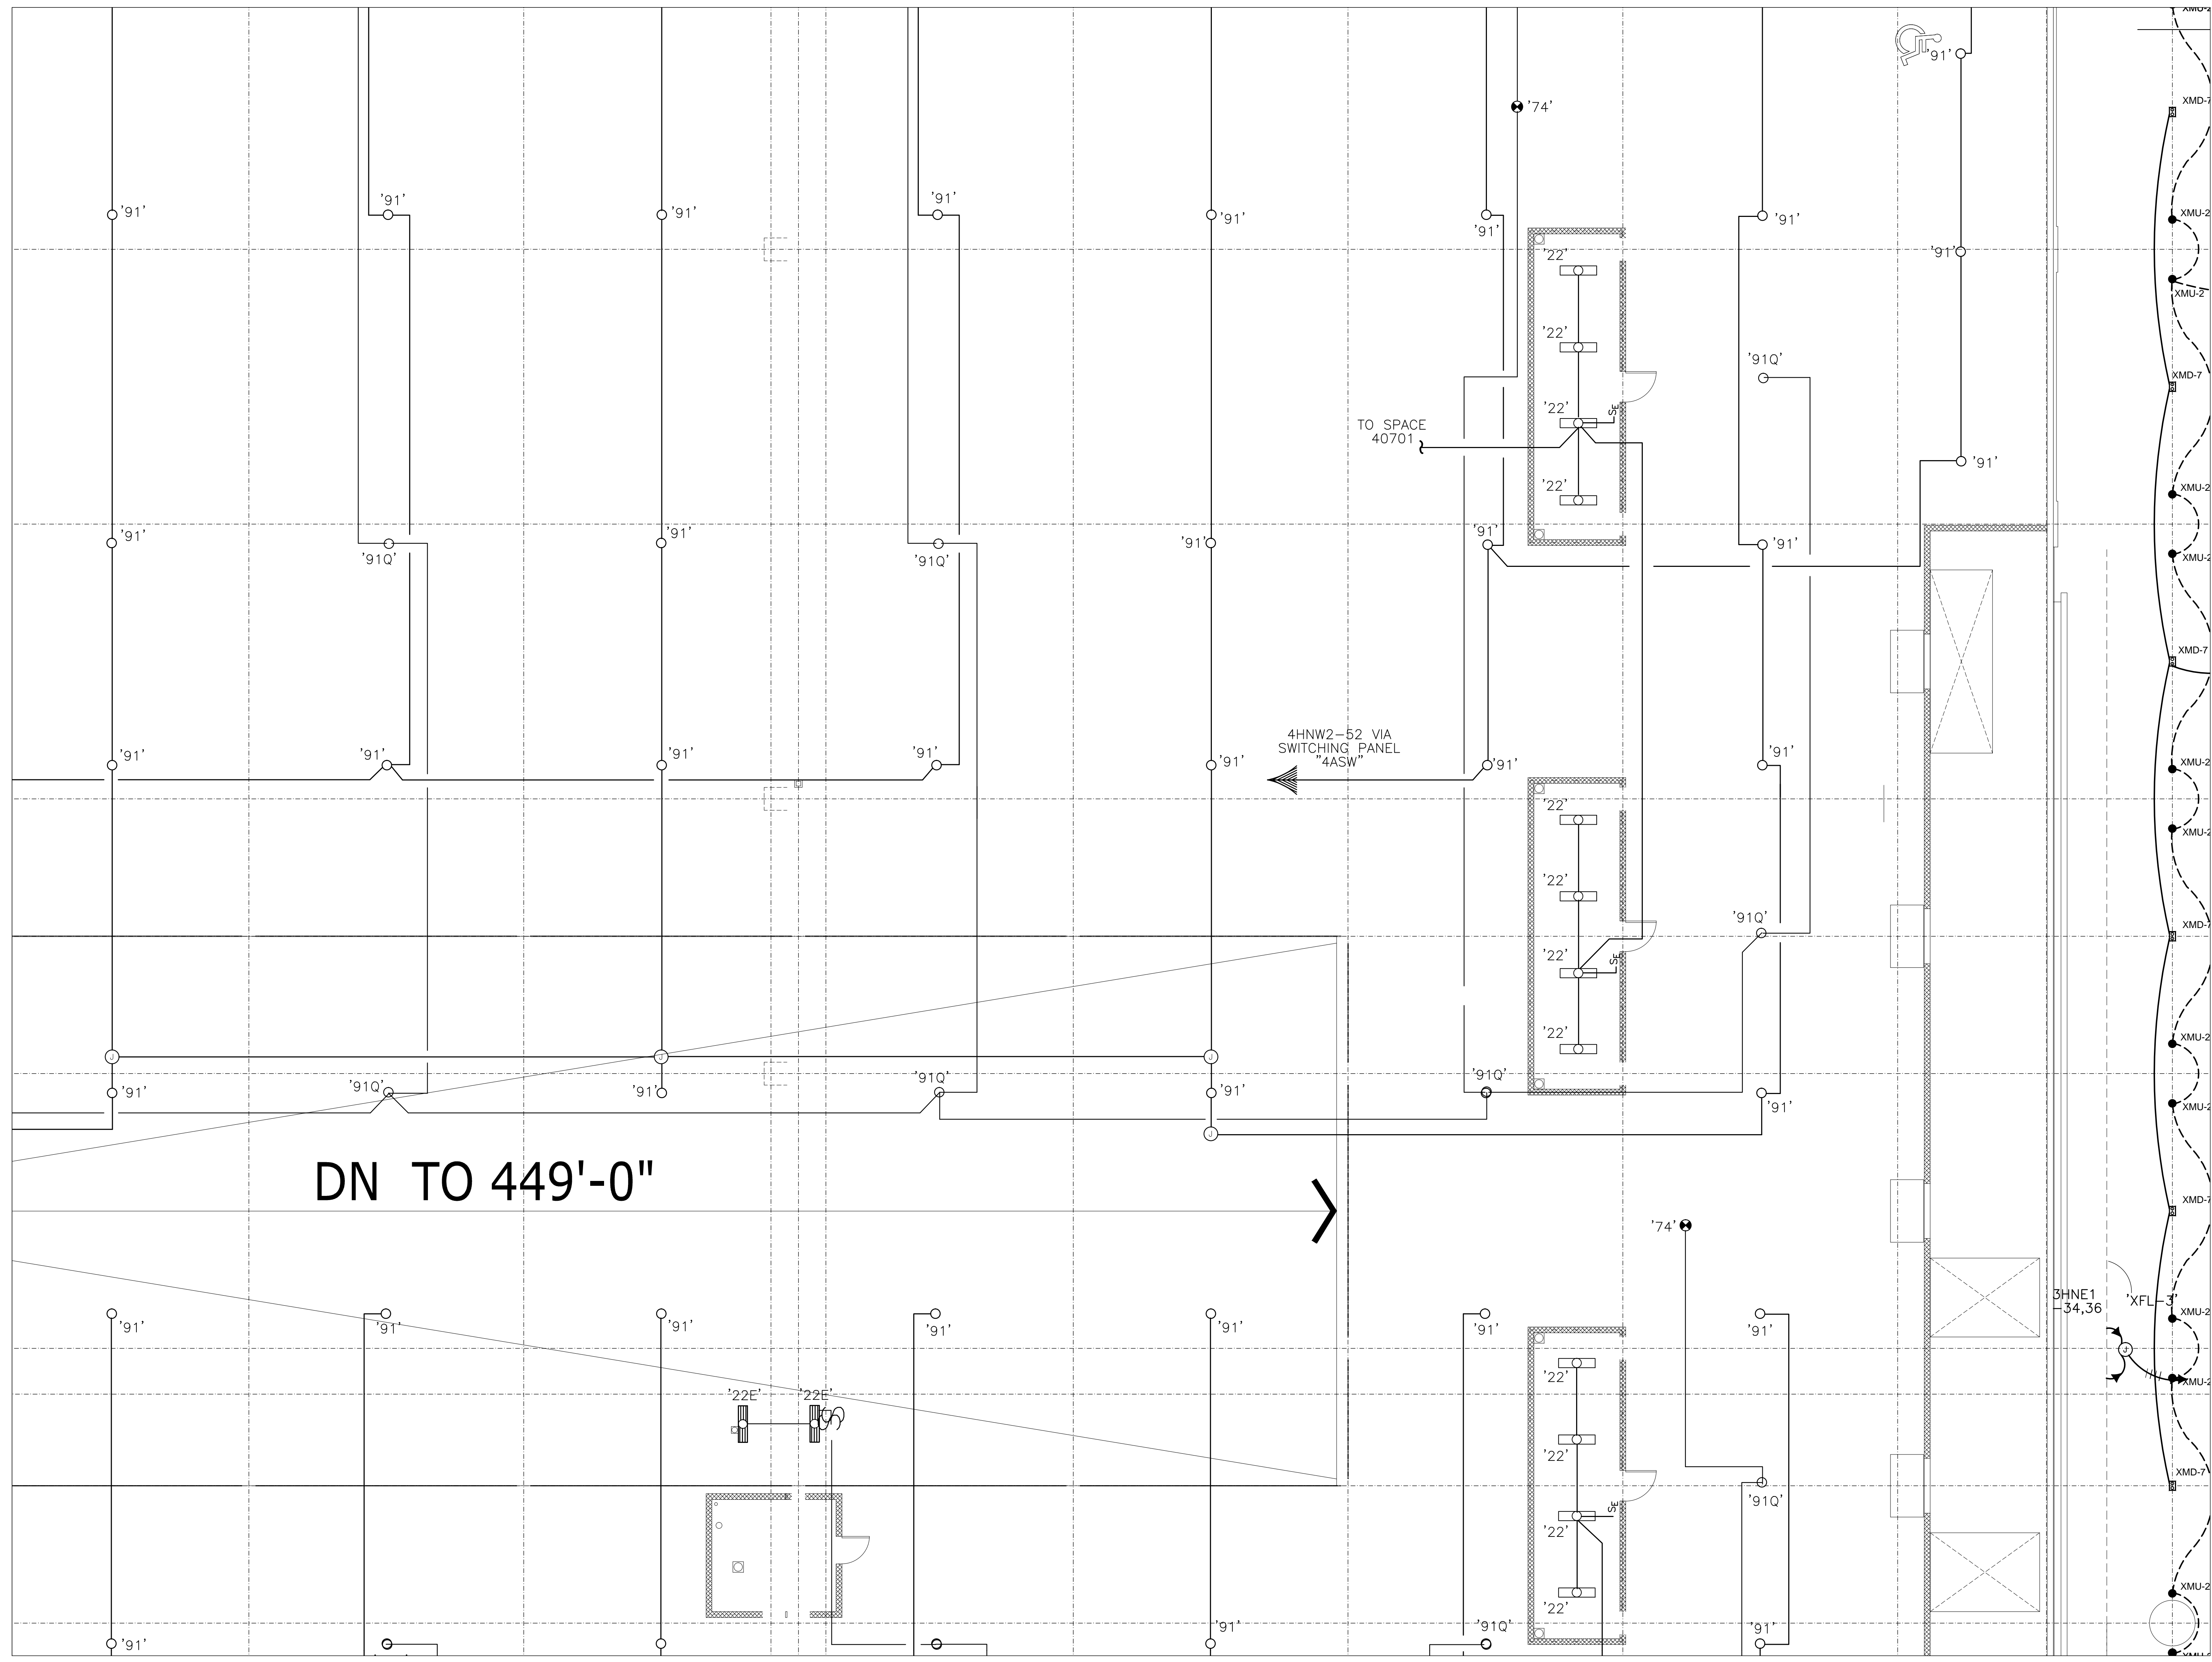

FILE PATH FOR CAD OPERATOR USE ONLY: P:\2015\Conti\Bids\Nashville\_MCC\Level\_4\_Lighting\_Schedule\_For\_Separating




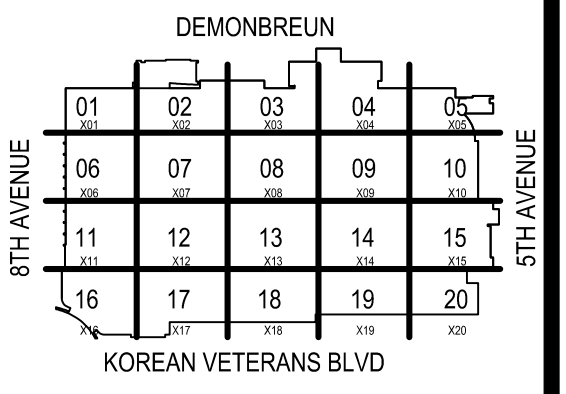

COORDINATION SIGN-OFF

| COMPANY | TRADE | DATE |
|---------|-------|------|
| CONTI   | ELEC. | / /  |
|         |       | / /  |
|         |       | / /  |
**Music City Center**  
 Nashville, Tennessee

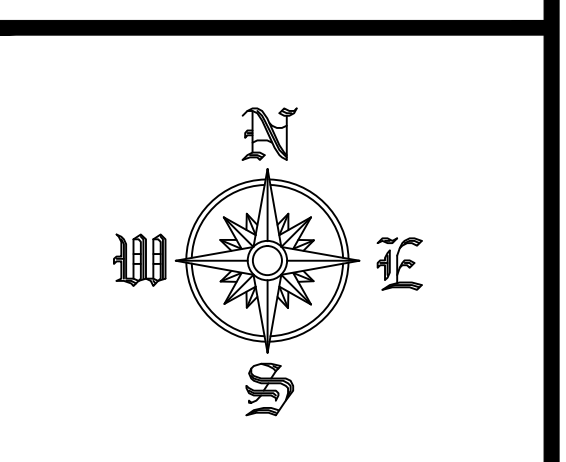

REVISIONS


| NO. | DATE | DESCRIPTION |
|-----|------|-------------|
|     |      |             |
|     |      |             |
|     |      |             |
|     |      |             |

RECORD DRAWINGS STAMP

CONTRACT DATE (Last Update): 2/24/2015 5:04 PM  
 DRAWING FILE NAME: E22-239  
 CAD OPERATOR: GERRMAN  
 PRINTED BY: GERRMAN GREGG  
 PLOT DATE: 6/4/2015 8:11 AM  
 SUBMITTED BY: G.L.P.  
 ASSIGNED TO:


LEVEL 4 LIGHTING  
 ZONE 9  
 SCALE: 1/8" = 1'-0"

EL2-409

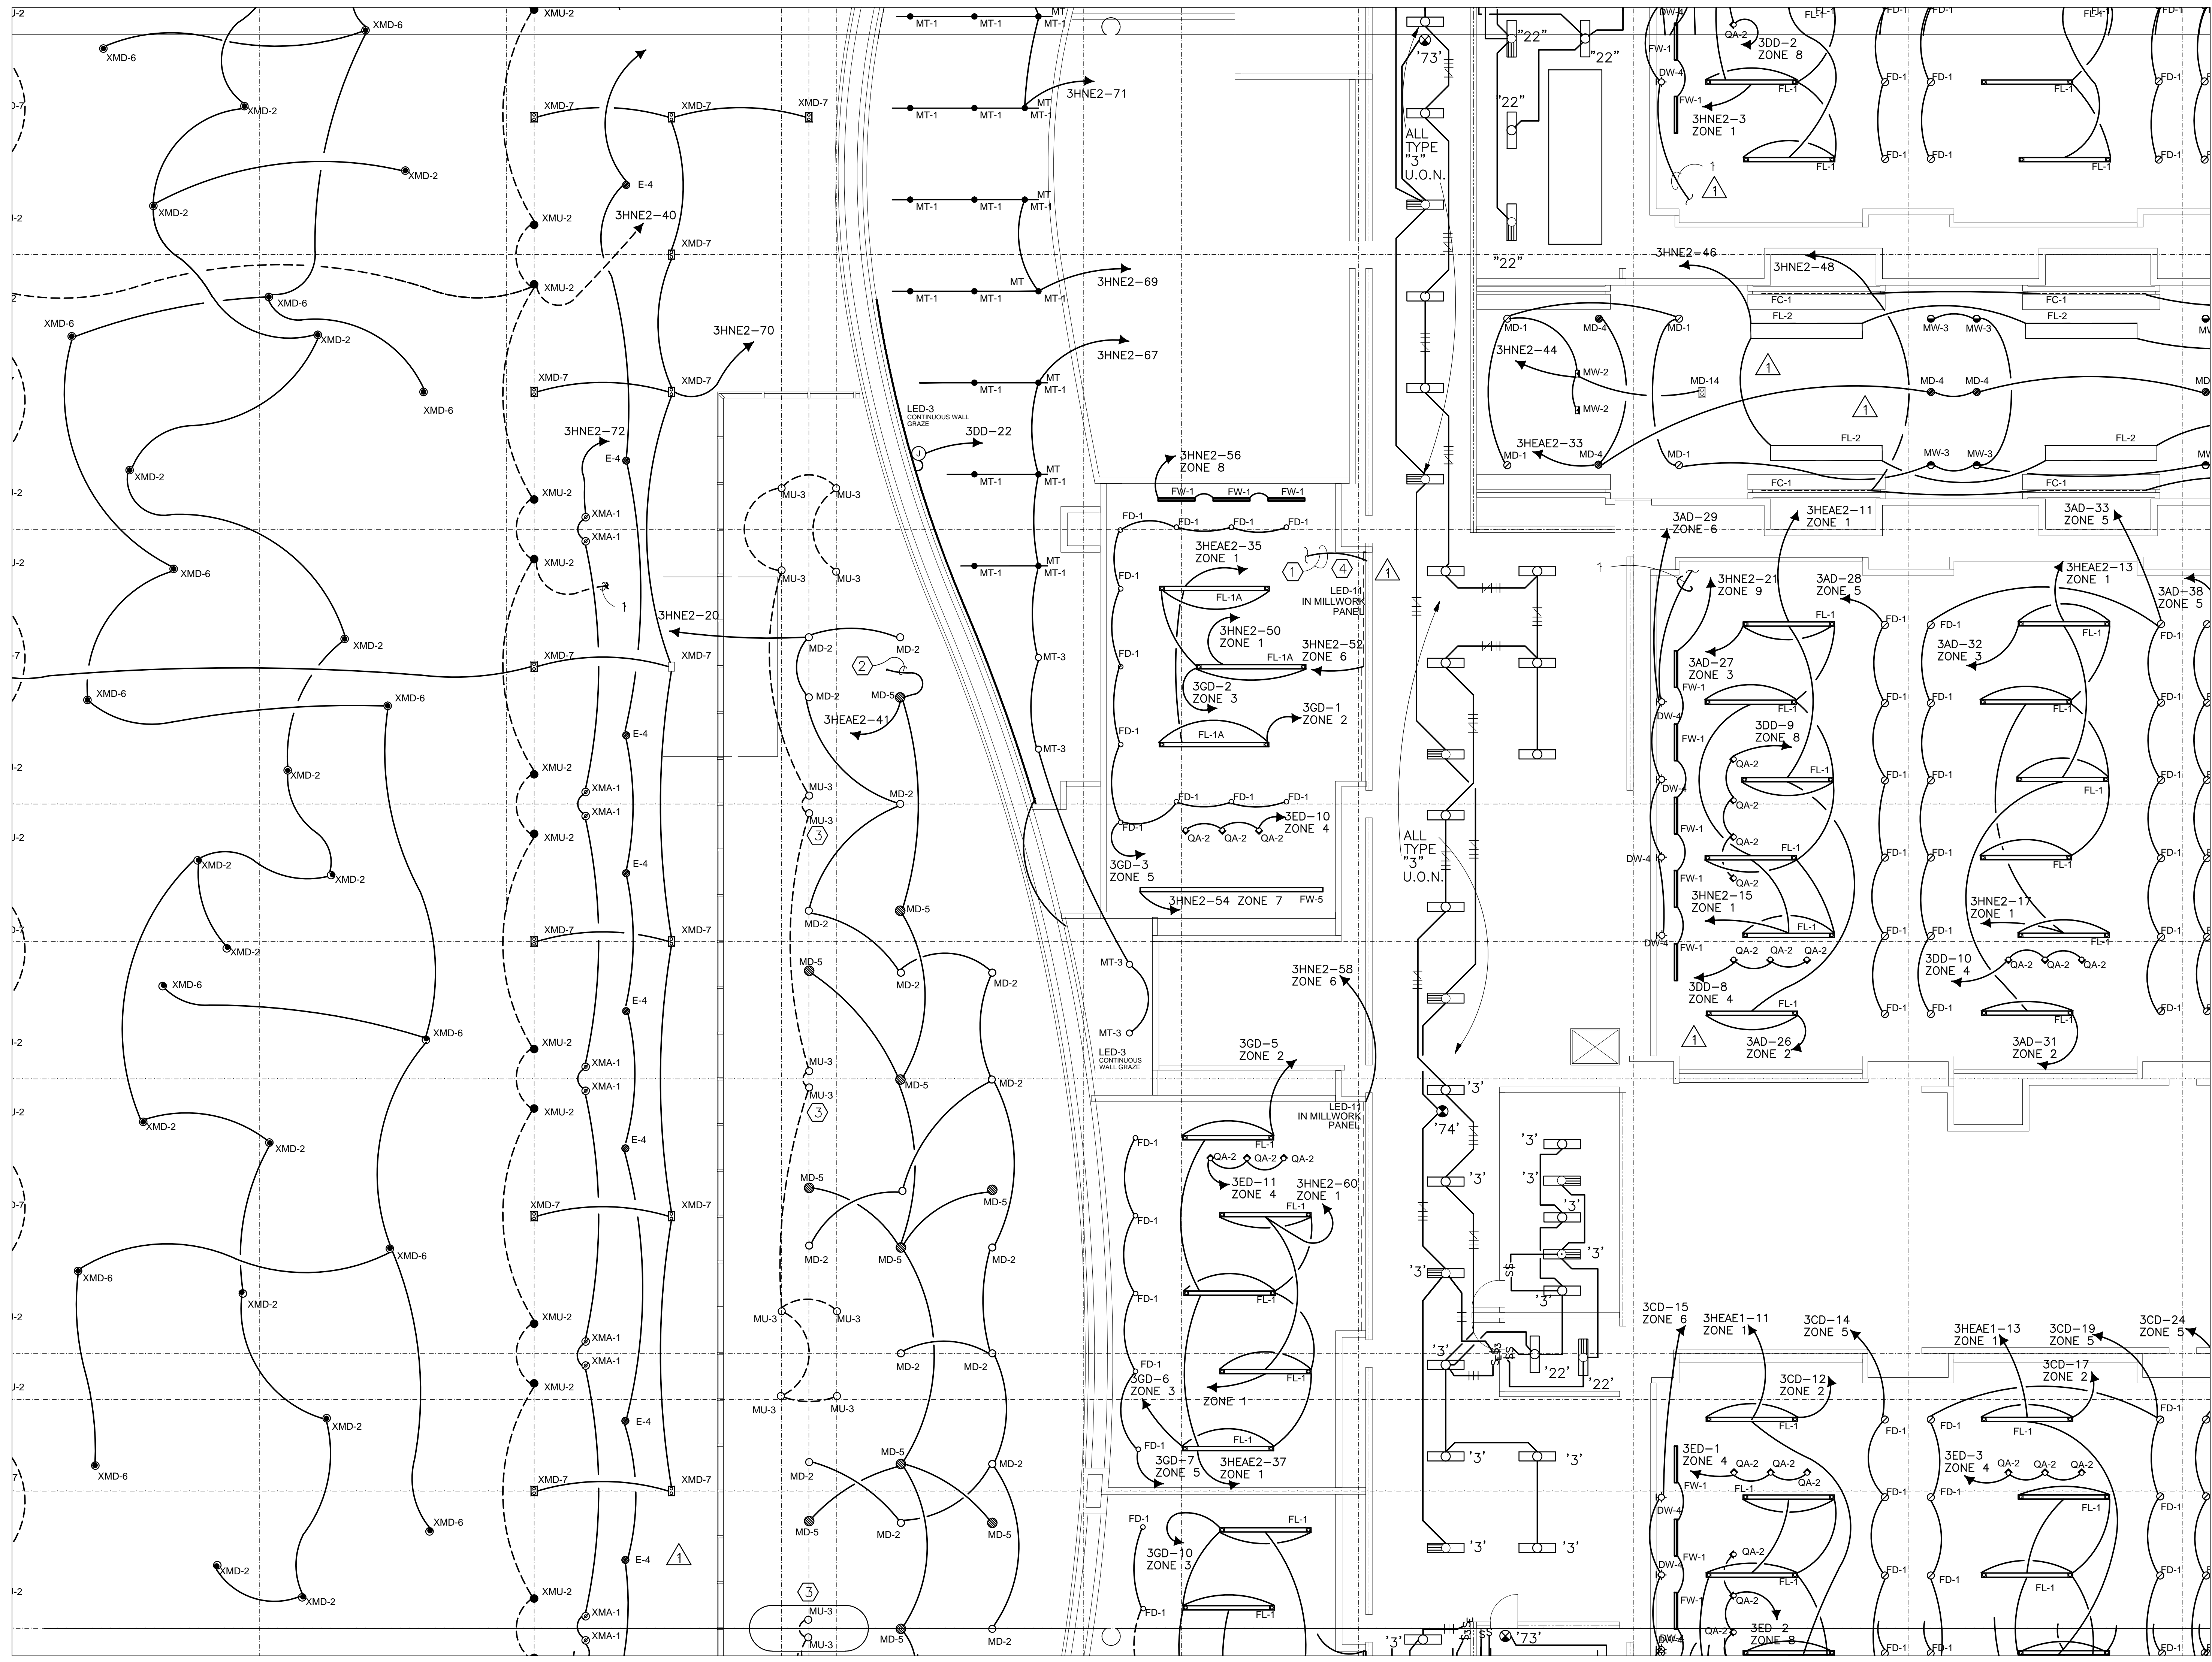

FILE PATH FOR CAD OPERATOR USE ONLY: P:\2015\Conti\Electric\Zone9\Level 4 Lighting\Zone 9 For Opening.dwg




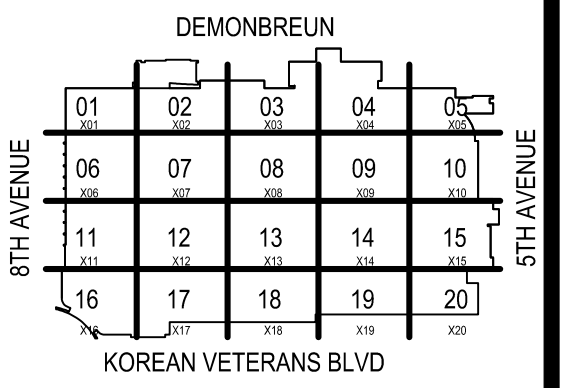

COORDINATION SIGN-OFF

| COMPANY | TRADE | DATE |
|---------|-------|------|
| CONTI   | ELEC. | / /  |
|         |       | / /  |
|         |       | / /  |
**Music City Center**  
 Nashville, Tennessee

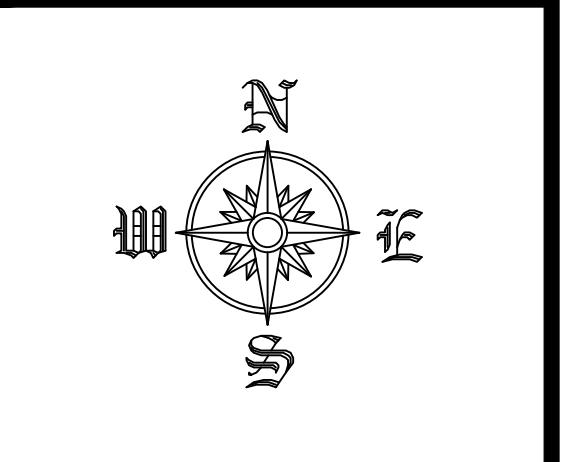

REVISIONS


| NO. | DATE | DESCRIPTION |
|-----|------|-------------|
|     |      |             |
|     |      |             |
RECORD DRAWINGS STAMP


CONTELECTRIC DATE (Last Update): 2/2/2015 5:04 PM  
 DRAWING FILE NAME: E2-10  
 CAD OPERATOR: GERTMAN  
 PRINTED BY: FREDMAN, GREGG  
 PLOT DATE: 6/4/2012 8:12 AM  
 SUBMITTED BY: GELF  
 ASSIGNED TO:

LEVEL 4 LIGHTING  
 ZONE 10  
 SCALE: 1/8" = 1'-0"

EL2-410

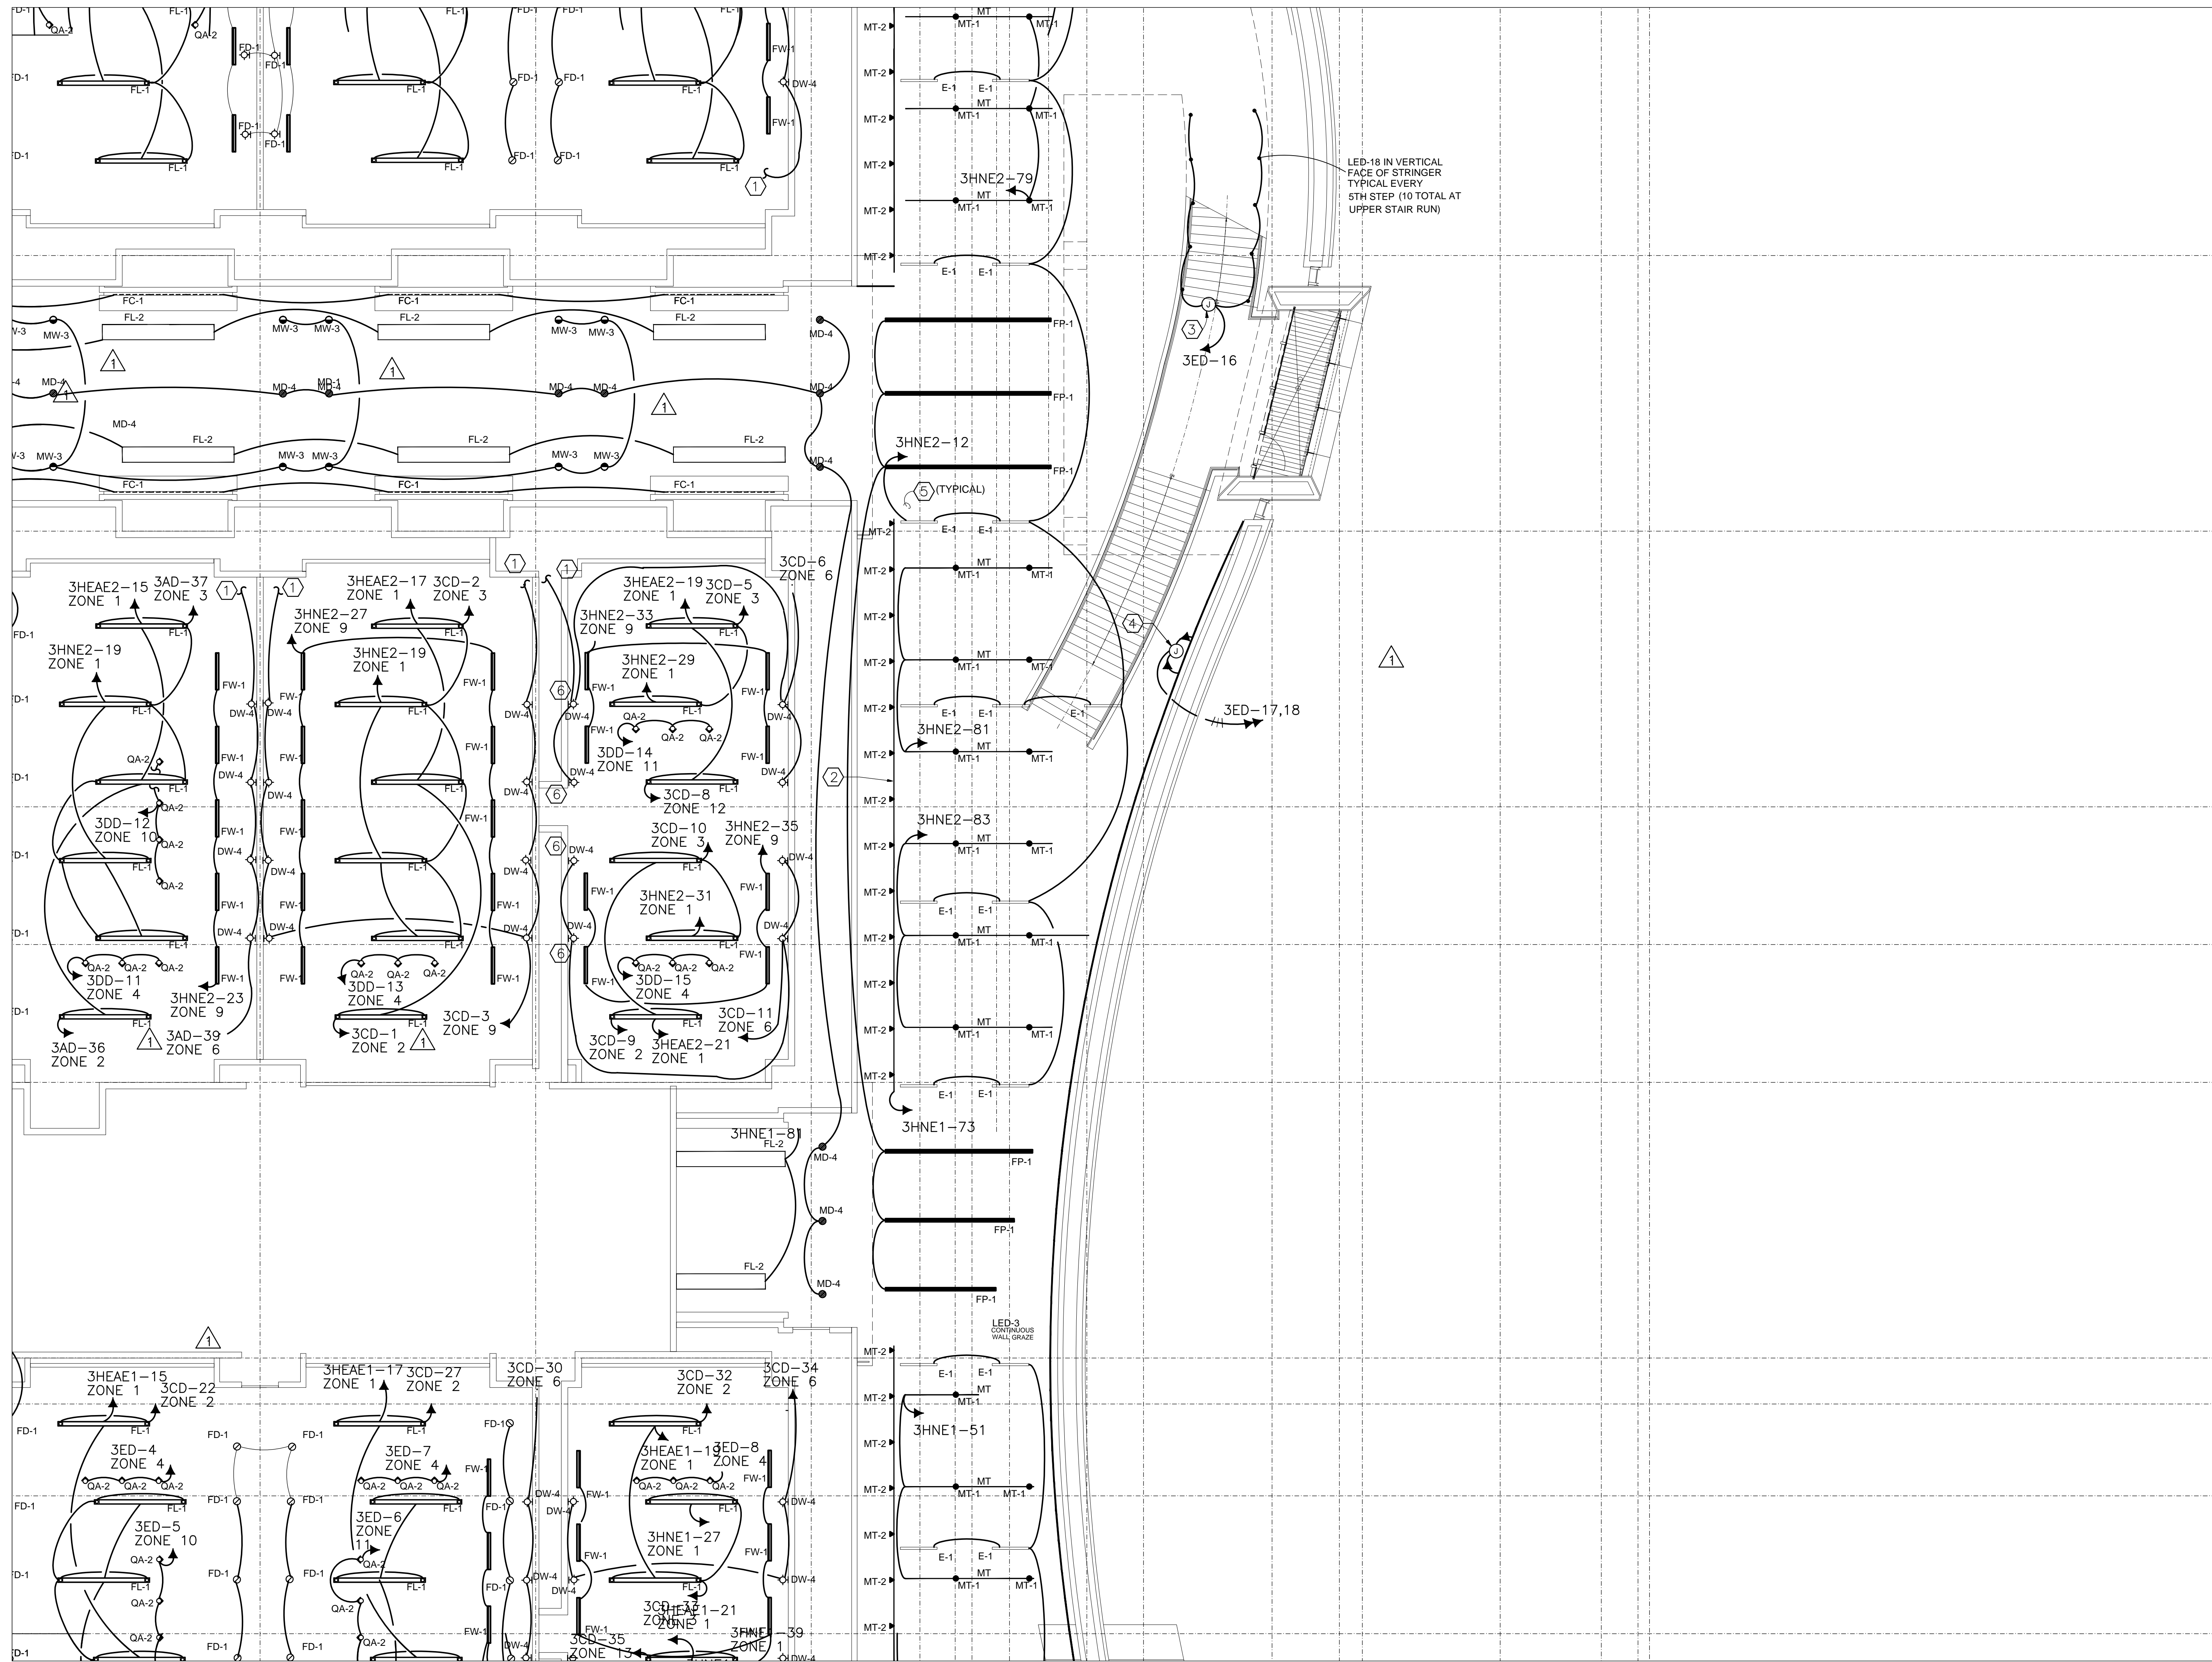




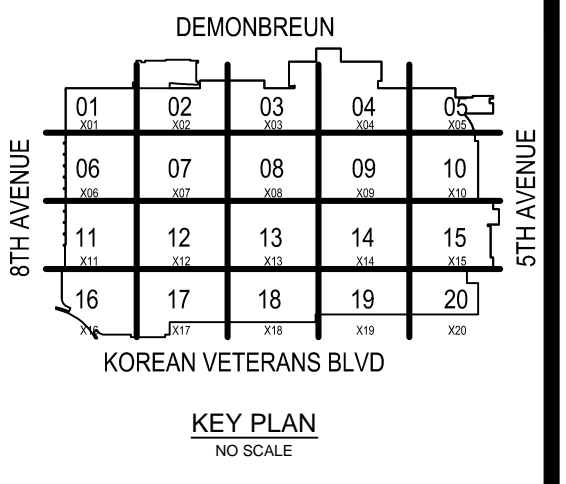

| COORDINATION SIGN-OFF |      | DATE | DATE | DATE | DATE | DATE |
|-----------------------|------|------|------|------|------|------|
| COMPANY               | NAME |      |      |      |      |      |
| TRADE                 |      |      |      |      |      |      |
| ELEC.                 |      |      |      |      |      |      |
| CONTI                 |      |      |      |      |      |      |

**Music City Center**  
 Nashville, Tennessee

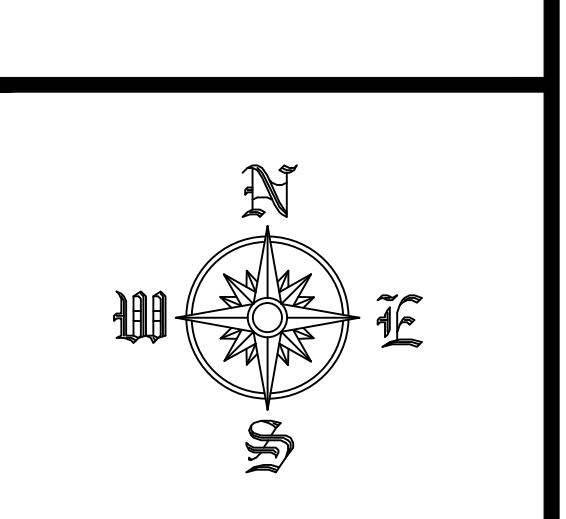


| REVISIONS |      |             |
|-----------|------|-------------|
| NO.       | DATE | DESCRIPTION |
|           |      |             |
|           |      |             |
**RECORD DRAWINGS STAMP**


CONTI ELECTRIC DATE (Last Update): 2/29/2012 5:06 PM  
 DRAWING FILE NAME: E22-110  
 CAD OPERATOR: GERTMAN  
 PRINTED BY: FREDMAN, GREGG  
 PLOT DATE: 6/4/2012 8:12 AM  
 SUBMITTED BY: G.L.P.  
 ASSIGNED TO:

LEVEL 4 LIGHTING  
 ZONE 11  
 SCALE: 1/8" = 1'-0"

EL2-411

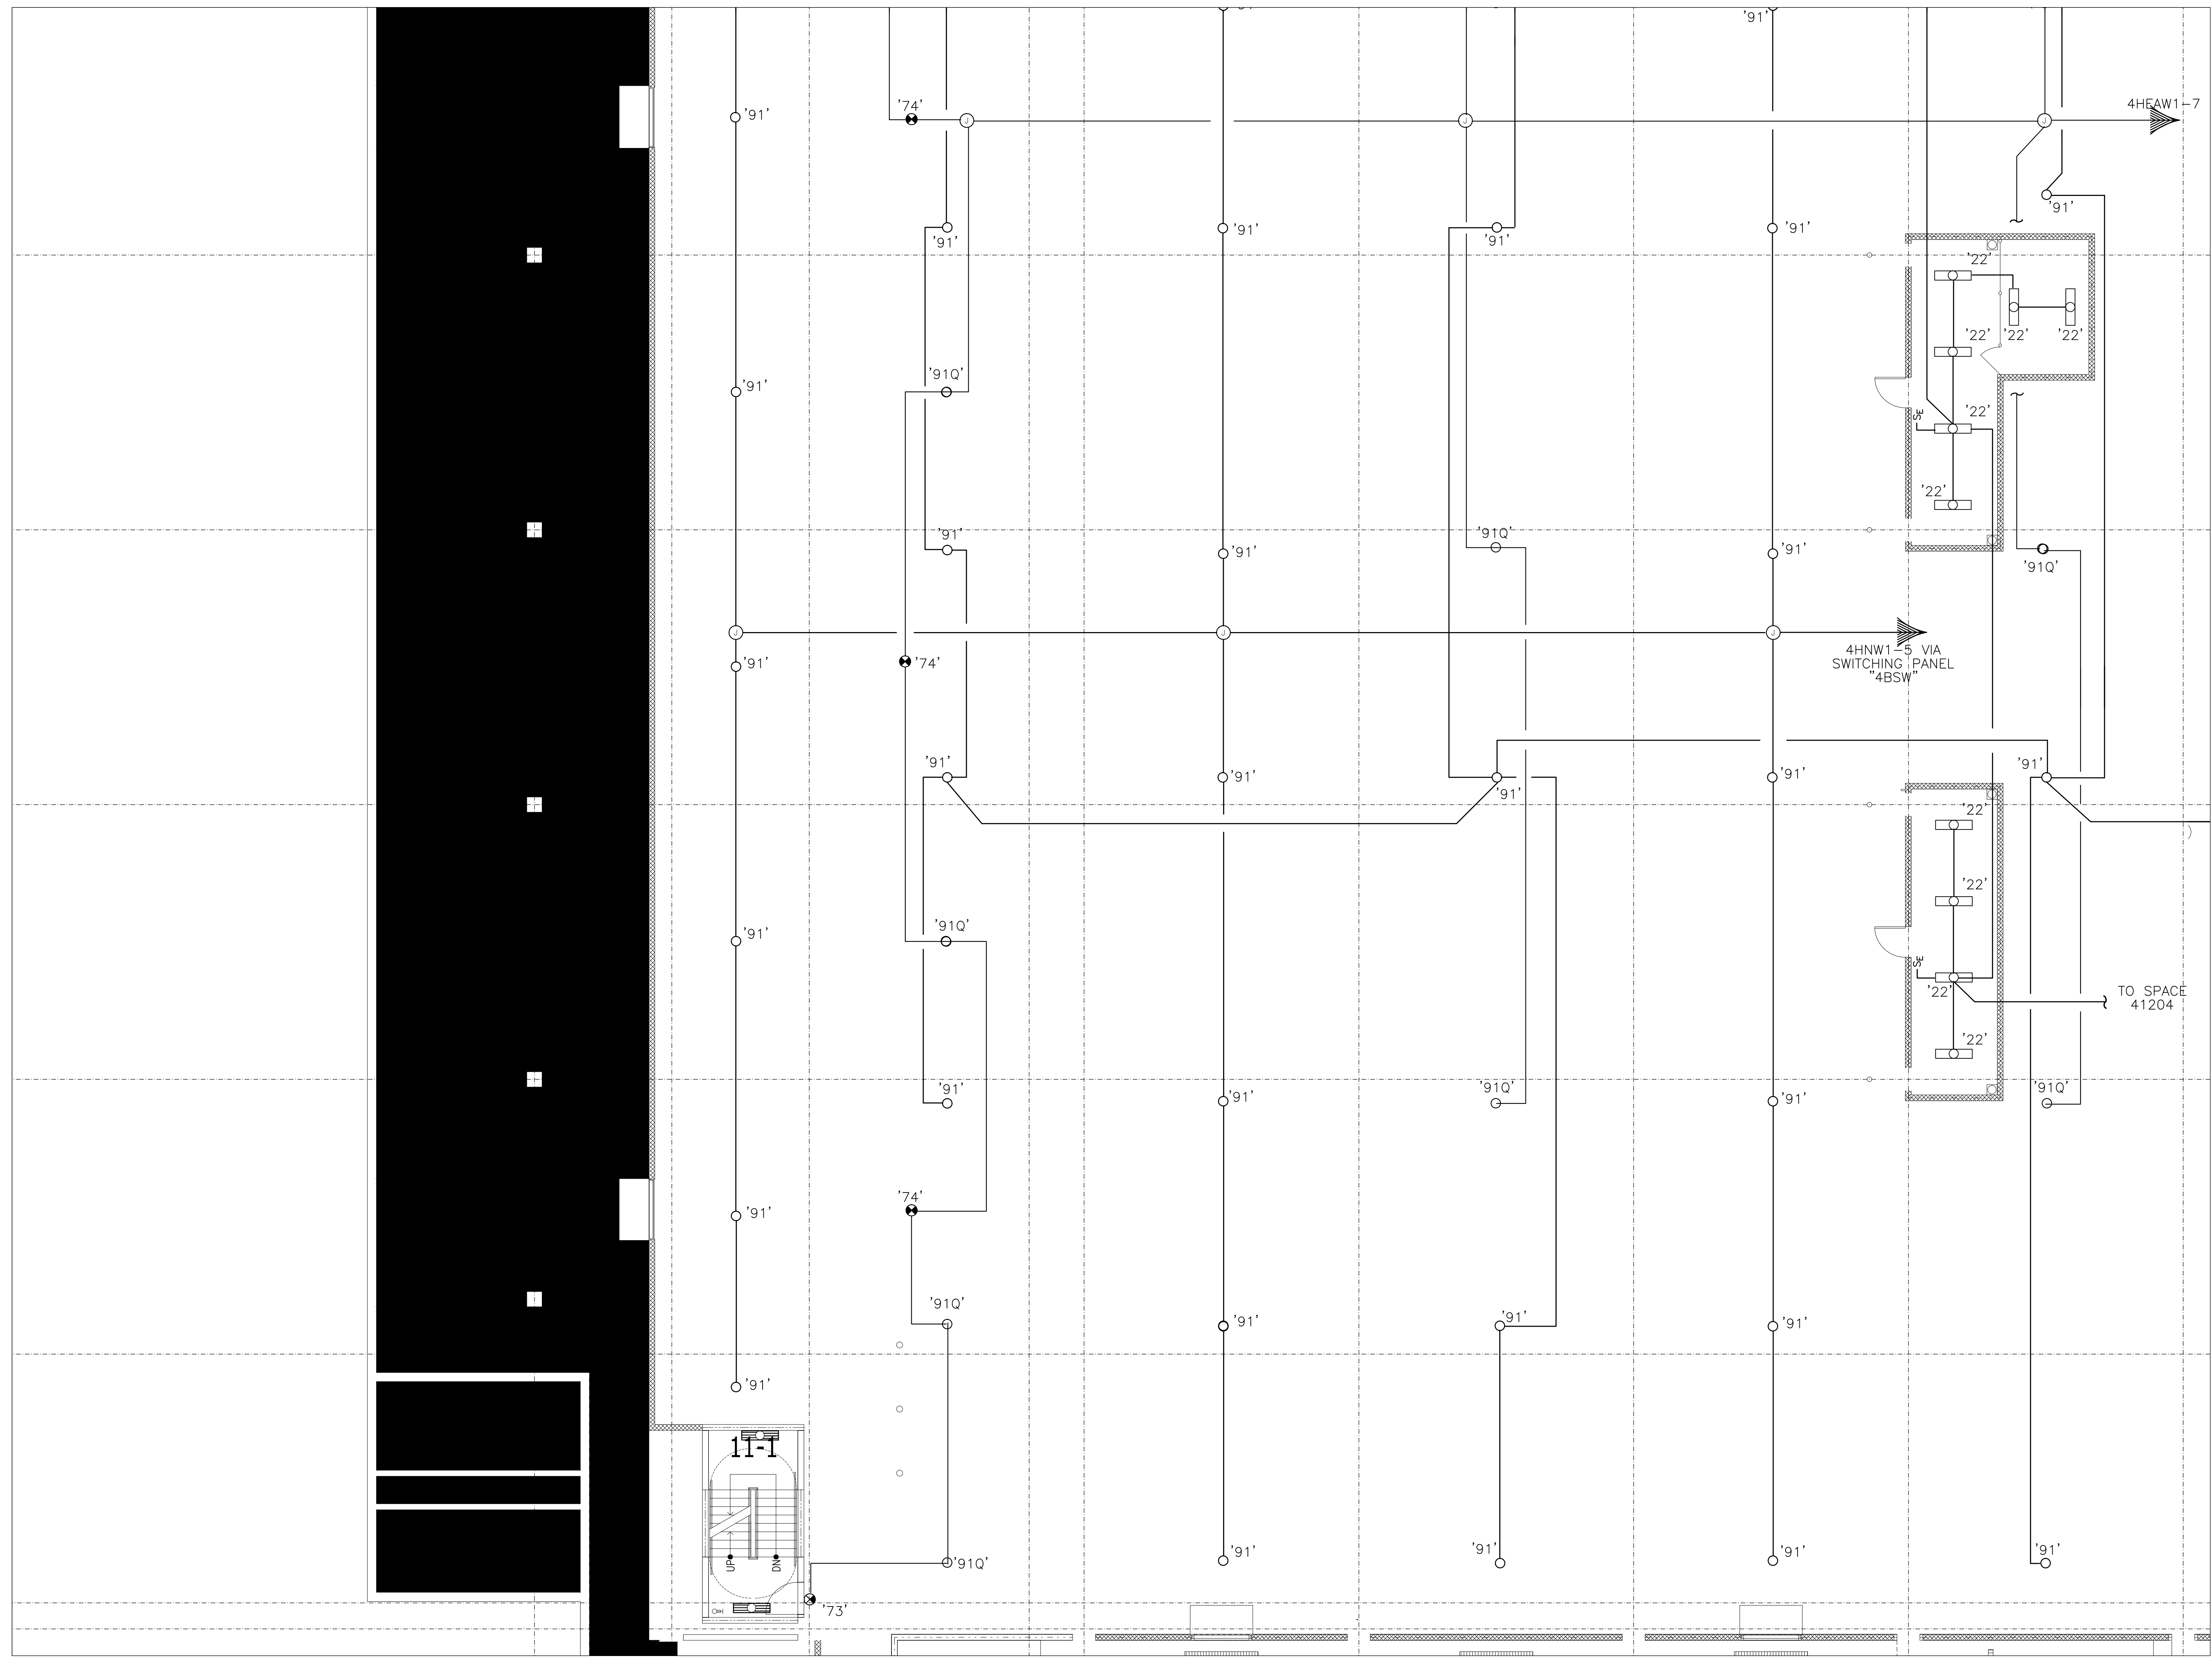


FILE PATH FOR CAD DEPARTMENT USE ONLY: P:\2012\Conti Electric\Projects\MCC\Level 4 Lighting\Zone 11 For Opening.dwg

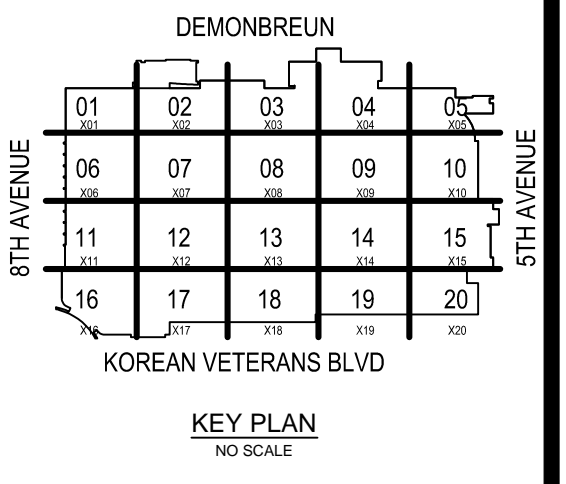

COORDINATION SIGN-OFF

| COMPANY | TRADE | DATE |
|---------|-------|------|
| CONTI   | ELEC. | / /  |
|         |       | / /  |
|         |       | / /  |
|         |       | / /  |
|         |       | / /  |

**Music City Center**  
 Nashville, Tennessee

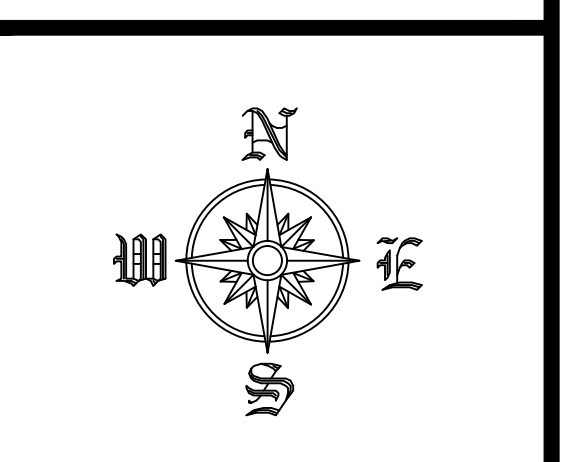

REVISIONS


| NO. | DATE | DESCRIPTION |
|-----|------|-------------|
|     |      |             |
|     |      |             |
RECORD DRAWINGS STAMP


CONTELECTRIC DATE (Last Update): 2/29/2012 5:06 PM  
 DRAWING FILE NAME: E2-12  
 CAD OPERATOR: GERTMAN  
 PRINTED BY: FREDMAN, GREG  
 PLOT DATE: 6/4/2012 8:12 AM  
 SUBMITTED BY: G.L.P.  
 ASSIGNED TO:

LEVEL 4 LIGHTING  
 ZONE 12  
 SCALE: 1/8" = 1'-0"

EL2-412

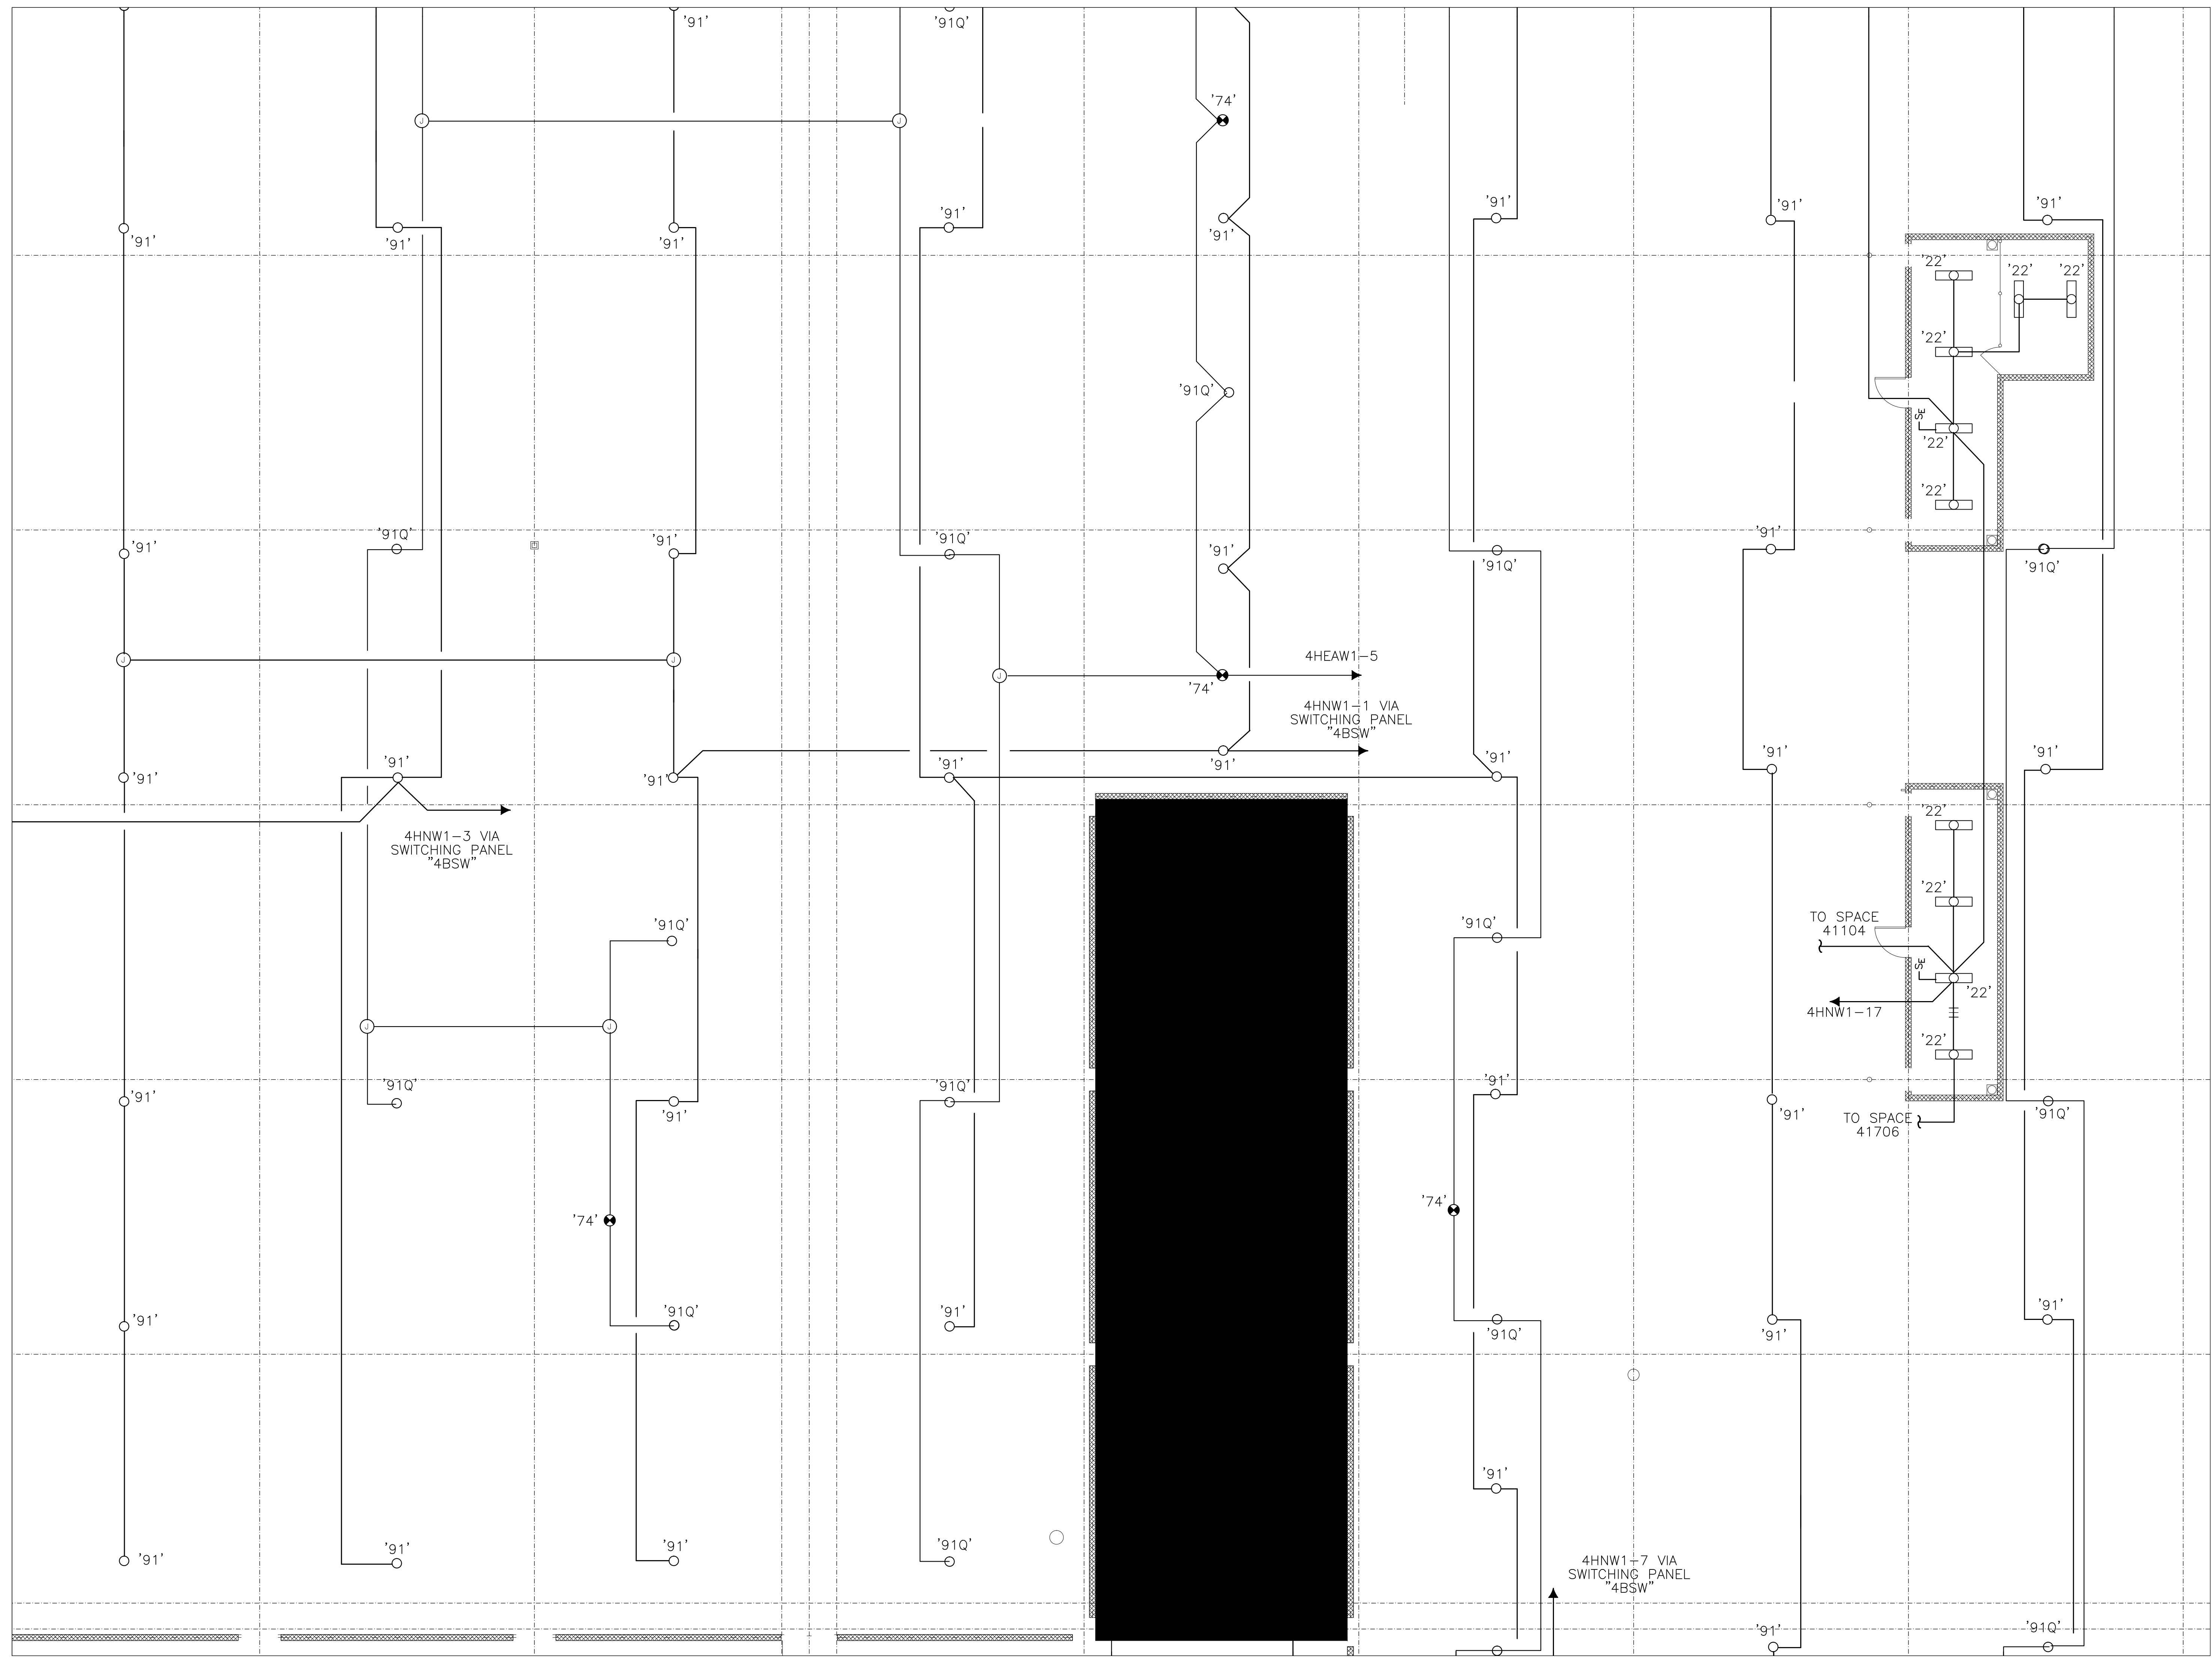




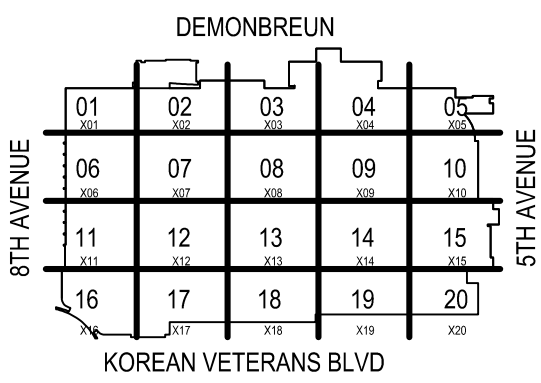

COORDINATION SIGN-OFF

| COMPANY | TRADE | DATE |
|---------|-------|------|
| CONTI   | ELEC. | / /  |
|         |       | / /  |
|         |       | / /  |
**Music City Center**  
 Nashville, Tennessee

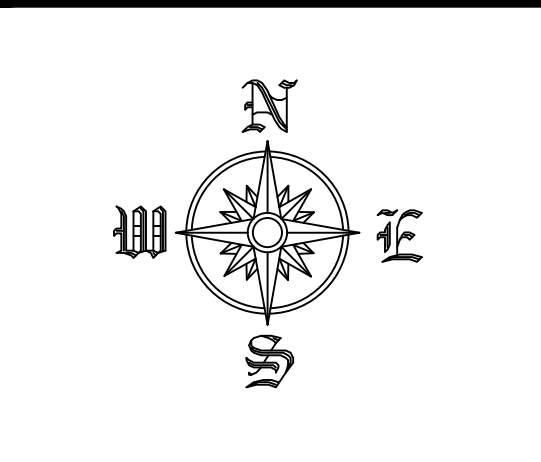

REVISIONS


| NO. | DATE | DESCRIPTION |
|-----|------|-------------|
|     |      |             |
|     |      |             |
RECORD DRAWINGS STAMP

CONTELECTRIC DATE (Last Update): 2/29/2012 5:06 PM  
 DRAWING FILE NAME: EL2-13  
 CAD OPERATOR: GREGG  
 PRINTED BY: GREGG  
 PLOT DATE: 6/4/2012 8:12 AM  
 SUBMITTED BY: GREGG  
 ASSIGNED TO:

LEVEL 4 LIGHTING  
 ZONE 13  
 SCALE: 1/8" = 1'-0"

EL2-413

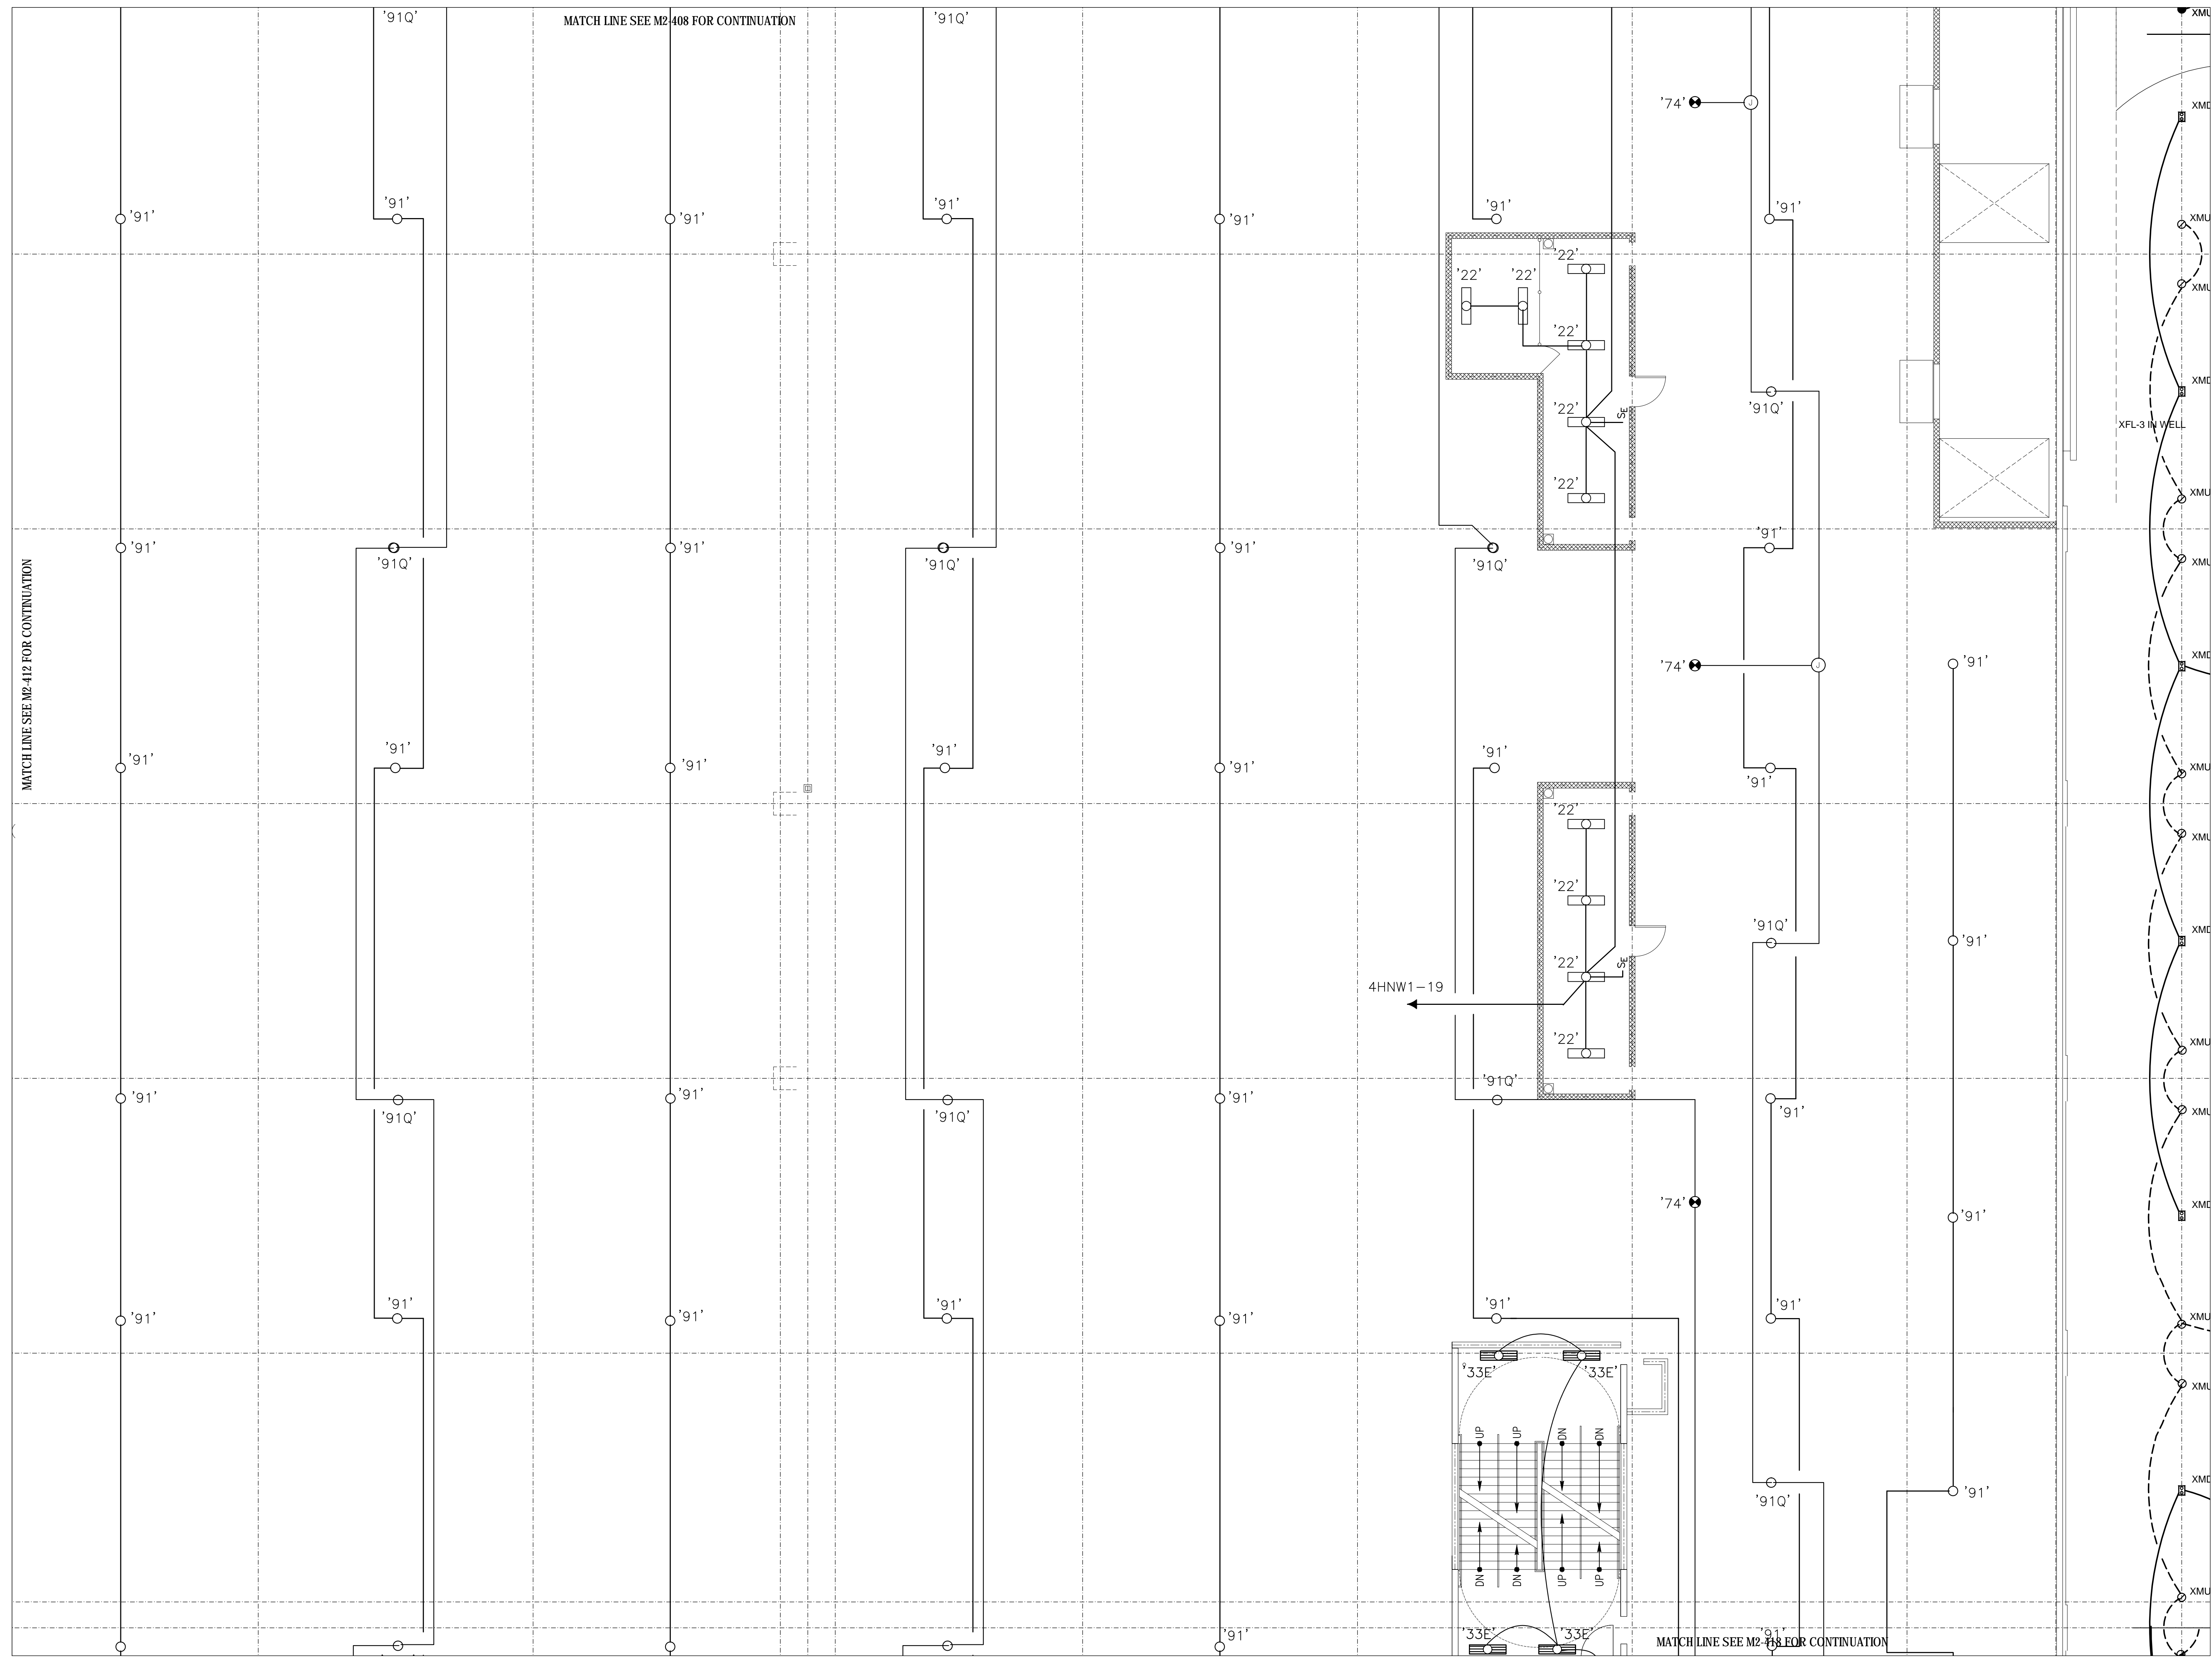


FILE PATH FOR CAD DEPARTMENT USE ONLY: P:\3085\Conti Electric\Projects\MusCity\Level 04 - Level 4\EL2\Zone 13 Lighting Symbols For Overlay.dwg








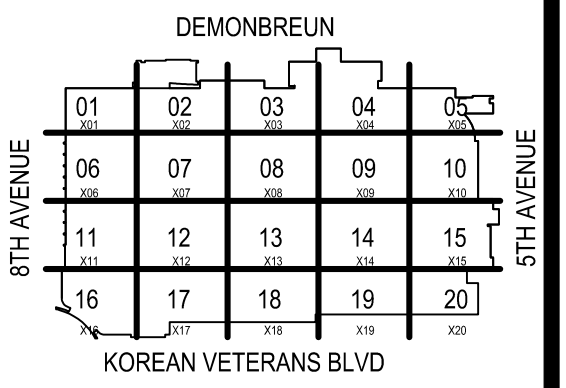

COORDINATION SIGN-OFF

|         |   |   |   |   |   |   |
|---------|---|---|---|---|---|---|
| DATE    | / | / | / | / | / | / |
| NAME    |   |   |   |   |   |   |
| TRADE   |   |   |   |   |   |   |
| ELEC.   |   |   |   |   |   |   |
| COMPANY |   |   |   |   |   |   |
| CONTI   |   |   |   |   |   |   |

**Music City Center**  
 Nashville, Tennessee

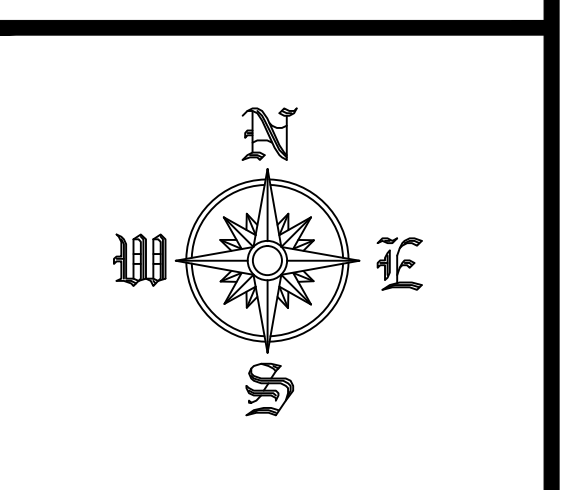

REVISIONS

| NO. | DATE | DESCRIPTION |
|-----|------|-------------|
|     |      |             |
|     |      |             |
RECORD DRAWINGS STAMP

CONTELECTRIC DATE (Last Update):  
 2/20/2015 5:04 PM

DRAWING FILE NAME:  
 EL2-415

CAD OPERATOR:  
 GERRITMAN

PRINTED BY:  
 FREDMAN, GREGG


PLOT DATE:  
 6/4/2015 8:12 AM

SUBMITTED BY:  
 G.P.F.


ASSIGNED TO:

LEVEL 4 LIGHTING  
 ZONE 15  
 SCALE: 1/8" = 1'-0"

EL2-415

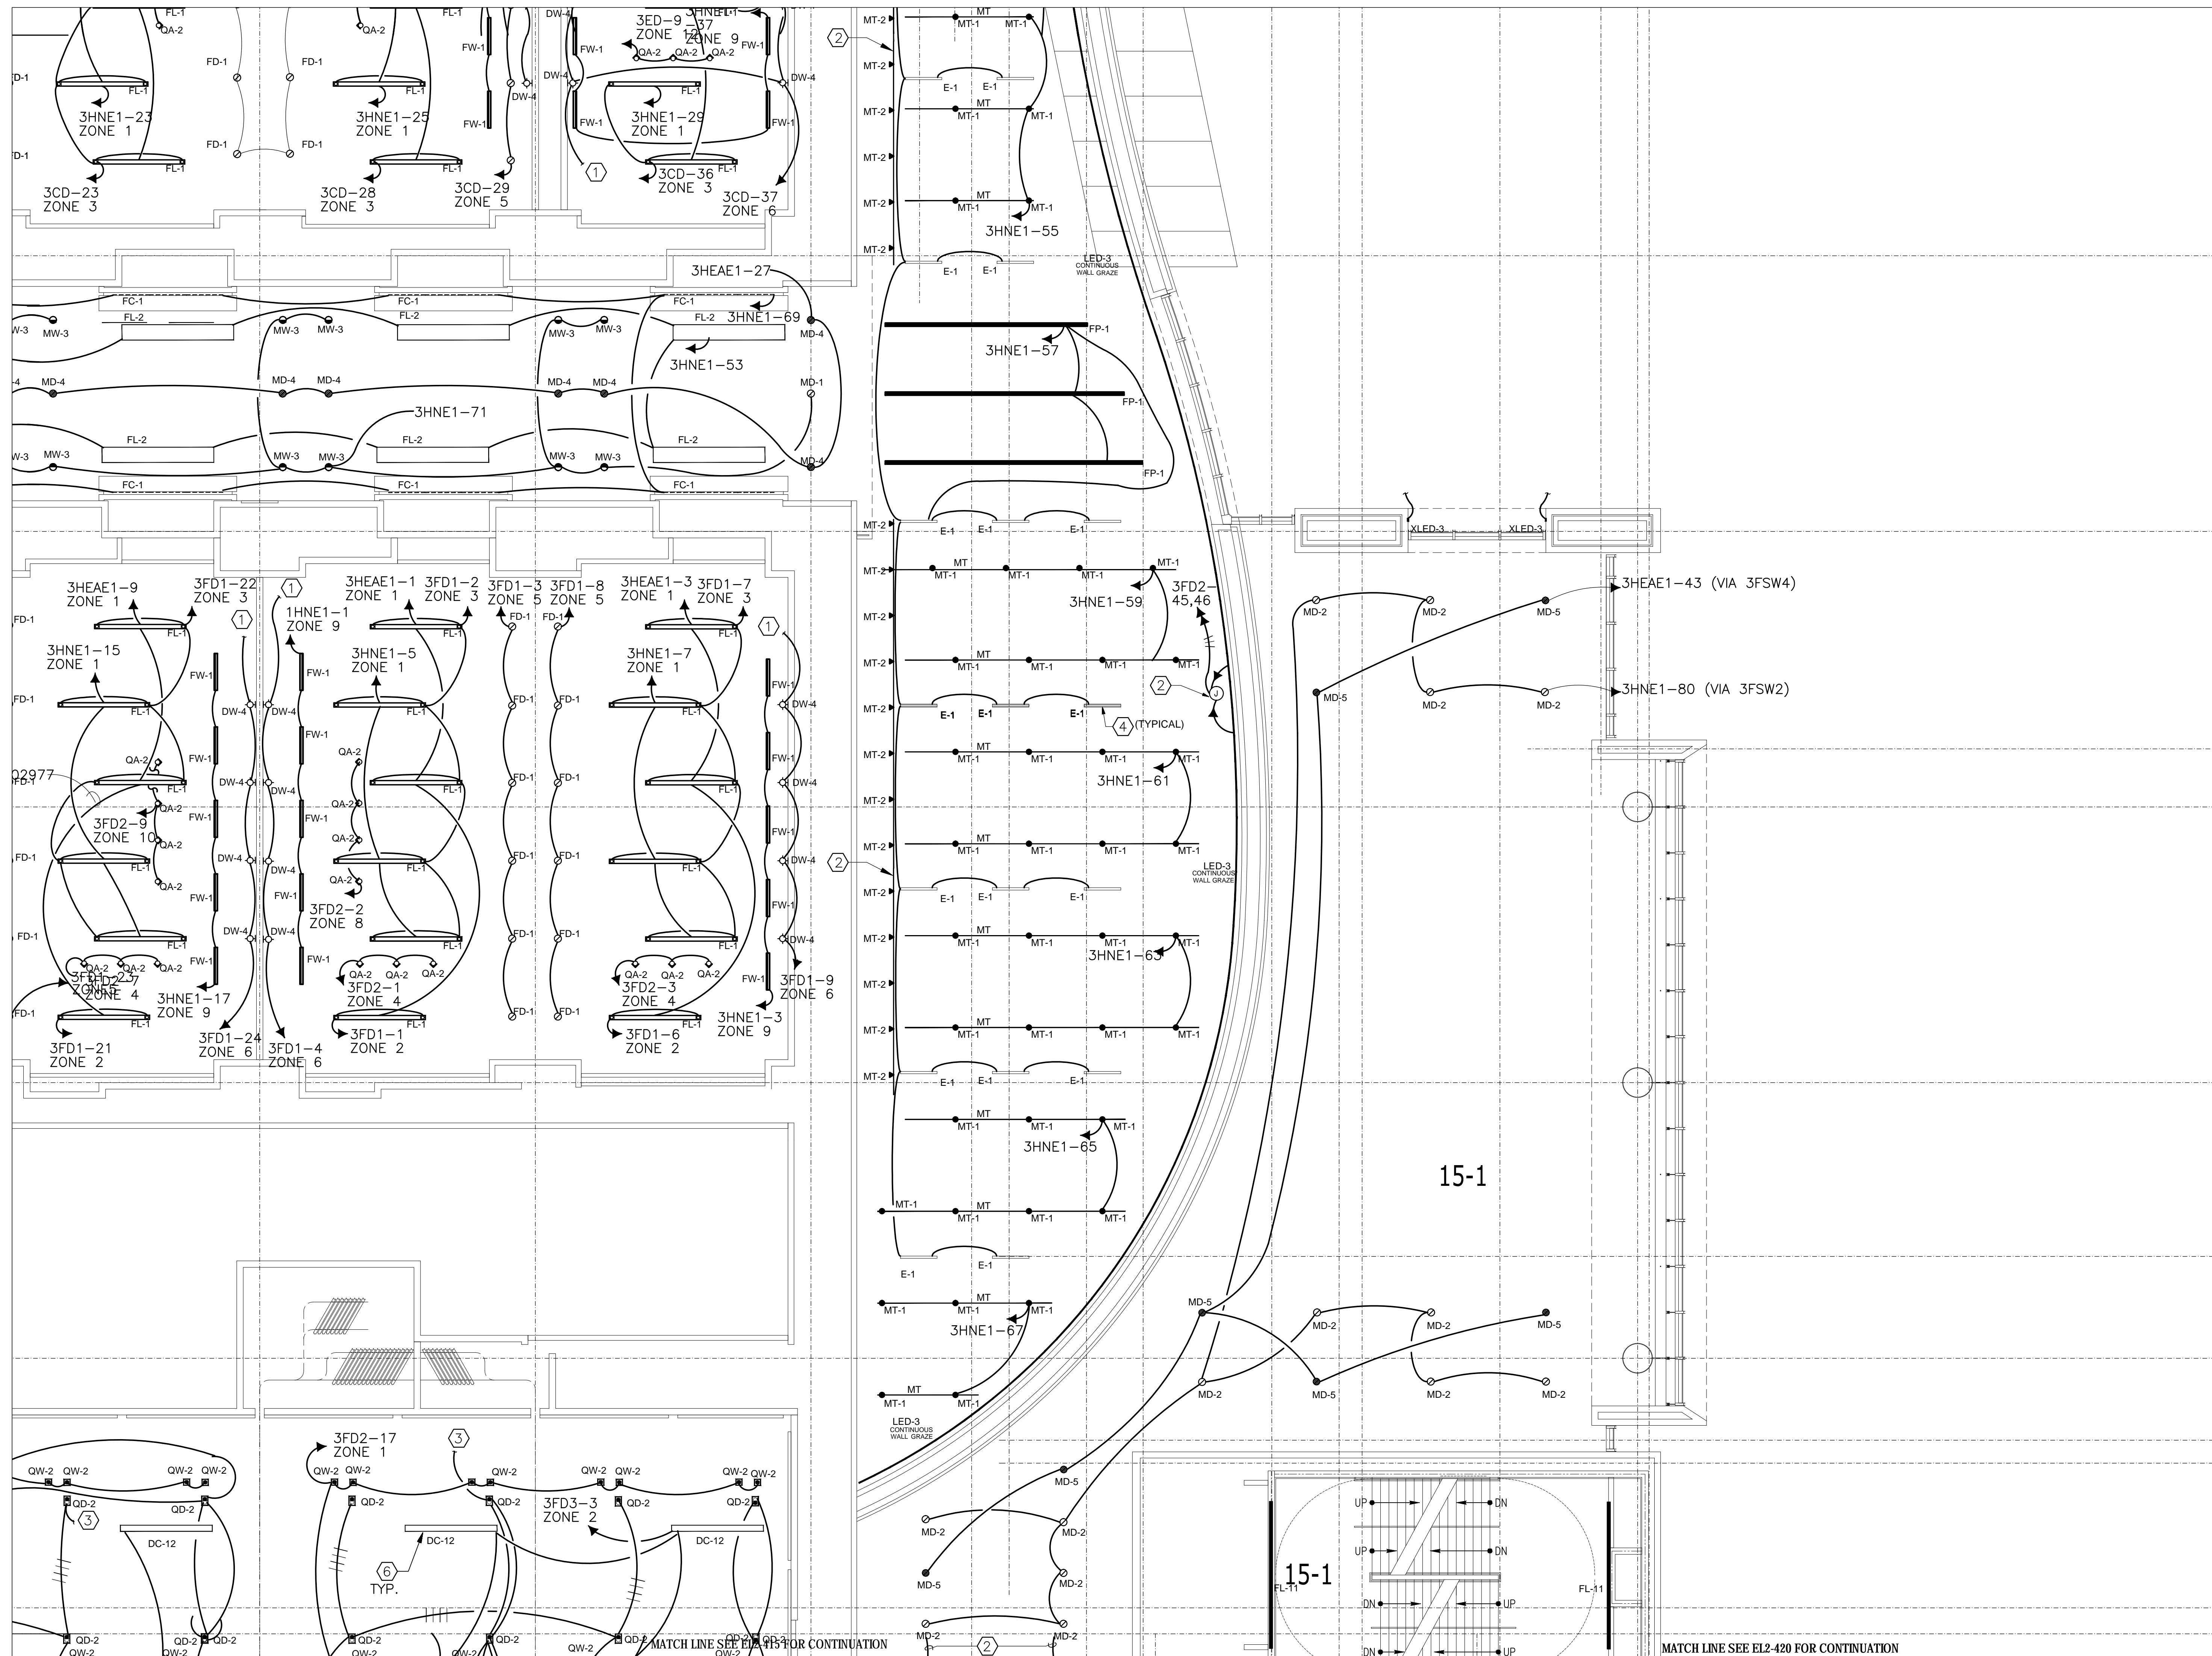




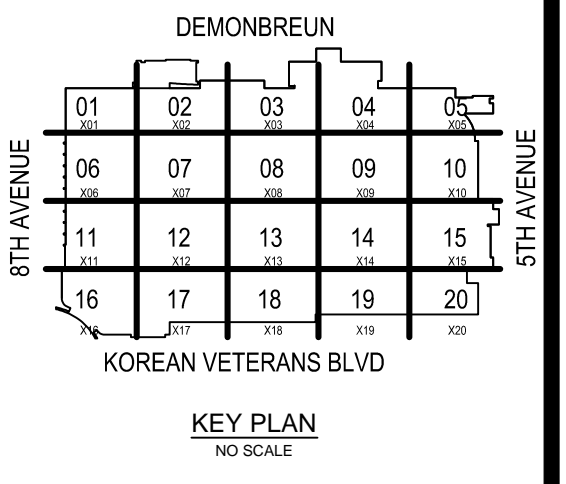

COORDINATION SIGN-OFF

| COMPANY | TRADE | DATE |
|---------|-------|------|
| CONTI   | ELEC. | / /  |
|         |       | / /  |
|         |       | / /  |
|         |       | / /  |
|         |       | / /  |

**Music City Center**  
 Nashville, Tennessee

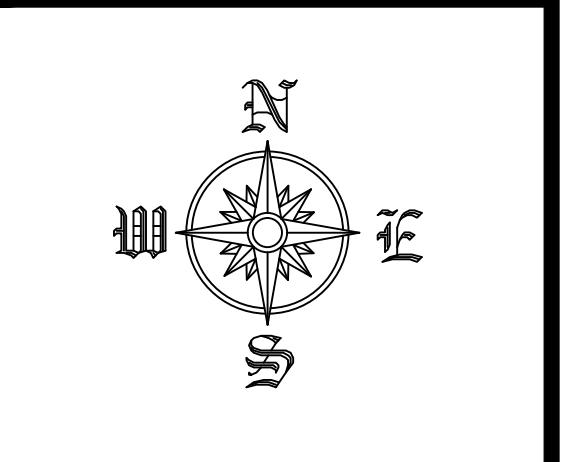

REVISIONS


| NO. | DATE | DESCRIPTION |
|-----|------|-------------|
|     |      |             |
|     |      |             |
**RECORD DRAWINGS STAMP**


CONTI ELECTRIC DATE (Last Update): 2/24/2015 5:06 PM  
 DRAWING FILE NAME: EL2-16  
 CAD OPERATOR: GERTMAN  
 PRINTED BY: FREDMAN, GREG  
 PLOT DATE: 6/4/2015 8:12 AM  
 SUBMITTED BY: G.L.P.  
 ASSIGNED TO:

LEVEL 4 LIGHTING  
 ZONE 16  
 SCALE: 1/8" = 1'-0"

EL2-416

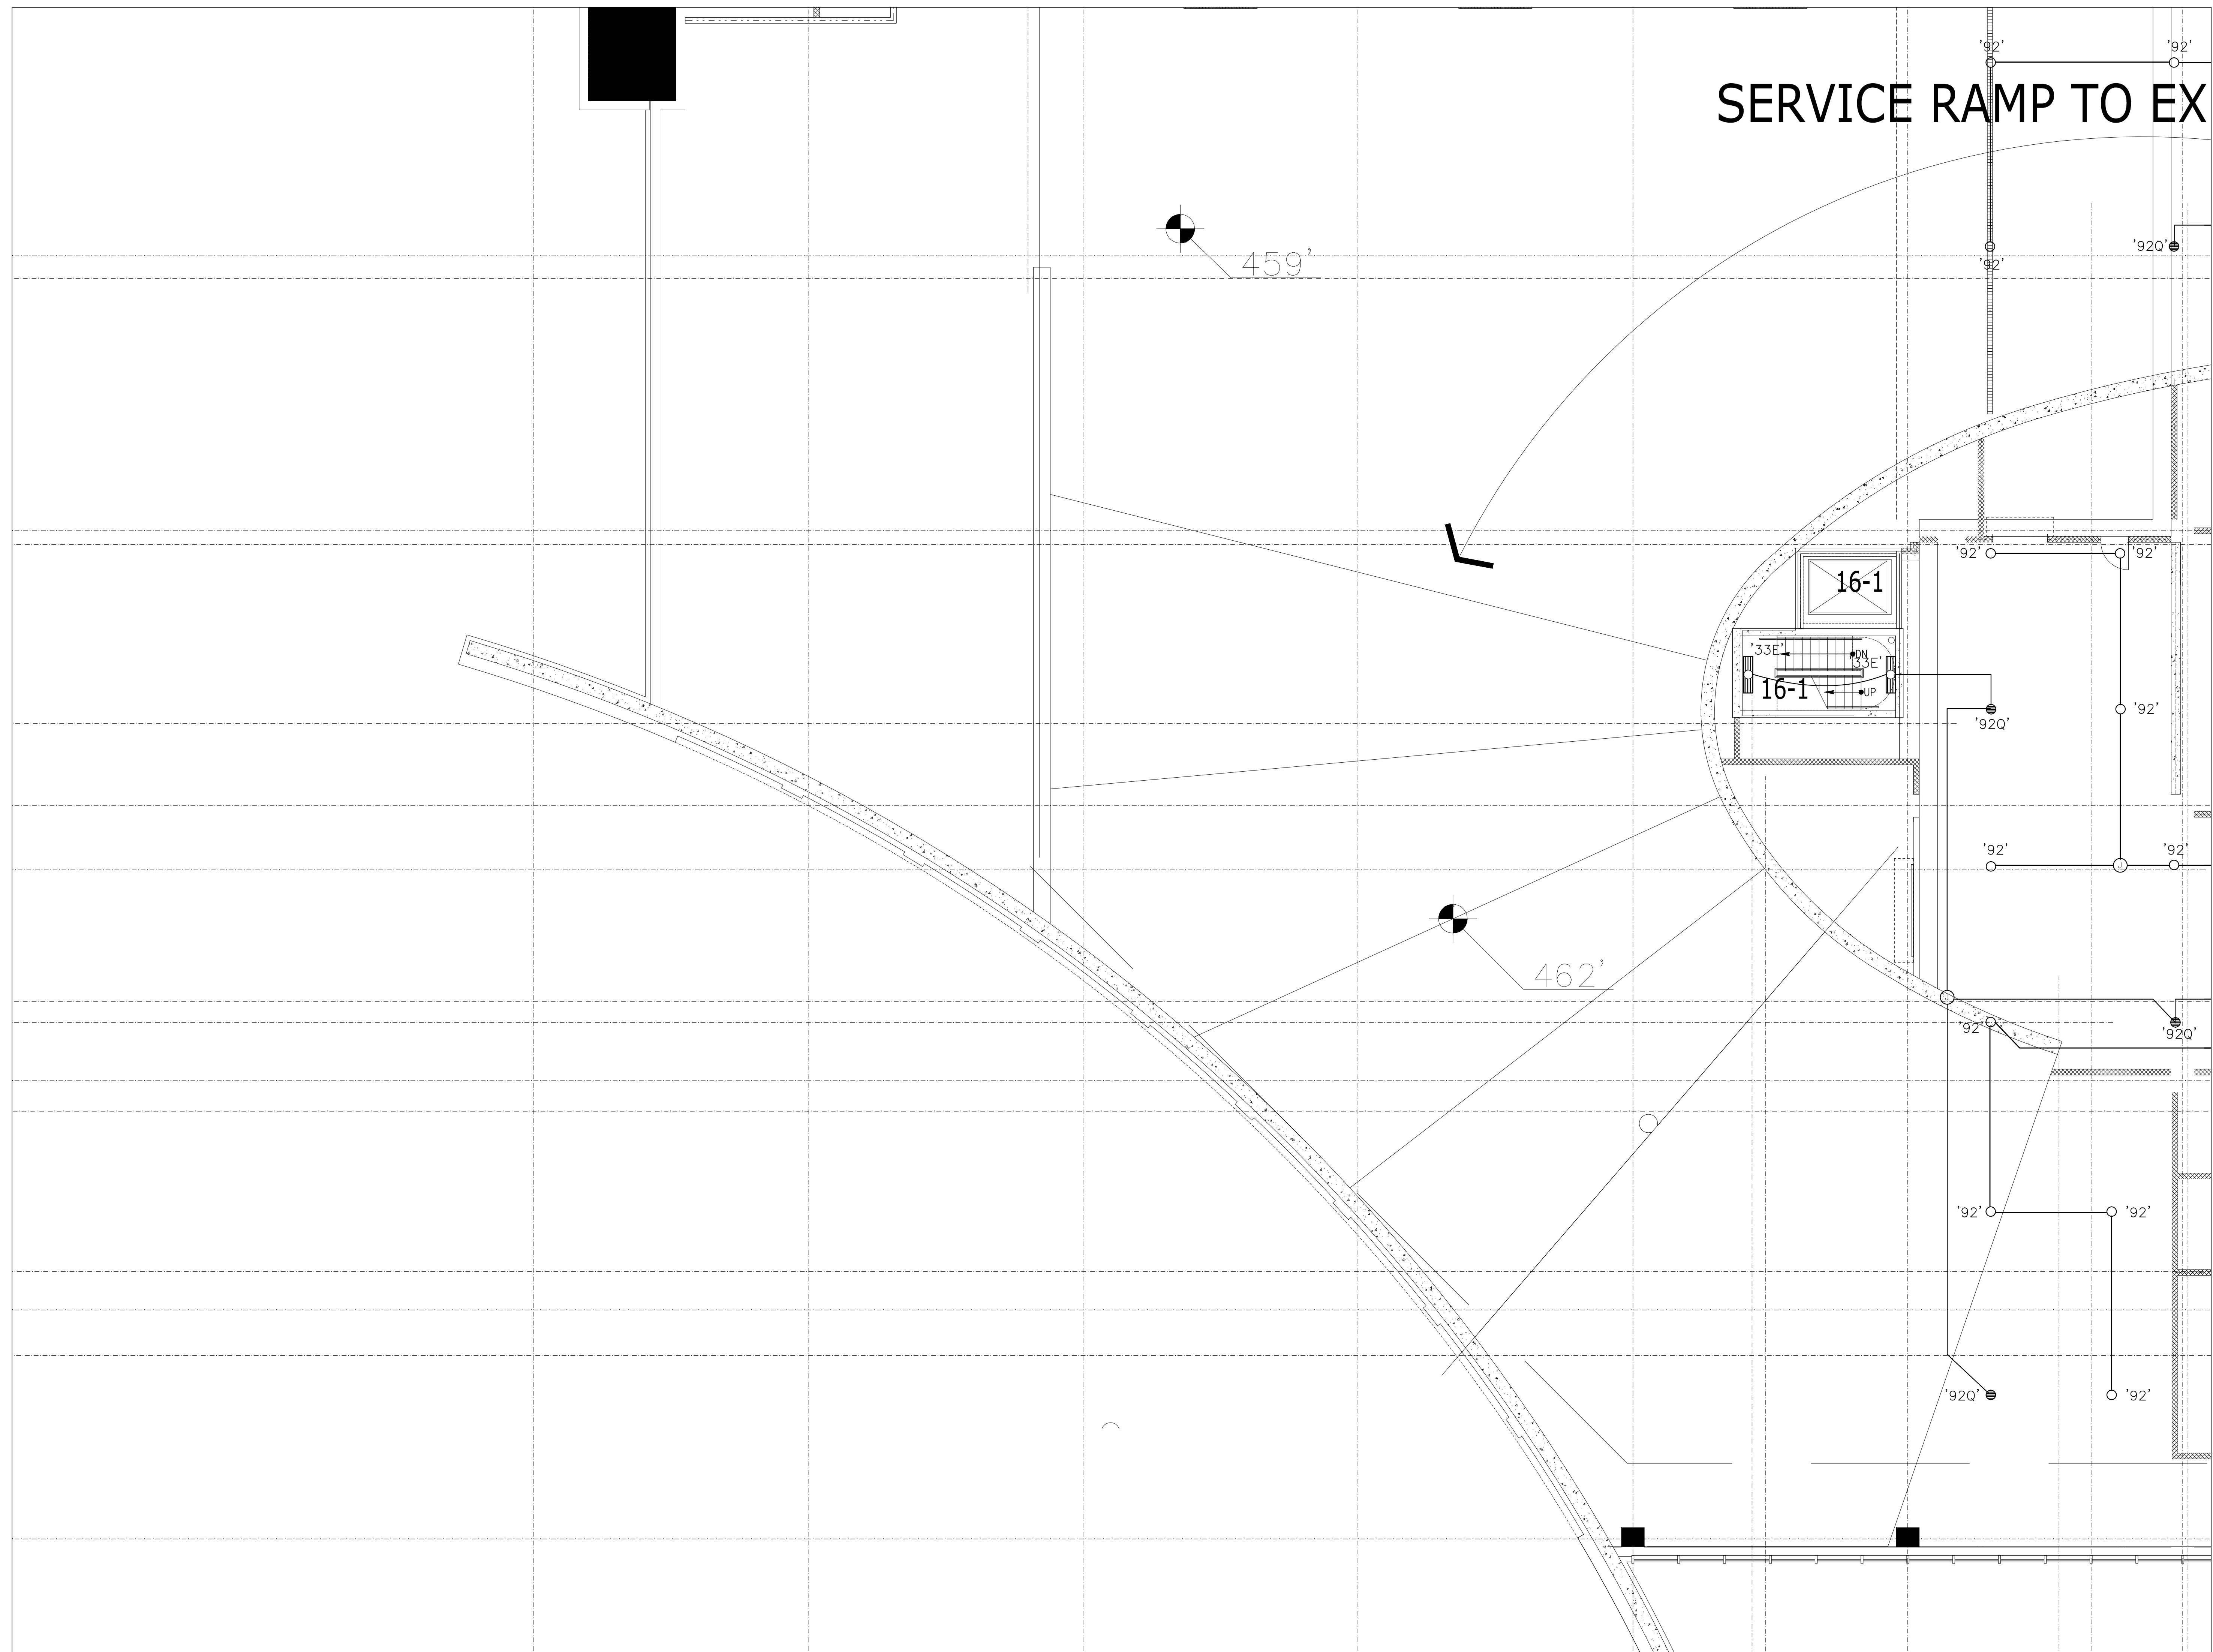




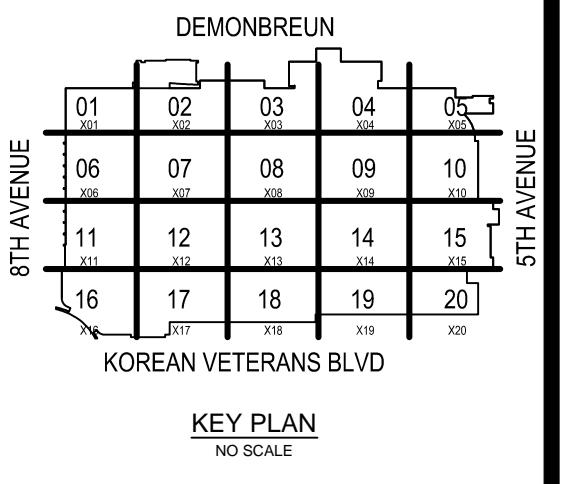

COORDINATION SIGN-OFF

| COMPANY | TRADE | DATE |
|---------|-------|------|
| CONTI   | ELEC. | / /  |
|         |       | / /  |
|         |       | / /  |
**Music City Center**  
 Nashville, Tennessee

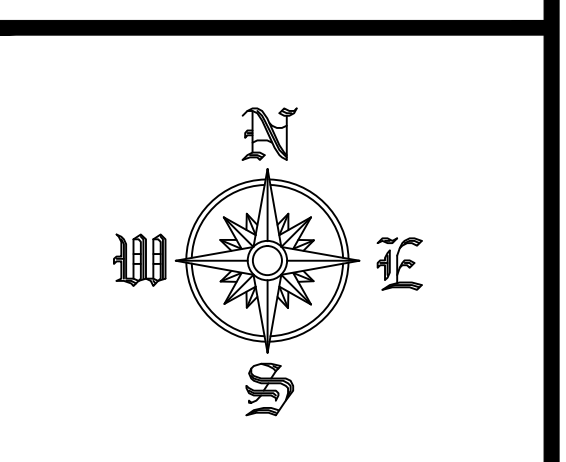

REVISIONS


| NO. | DATE | DESCRIPTION |
|-----|------|-------------|
|     |      |             |
|     |      |             |
|     |      |             |
|     |      |             |

RECORD DRAWINGS STAMP

CONTELECTRIC DATE (Last Update): 2/29/2012 5:06 PM  
 DRAWING FILE NAME: EL2-417  
 CAD OPERATOR: GERTMAN  
 PRINTED BY: FREDMAN, GREG  
 PLOT DATE: 6/4/2012 8:12 AM  
 SUBMITTED BY: G.L.P.  
 ASSIGNED TO:

LEVEL 4 LIGHTING  
 ZONE 17  
 SCALE: 1/8" = 1'-0"

EL2-417

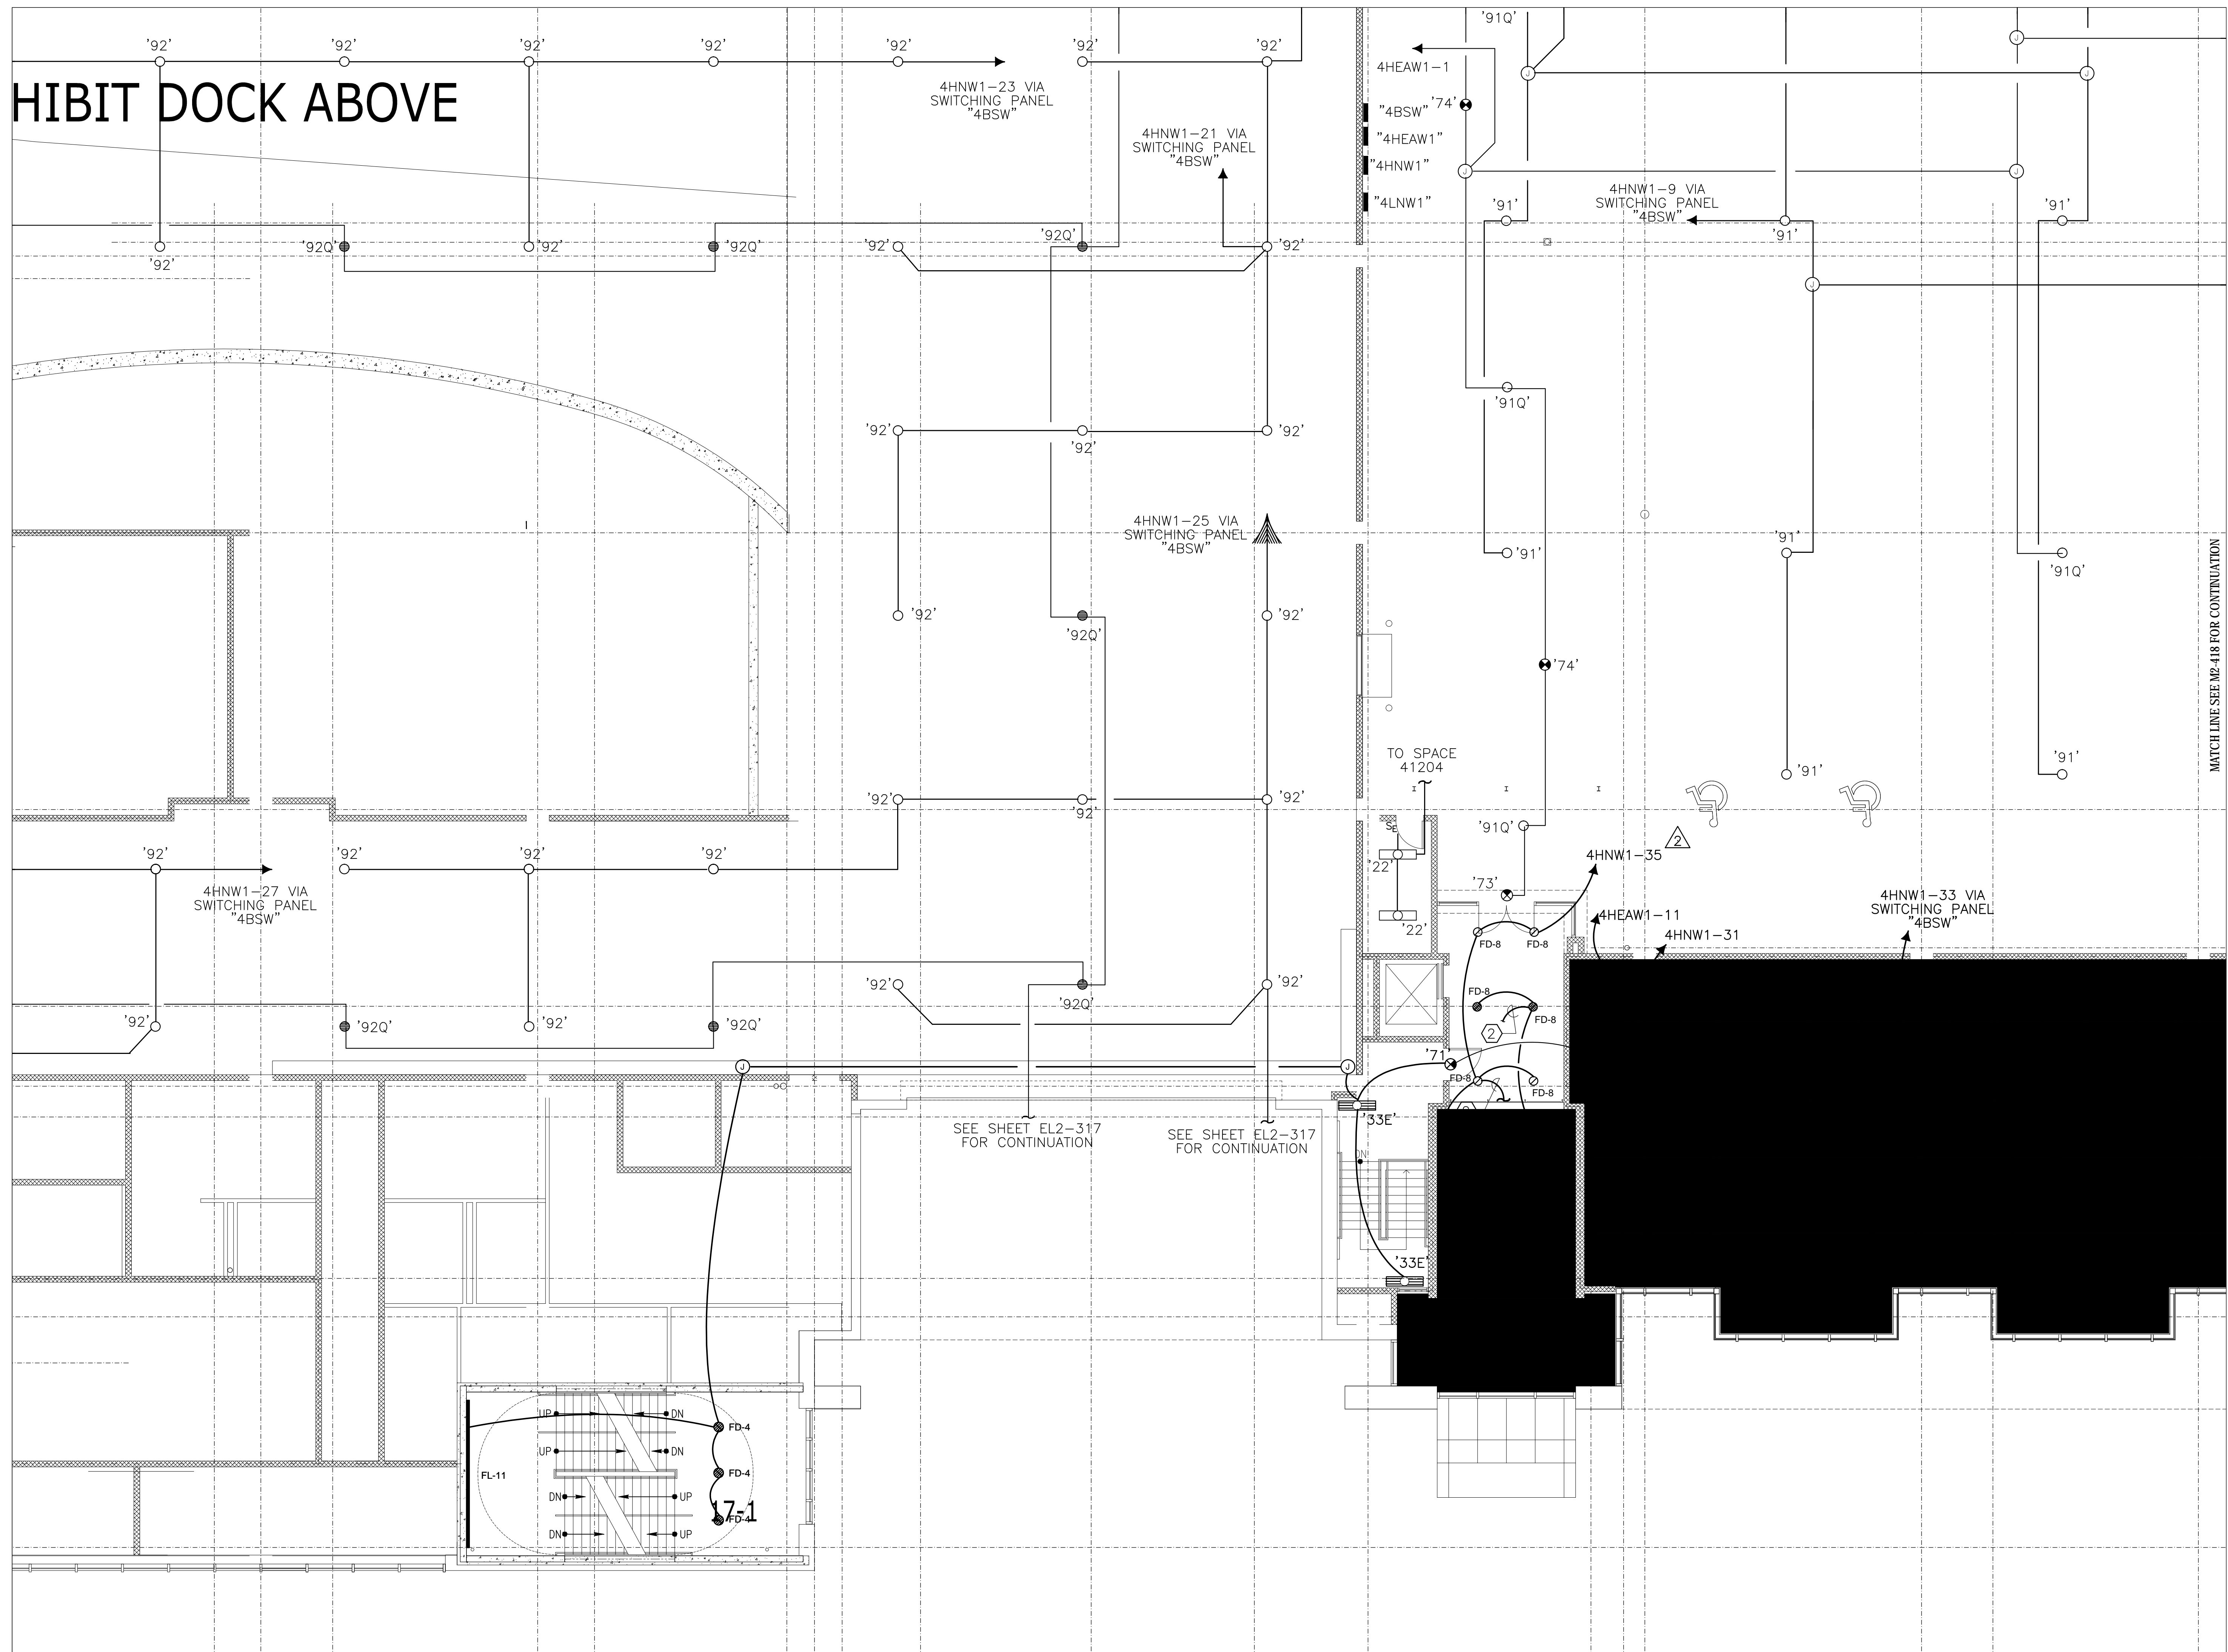











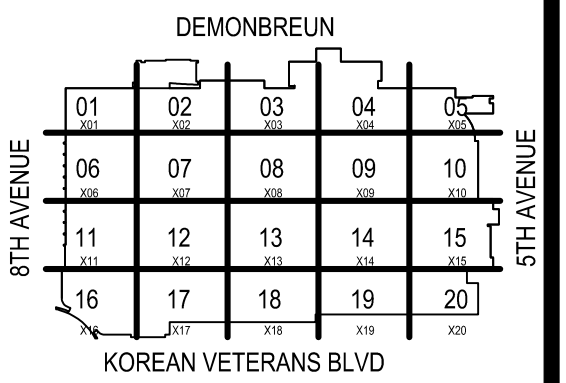

KEY PLAN  
NO SCALE

| COORDINATION SIGN-OFF |       | DATE | DATE | DATE | DATE | DATE |
|-----------------------|-------|------|------|------|------|------|
| COMPANY               | NAME  | /    | /    | /    | /    | /    |
| TRADE                 | ELEC. |      |      |      |      |      |
| CONTI                 |       |      |      |      |      |      |

**Music City Center**  
Nashville, Tennessee

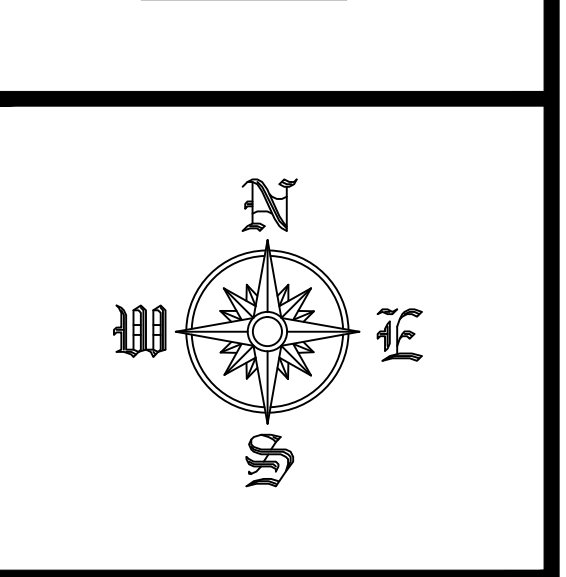


| REVISIONS |      |             |
|-----------|------|-------------|
| NO.       | DATE | DESCRIPTION |
|           |      |             |
|           |      |             |
| RECORD DRAWINGS STAMP              |                   |
|------------------------------------|-------------------|
| CONTI ELECTRIC DATE (Last Update): | 2/24/2015 5:04 PM |
| DRAWING FILE NAME:                 | EL2-420           |
| CAD OPERATOR:                      | GERMAN            |
| PRINTED BY:                        | FREDMAN, GREG     |
| PLOT DATE:                         | 6/4/2012 8:12 AM  |
| SUBMITTED BY:                      | ELF               |
| ASSIGNED TO:                       |                   |

LEVEL 4 LIGHTING  
 ZONE 20  
 SCALE: 1/8" = 1'-0"

EL2-420

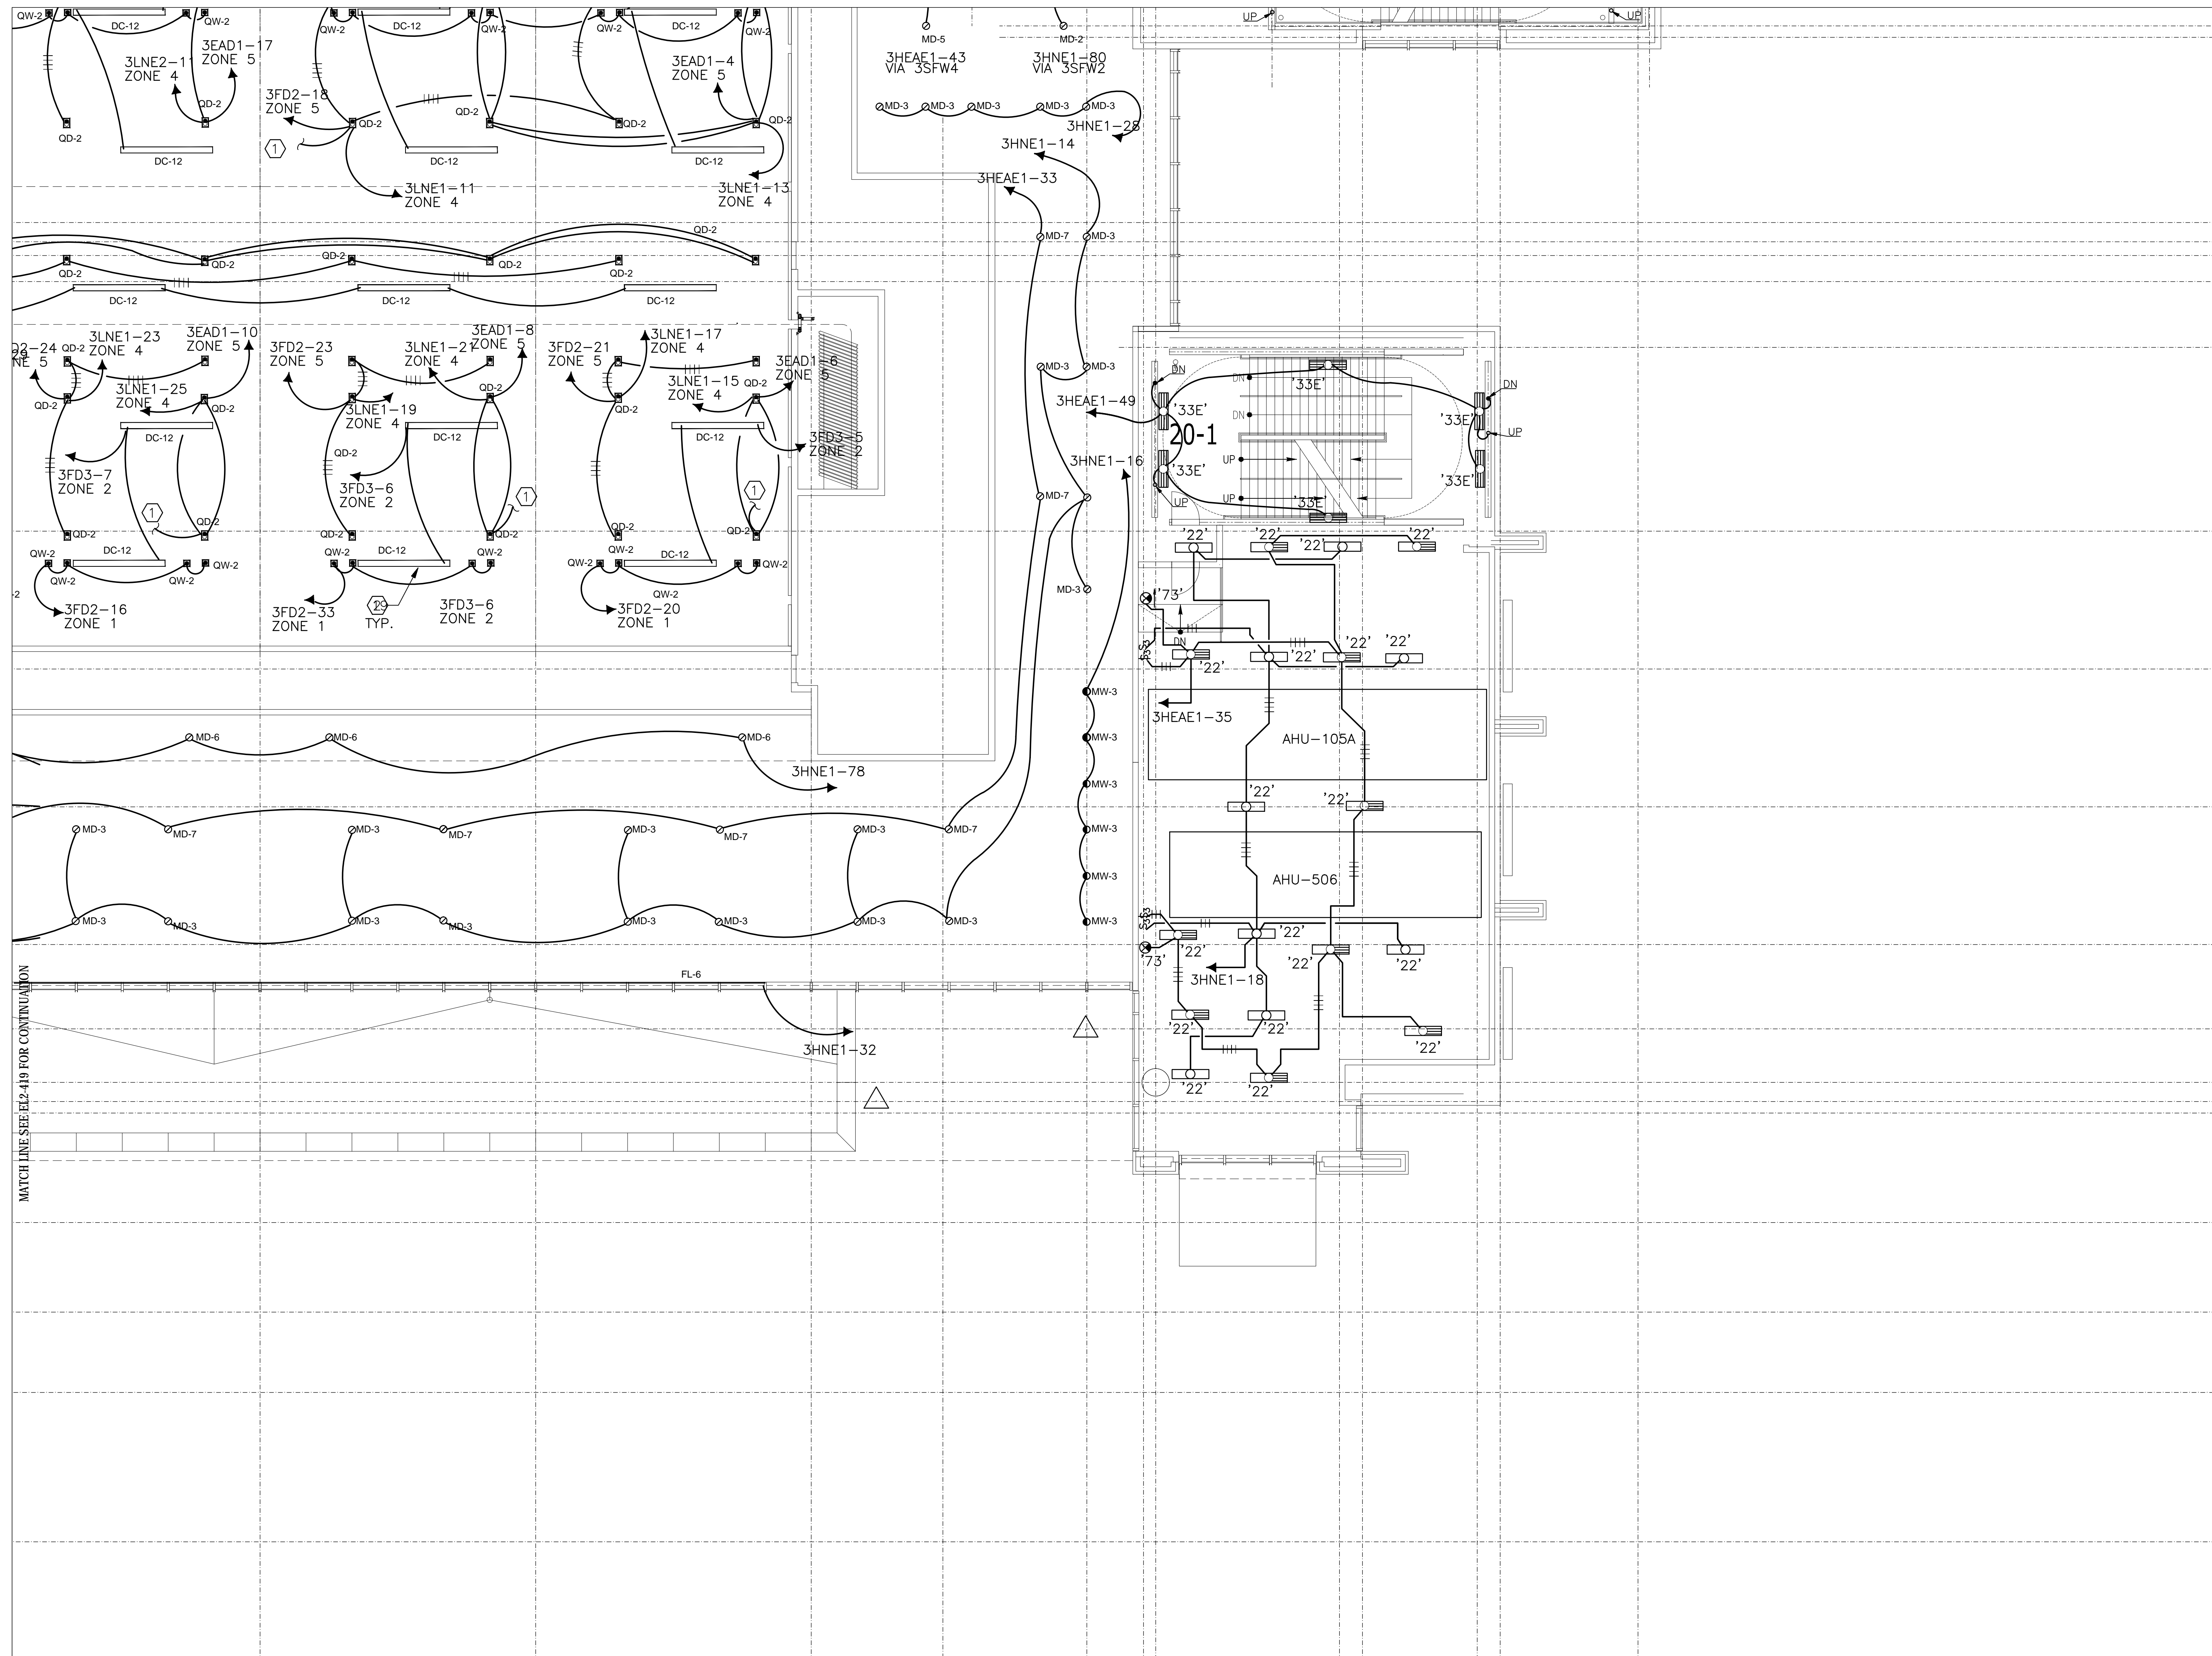

MATCH LINE SEE EL2-418 FOR CONTINUATION

FILE PATH FOR CAD OPERATOR USE ONLY: C:\Users\Conti\Documents\Projects\Music City Center\As-Built\4-EL2-420\Level 4 Lighting\Zone 20 Lighting.dwg