


COORDINATION SIGN-OFF

| COMPANY | TRADE | DATE |
|---------|-------|------|
| CONTI | ELEC. | /// |
| | | /// |
| | | /// |
Music City Center
 Nashville, Tennessee

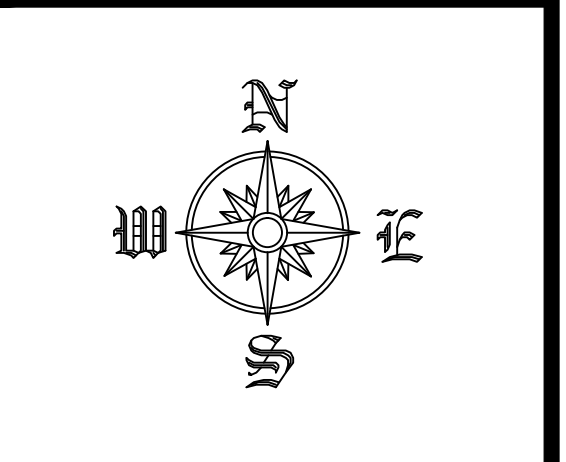

REVISIONS


| NO. | DATE | DESCRIPTION |
|-----|------|-------------|
| | | |
| | | |
RECORD DRAWINGS STAMP


CONTI ELECTRIC DATE (Last Update): 2/28/2012 8:00 AM
 DRAWING FILE NAME: EL2-501
 CAD OPERATOR: GERTMAN
 PRINTED BY: FRYMAN, GREGG
 PLOT DATE: 6/4/2012 8:02 AM
 SUBMITTED BY: GUY
 ASSIGNED TO:

LEVEL 5 LIGHTING
 ZONE 1
 SCALE: 1/8" = 1'-0"

EL2-501

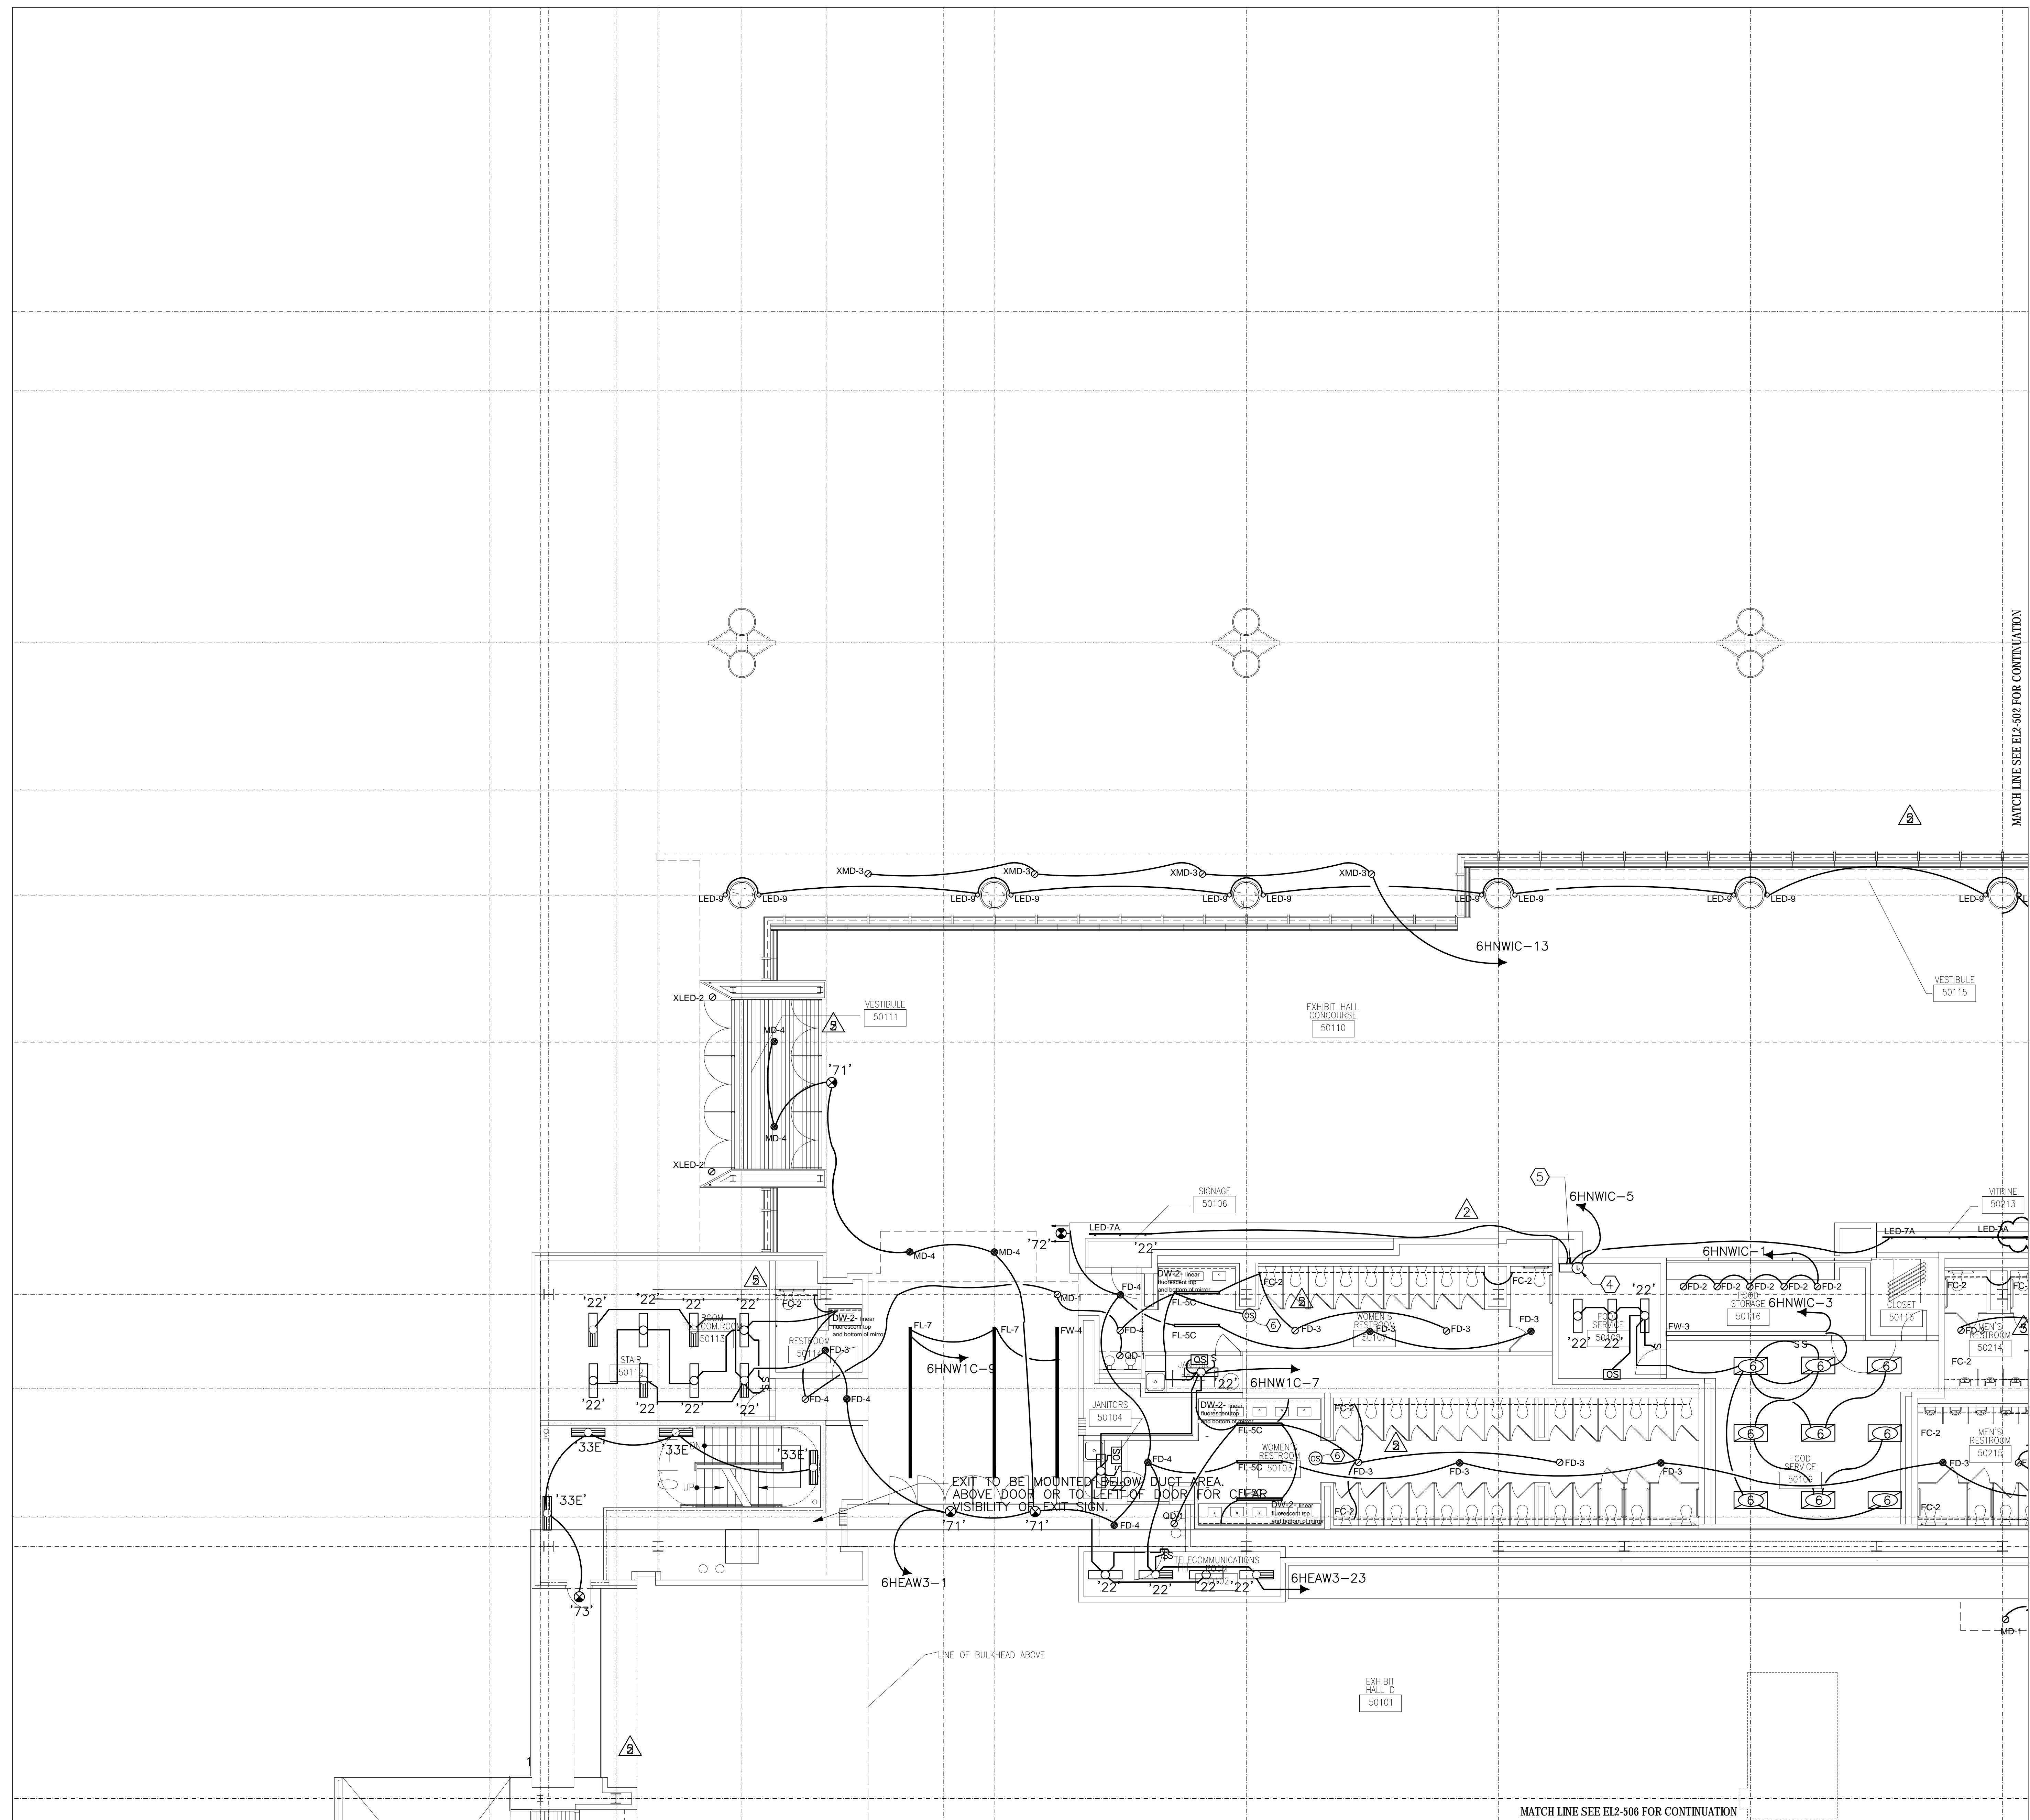


FILE PATH: P:\CD\SPRINT\USE ONLY - E:\3085\Conti\Bldg\Nashville\MC\Level 5 - Exhibit Hall D\EL2\Zone 1 Lighting\Zone 1 Lighting.dwg

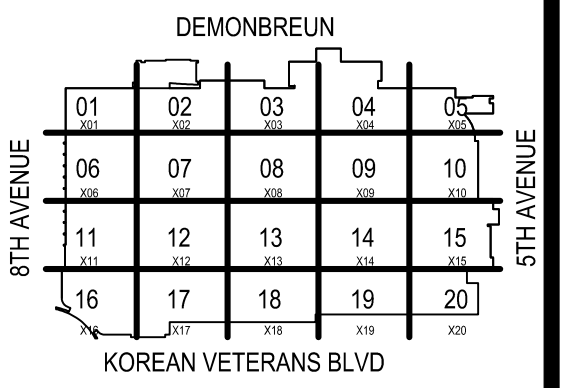

| COORDINATION SIGN-OFF | | DATE | NAME | TRADE | COMPANY |
|-----------------------|--|------|------|-------|---------|
| | | / / | | ELEC. | CONTI |
| | | / / | | | |
| | | / / | | | |
| | | / / | | | |
| | | / / | | | |

Music City Center
Nashville, Tennessee

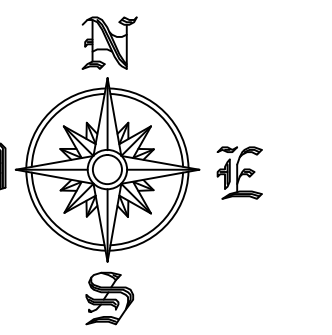


| REVISIONS | | |
|-----------|------|-------------|
| NO. | DATE | DESCRIPTION |
| | | |
| | | |
| | | |
| | | |


| RECORD DRAWINGS STAMP | |
|------------------------------------|-------------------|
| CONTI ELECTRIC DATE (Last Update): | 2/28/2013 8:00 AM |
| DRAWING FILE NAME: | EL2-502 |
| CAD OPERATOR: | SEYMOUR |
| PRINTED BY: | FRYMAN, GREG |
| PLOT DATE: | 6/4/2013 8:02 AM |
| SUBMITTED BY: | ELF |
| ASSIGNED TO: | |

LEVEL 5 LIGHTING
 ZONE 2
 SCALE: 1/8" = 1'-0"

EL2-502

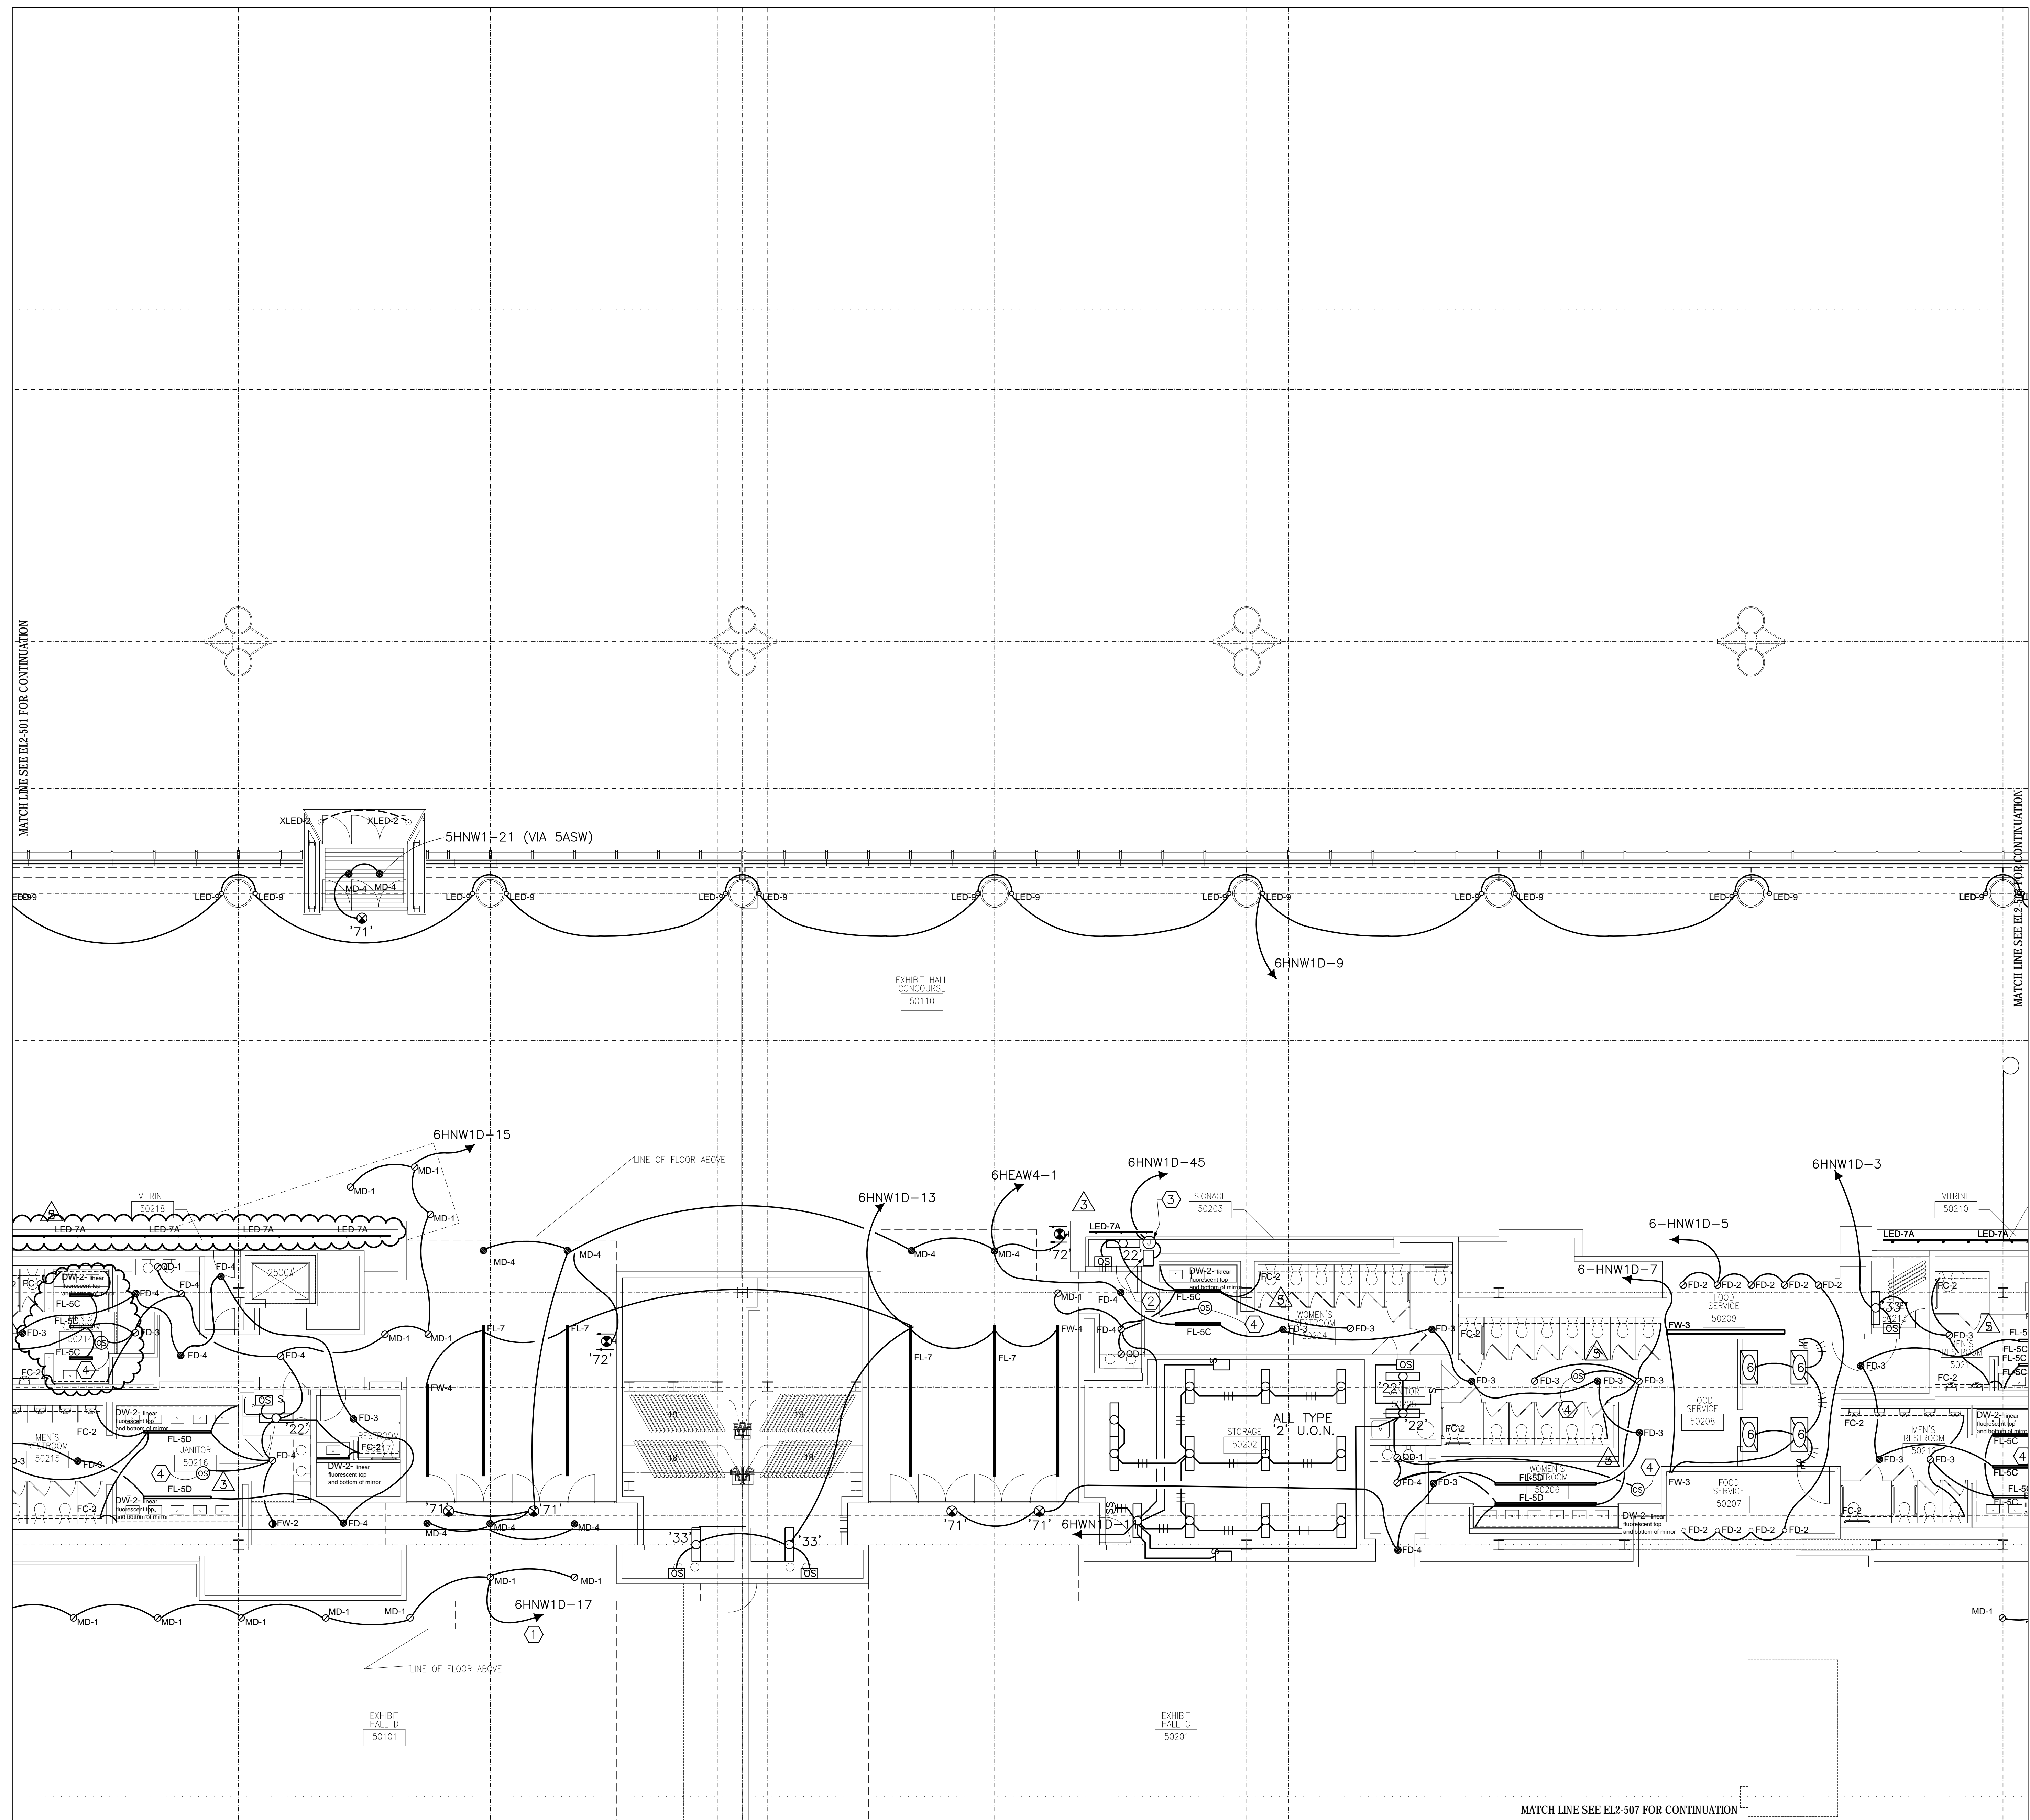


FILE PATH: P:\CD\SPRINT\EL2-502\EL2-502.dwg DATE: 6/4/2013 8:02 AM USER: GREG.FRYMAN

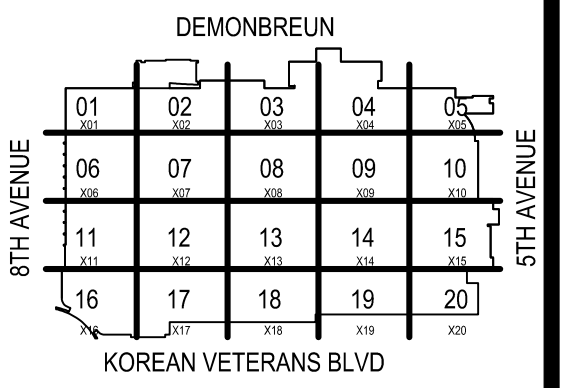

COORDINATION SIGN-OFF

| COMPANY | TRADE | DATE |
|---------|-------|------|
| CONTI | ELEC. | /// |
| | | /// |
| | | /// |
Music City Center
 Nashville, Tennessee

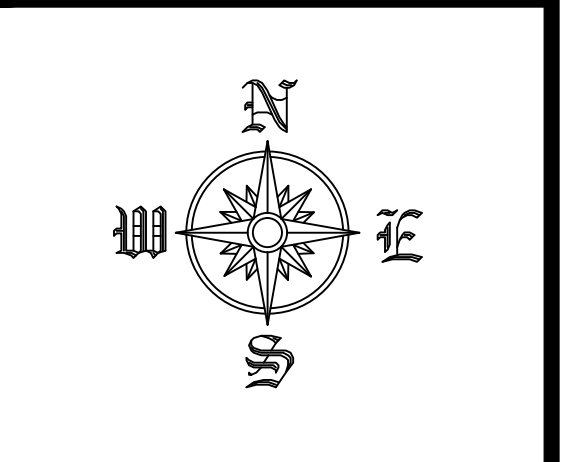

REVISIONS


| NO. | DATE | DESCRIPTION |
|-----|------|-------------|
| | | |
| | | |
| | | |
| | | |

RECORD DRAWINGS STAMP


CONTELECTRIC DATE (Last Update):
 2/28/2019 8:00 AM
 DRAWING FILE NAME:
 EL2-503
 CAD OPERATOR:
 GERTMAN
 PRINTED BY:
 FRYMAN, GREGG
 PLOT DATE:
 6/4/2019 8:02 AM
 SUBMITTED BY:
 G.P.F.
 ASSIGNED TO:

LEVEL 5 LIGHTING
 ZONE 3
 SCALE: 1/8" = 1'-0"

EL2-503

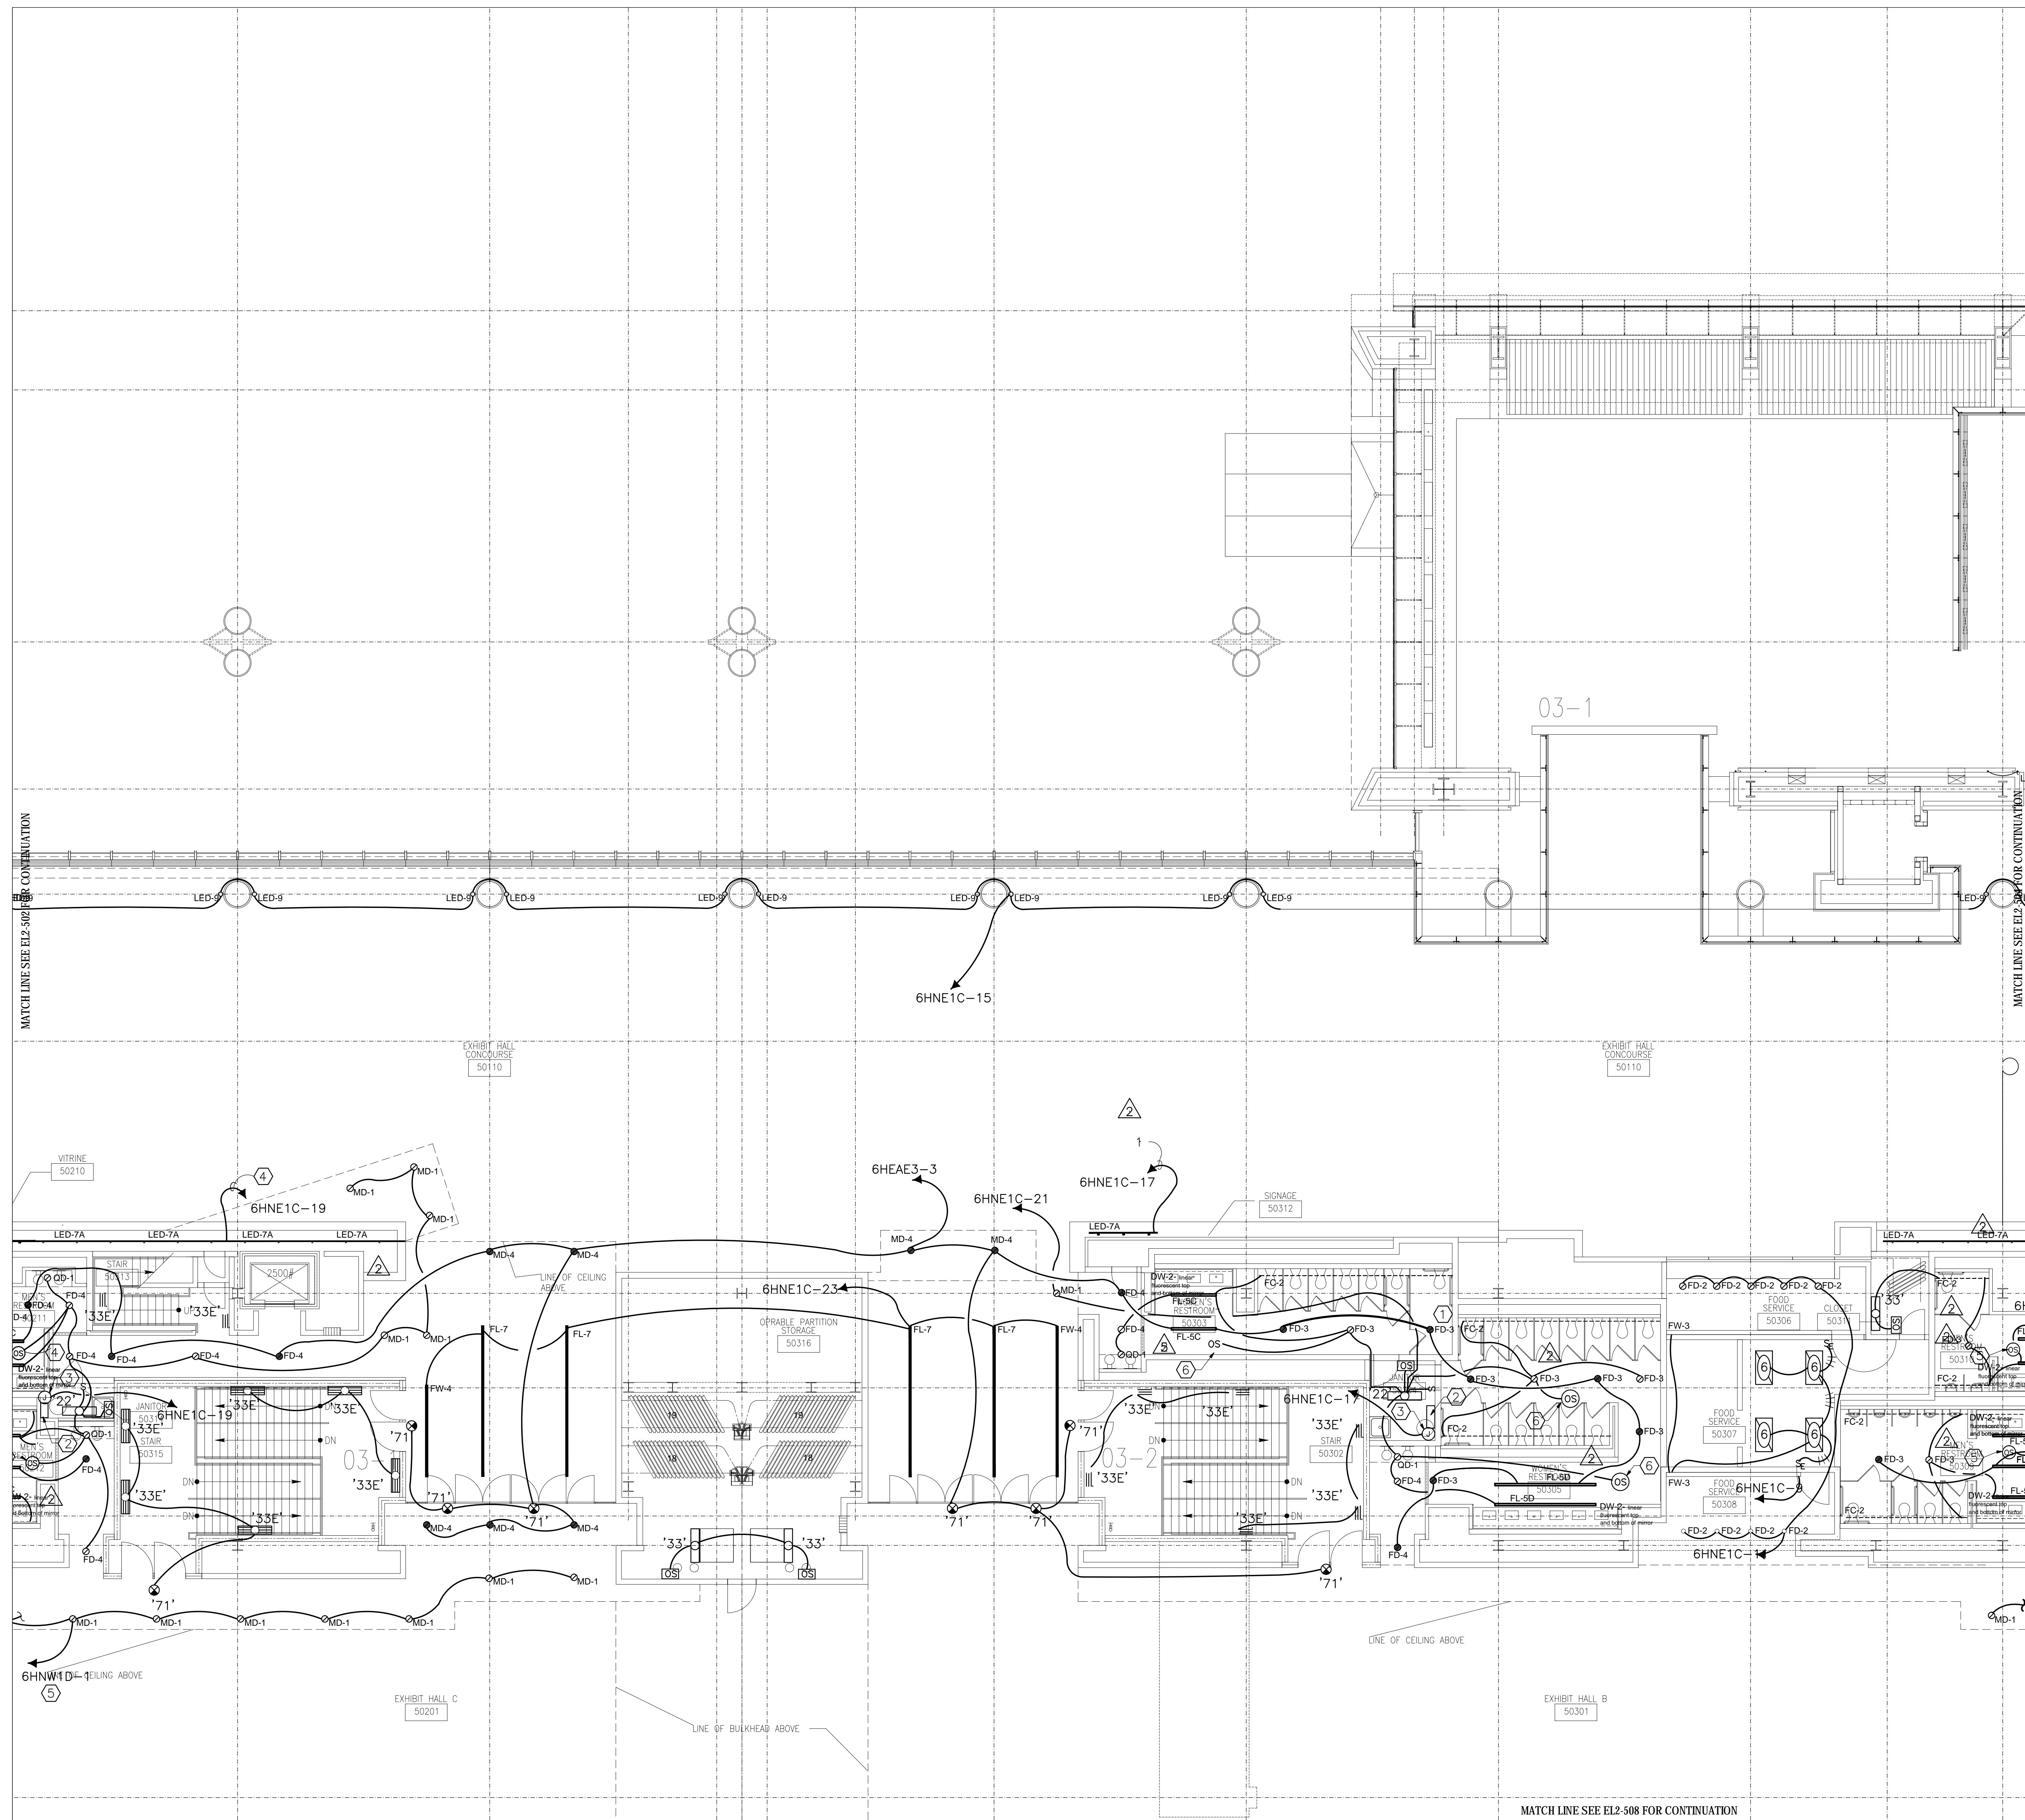


FILE PATH FOR CAD OPERATOR USE ONLY: P:\3085\Conti\Bldg\Nashville\MC2\Level 5 Lighting\Zone 3 Lighting\Zone 3 Lighting.dwg

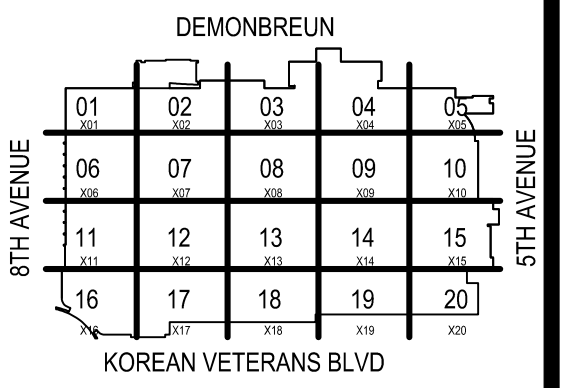

COORDINATION SIGN-OFF

| COMPANY | TRADE | DATE |
|---------|-------|------|
| CONTI | ELEC. | / / |
| | | / / |
| | | / / |
Music City Center
 Nashville, Tennessee

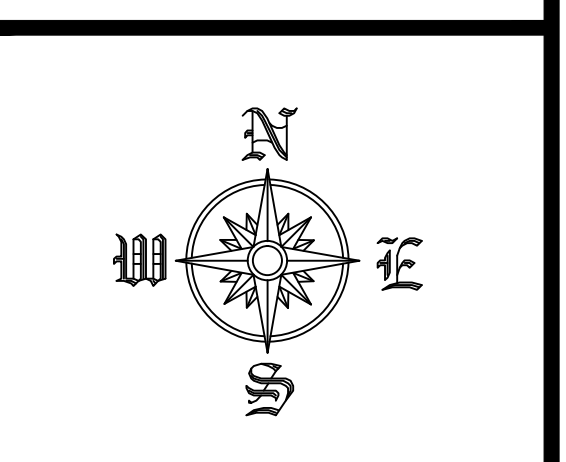

REVISIONS

| NO. | DATE | DESCRIPTION |
|-----|------|-------------|
| | | |
| | | |
| | | |
| | | |

RECORD DRAWINGS STAMP

CONTI ELECTRIC DATE (Last Update):
 2/28/2019 8:00 AM

DRAWING FILE NAME:
 EL2-504

CAD OPERATOR:
 GERTMAN

PRINTED BY:
 FRYMAN, GREGG


PLOT DATE:
 6/4/2019 8:04 AM

SUBMITTED BY:
 G.P.

ASSIGNED TO:

LEVEL 5 LIGHTING
 ZONE 4
 SCALE: 1/8" = 1'-0"

EL2-504

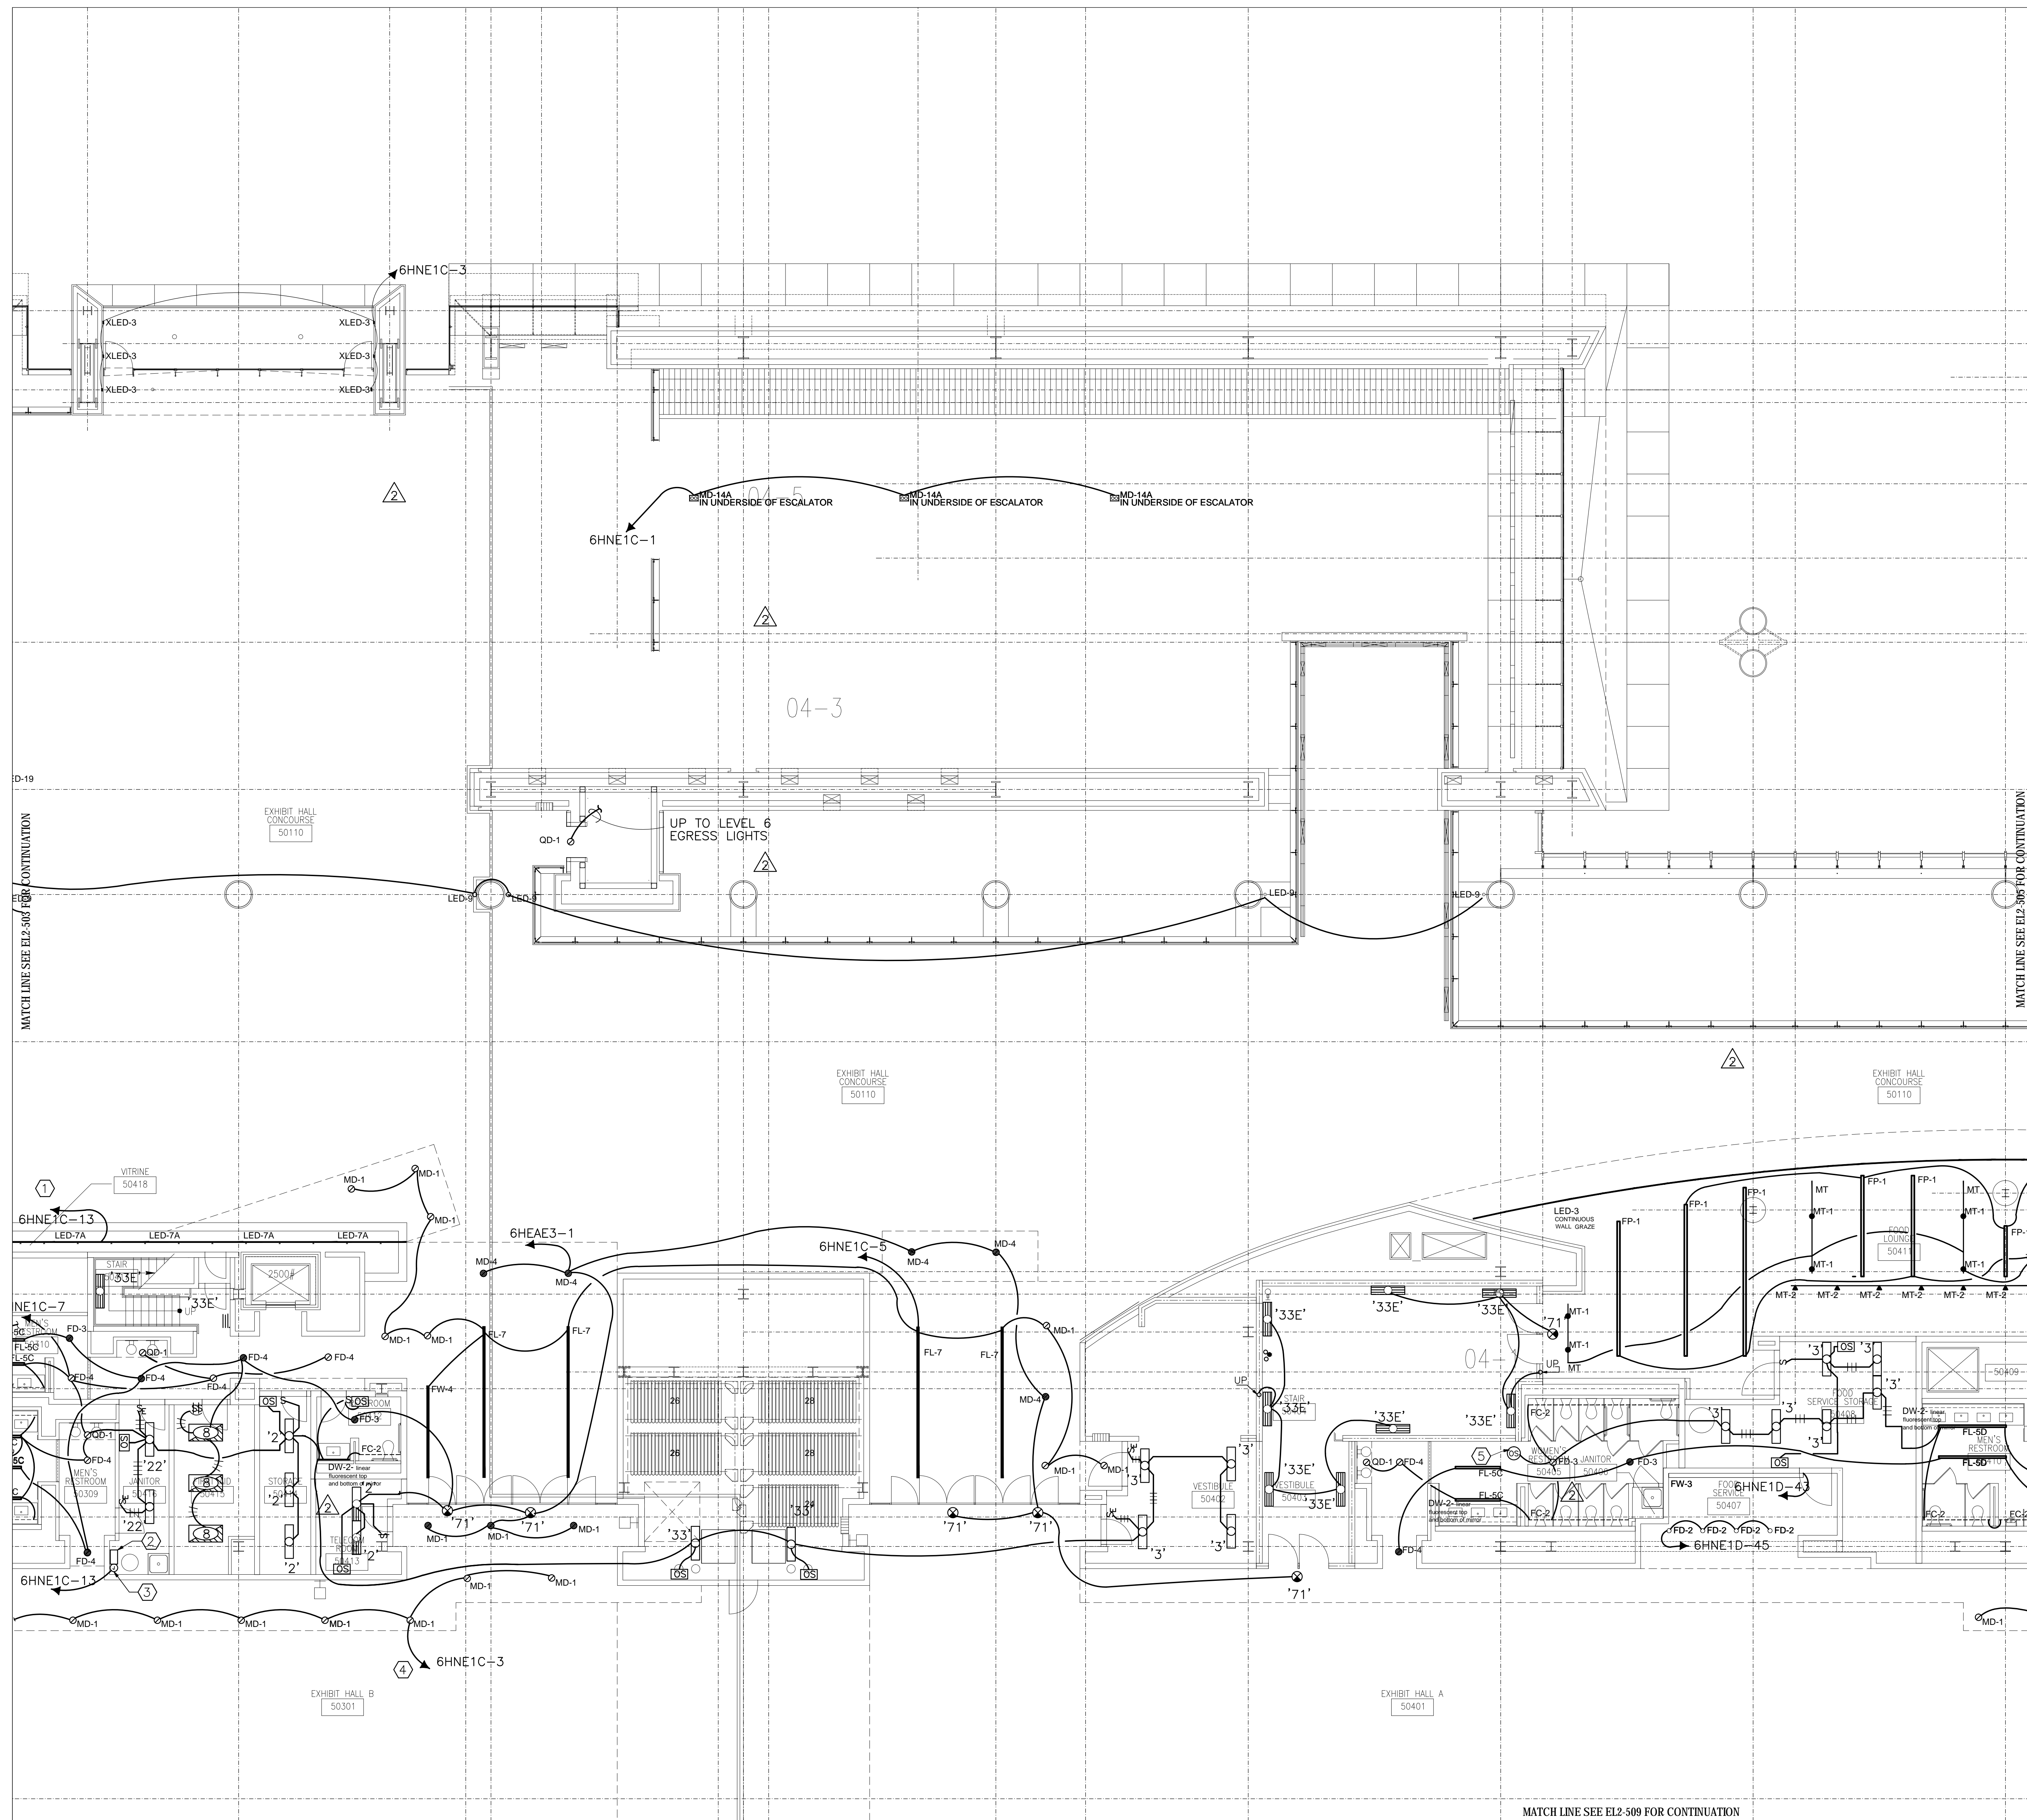


MATCH LINE SEE EL2-503 FOR CONTINUATION

MATCH LINE SEE EL2-505 FOR CONTINUATION

MATCH LINE SEE EL2-509 FOR CONTINUATION


FILE PATH FOR CAD DEPARTMENT USE ONLY: P:\3085\Conti\Bldg\Exhibit\Zone4\Level 5 Lighting\Zone4 For Opening

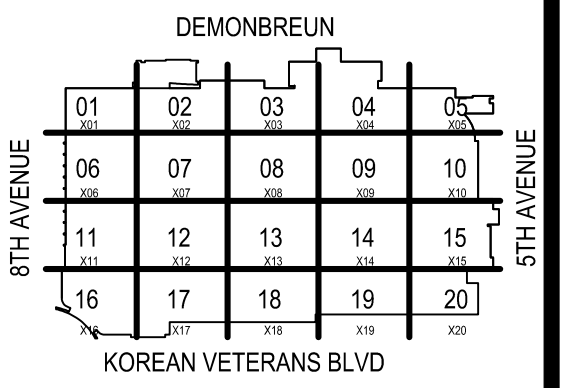

COORDINATION SIGN-OFF

| COMPANY | TRADE | DATE |
|---------|-------|------|
| CONTI | ELEC. | /// |
| | | /// |
| | | /// |
Music City Center
 Nashville, Tennessee

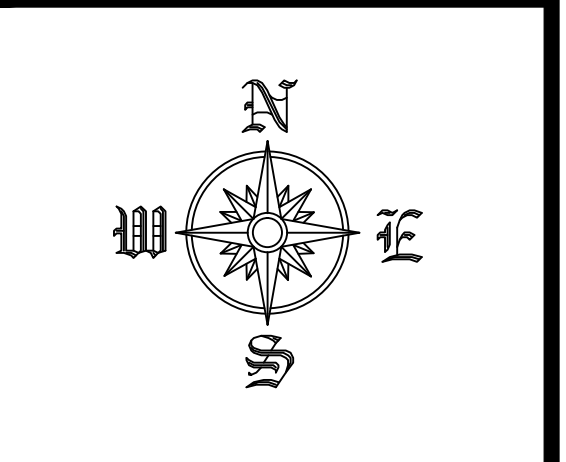

REVISIONS


| NO. | DATE | DESCRIPTION |
|-----|------|-------------|
| | | |
| | | |
| | | |
| | | |

RECORD DRAWINGS STAMP

CONTI ELECTRIC DATE (Last Update): 2/23/2012 8:00 AM
 DRAWING FILE NAME: EL2-505
 DATE: 6/2/12
 CAD OPERATOR: GERTMAN
 PRINTED BY: FREDMAN, GREG
 PLOT DATE: 6/4/2012 8:04 AM
 SUBMITTED BY: G.P.F.
 ASSIGNED TO:


LEVEL 5 LIGHTING
 ZONE 5
 SCALE: 1/8" = 1'-0"

EL2-505

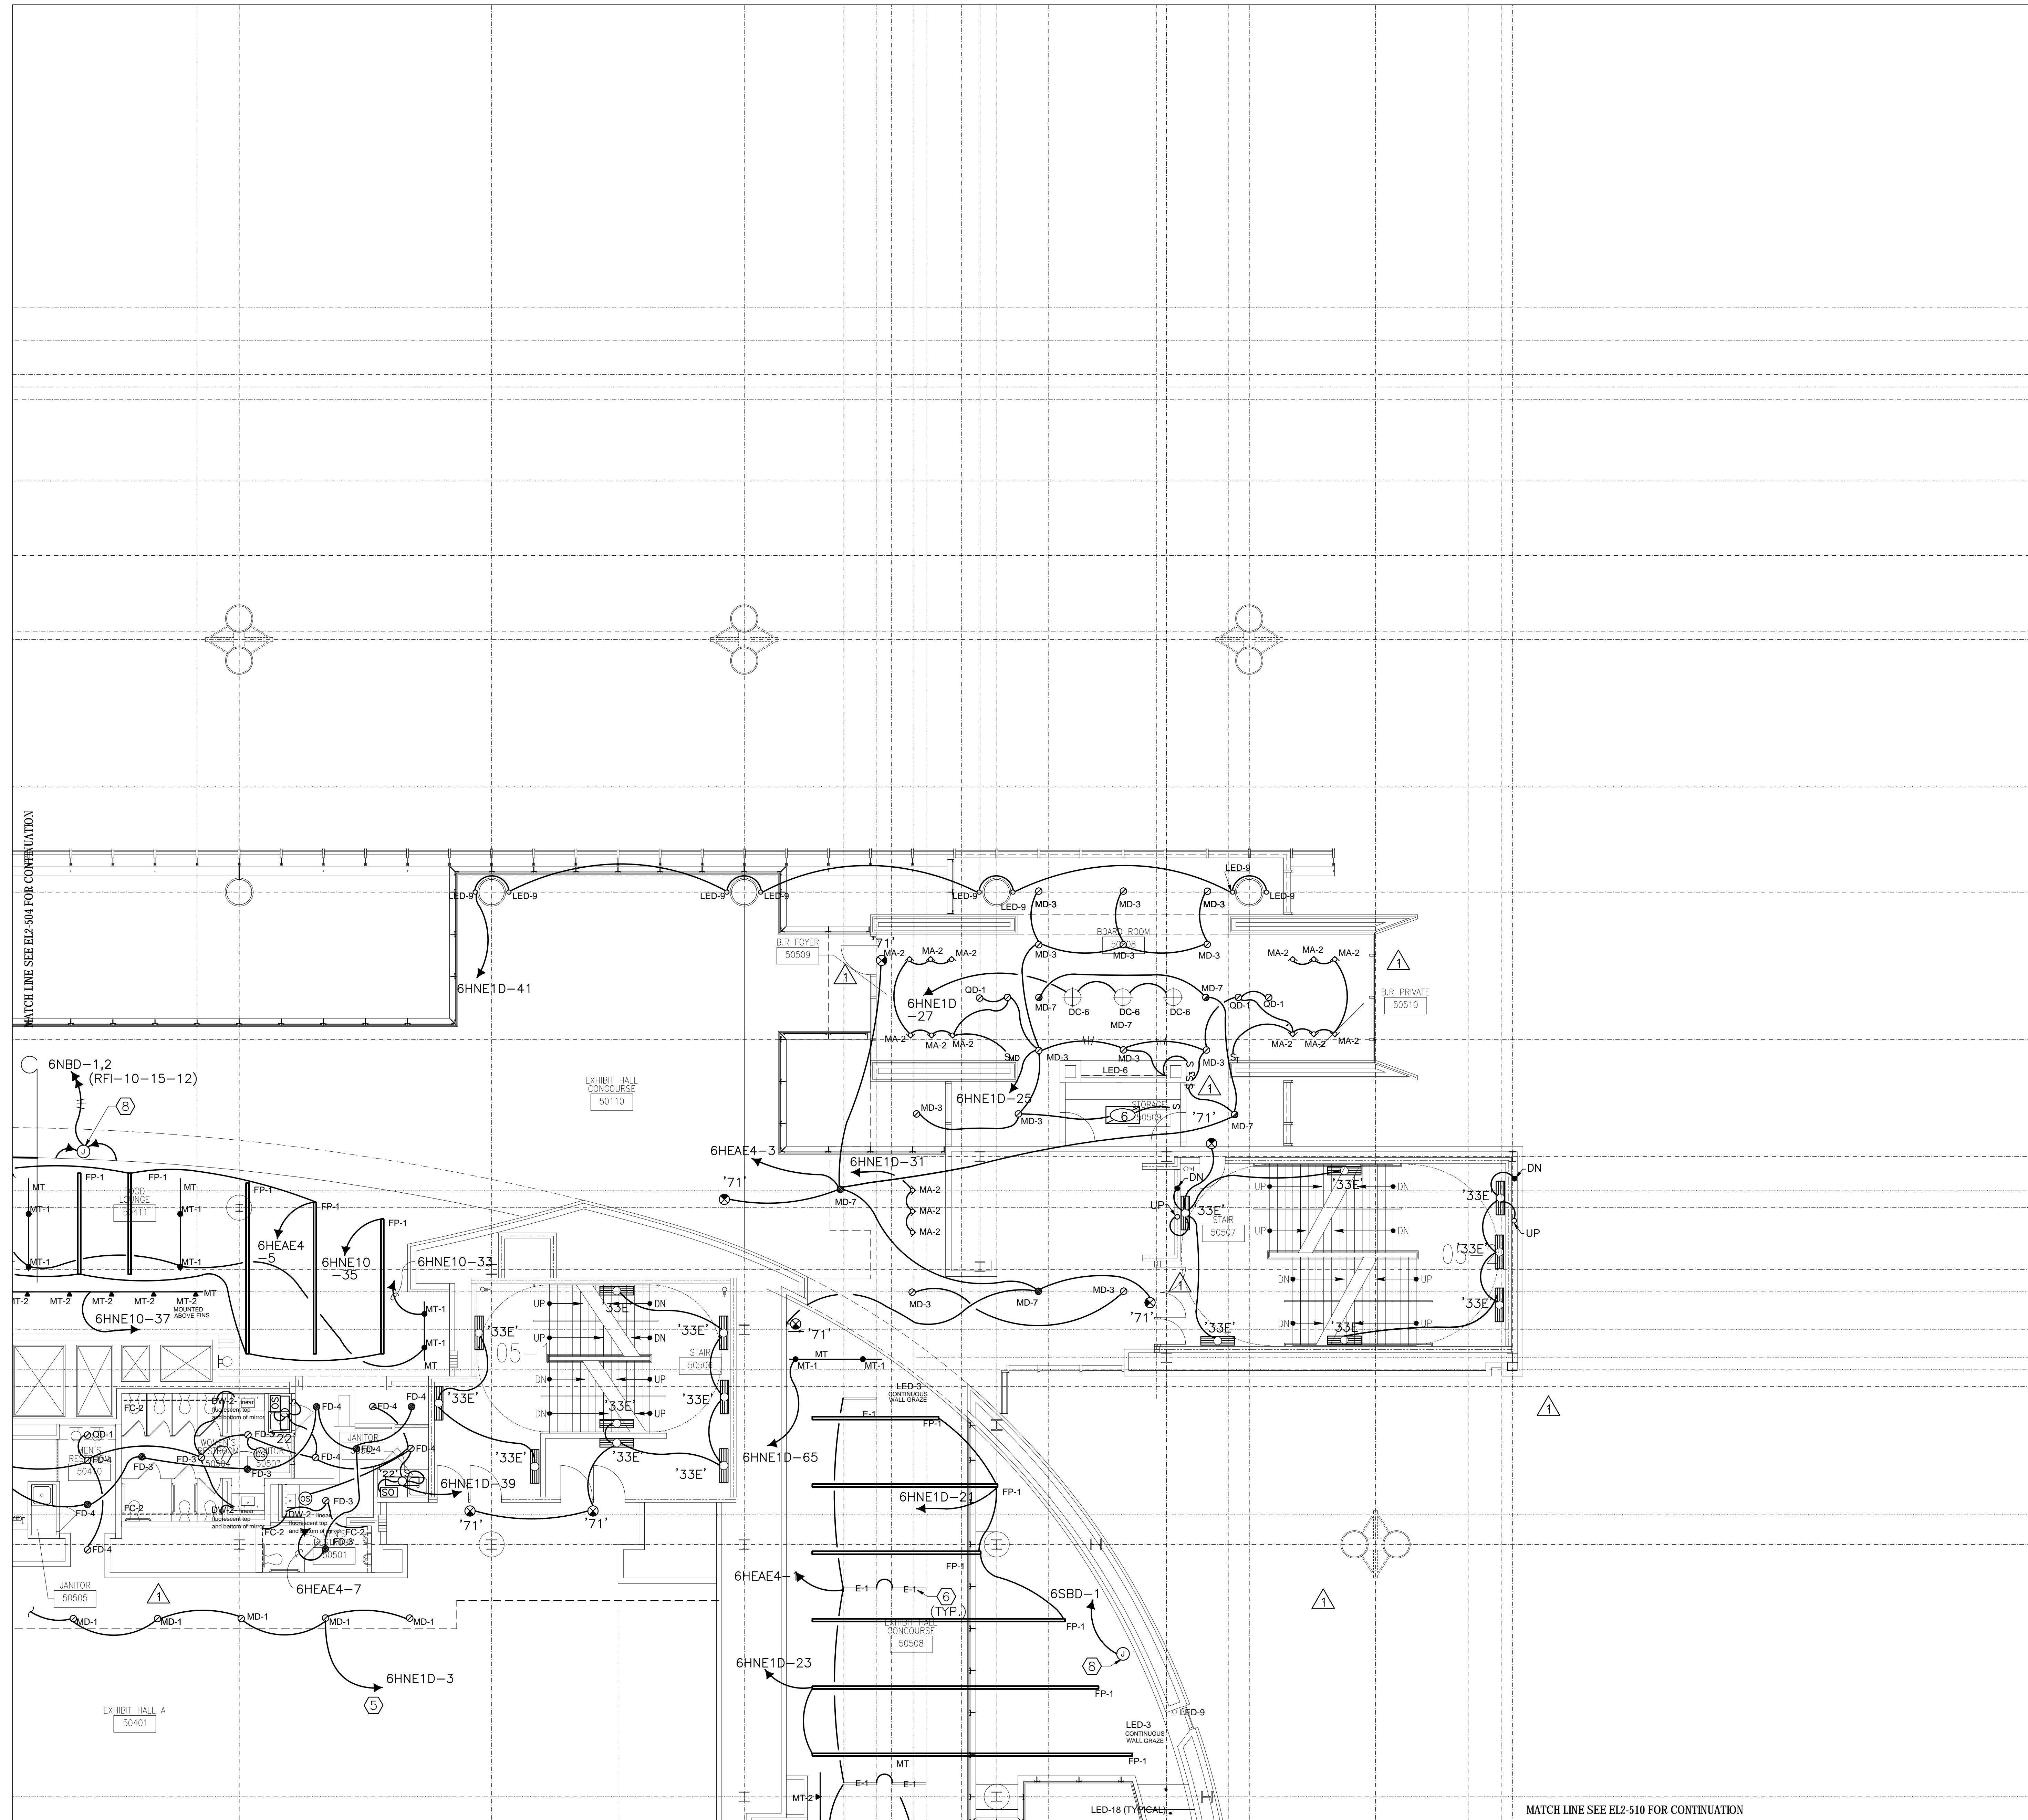

MATCH LINE SEE EL2-504 FOR CONTINUATION


MATCH LINE SEE EL2-510 FOR CONTINUATION

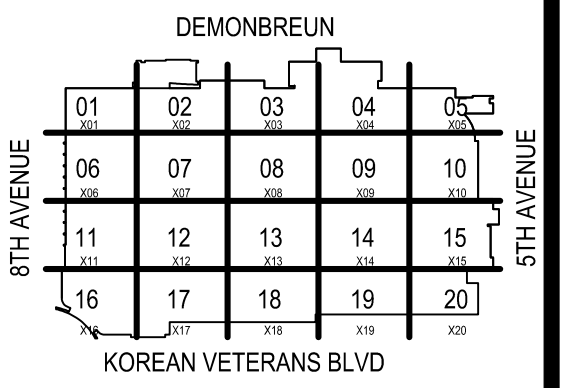

KEY PLAN
NO SCALE

| COORDINATION SIGN-OFF | | DATE |
|-----------------------|------|------|
| COMPANY | NAME | / / |
| TRADE | | / / |
| ELEC. | | / / |
| | | / / |
| | | / / |

Music City Center
Nashville, Tennessee

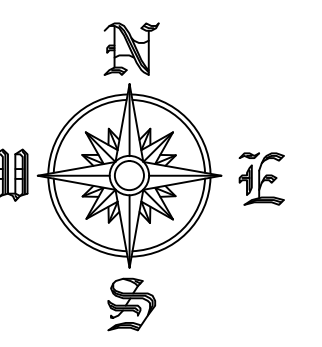


| REVISIONS | | |
|-----------|------|-------------|
| NO. | DATE | DESCRIPTION |
| | | |
| | | |
RECORD DRAWINGS STAMP

CONTI ELECTRIC DATE (Last Update): 2/20/2012 8:00 AM
 DRAWING FILE NAME: EL2-506
 CAD OPERATOR: GERTMAN
 PRINTED BY: FREDMAN, GREG
 PLOT DATE: 6/4/2012 8:04 AM
 SUBMITTED BY: GLEF
 ASSIGNED TO:

LEVEL 5 LIGHTING
 ZONE 6
 SCALE: 1/8" = 1'-0"

EL2-506

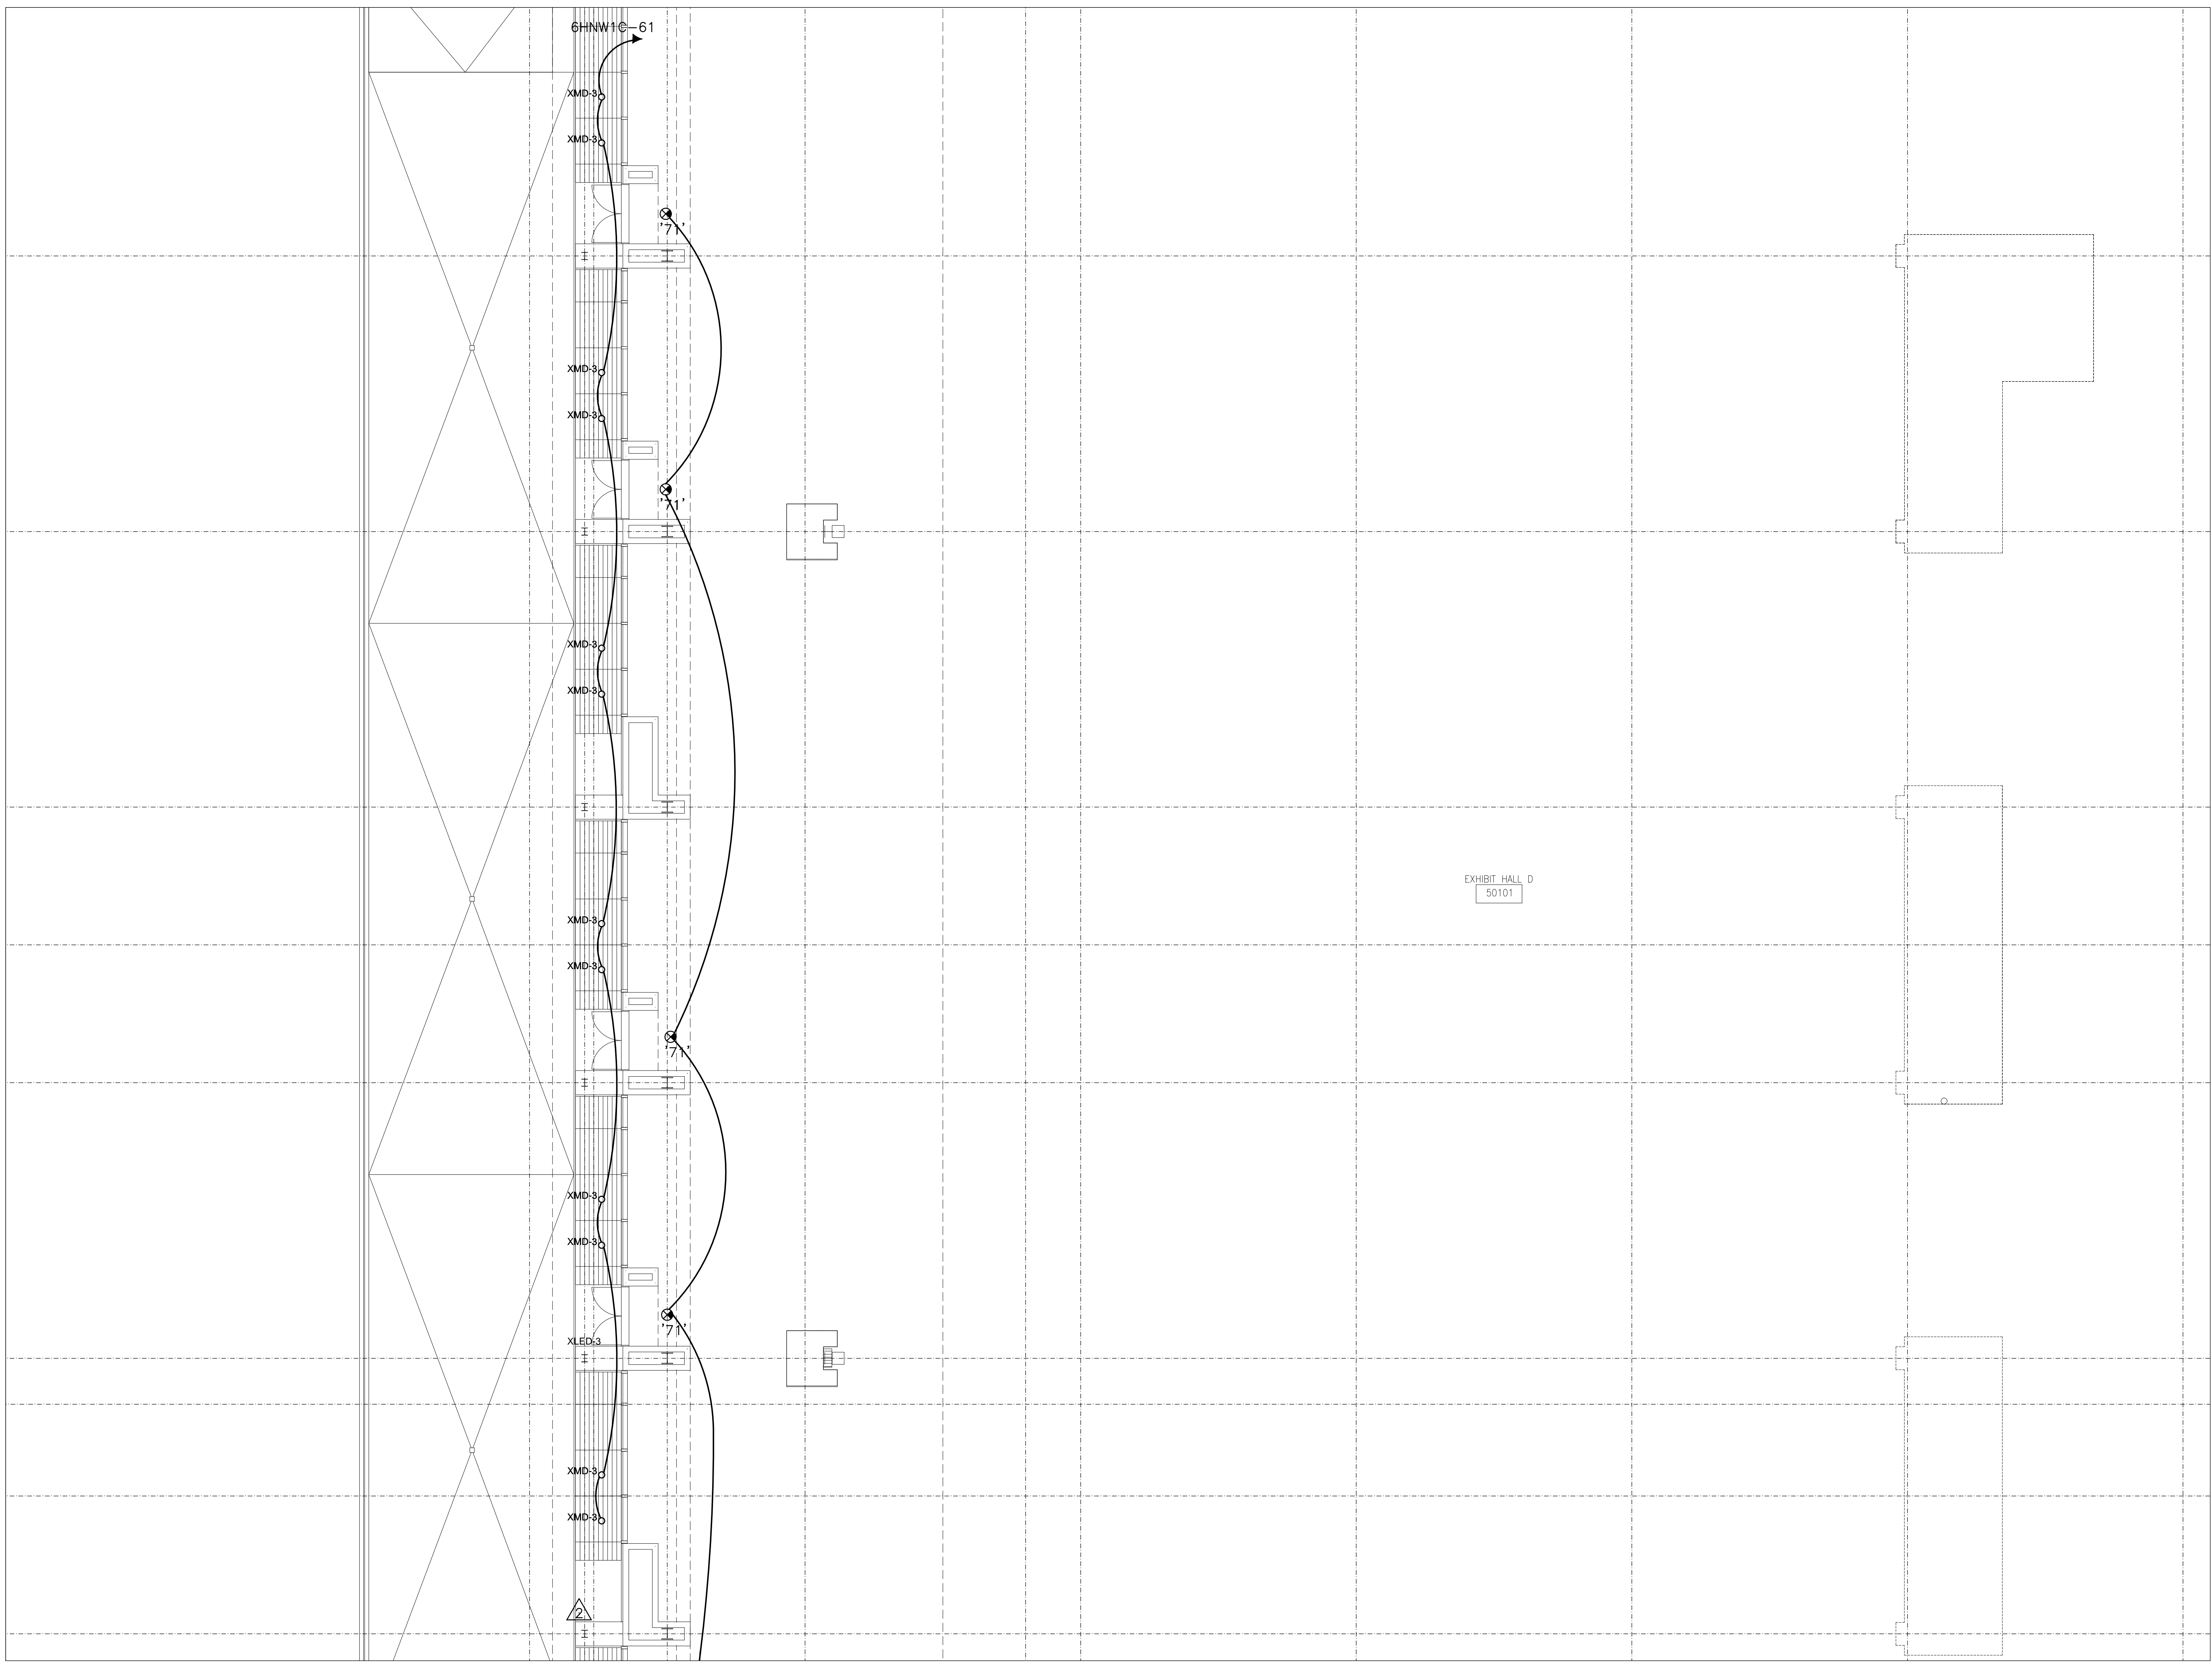


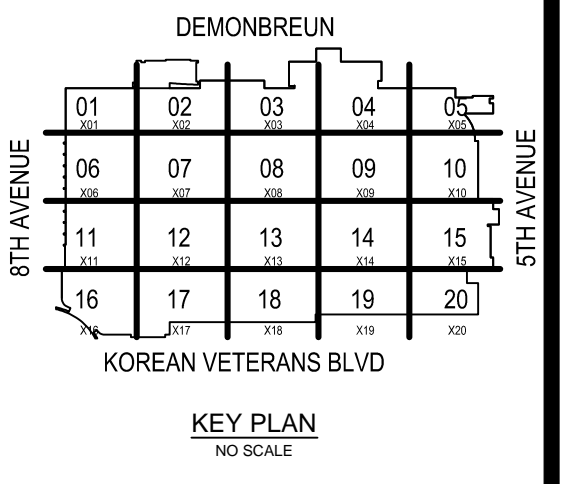

COORDINATION SIGN-OFF

| COMPANY | TRADE | DATE |
|---------|-------|------|
| CONTI | ELEC. | / / |
| | | / / |
| | | / / |
Music City Center
 Nashville, Tennessee

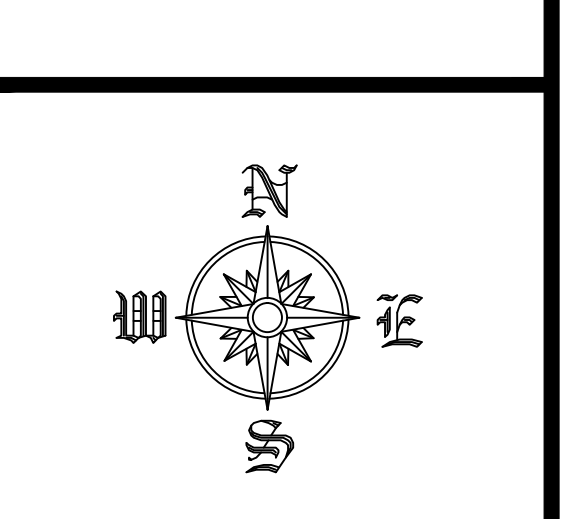

REVISIONS

| NO. | DATE | DESCRIPTION |
|-----|------|-------------|
| | | |
| | | |
RECORD DRAWINGS STAMP

CONTI ELECTRIC DATE (Last Update):
 2/20/2019 8:00 AM

DRAWING FILE NAME:
 EL2-510

CAD OPERATOR:
 GERTMAN

PRINTED BY:
 FREDMAN, GREGG


PLOT DATE:
 6/4/2019 8:04 AM

SUBMITTED BY:
 GERTMAN

ASSIGNED TO:

LEVEL 5 LIGHTING
 ZONE 10
 SCALE: 1/8" = 1'-0"

EL2-510

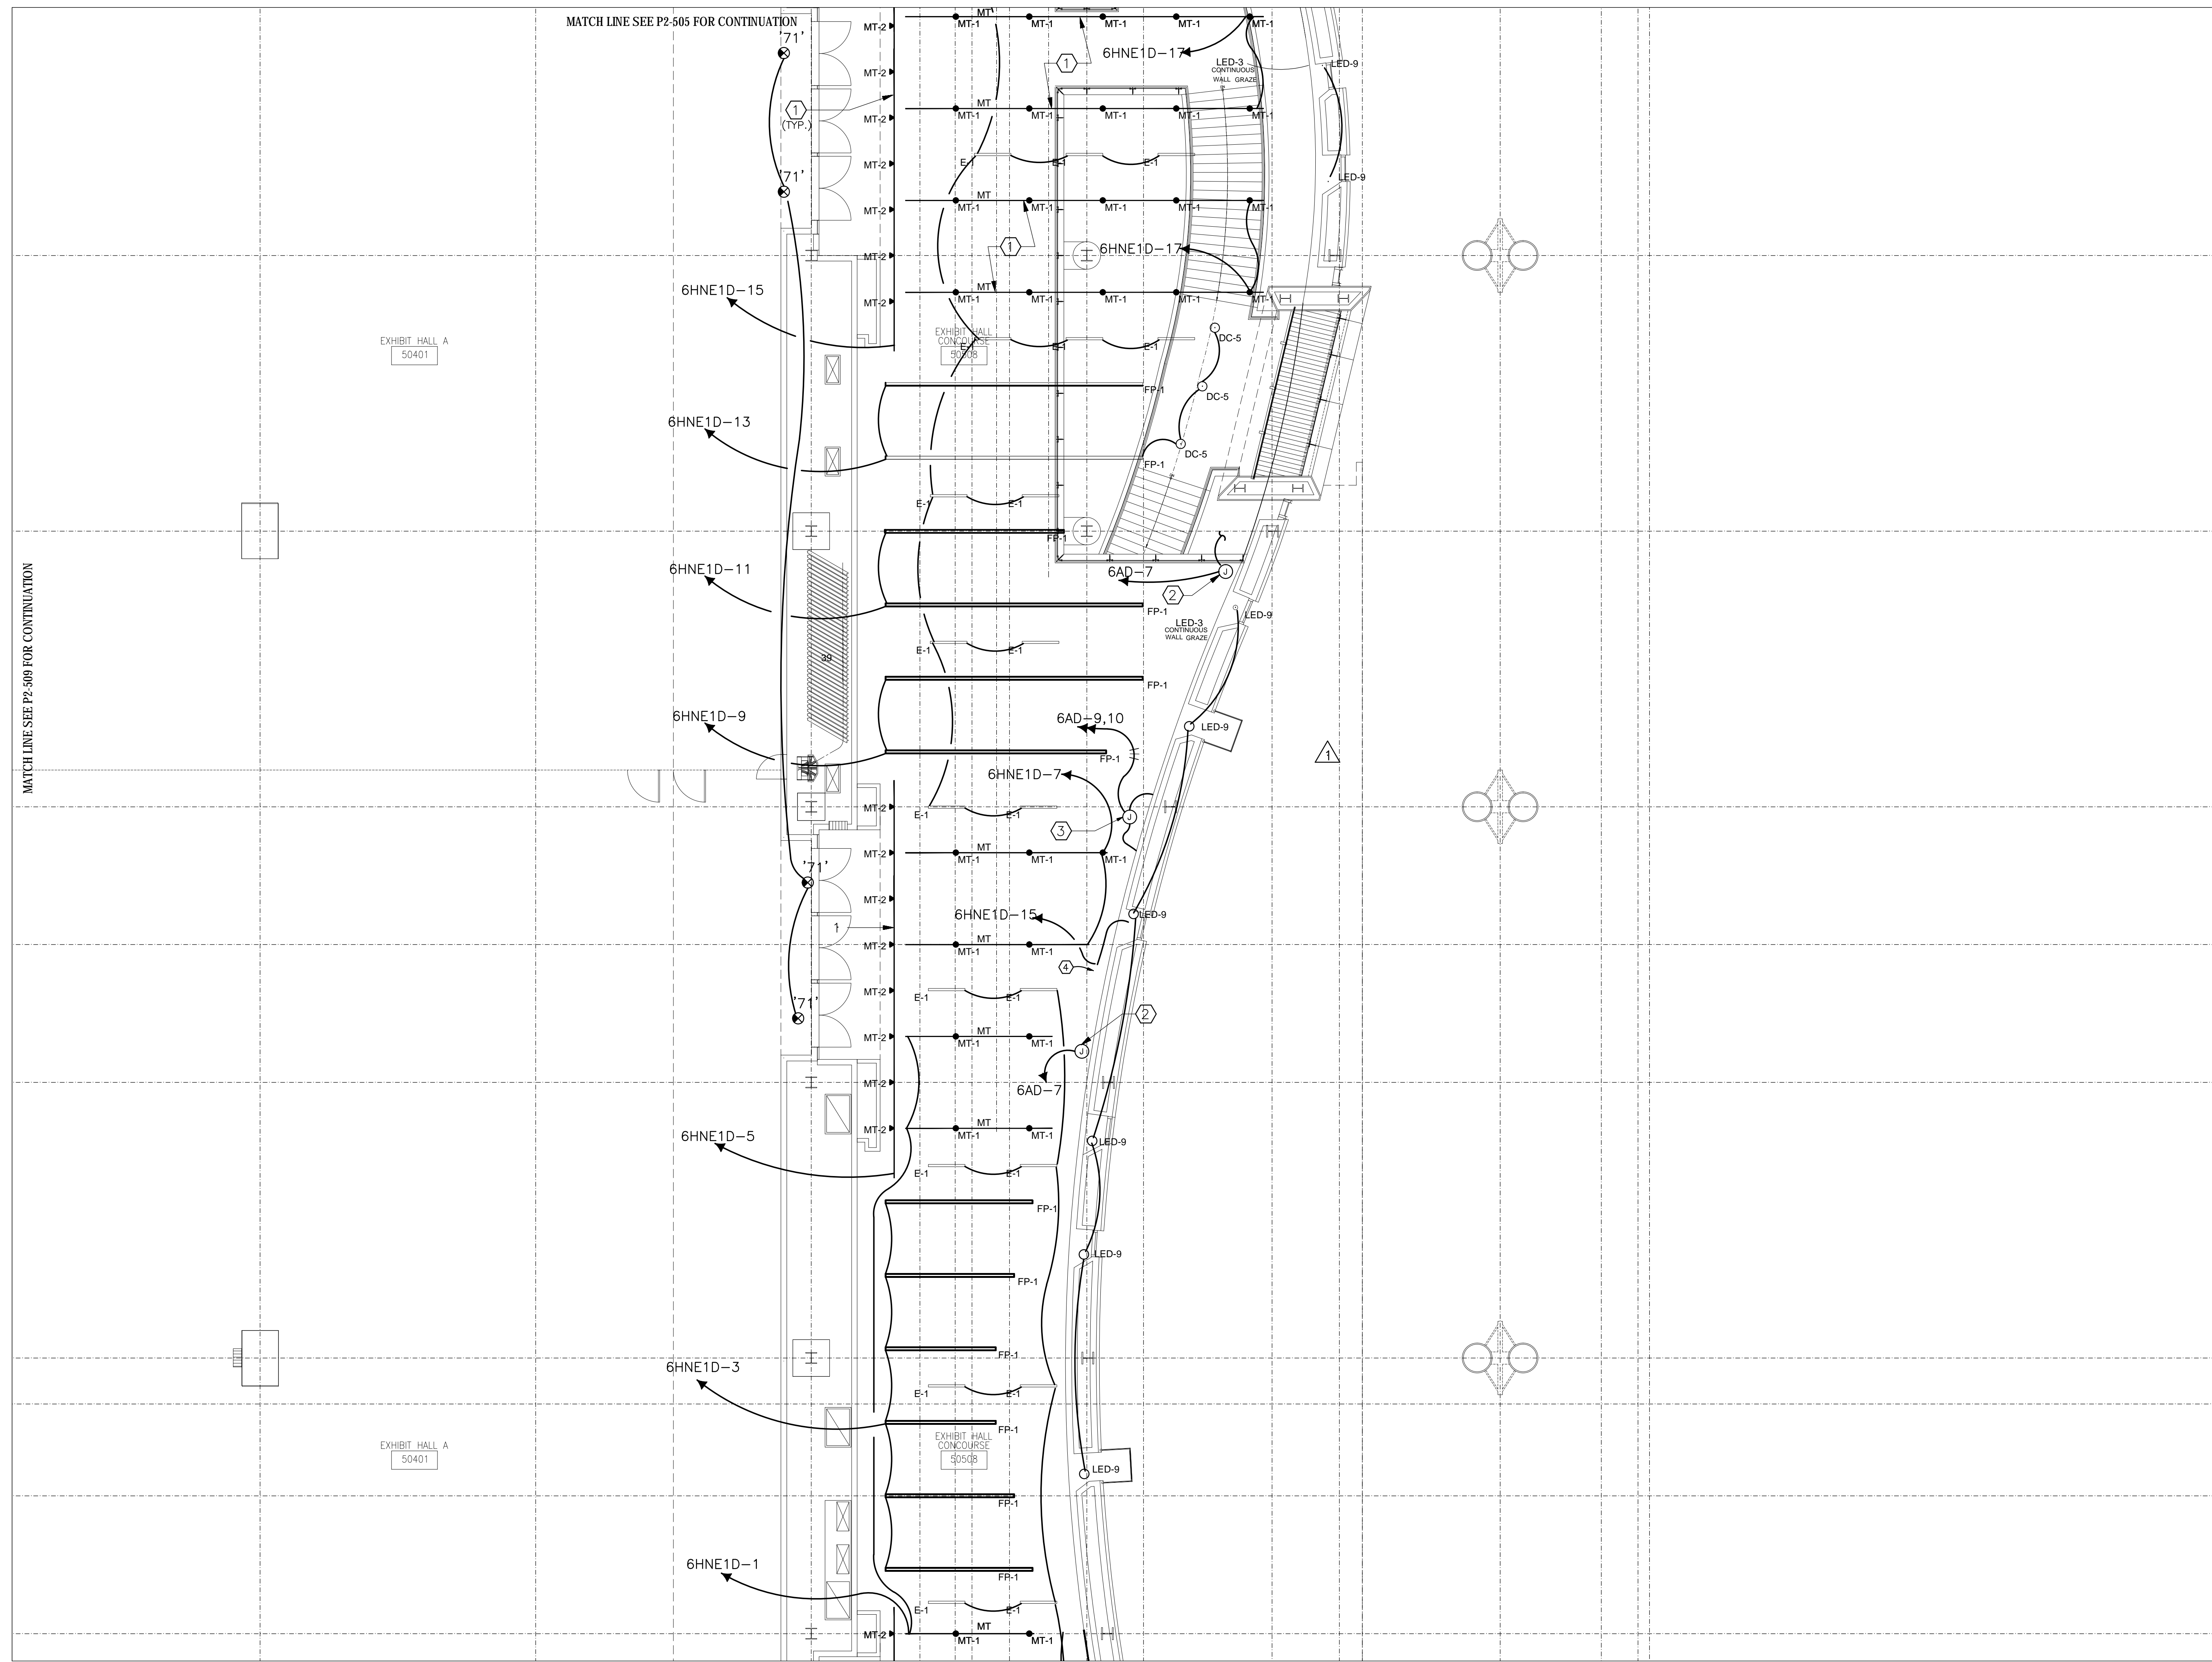


DEMOMBREUN

| | | | |
|----|----|----|----|
| 01 | 02 | 03 | 04 |
| 05 | 06 | 07 | 08 |
| 09 | 10 | 11 | 12 |
| 13 | 14 | 15 | 16 |
| 17 | 18 | 19 | 20 |

BRIDGE AVENUE
 KOREAN VETERANS BLVD
 STRAWBRIDGE


KEY PLAN
 NO SCALE

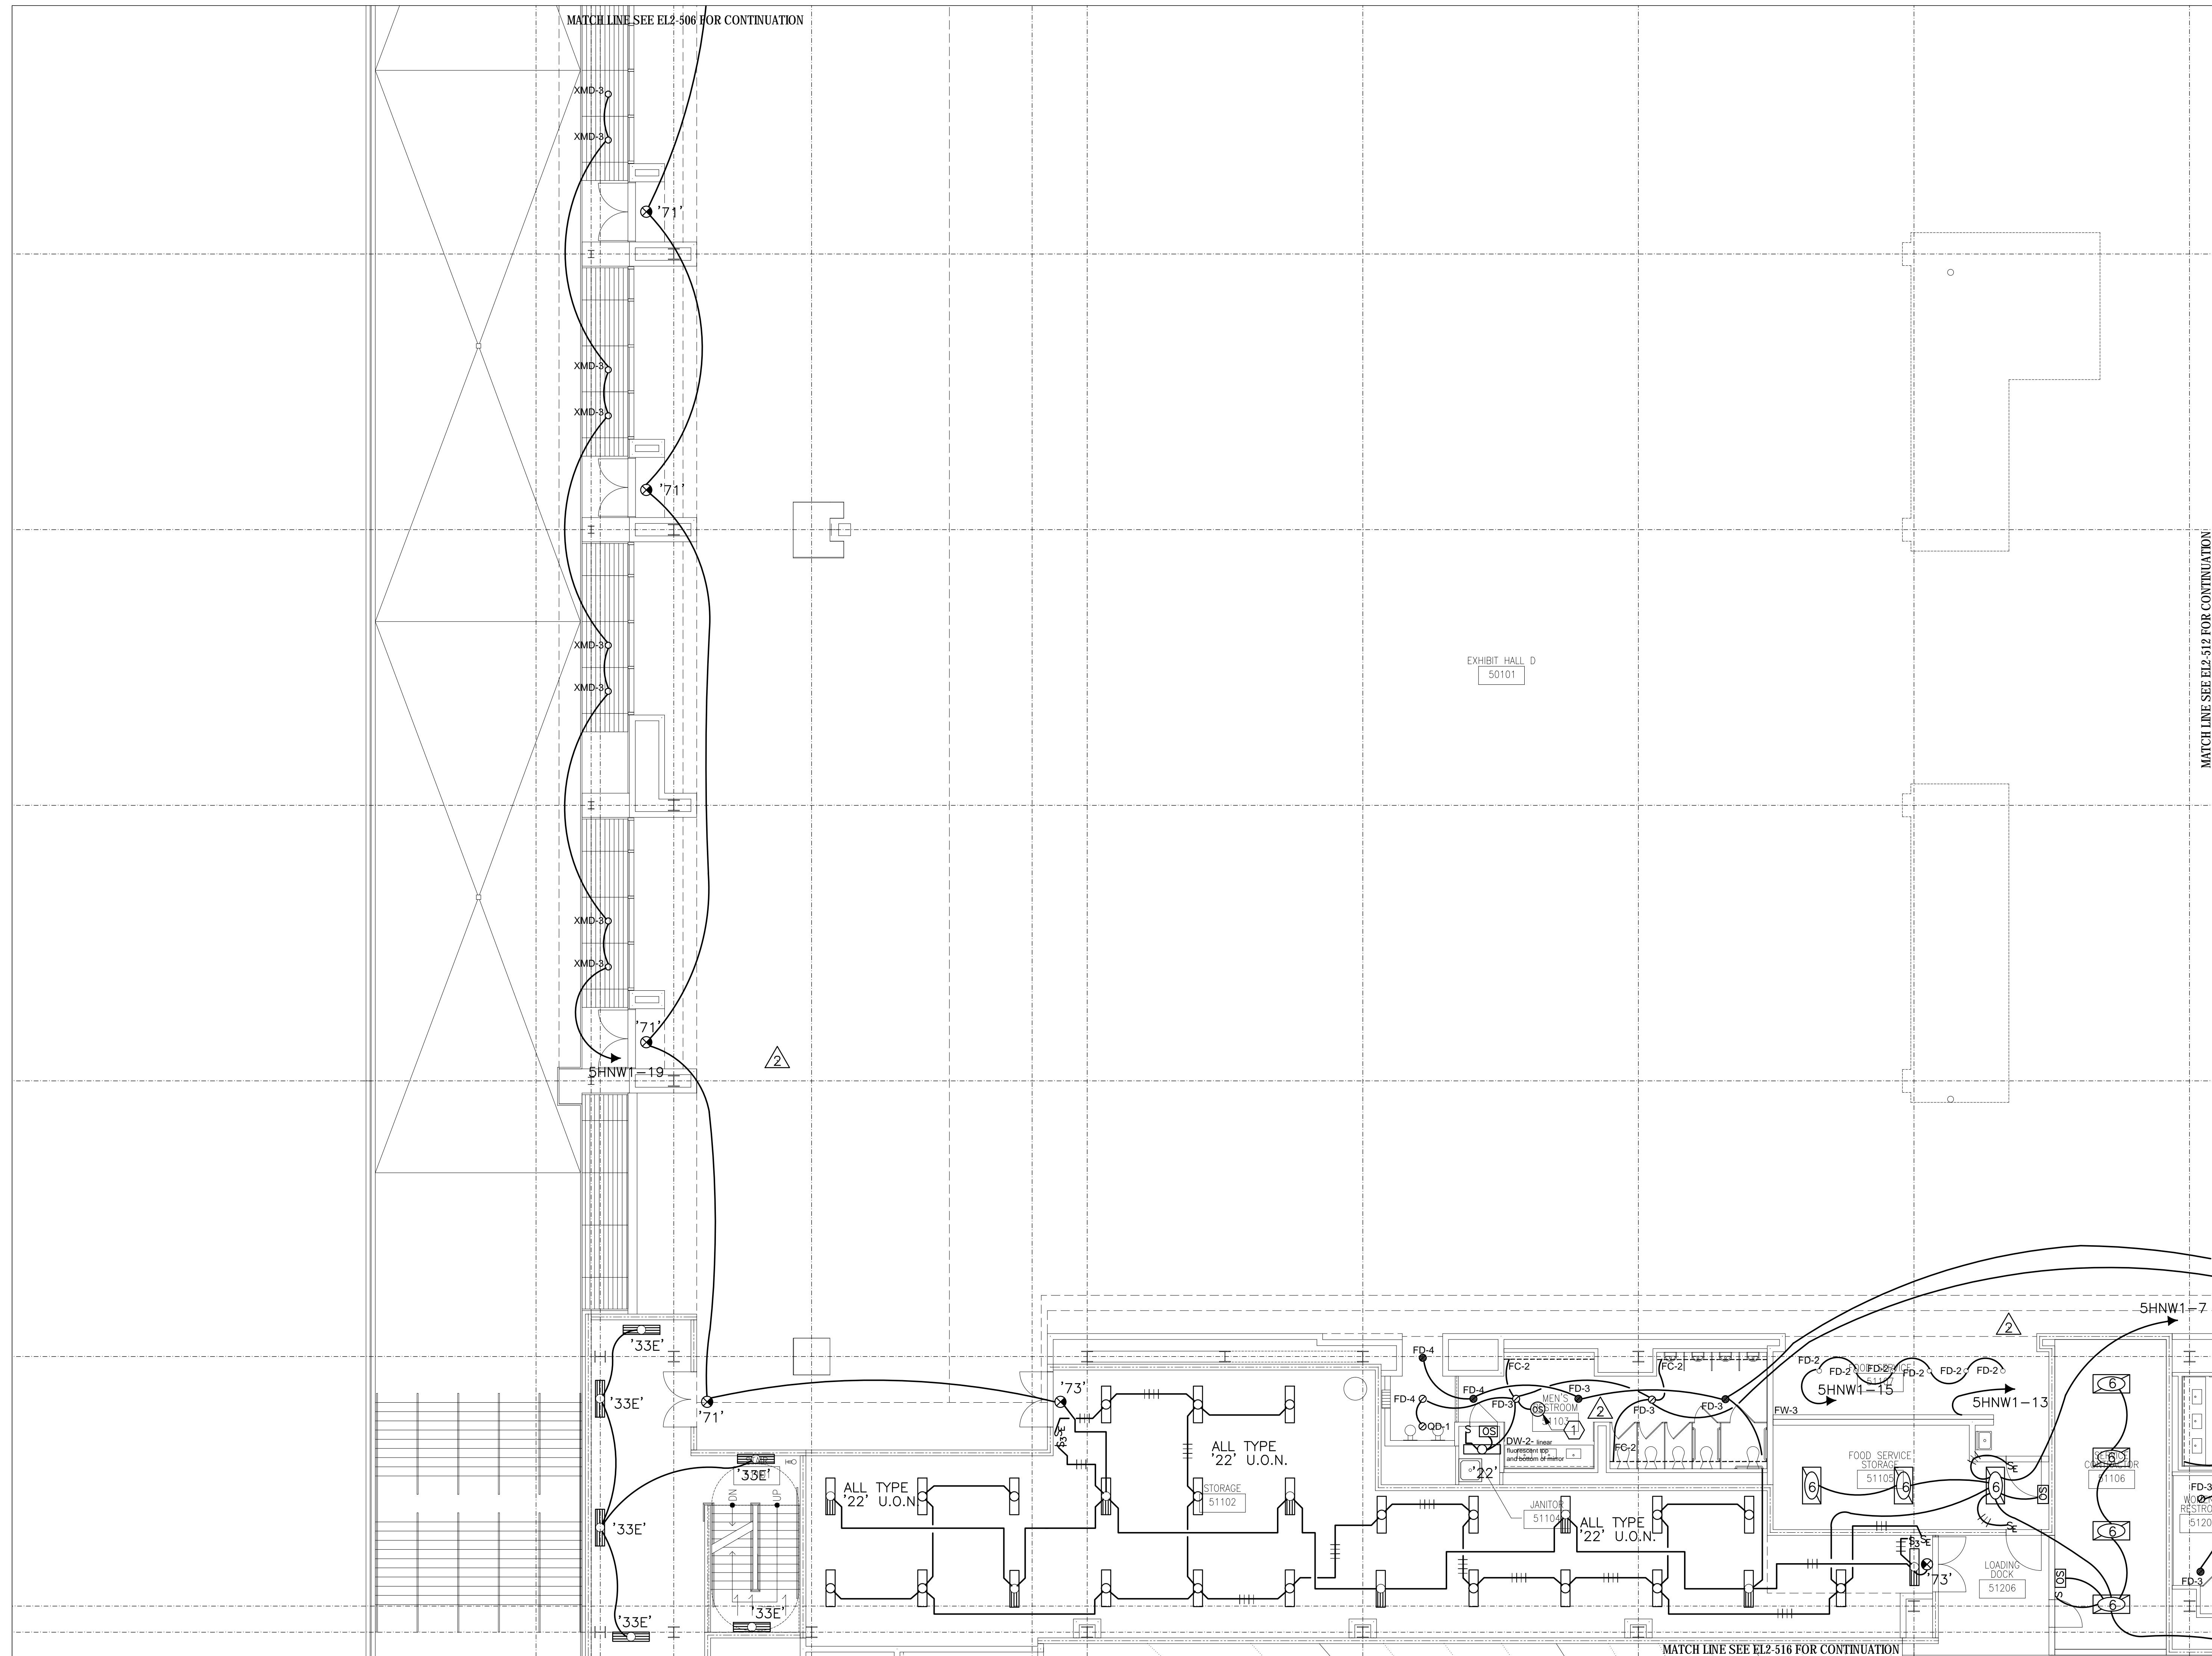

COORDINATION SIGN-OFF

| COMPANY | TRADE | DATE |
|---------|-------|------|
| CONTI | ELEC. | / / |
| | | / / |
| | | / / |
Music City Center
 Nashville, Tennessee

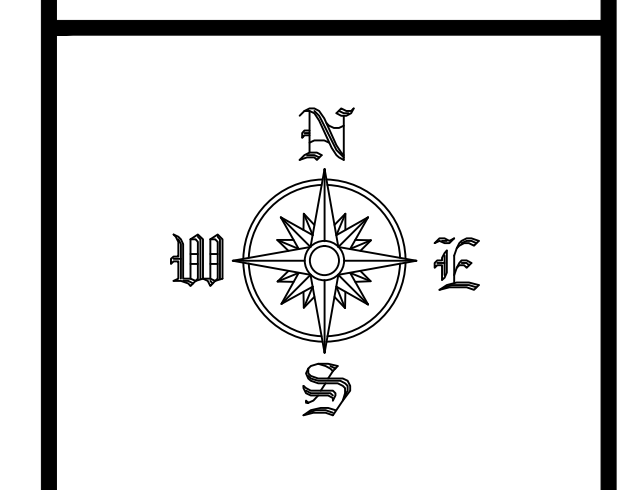

REVISIONS

| NO. | DATE | DESCRIPTION |
|-----|------|-------------|
| | | |
| | | |
RECORD DRAWINGS STAMP

CONTI ELECTRIC DATE (last Update): 2/28/2012 8:00 AM
 DRAWING FILE NAME: EL2-11
 CAD OPERATOR: GEBERMAN
 PRINTED BY: FREEMAN, GREGG
 PLOT DATE: 6/4/2012 8:04 AM
 SUBMITTED BY: GEP
 ASSIGNED TO:

LEVEL 3 LIGHTING
 ZONE 11
 SCALE: 1/8" = 1'-0"

EL2-311


FILE PATH FOR CAD DEPARTMENT USE ONLY: C:\3035\Conti Electric\Projects\MusicCity\Level 3 Lighting\Zone 11\Level 3 Lighting Zone 11.dwg

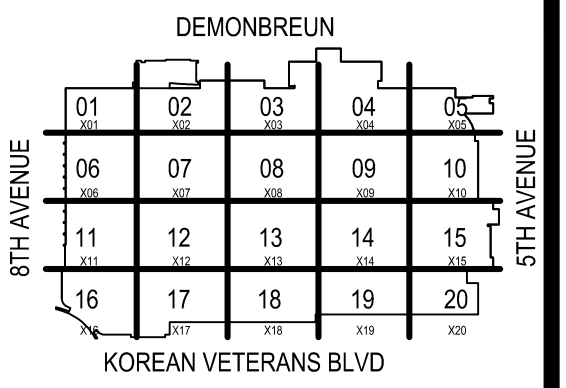

COORDINATION SIGN-OFF

| COMPANY | TRADE | DATE |
|---------|-------|------|
| CONTI | ELEC. | / / |
| | | / / |
| | | / / |
Music City Center
 Nashville, Tennessee

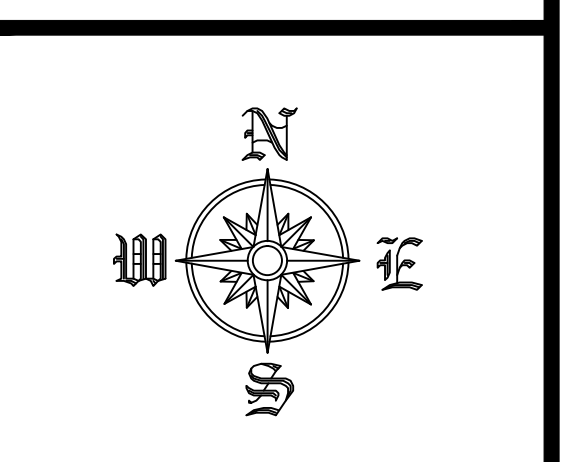

REVISIONS


| NO. | DATE | DESCRIPTION |
|-----|------|-------------|
| | | |
| | | |
RECORD DRAWINGS STAMP

CONTI ELECTRIC DATE (Last Update):
 2/20/2013 8:00 AM
 DRAWING FILE NAME:
 E2-512
 CAD OPERATOR:
 GERTMAN
 PRINTED BY:
 FREDMAN, GREG
 PLOT DATE:
 6/4/2013 8:04 AM
 SUBMITTED BY:
 GERTMAN
 ASSIGNED TO:

LEVEL 5 LIGHTING
 ZONE 12
 SCALE: 1/8" = 1'-0"

EL2-512

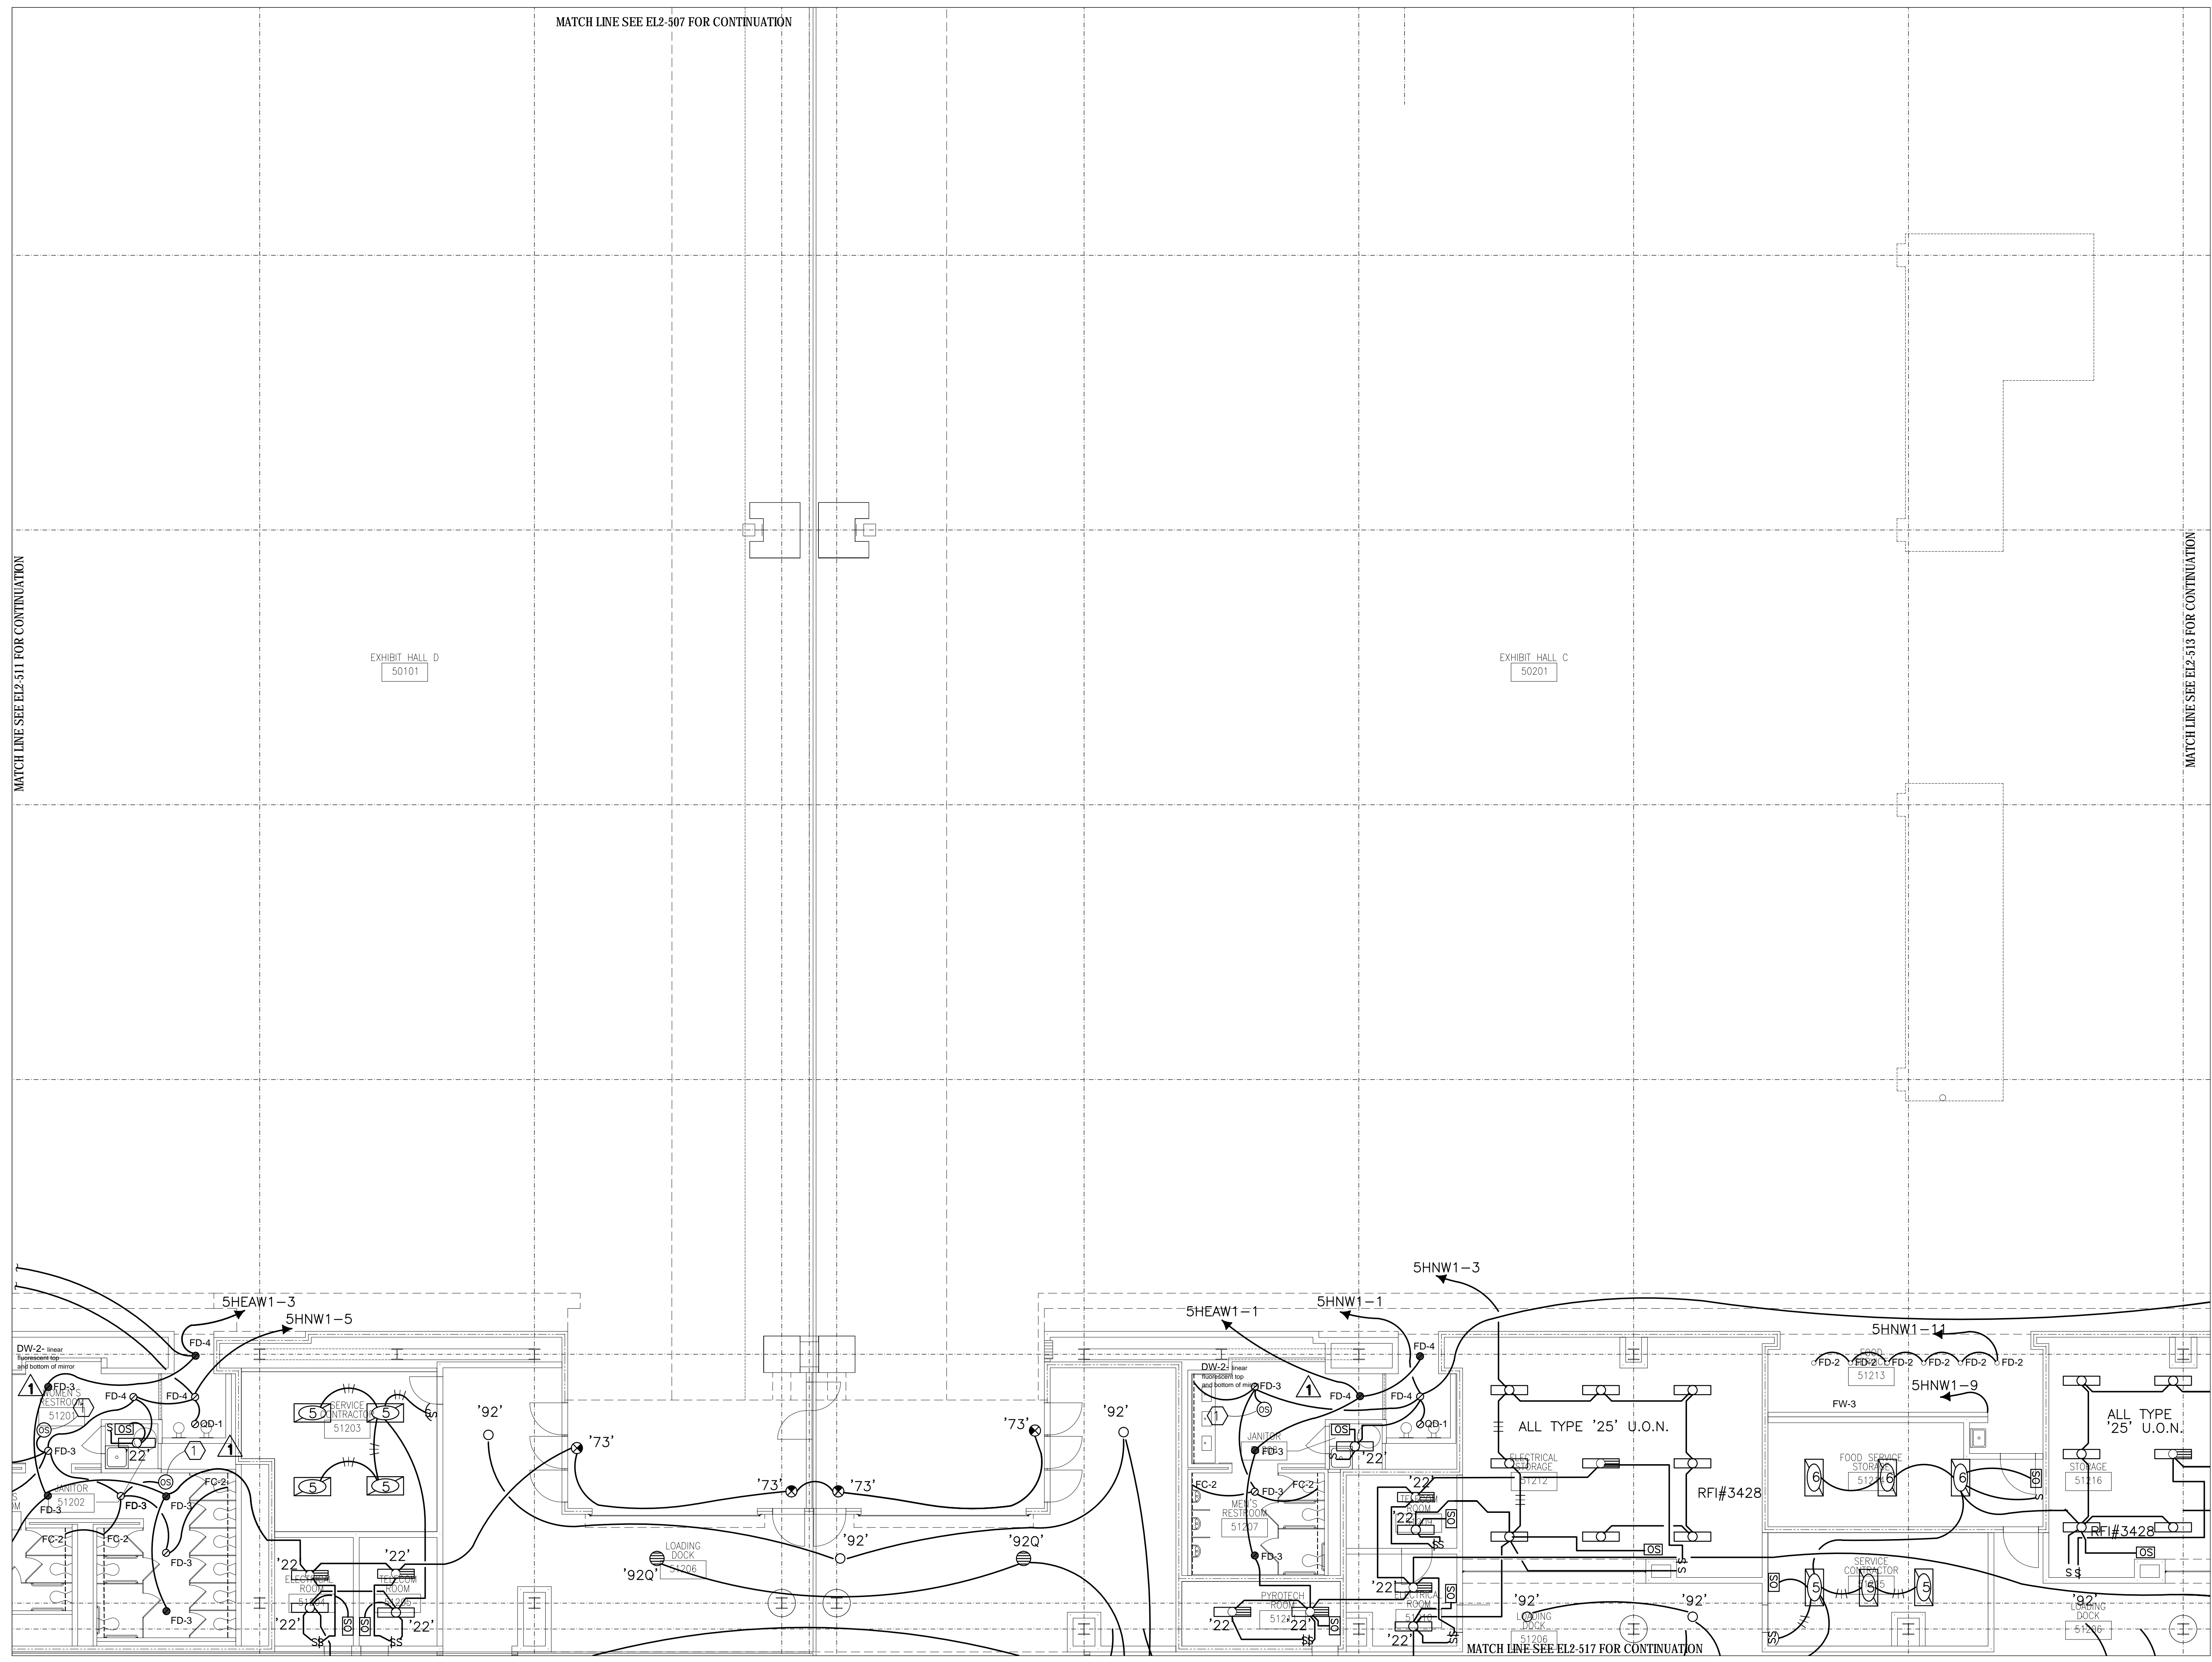


MATCH LINE SEE EL2-511 FOR CONTINUATION

MATCH LINE SEE EL2-513 FOR CONTINUATION

MATCH LINE SEE EL2-511 FOR CONTINUATION

MATCH LINE SEE EL2-517 FOR CONTINUATION


MATCH LINE SEE EL2-507 FOR CONTINUATION

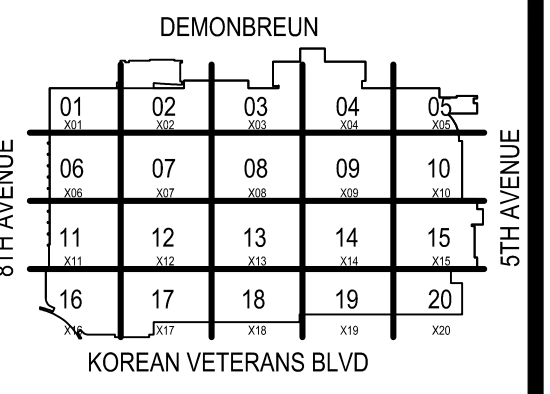

KEY PLAN
NO SCALE

| COMPANY | TRADE | NAME | COORDINATION SIGN-OFF | | | | |
|---------|-------|------|-----------------------|------|------|------|------|
| | | | DATE | DATE | DATE | DATE | DATE |
| CONTI | ELEC. | | / / | / / | / / | / / | / / |
| | | | / / | / / | / / | / / | / / |
| | | | / / | / / | / / | / / | / / |
| | | | / / | / / | / / | / / | / / |

Music City Center
Nashville, Tennessee

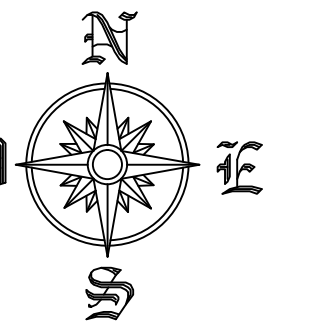


| REVISIONS | | |
|-----------|------|-------------|
| NO. | DATE | DESCRIPTION |
| | | |
| | | |
RECORD DRAWINGS STAMP

CONTI ELECTRIC DATE (Last Update): 2/20/2013
DRAWING FILE NAME: E2-513
DESIGNED BY: GERTMAN
CAD OPERATOR: GERTMAN
PRINTED BY: FREDMAN, GREGG
PLOT DATE: 6/14/2013 8:04 AM
SUBMITTED BY: GERTMAN
ASSIGNED TO:

LEVEL 5 LIGHTING
ZONE 13
SCALE: 1/8" = 1'-0"

EL2-513

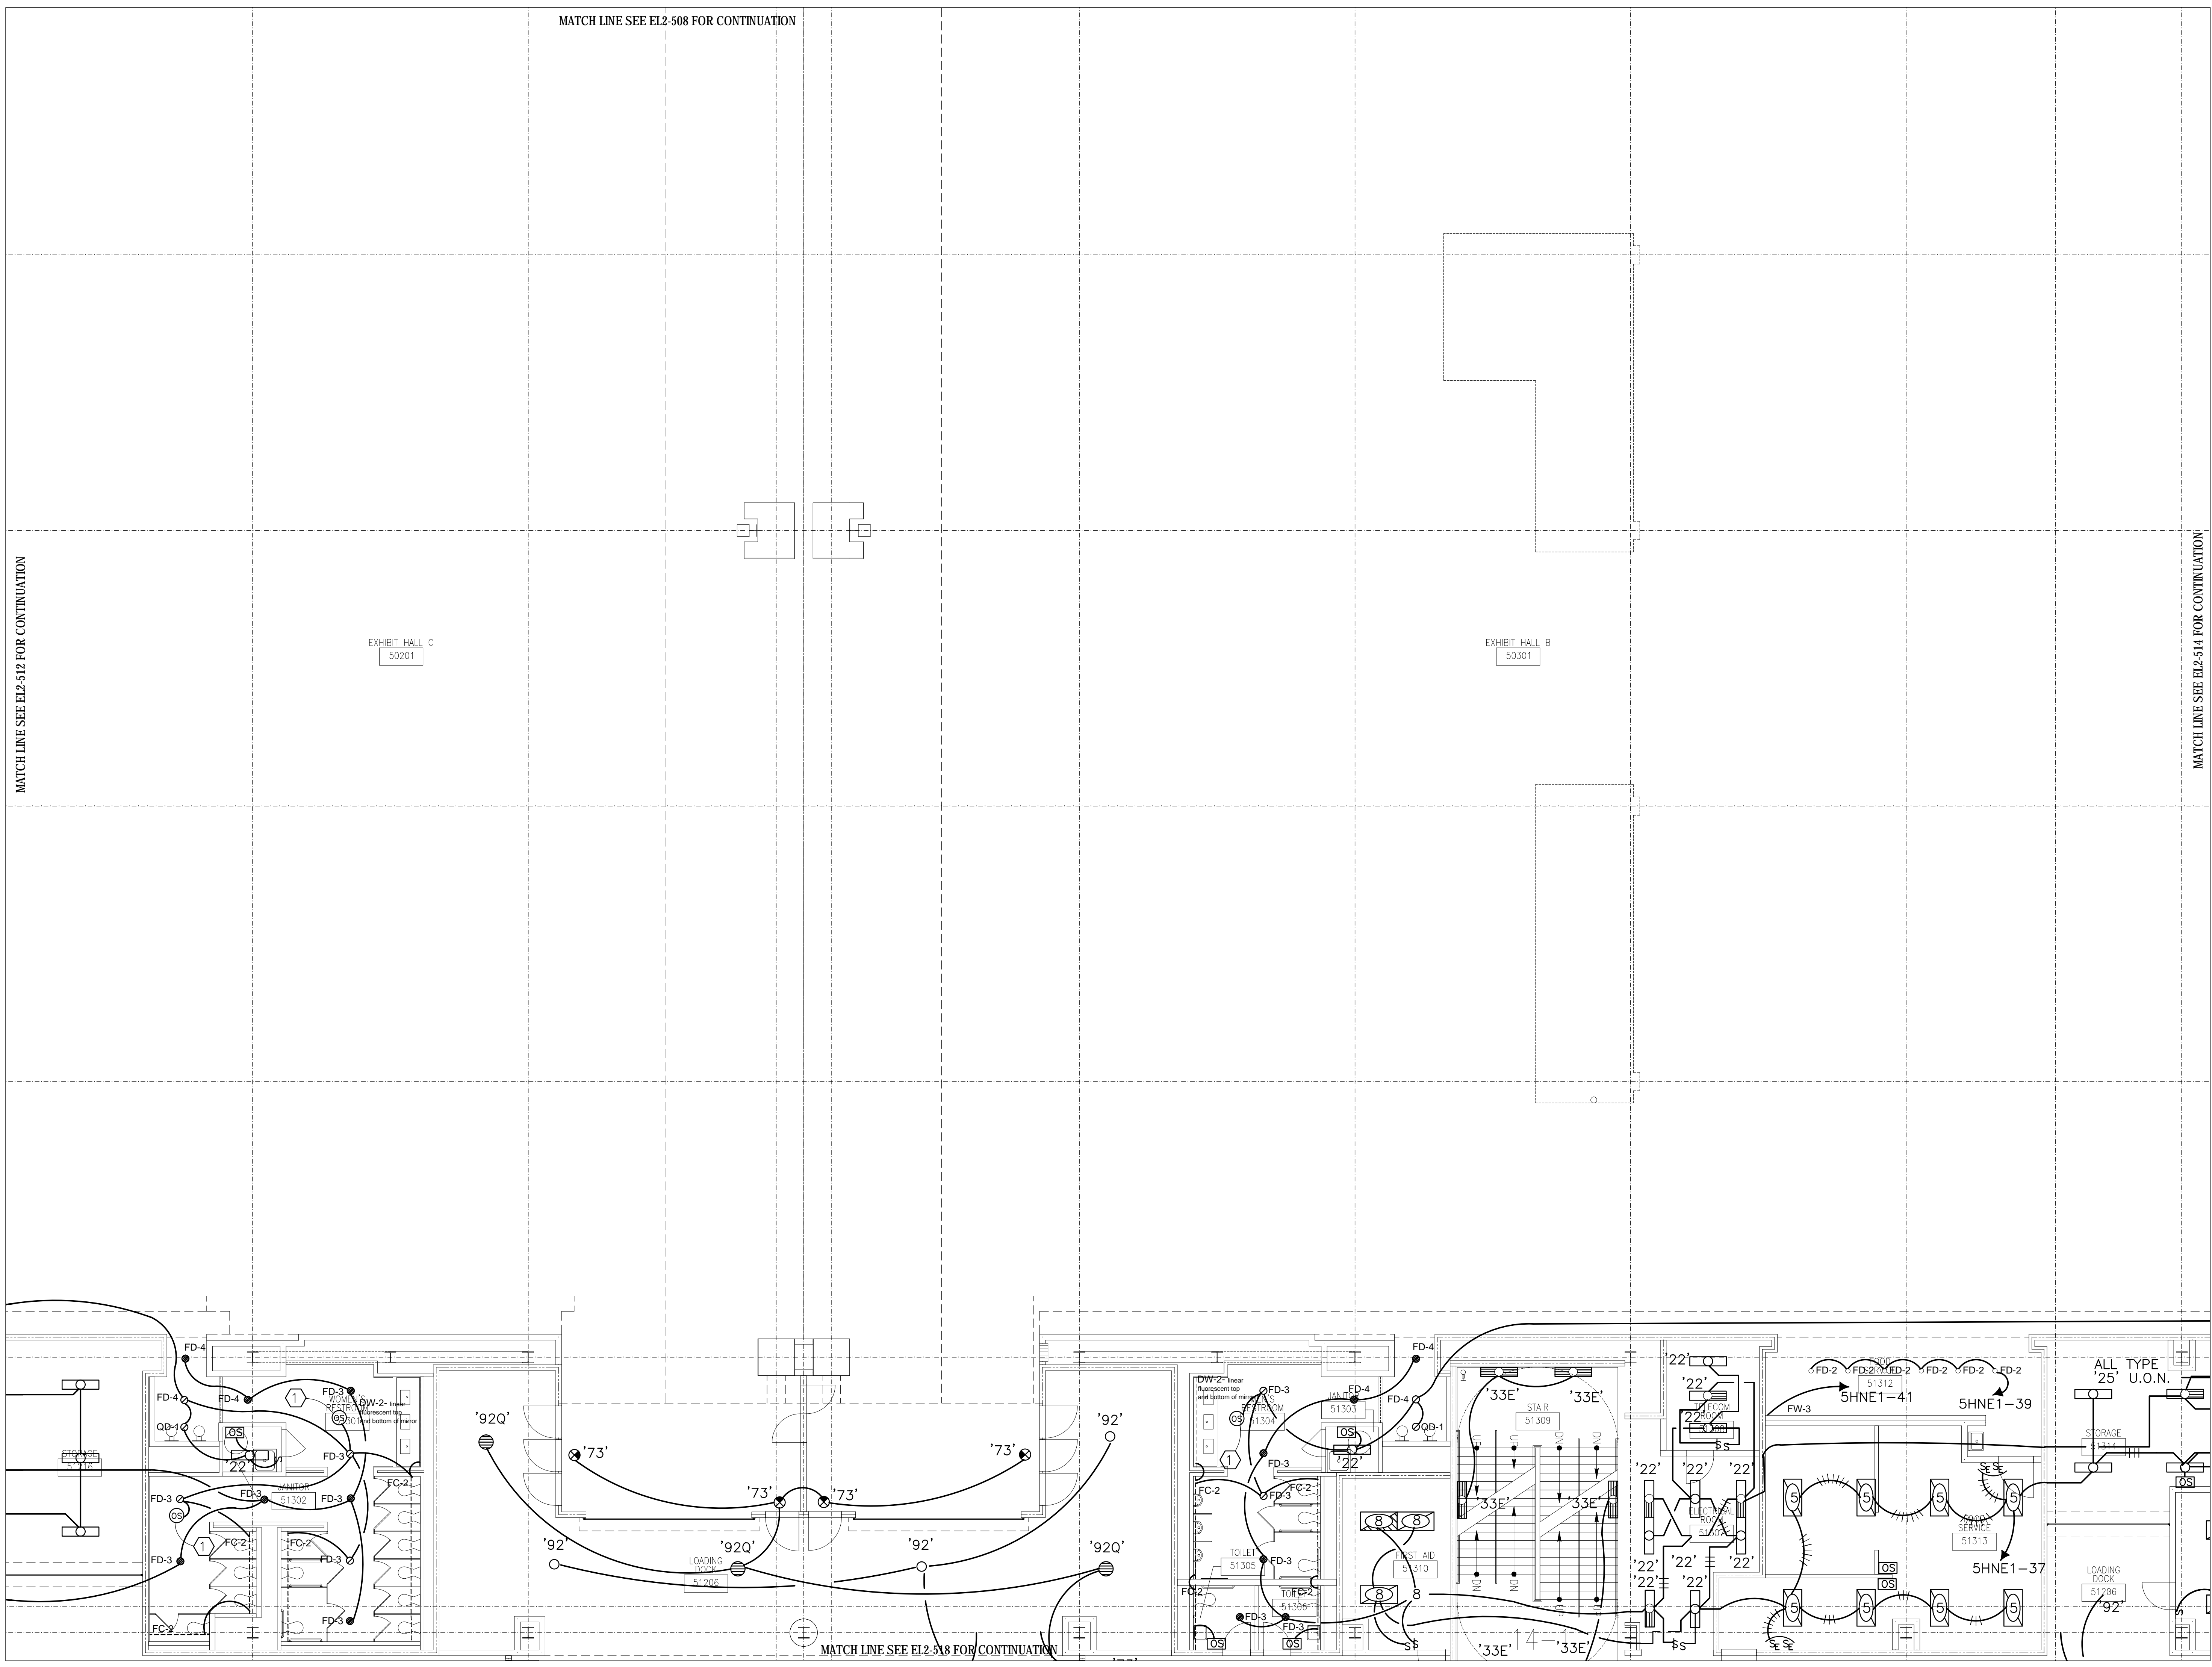


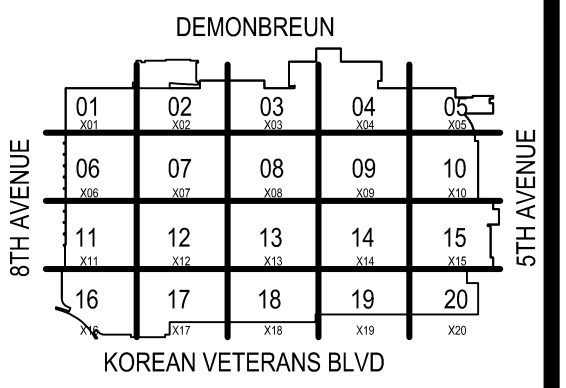

COORDINATION SIGN-OFF

| COMPANY | TRADE | DATE |
|---------|-------|------|
| CONTI | ELEC. | / / |
| | | / / |
| | | / / |
Music City Center
 Nashville, Tennessee

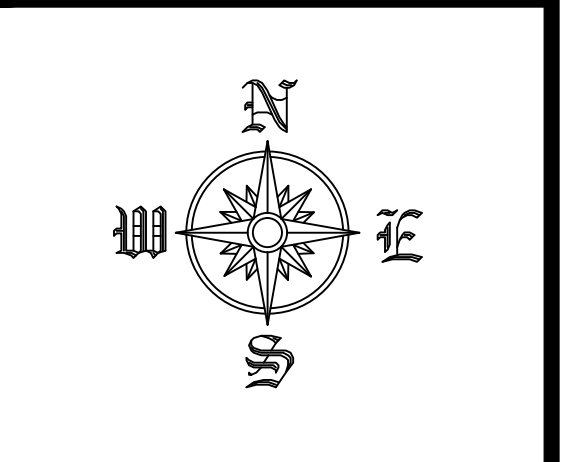

REVISIONS


| NO. | DATE | DESCRIPTION |
|-----|------|-------------|
| | | |
| | | |
RECORD DRAWINGS STAMP


CONTI ELECTRIC DATE (Last Update): 2/28/2012 8:00 AM
 DRAWING FILE NAME: EL2-514
 CAD OPERATOR: GERTMAN
 PRINTED BY: FREDMAN, GREG
 PLOT DATE: 6/4/2012 8:04 AM
 SUBMITTED BY: GELF
 ASSIGNED TO:

LEVEL 5 LIGHTING
 ZONE 14
 SCALE: 1/8" = 1'-0"

EL2-514

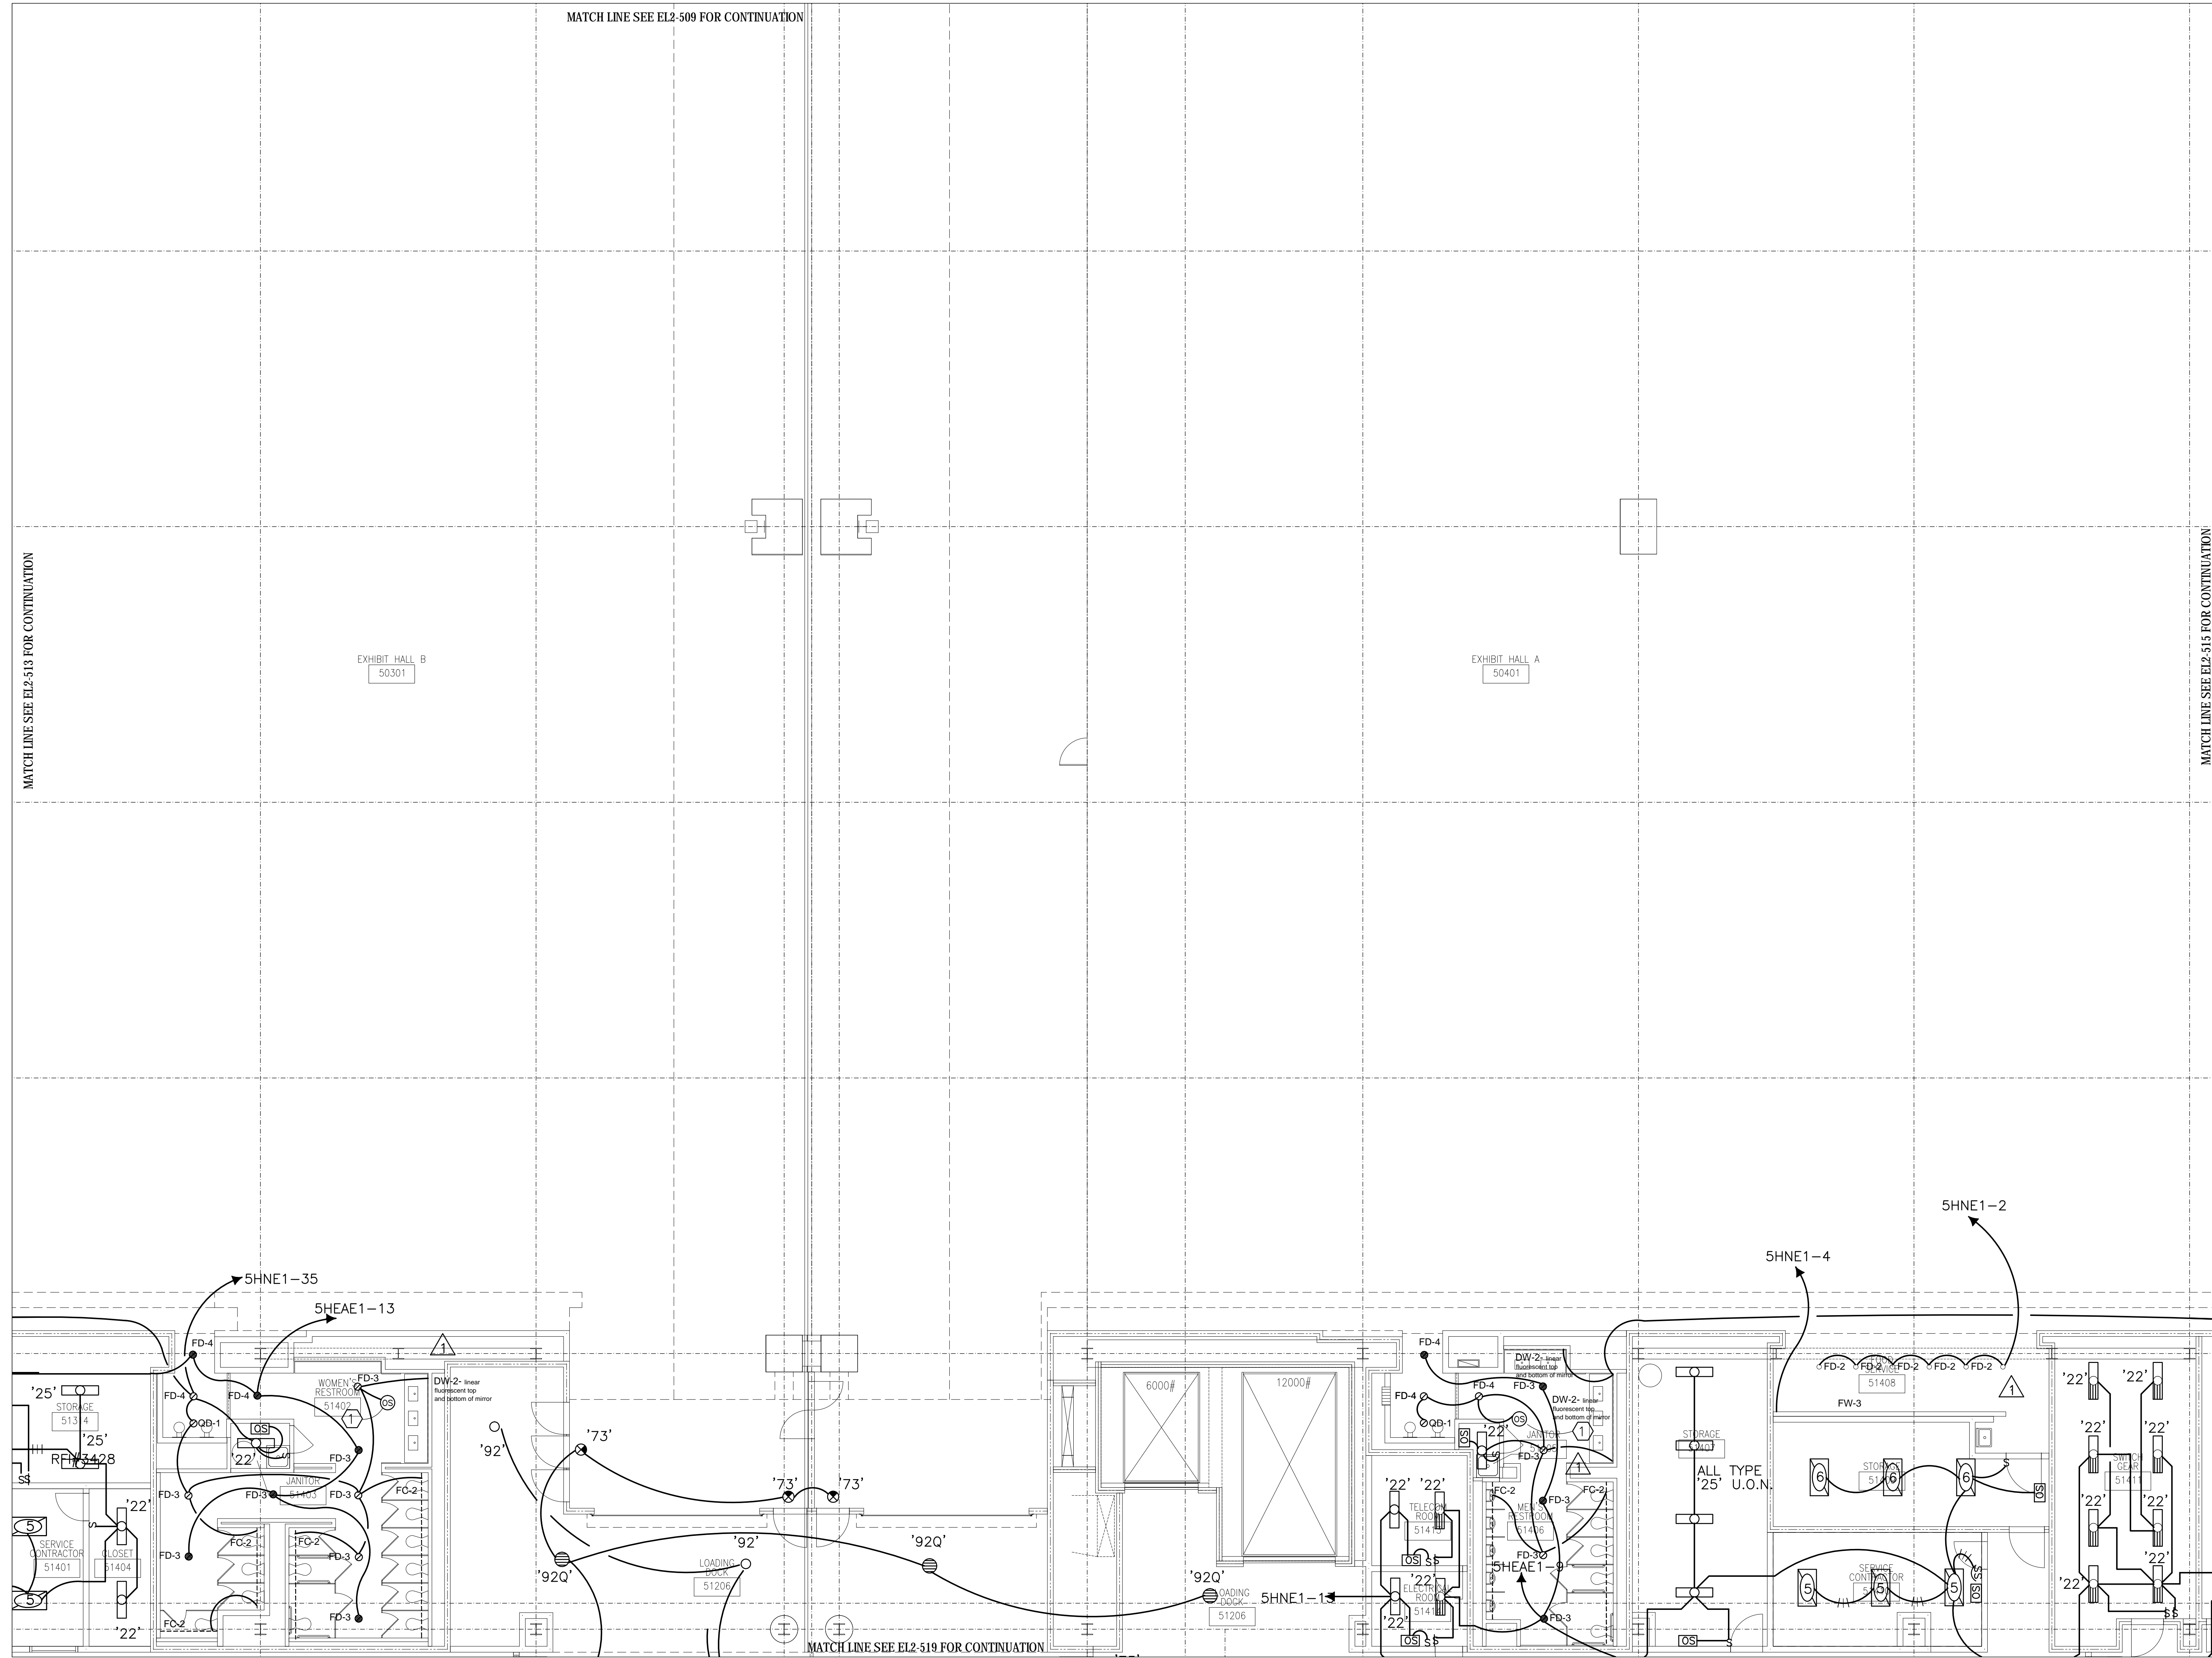


FILE PATH FOR CAD DEPARTMENT USE ONLY: P:\3000\Conti\Electric\Zone14\Level 5\Bldg 4\Bldg 4-514\Zone 14 Lighting\Zone 14 Lighting.dwg

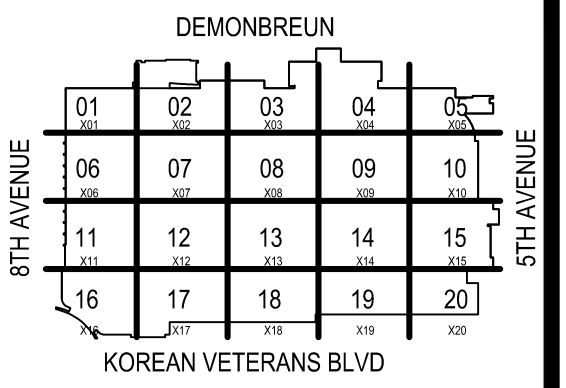

COORDINATION SIGN-OFF

| COMPANY | TRADE | DATE |
|---------|-------|------|
| CONTI | ELEC. | / / |
| | | / / |
| | | / / |
Music City Center
 Nashville, Tennessee

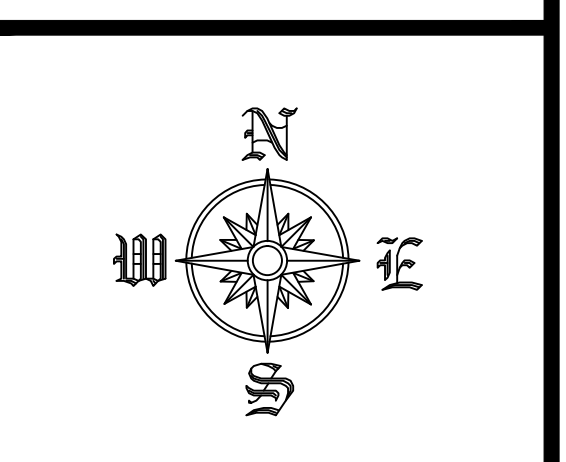

REVISIONS


| NO. | DATE | DESCRIPTION |
|-----|------|-------------|
| | | |
| | | |
RECORD DRAWINGS STAMP

CONTELECTRIC DATE (last Update):
 2/20/2019 8:00 AM
 DRAWING FILE NAME:
 EL2-15
 CAD OPERATOR:
 GERTMAN
 PRINTED BY:
 FREDMAN GREGG
 PLOT DATE:
 6/4/2019 8:04 AM
 SUBMITTED BY:
 G.L.P.
 ASSIGNED TO:

LEVEL 5 LIGHTING
 ZONE 15
 SCALE: 1/8" = 1'-0"

EL2-515

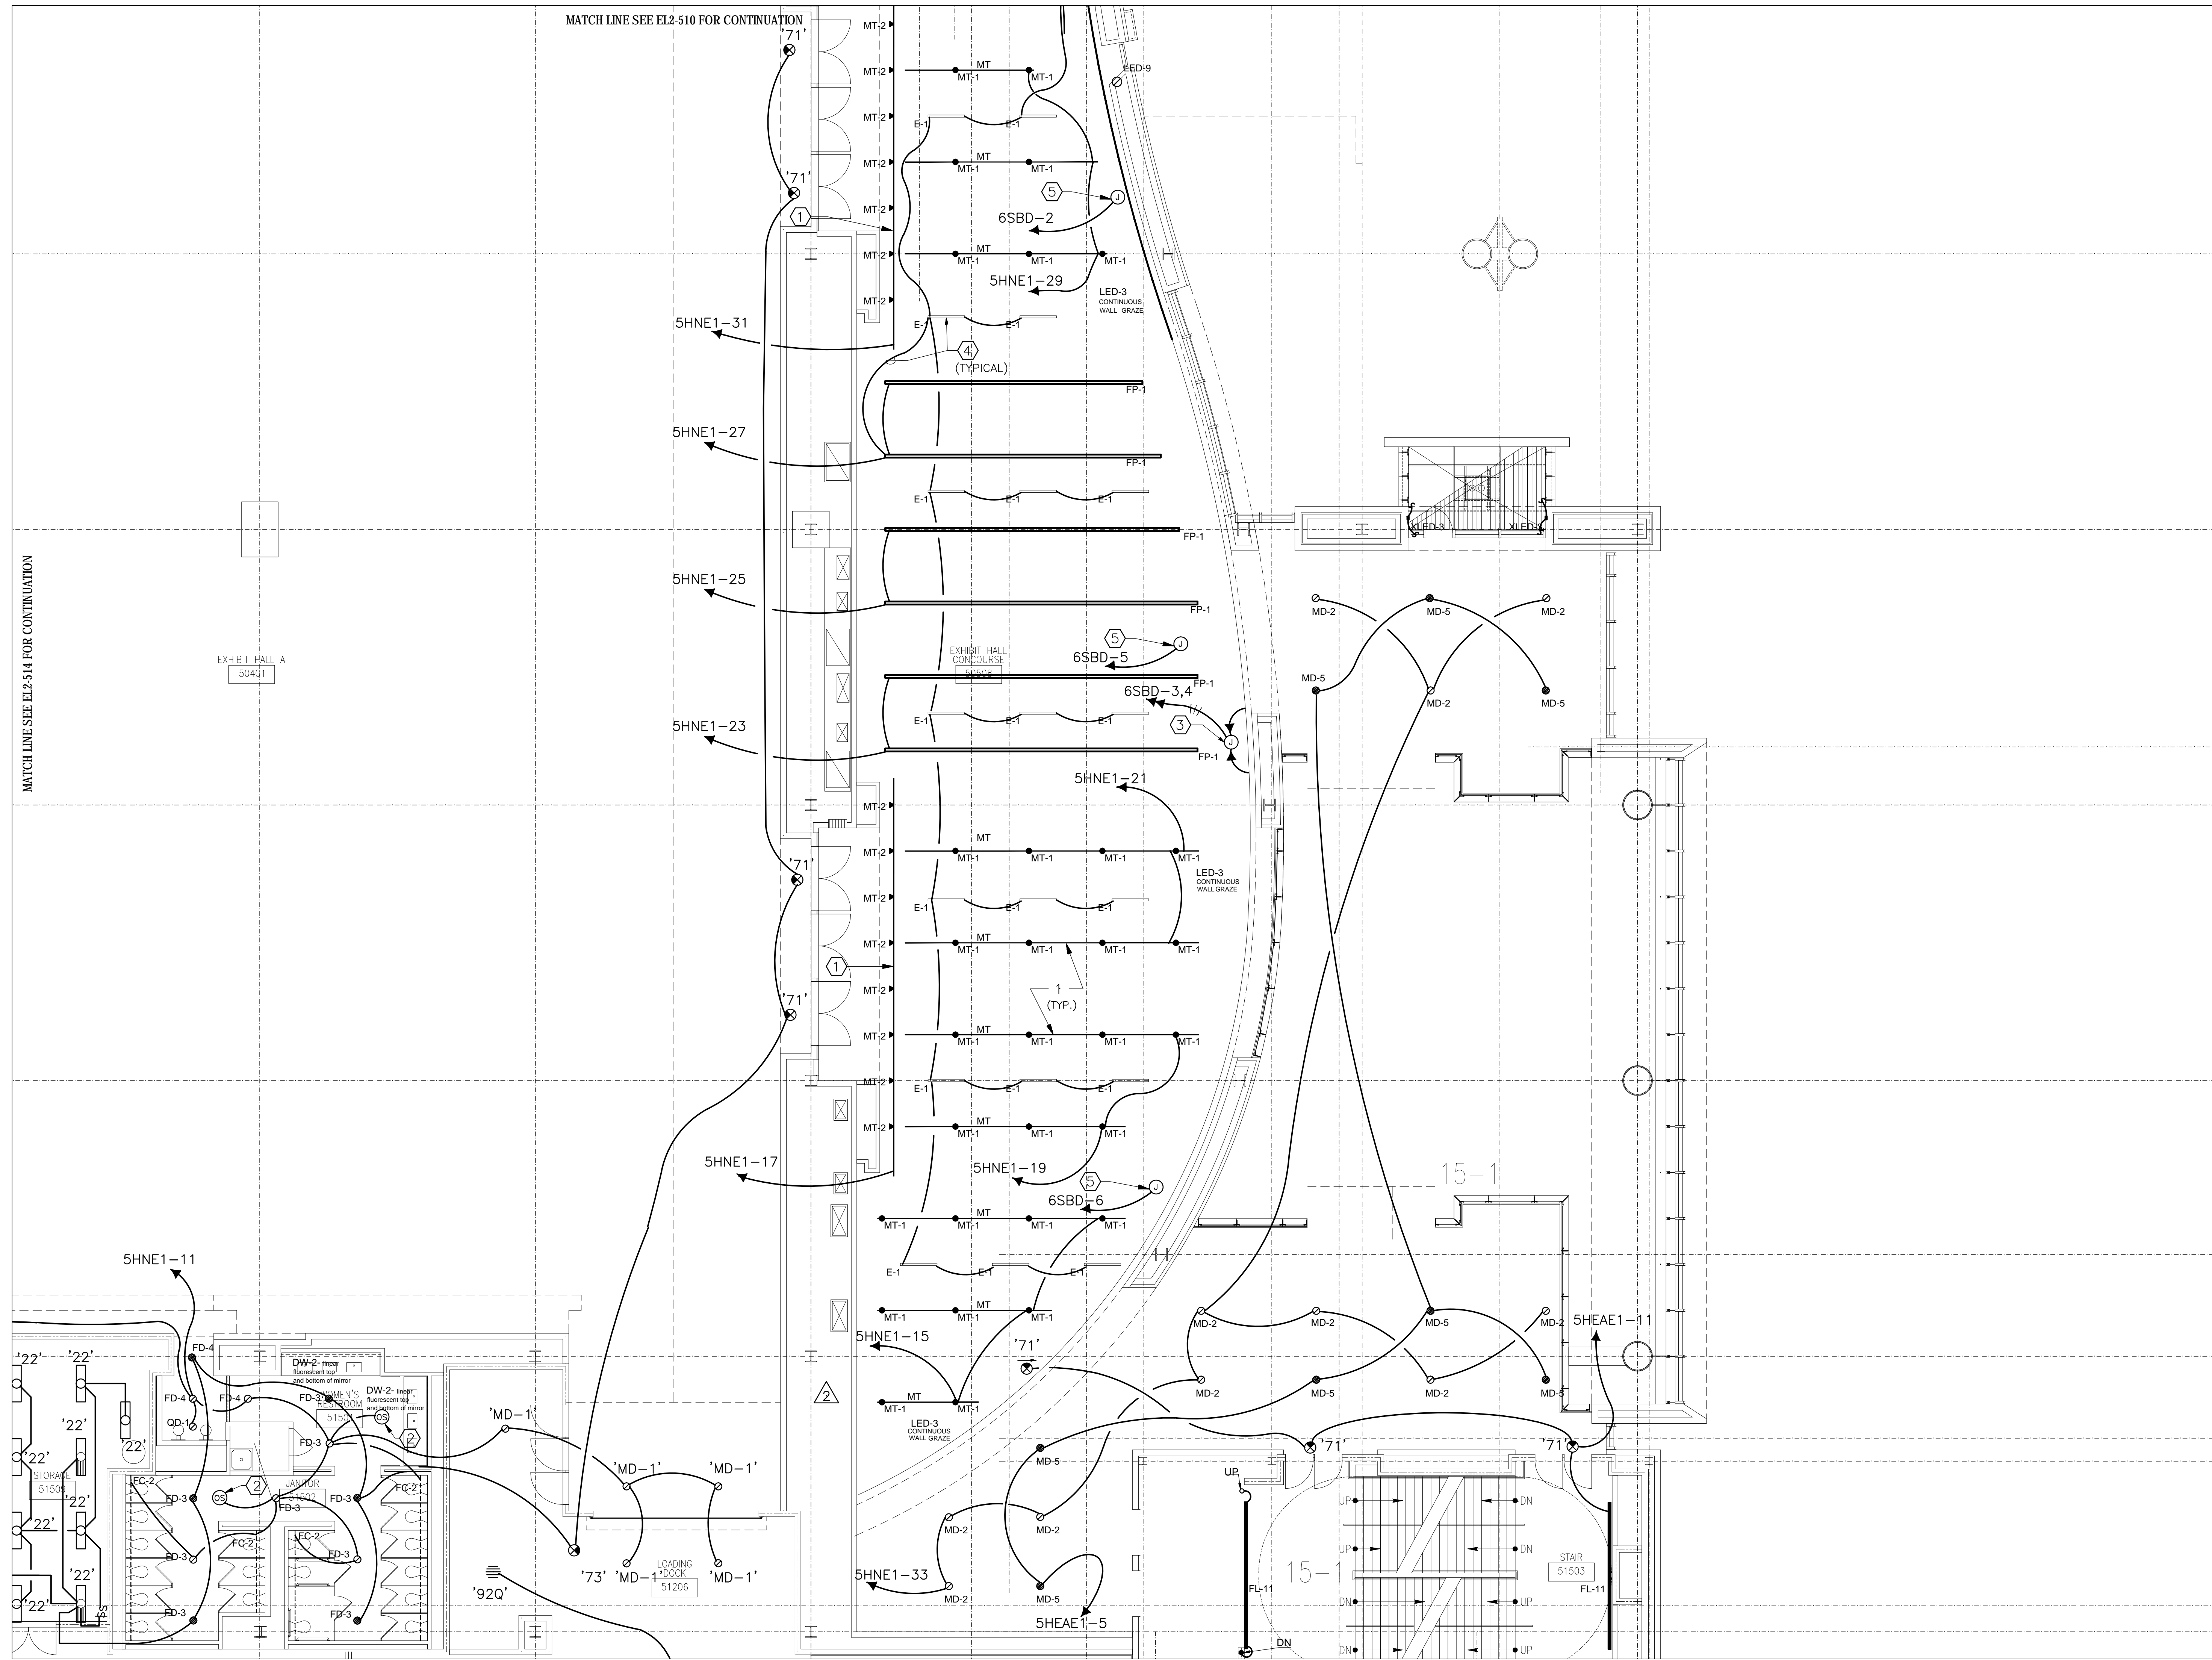


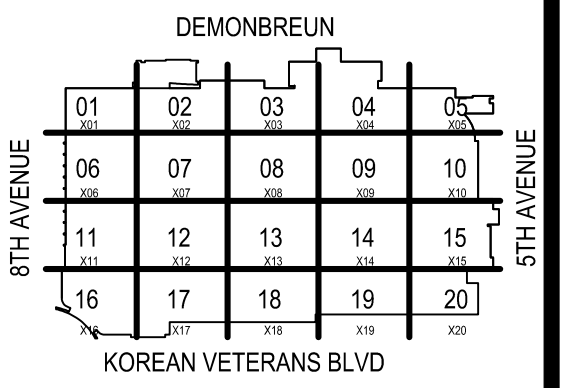

KEY PLAN
NO SCALE

| COORDINATION SIGN-OFF | |
|-----------------------|------|
| COMPANY | DATE |
| CONTRACTOR | / / |
| OWNER | / / |
| ARCHITECT | / / |
| ELECTRICIAN | / / |
| MECHANICAL | / / |
| PLUMBING | / / |
| OTHER | / / |

Music City Center
Nashville, Tennessee

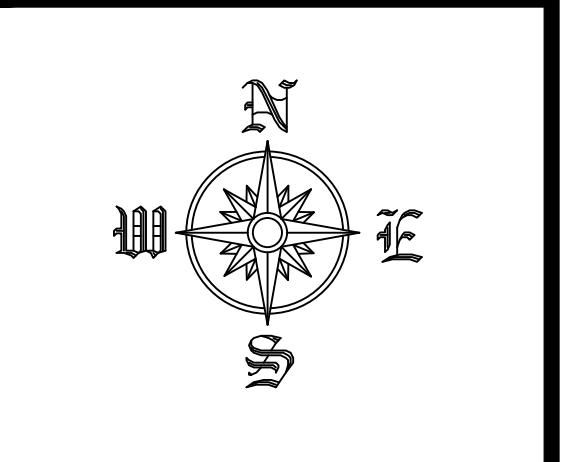

| REVISIONS | | |
|-----------|------|-------------|
| NO. | DATE | DESCRIPTION |
| | | |
| | | |
RECORD DRAWINGS STAMP

CONTI ELECTRIC DATE (Last Update):
 2/20/2012 8:00 AM

DRAWING FILE NAME:
 EL2-516

CAD OPERATOR:
 GREGG

PRINTED BY:
 FREDMAN, GREGG


PLOT DATE:
 6/4/2012 8:04 AM

SUBMITTED BY:
 GREGG

ASSIGNED TO:

LEVEL 5 LIGHTING
 ZONE 16
 SCALE: 1/8" = 1'-0"


EL2-516

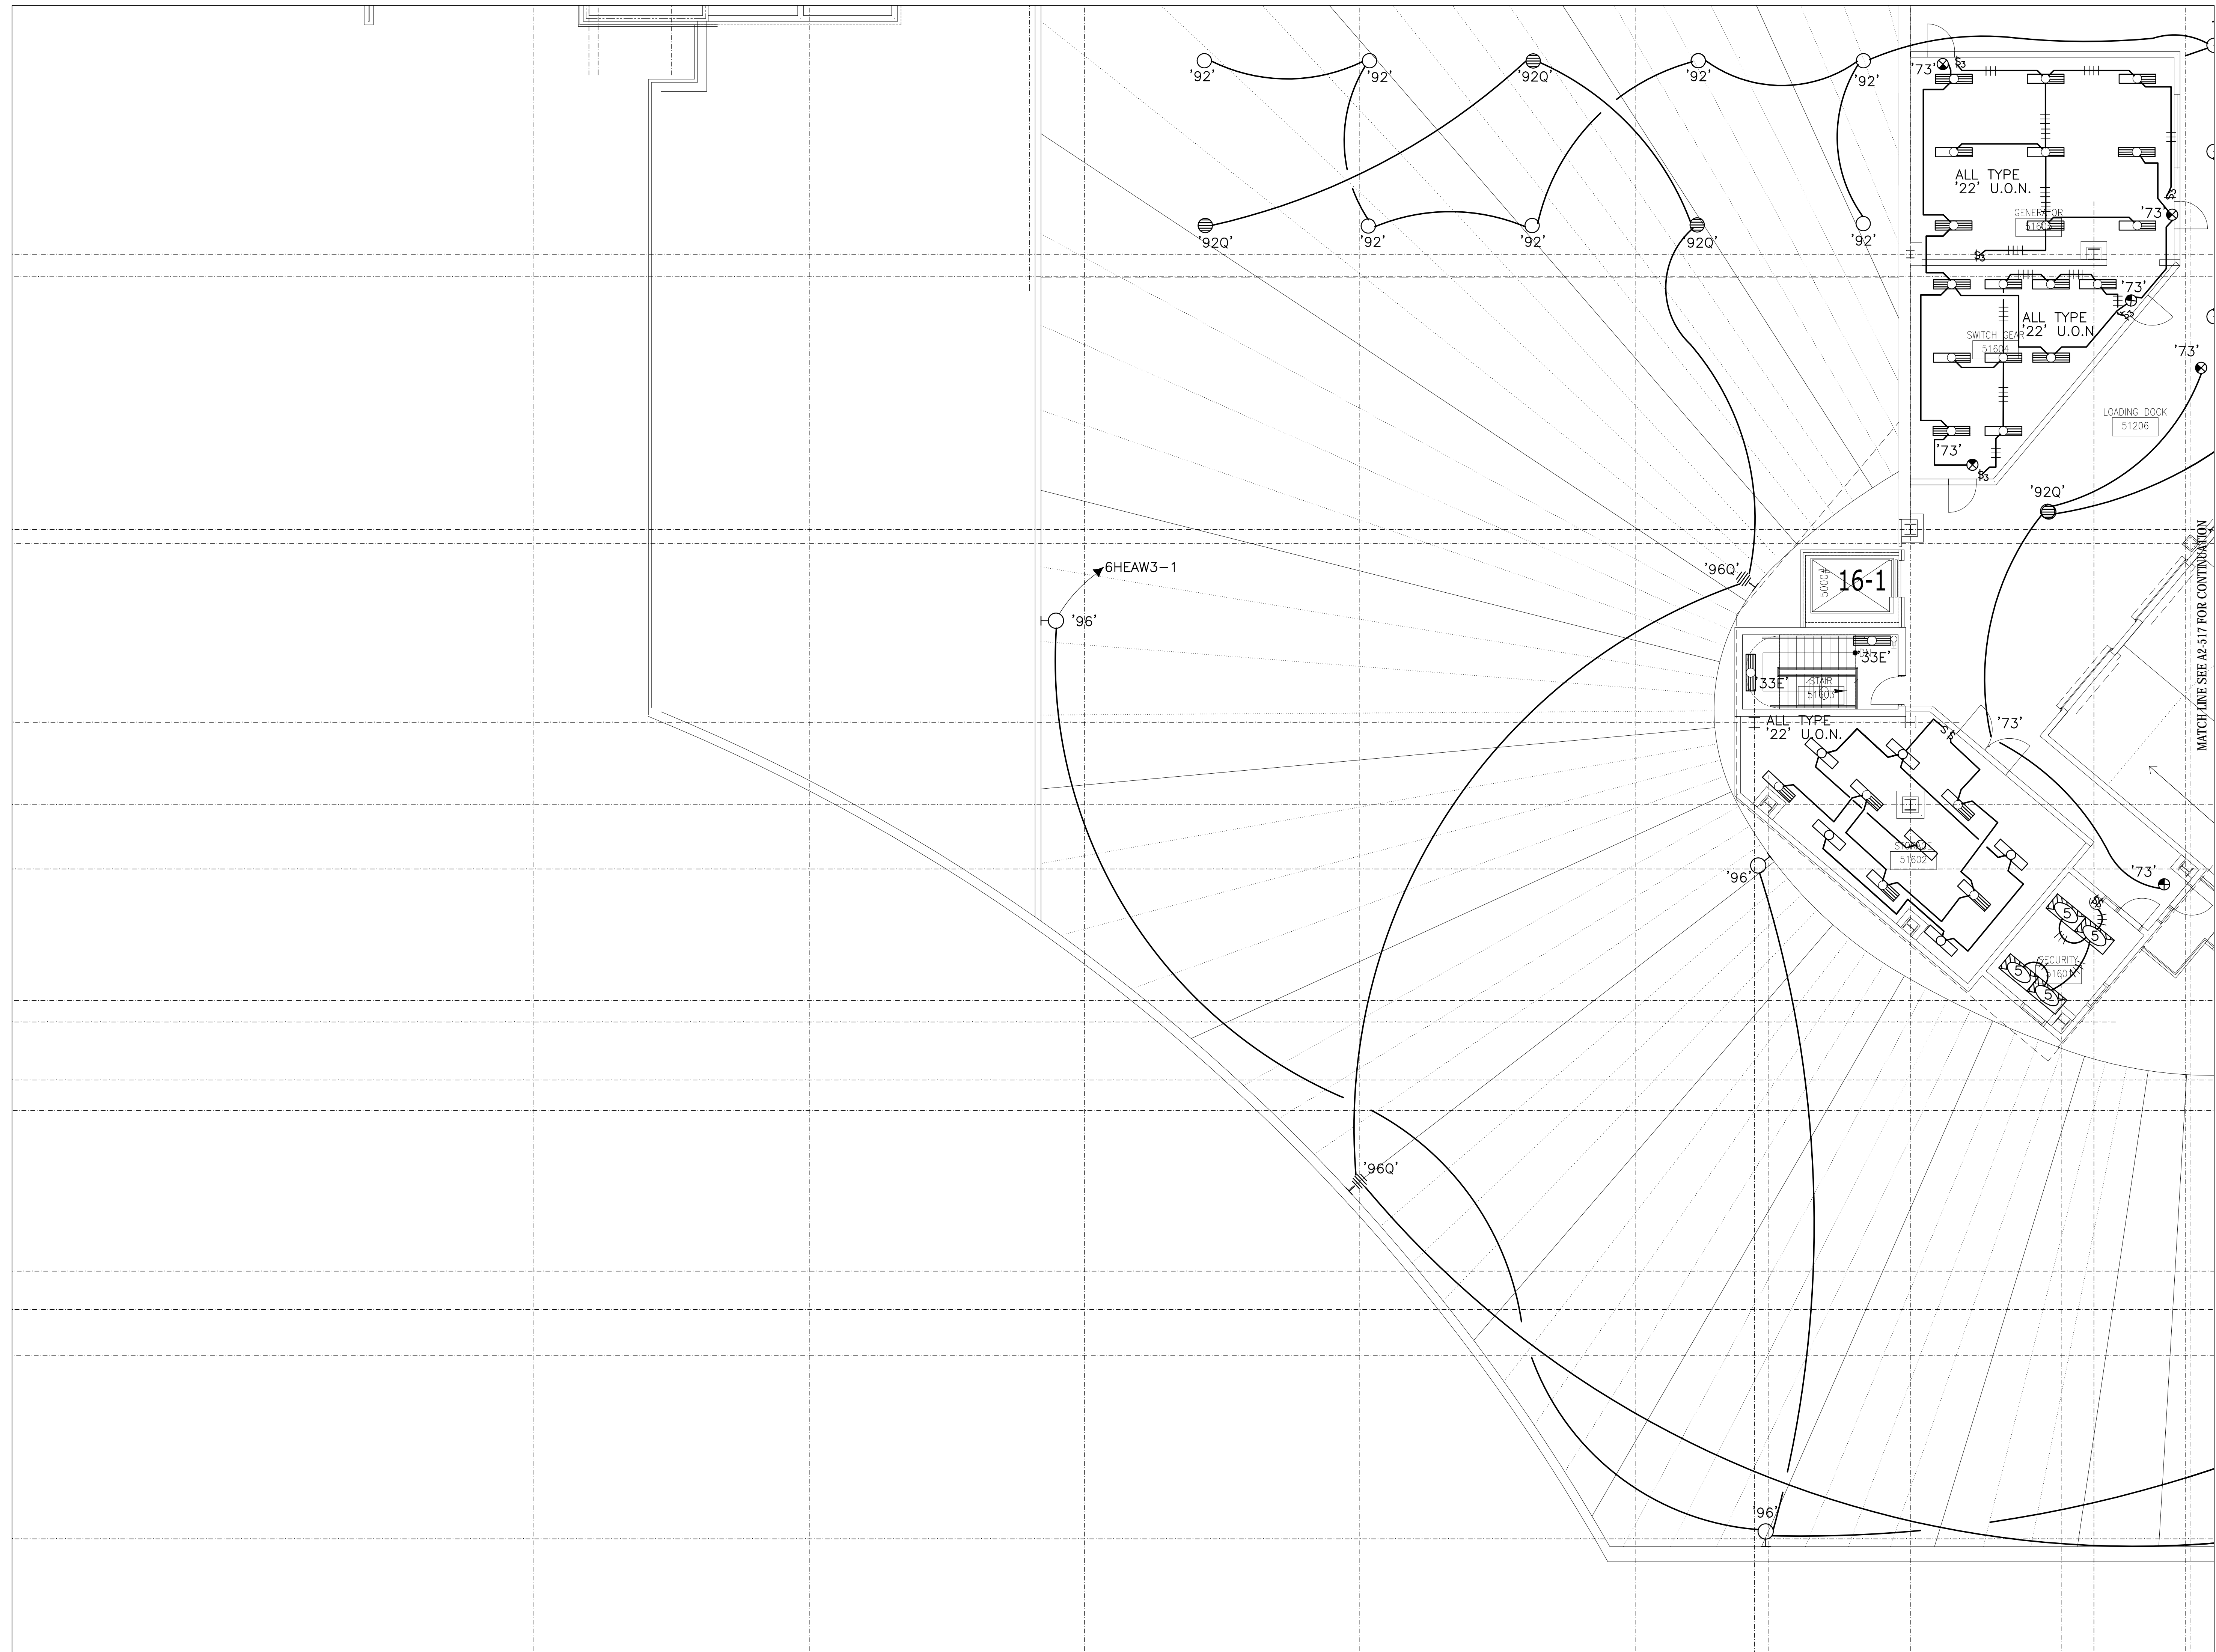

DEMOMBREUN

| | | | | |
|----|----|----|----|----|
| 01 | 02 | 03 | 04 | 05 |
| 06 | 07 | 08 | 09 | 10 |
| 11 | 12 | 13 | 14 | 15 |
| 16 | 17 | 18 | 19 | 20 |


KOREAN VETERANS BLVD
 KEY PLAN
 NO SCALE

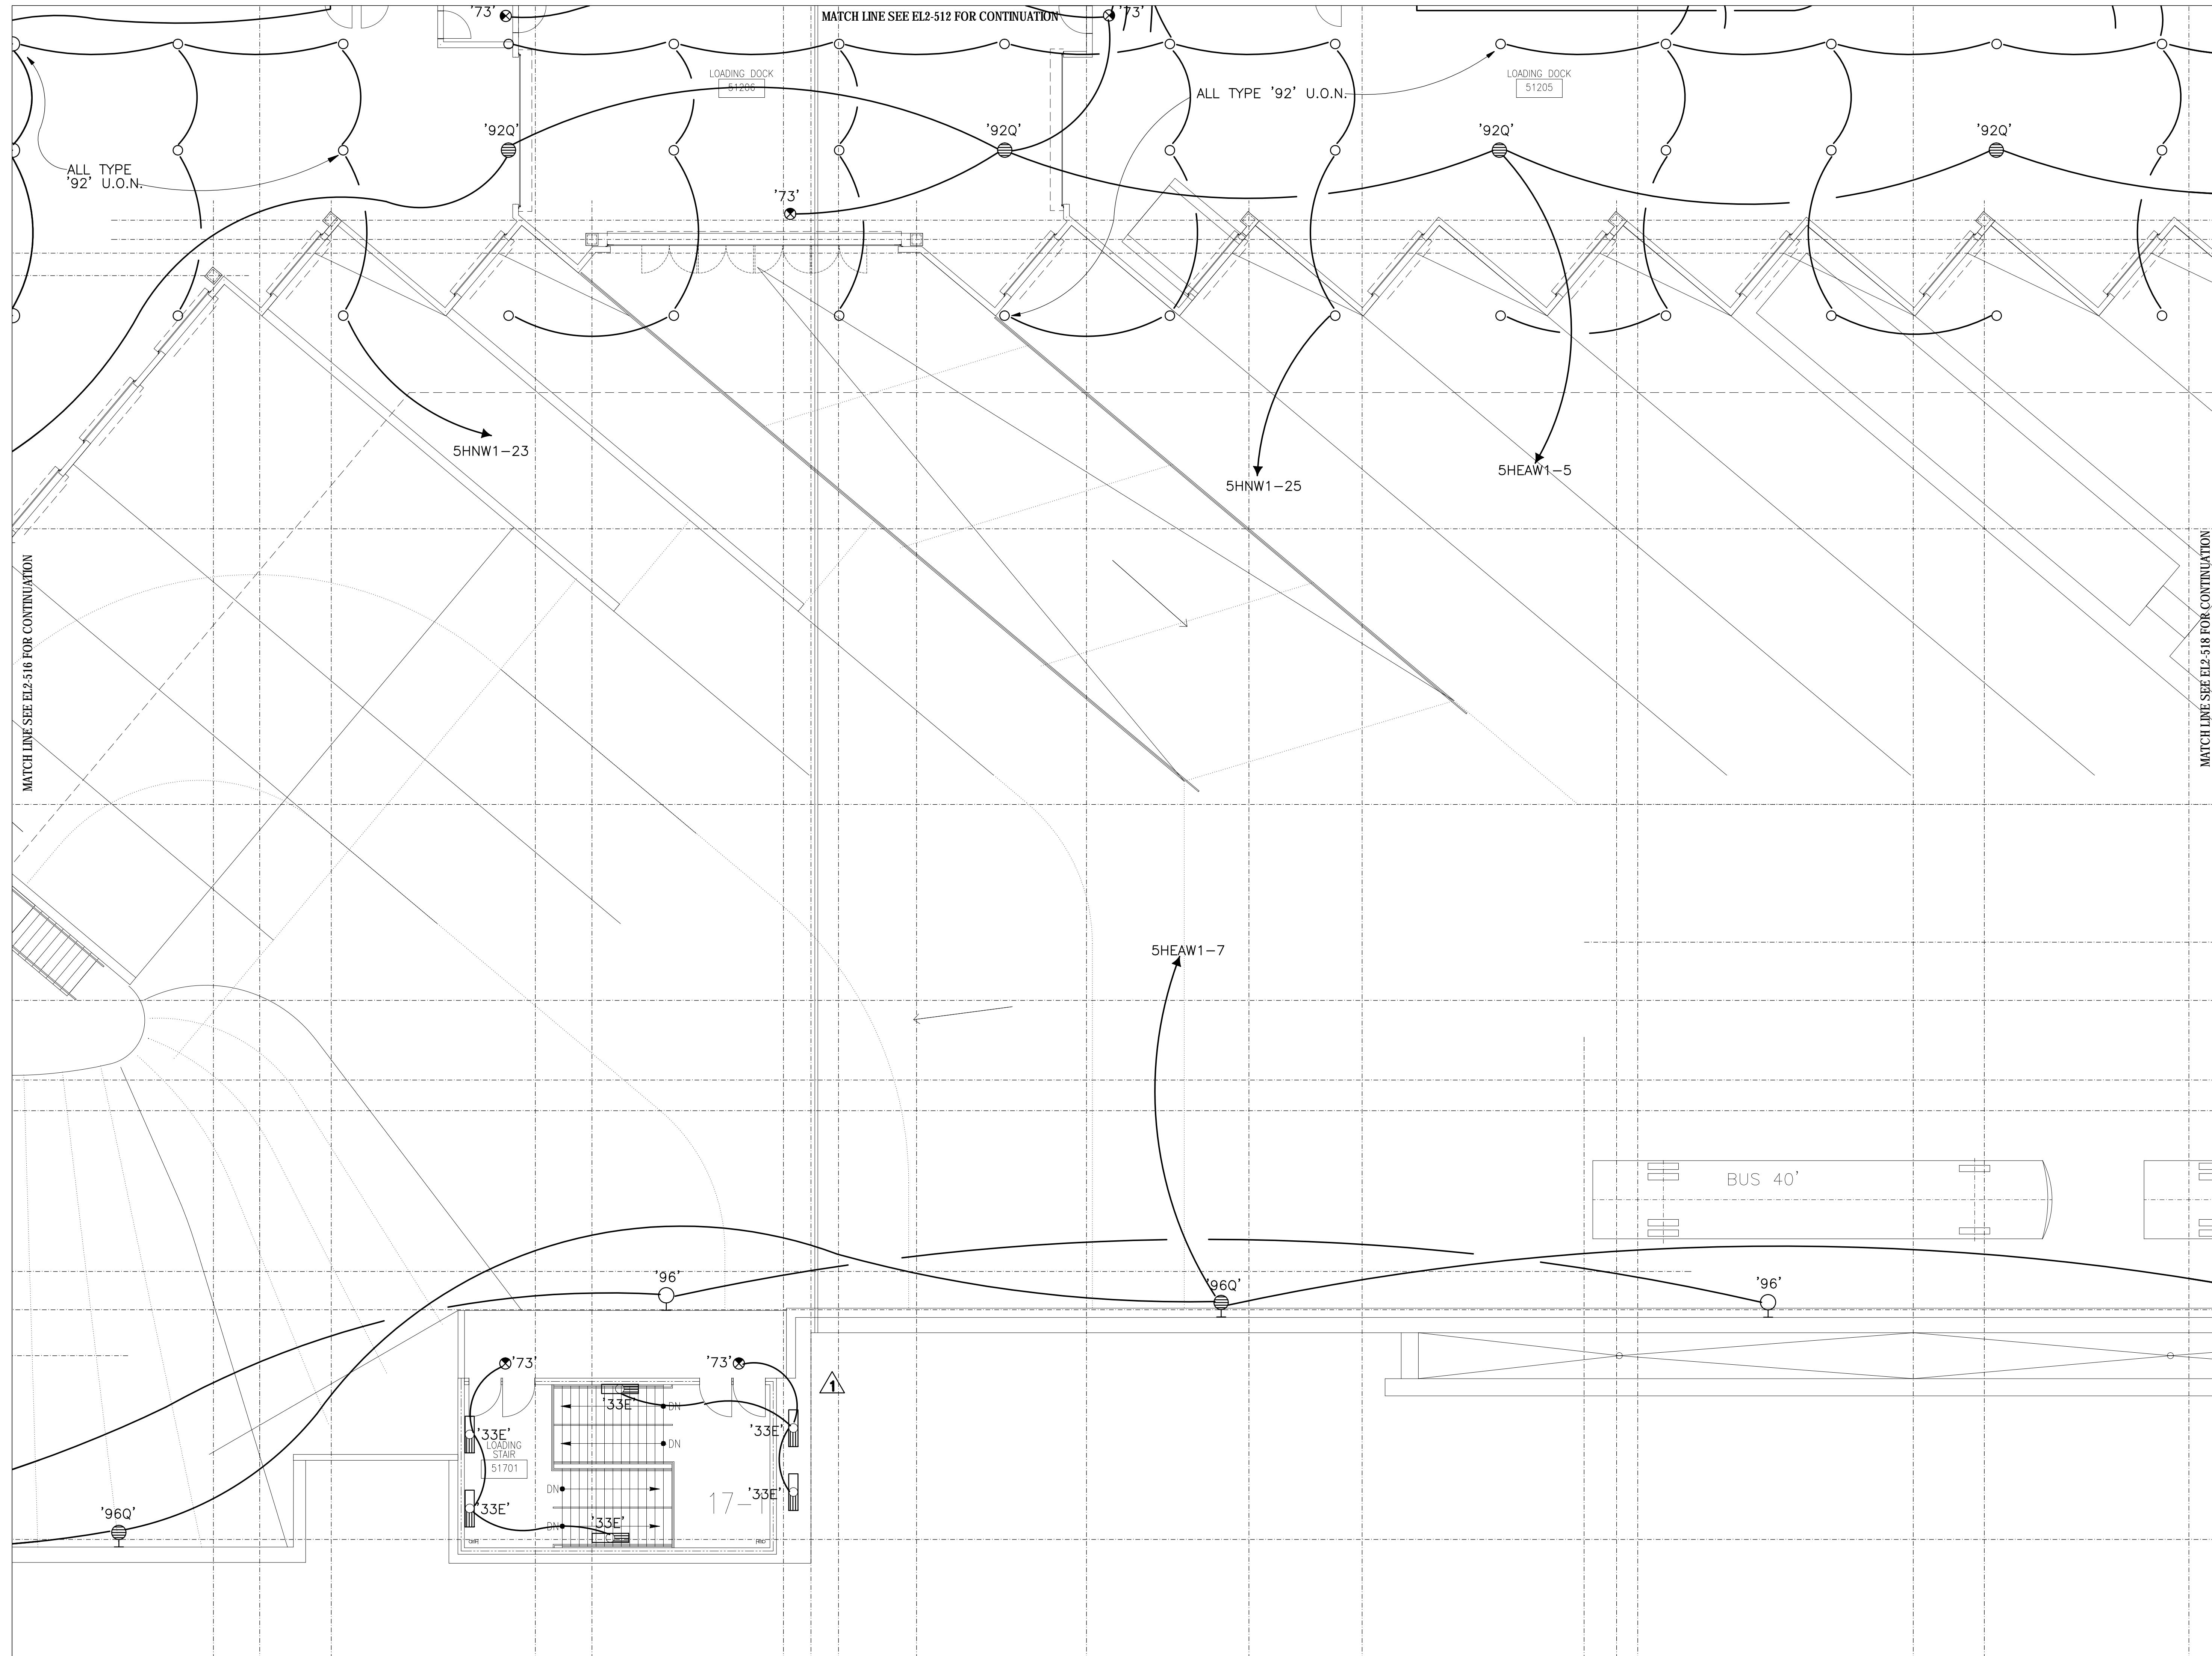

COORDINATION SIGN-OFF

| | | | | | | |
|---------|---|---|---|---|---|---|
| DATE | / | / | / | / | / | / |
| NAME | | | | | | |
| TRADE | | | | | | |
| ELEC. | | | | | | |
| COMPANY | | | | | | |
| CDTI | | | | | | |

Music City Center
 Nashville, Tennessee

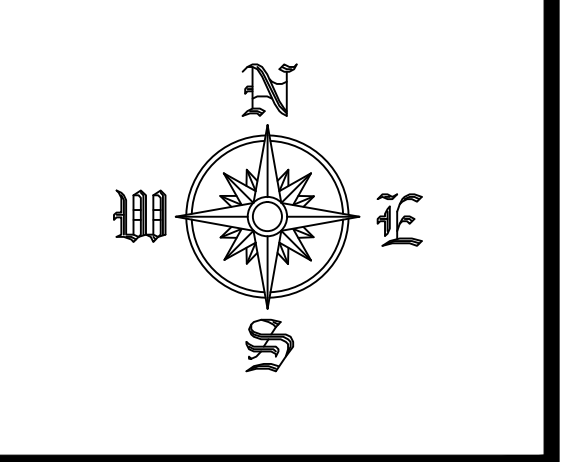

REVISIONS


| NO. | DATE | DESCRIPTION |
|-----|------|-------------|
| | | |
| | | |
RECORD DRAWINGS STAMP

CONTI ELECTRIC DATE (Last Update):
 2/29/2012 8:00 AM
 DRAWING FILE NAME:
 EL2-17
 CAD OPERATOR:
 GERTMAN
 PRINTED BY:
 FREDMAN, GREGG
 PLOT DATE:
 6/4/2012 8:00 AM
 SUBMITTED BY:
 G.L.P.
 ASSIGNED TO:

LEVEL 5 LIGHTING
 ZONE 17
 SCALE: 1/8" = 1'-0"


EL2-517

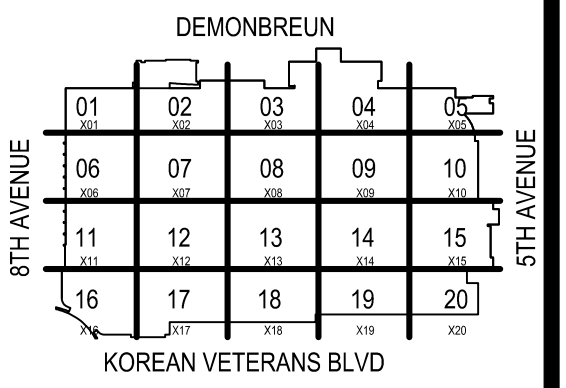

COORDINATION SIGN-OFF

| COMPANY | TRADE | DATE |
|---------|-------|------|
| CONTI | ELEC. | / / |
| | | / / |
| | | / / |
Music City Center
 Nashville, Tennessee

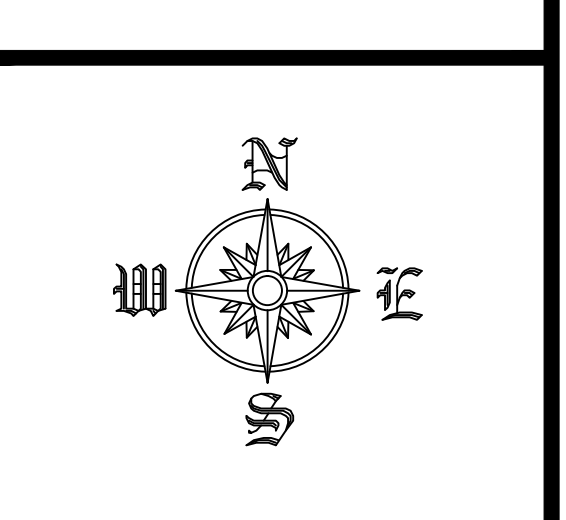

REVISIONS

| NO. | DATE | DESCRIPTION |
|-----|------|-------------|
| | | |
| | | |
| | | |
| | | |

RECORD DRAWINGS STAMP

CONTI ELECTRIC DATE (Last Update):
 2/20/2012 8:00 AM

DRAWING FILE NAME:
 EL2-518

CAD OPERATOR:
 GREGG

PRINTED BY:
 FREDMAN, GREGG


PLOT DATE:
 6/4/2012 8:00 AM

SUBMITTED BY:
 GREGG

ASSIGNED TO:

LEVEL 5 LIGHTING
 ZONE 18
 SCALE: 1/8" = 1'-0"


EL2-518

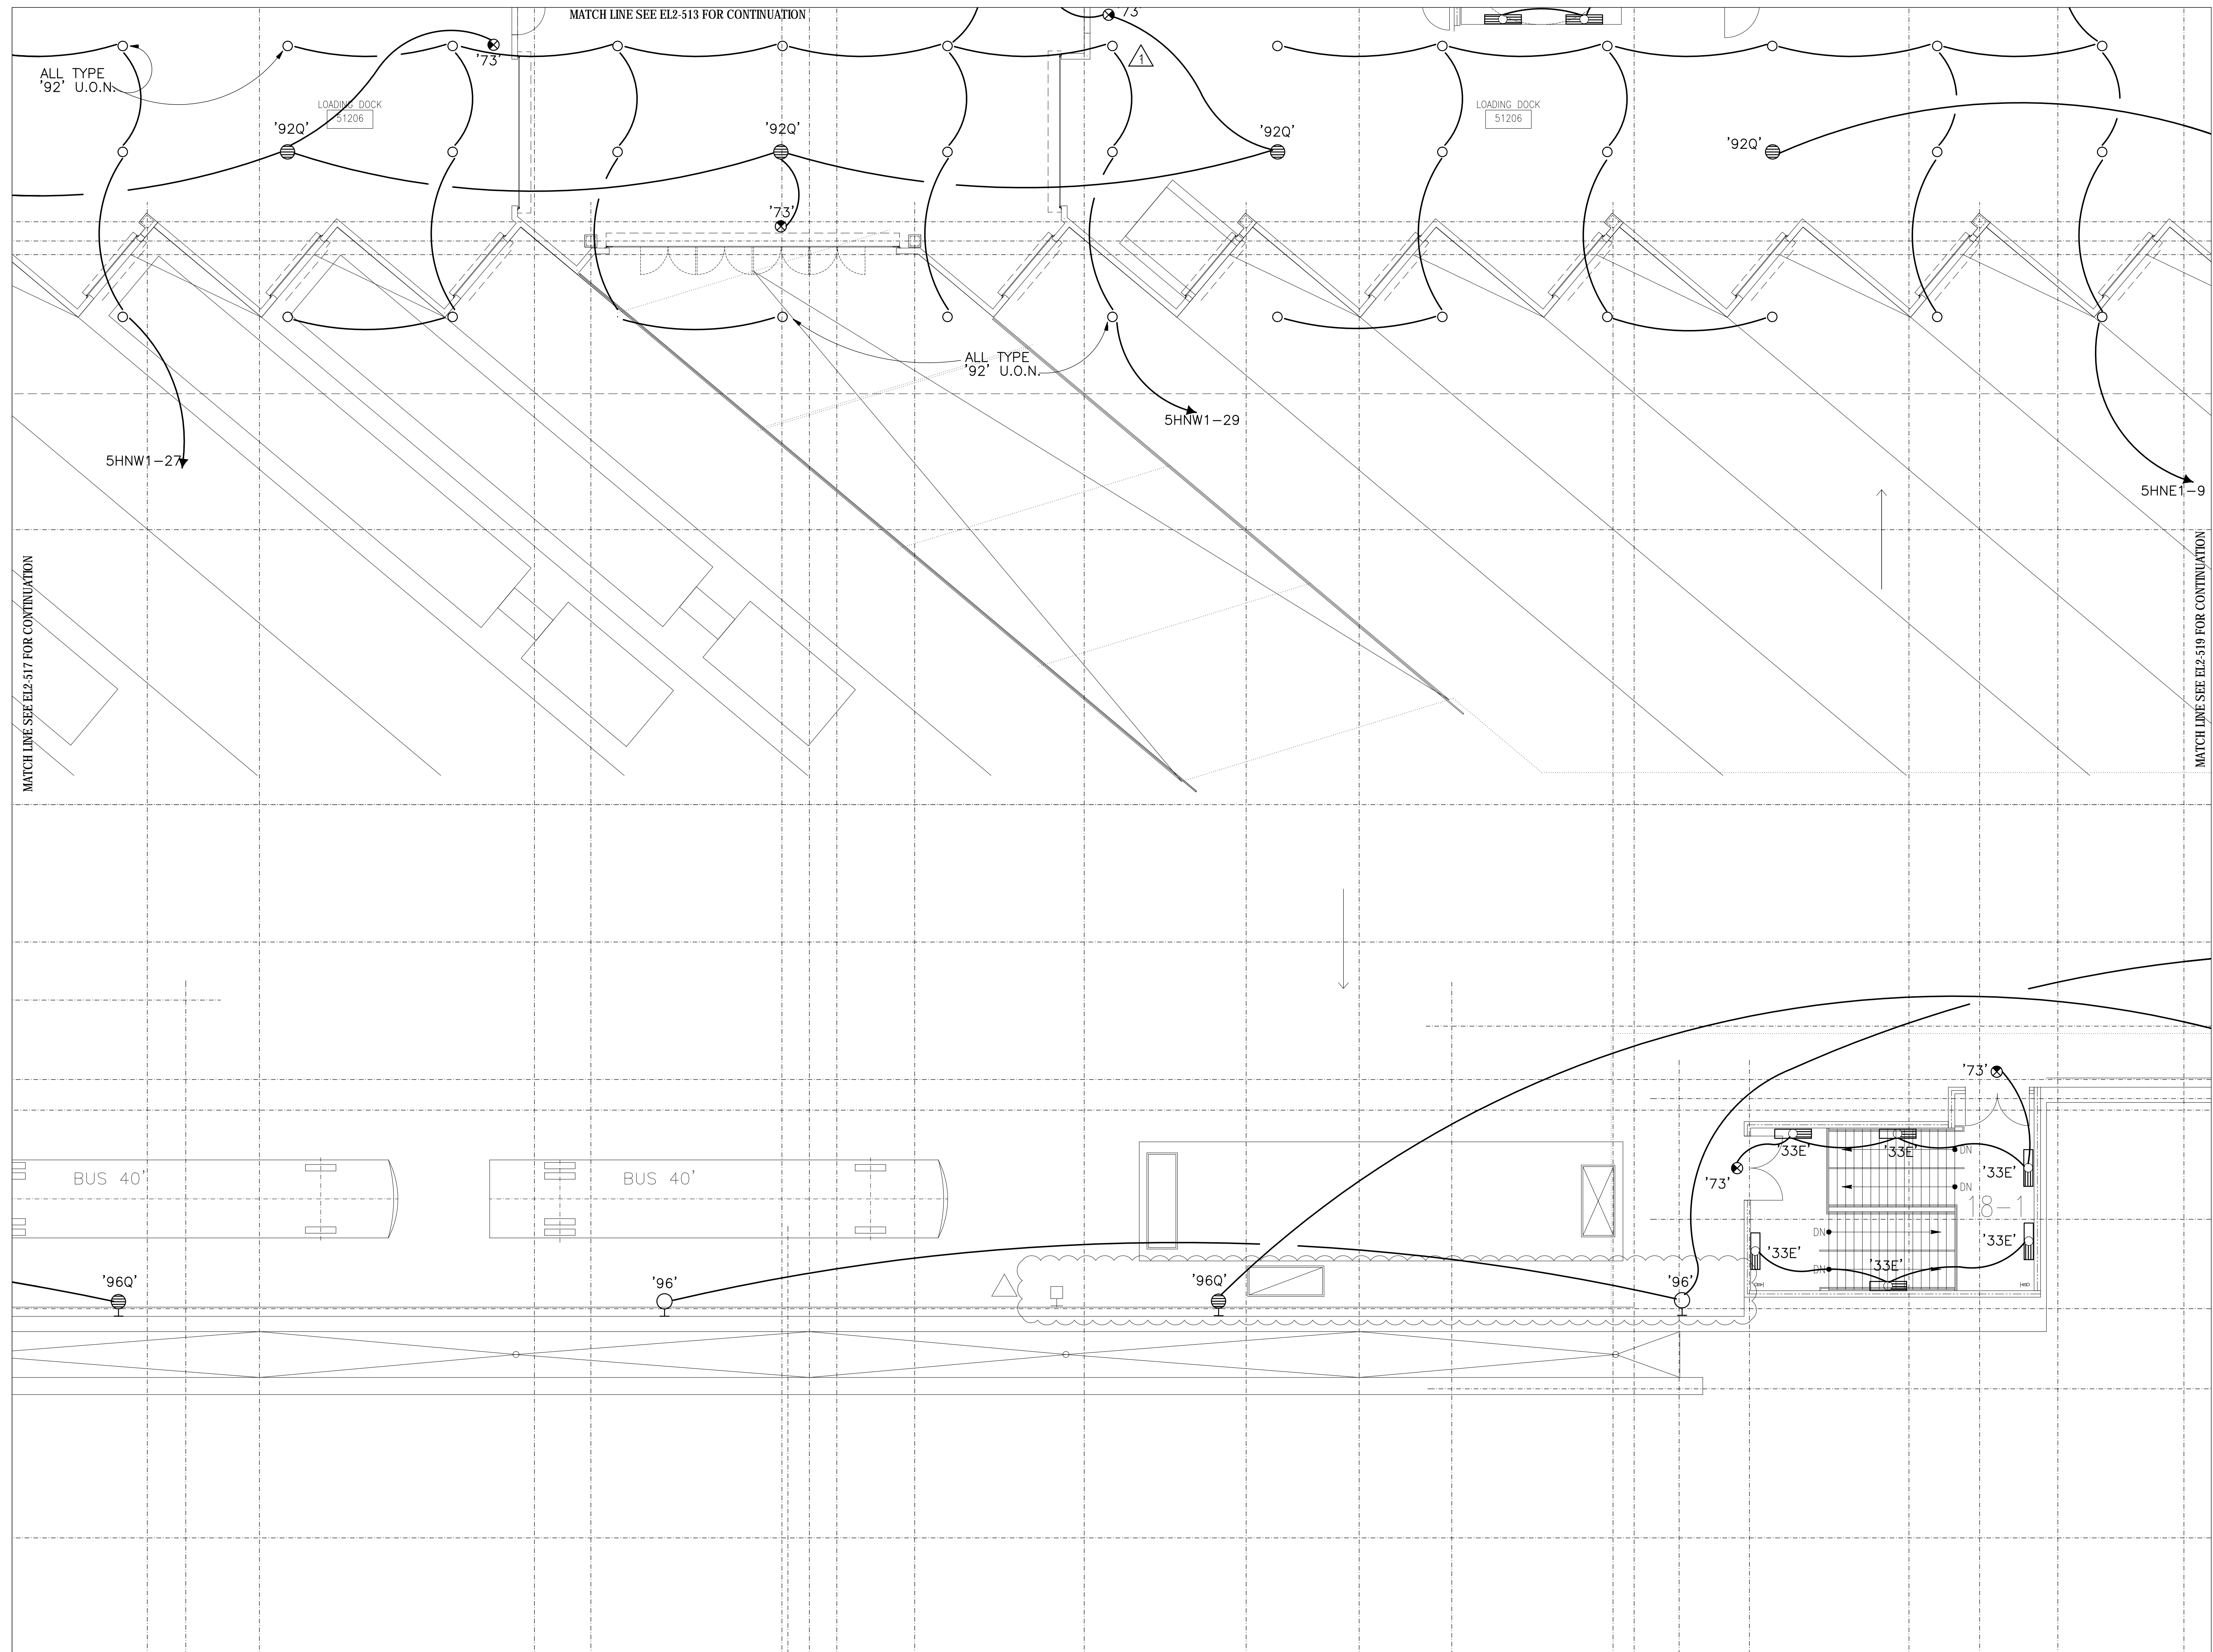

DEMOMBREUN

| | | | |
|----|----|----|----|
| 01 | 02 | 03 | 04 |
| 06 | 07 | 08 | 09 |
| 11 | 12 | 13 | 14 |
| 16 | 17 | 18 | 19 |
| 21 | 22 | 23 | 24 |


KOREAN VETERANS BLVD
 KEY PLAN
 NO SCALE

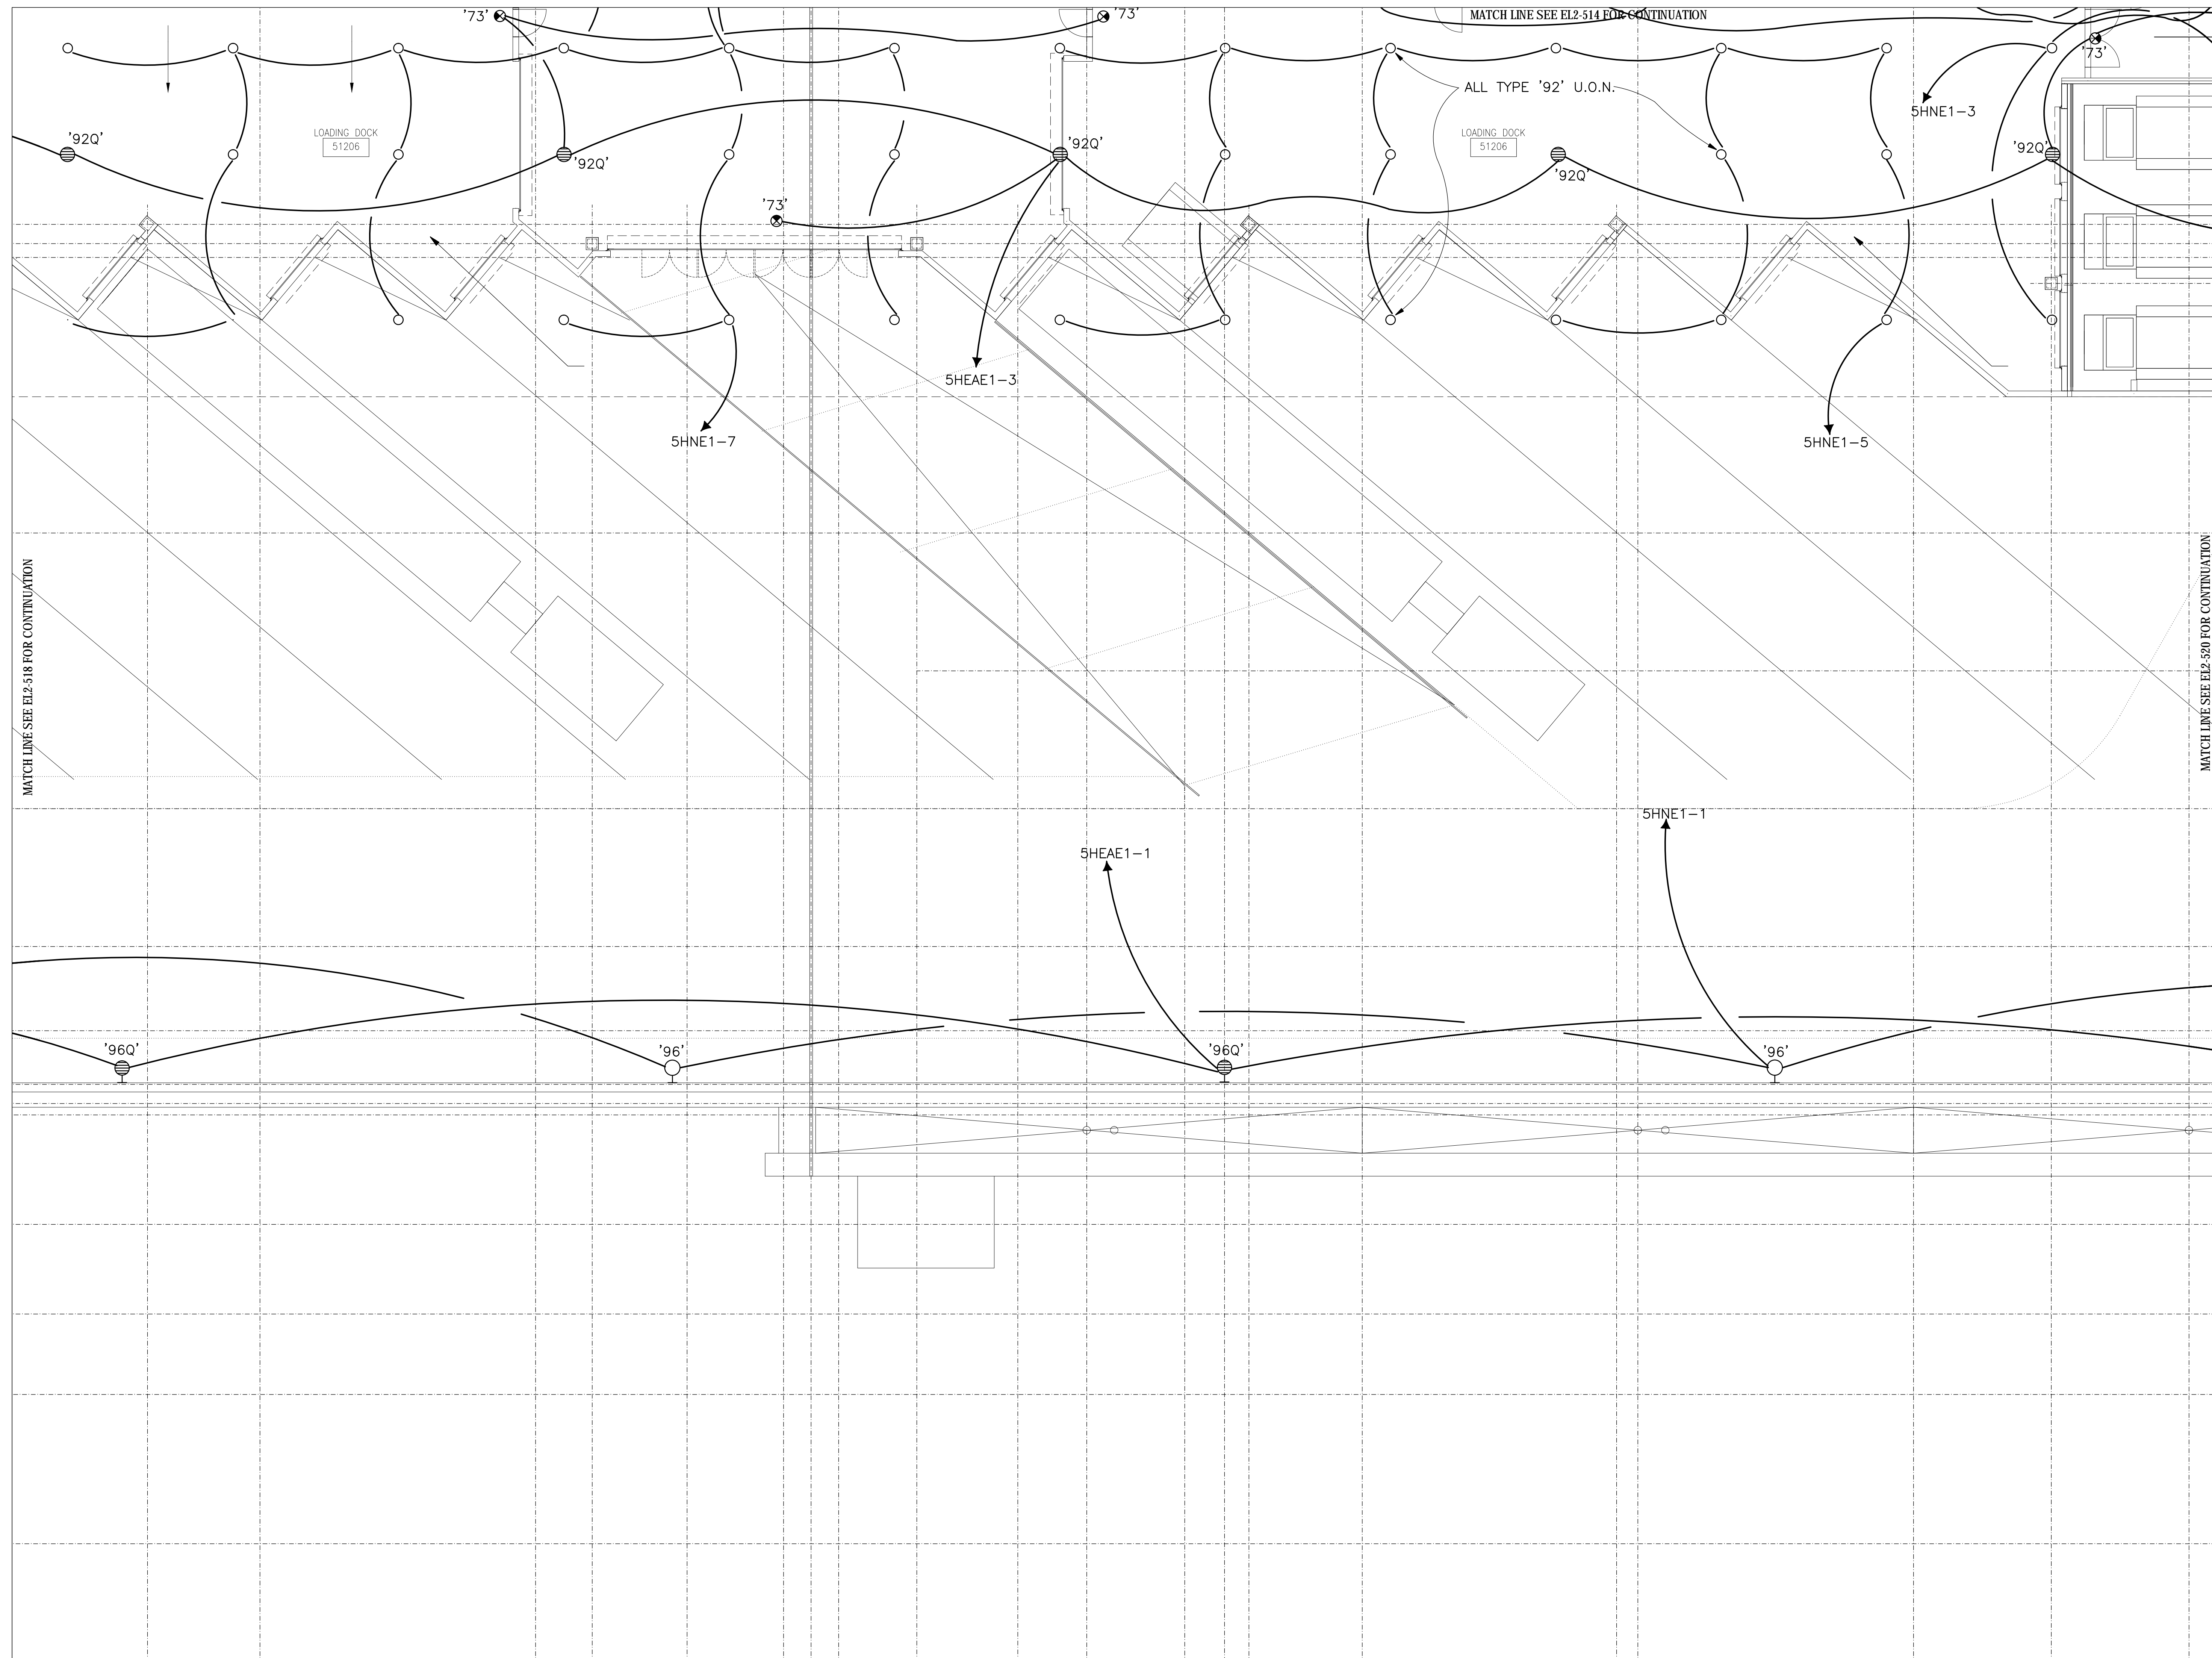

COORDINATION SIGN-OFF

| COMPANY | TRADE | DATE |
|---------|-------|------|
| CONTI | ELEC. | / / |
| | | / / |
| | | / / |
Music City Center
 Nashville, Tennessee

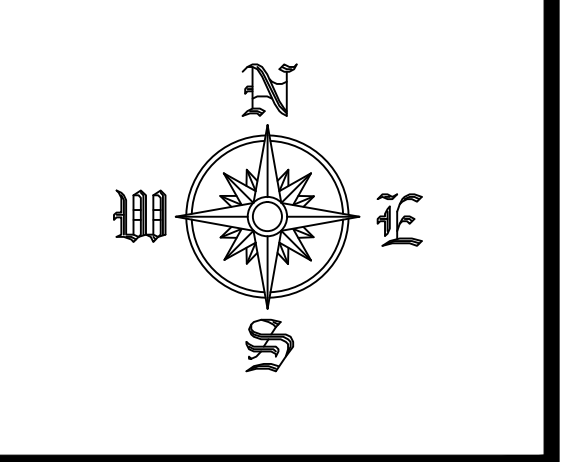

REVISIONS

| NO. | DATE | DESCRIPTION |
|-----|------|-------------|
| | | |
| | | |
RECORD DRAWINGS STAMP

CONTI ELECTRIC DATE (Last Update):
 2/20/2012 8:00 AM

DRAWING FILE NAME:
 EL2-19

CAD OPERATOR:
 GERTMAN

PRINTED BY:
 FREDMAN, GREGG

PLOT DATE:
 6/4/2012 8:00 AM



SUBMITTED BY:
 G.L.P.

ASSIGNED TO:

LEVEL 5 LIGHTING
 ZONE 19
 SCALE: 1/8" = 1'-0"

EL2-519


FILE PATH FOR CAD DEPARTMENT USE ONLY: E:\2012\Conti Electric\Projects\MCC\Zone 19 - Level 5 - Ballin - 4/13/12\Zone 19 Lighting - Submittal For Permit.dwg

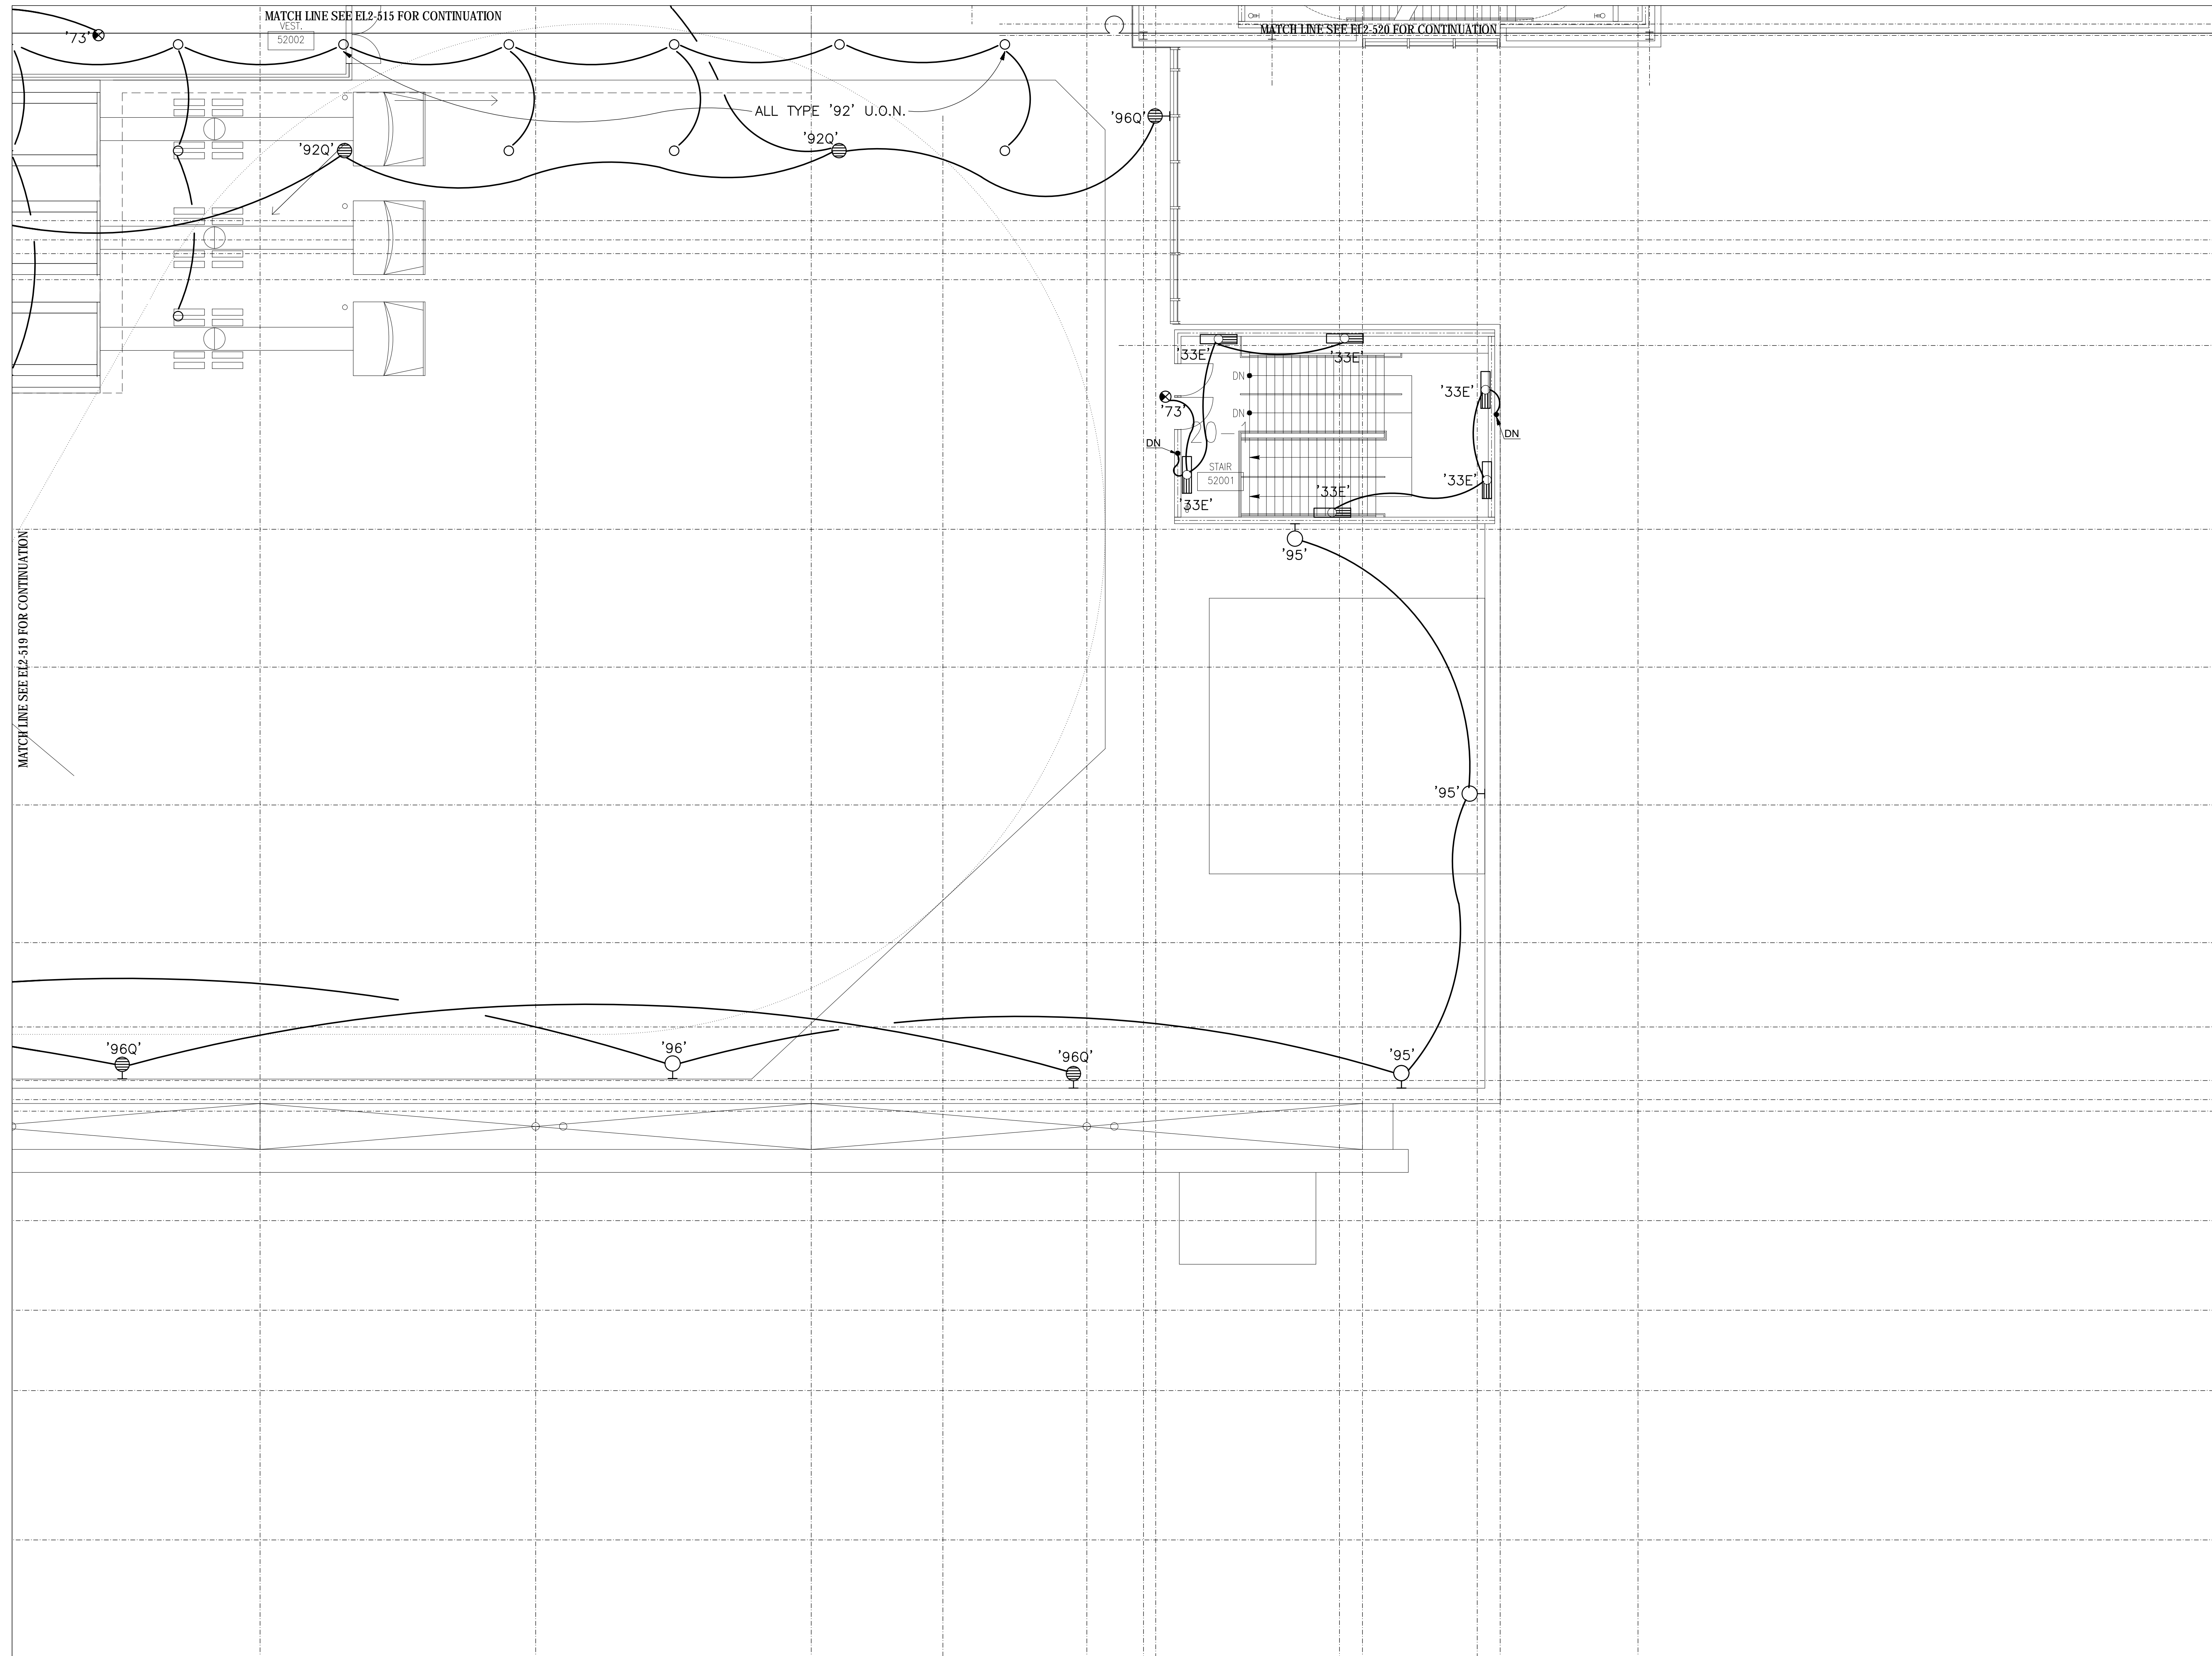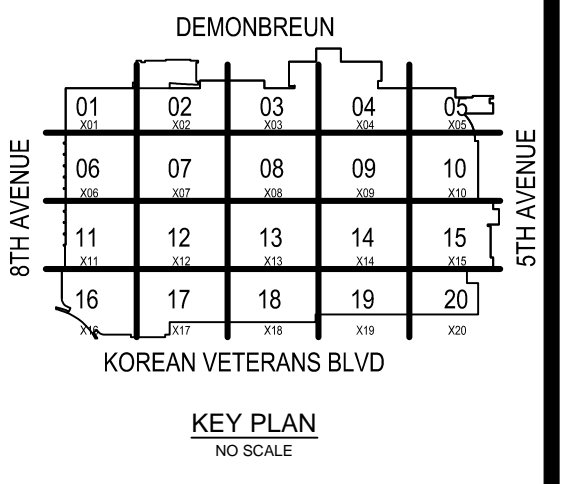

COORDINATION SIGN-OFF

| COMPANY | TRADE | DATE |
|---------|-------|------|
| CONTI | ELEC. | / / |
| | | / / |
| | | / / |
Music City Center
Nashville, Tennessee

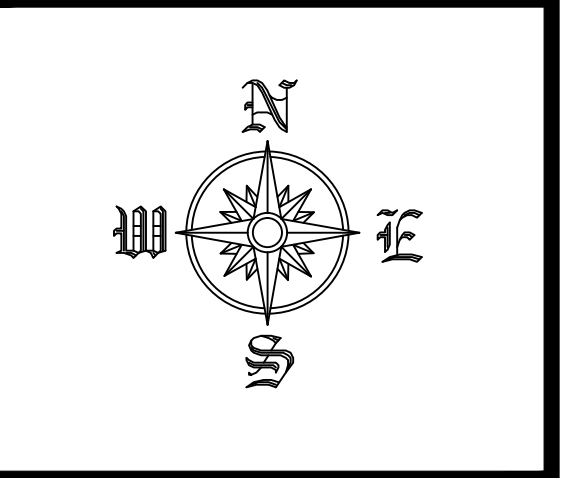

REVISIONS

| NO. | DATE | DESCRIPTION |
|-----|------|-------------|
| | | |
| | | |
RECORD DRAWINGS STAMP

CONTI ELECTRIC DATE (Last Update):
 2/20/2012 8:00 AM

DRAWING FILE NAME:
 EP-519

CAD OPERATOR:
 GERTMAN

PRINTED BY:
 FREDMAN, GREG

PLOT DATE:
 6/4/2012 8:00 AM

SUBMITTED BY:
 G.P.

ASSIGNED TO:

LEVEL 5 LIGHTING
 ZONE 20
 SCALE: 1/8" = 1'-0"

EL2-520

FILE PATH FOR CAD DEPARTMENT USE ONLY: P:\3085\Conti Electric\Nashville MusicCityCenter_City Center As-Built\4-13-12\Zone 20 Lighting_Schedule For Opening.dwg