


COORDINATION SIGN-OFF

| COMPANY | TRADE | DATE |
|---------|-------|------|
| CONTI | ELEC. | / / |
| | | / / |
| | | / / |
Music City Center
 Nashville, Tennessee

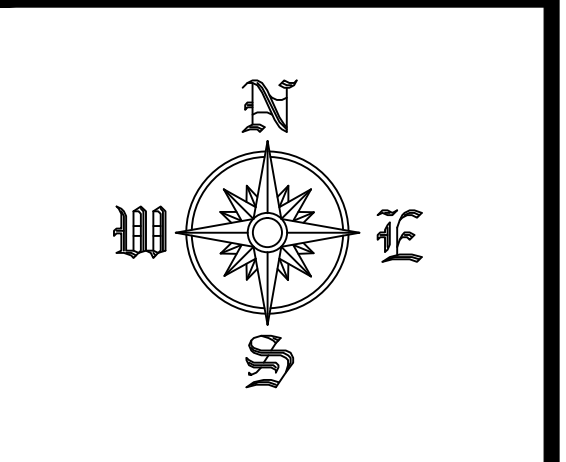


REVISIONS

| NO. | DATE | DESCRIPTION |
|-----|------|-------------|
| | | |
| | | |
RECORD DRAWINGS STAMP


CONTI ELECTRIC DATE (Last Update):
 2/21/2012 9:25 AM
 DRAWING FILE NAME:
 E22-01
 CAD OPERATOR:
 GERTMAN
 PRINTED BY:
 FREDMAN, GREG
 PLOT DATE:
 2/21/2012 10:29 AM
 SUBMITTED BY:
 G.P.F.
 ASSIGNED TO:

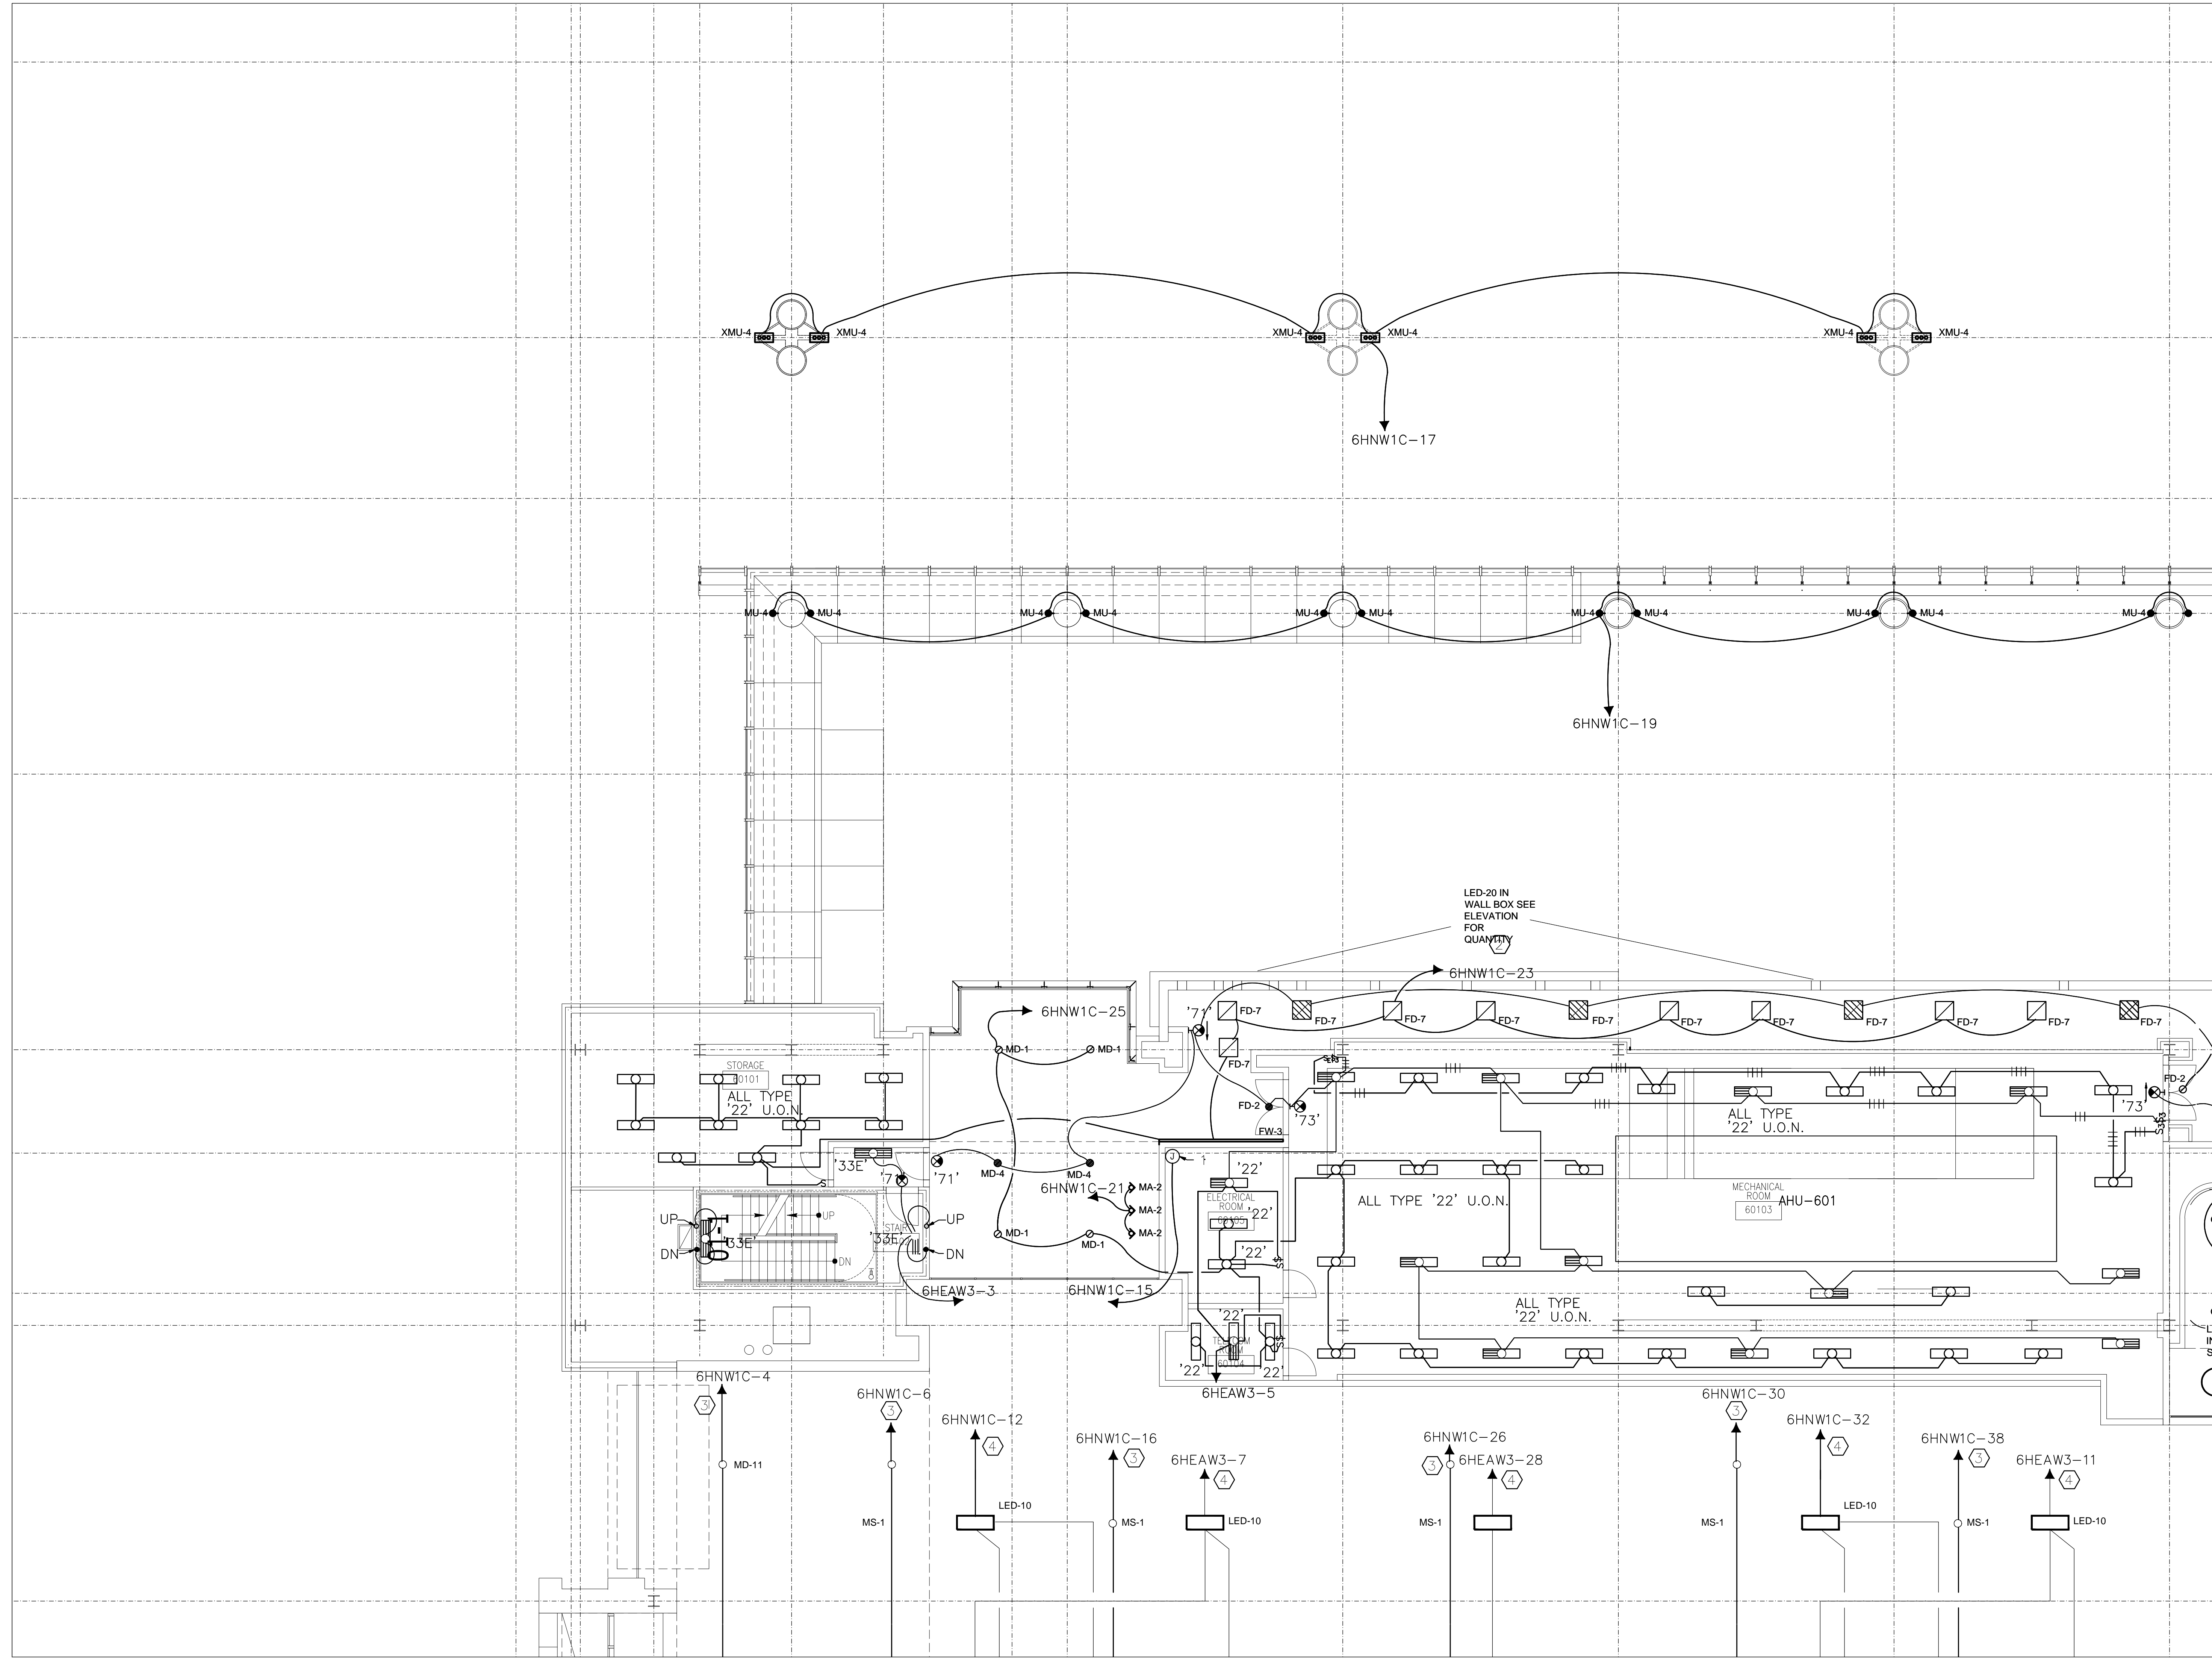

LEVEL 6 LIGHTING
 ZONE 01
 SCALE: 1/8" = 1'-0"

EL2-601


FILE PATH FOR CAD OPERATOR USE ONLY: C:\Users\Gertman\Documents\Projects\Music City Center\As-Built\4-10-12\Level 6 Lighting\Zone 01.dwg

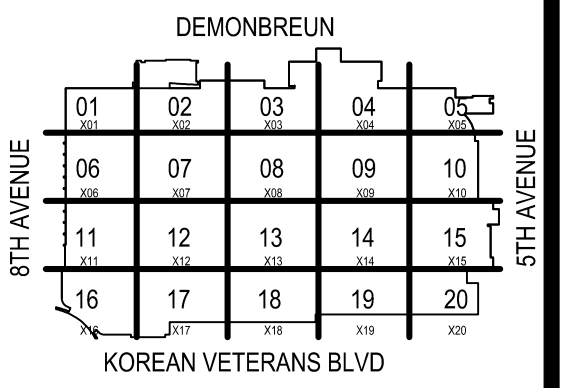

COORDINATION SIGN-OFF

| COMPANY | TRADE | DATE |
|---------|-------|------|
| CONTI | ELEC. | / / |
| | | / / |
| | | / / |
Music City Center
Nashville, Tennessee

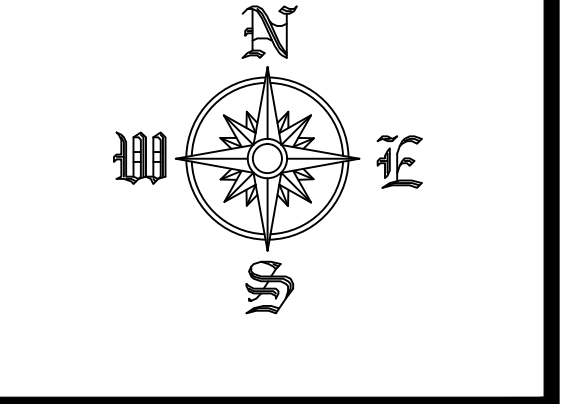

REVISIONS


| NO. | DATE | DESCRIPTION |
|-----|------|-------------|
| | | |
| | | |
RECORD DRAWINGS STAMP

CONTI ELECTRIC DATE (Last Update): 2/21/2012 9:25 AM
 DRAWING FILE NAME: 212-204
 CAD OPERATOR: SEYMEN
 PRINTED BY: SEYMEN GREGG
 PLOT DATE: 2/21/2012 10:29 AM
 SUBMITTED BY: GREGG
 ASSIGNED TO:

LEVEL 6 LIGHTING
 ZONE 02
 SCALE: 1/8" = 1'-0"

EL2-602

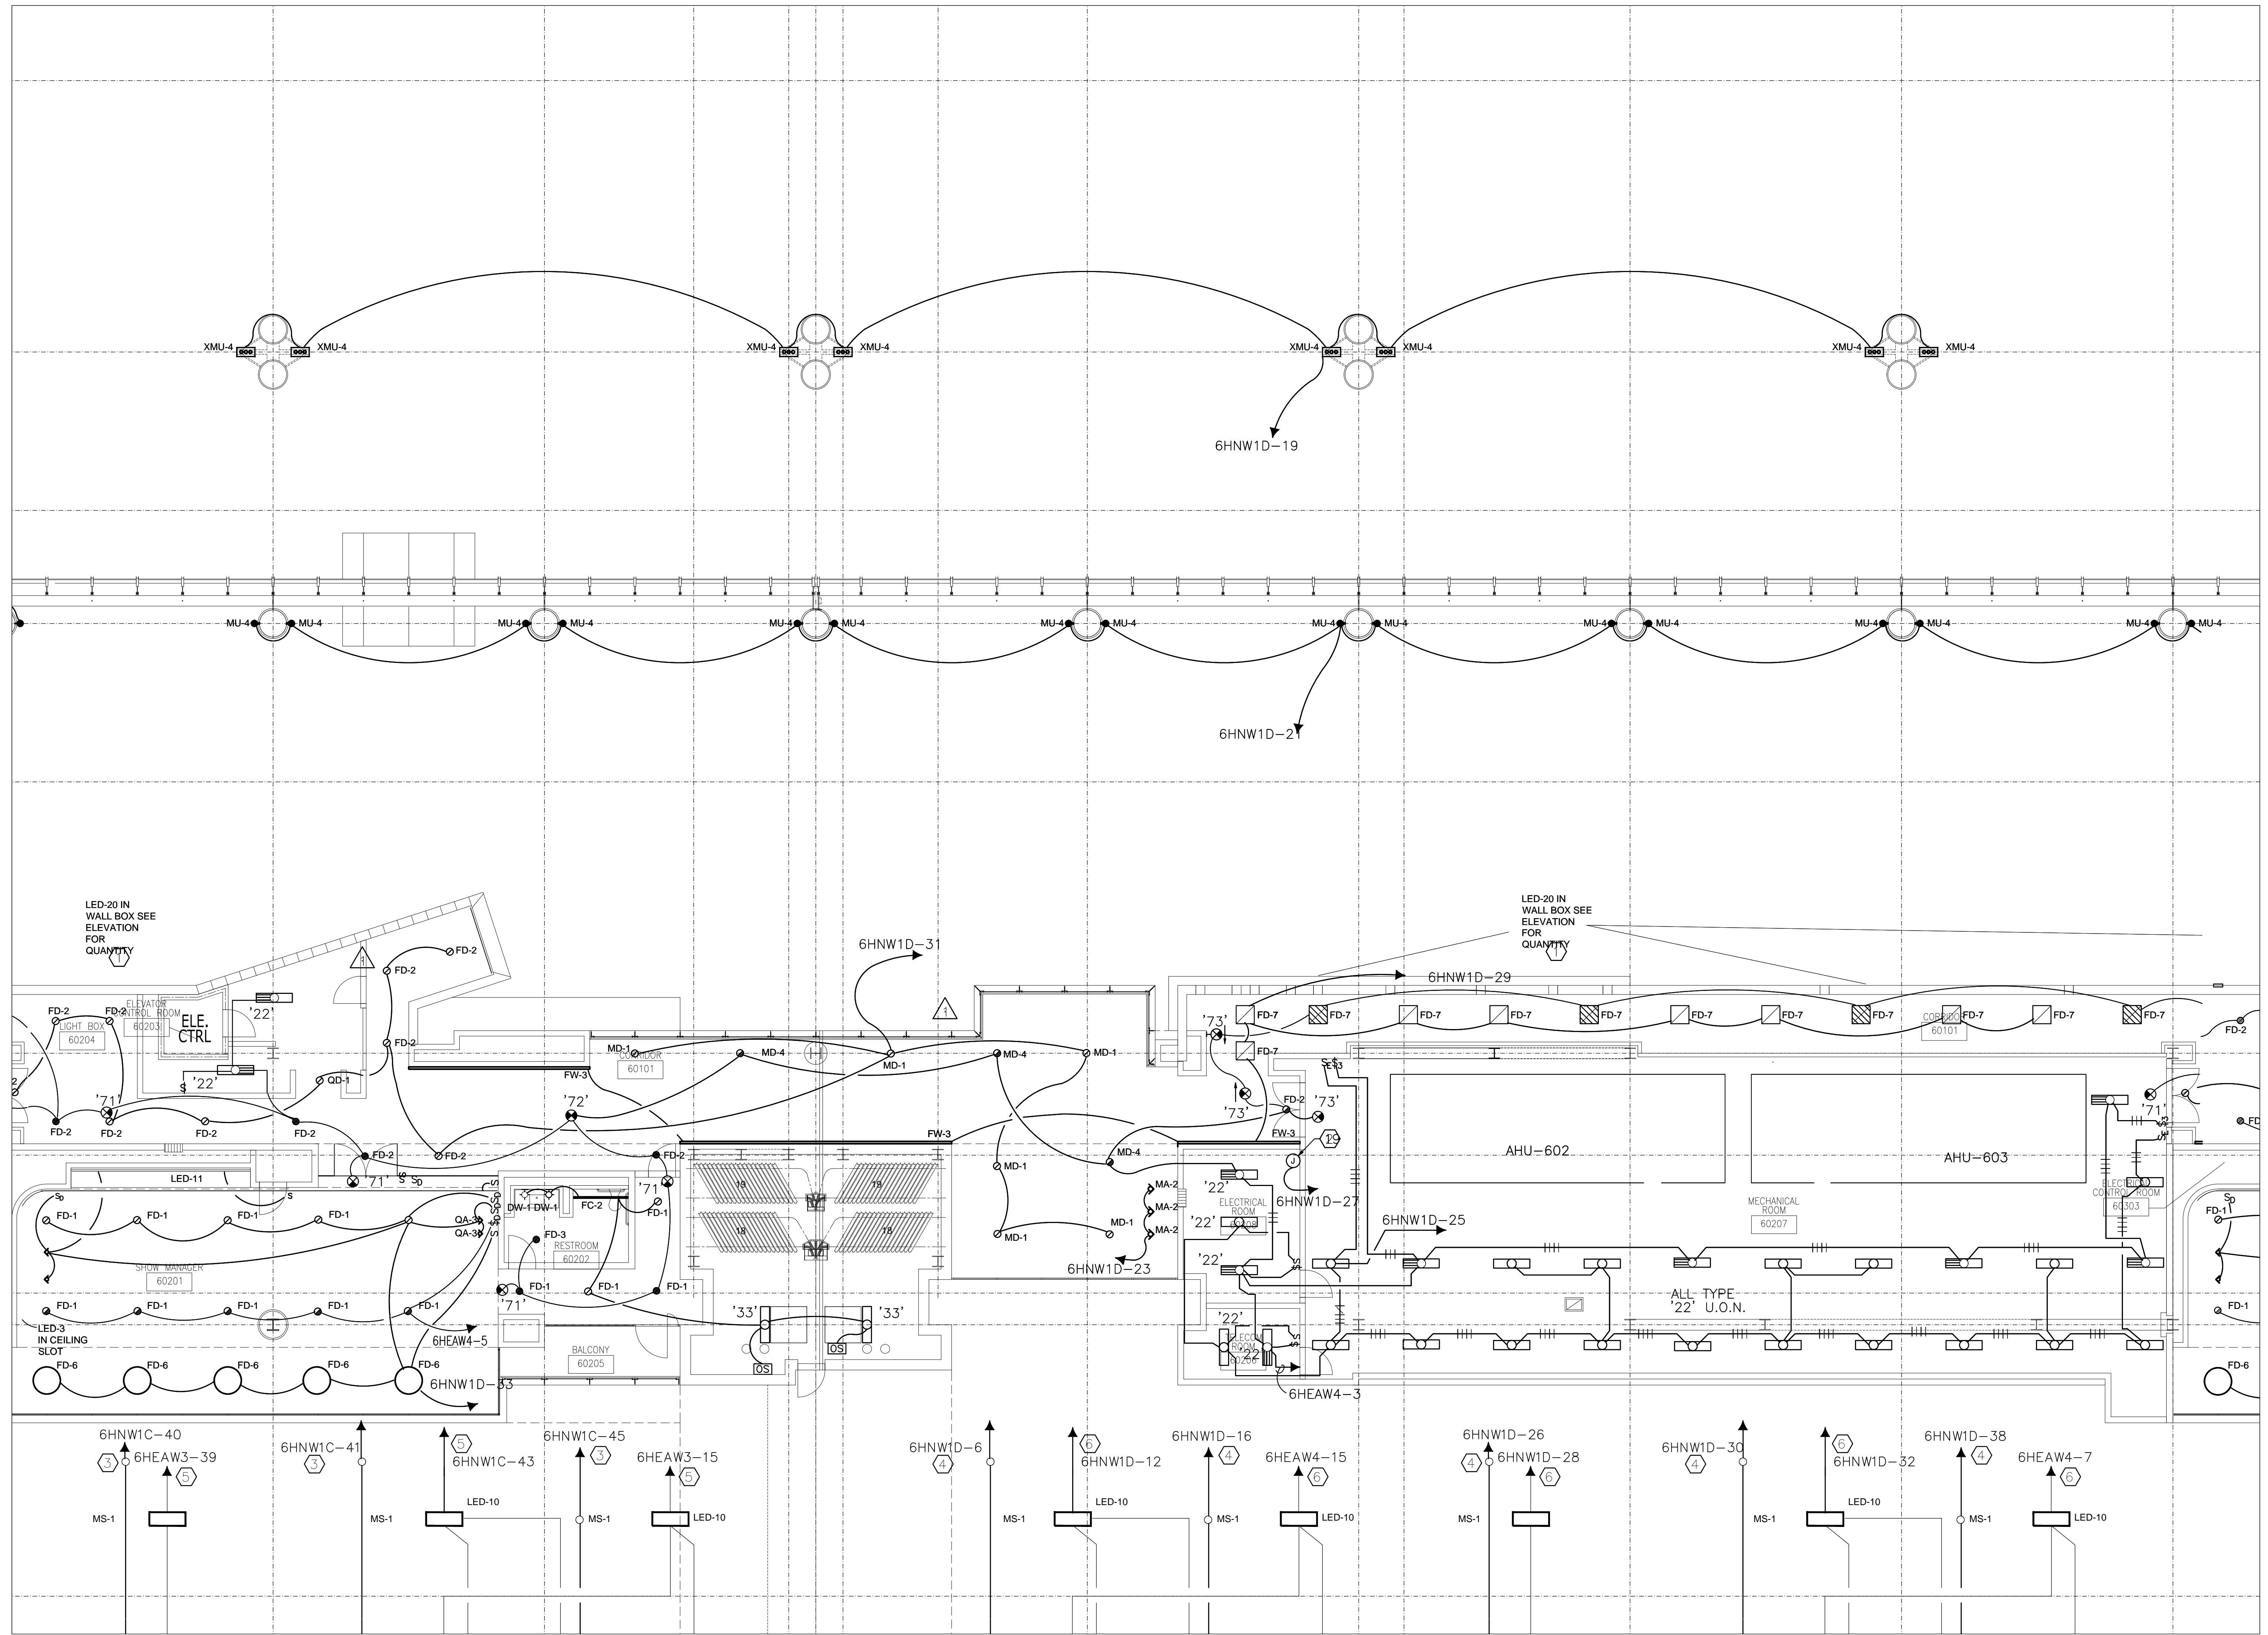


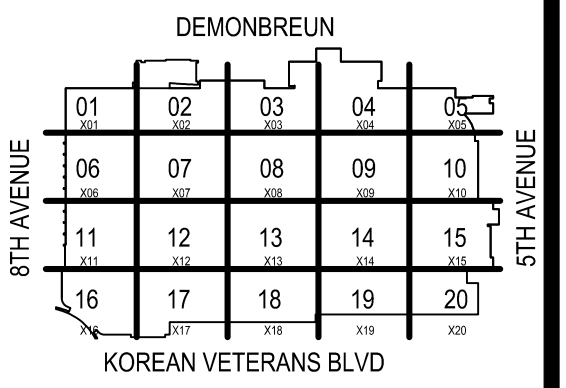

KEY PLAN
NO SCALE

| COORDINATION SIGN-OFF | | DATE | DATE | DATE | DATE | DATE |
|-----------------------|-------|------|------|------|------|------|
| COMPANY | NAME | | | | | |
| TRADE | ELEC. | | | | | |
| EDITI | | | | | | |

Music City Center
Nashville, Tennessee

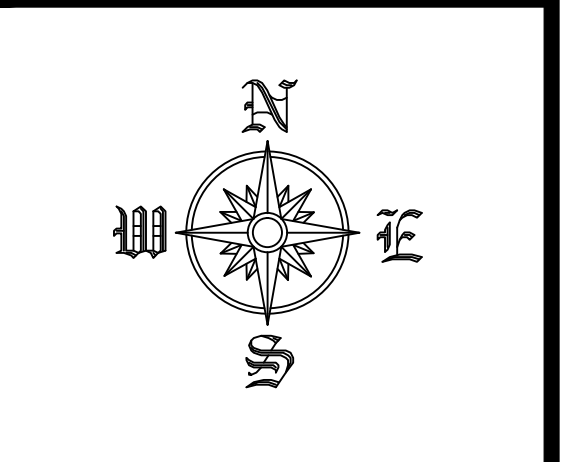


| REVISIONS | | |
|-----------|------|-------------|
| NO. | DATE | DESCRIPTION |
| | | |
| | | |
| | | |
| | | |


| RECORD DRAWINGS STAMP | |
|------------------------------------|--------------------|
| CONTI ELECTRIC DATE (Last Update): | 2/21/2012 10:29 AM |
| DRAWING FILE NAME: | EL2-603 |
| CAD OPERATOR: | SEYMEN |
| PRINTED BY: | SEYMEN |
| PLOT DATE: | 2/21/2012 10:29 AM |
| SUBMITTED BY: | SEYMEN |
| ASSIGNED TO: | |

LEVEL 6 LIGHTING
 ZONE 03
 SCALE: 1/8" = 1'-0"

EL2-603

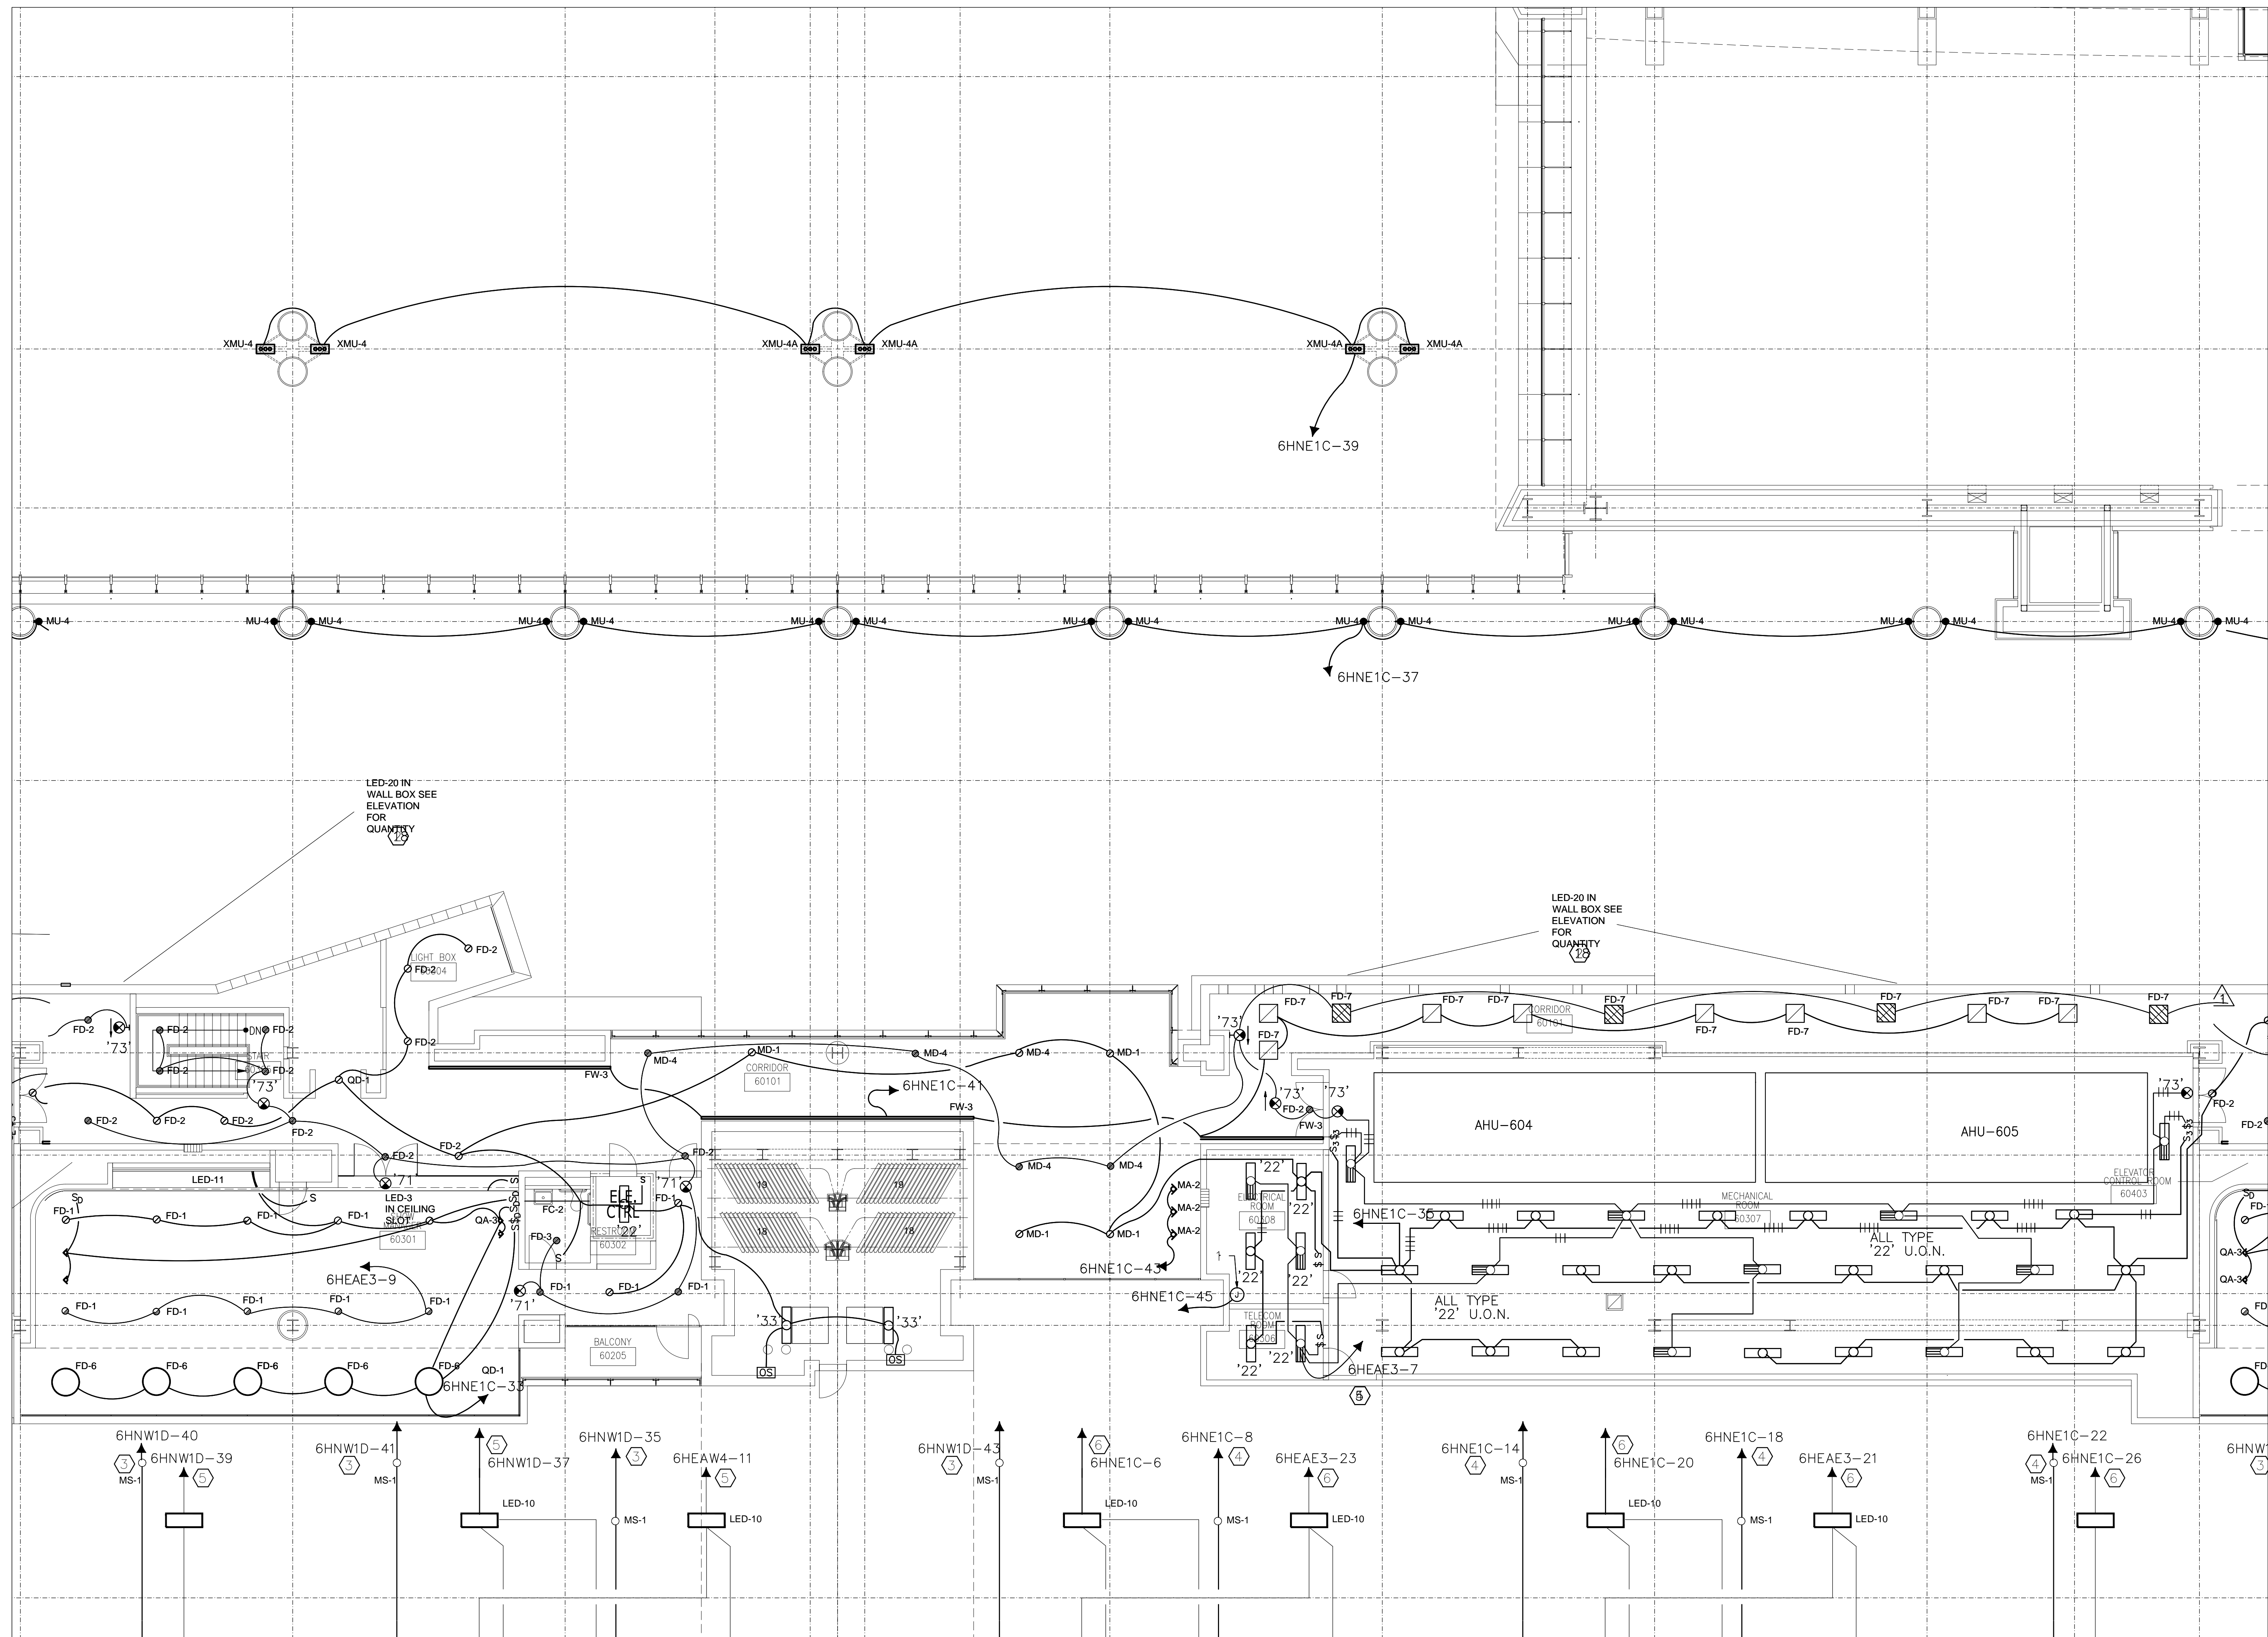


FILE PATH FOR CAD OPERATOR USE ONLY: C:\Users\Conti\Documents\Projects\Music City Center\Bldg 4\EL2\Zone 03 Lighting Symbols For Operating

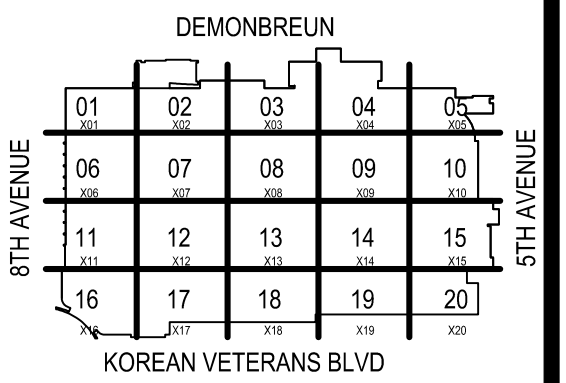

COORDINATION SIGN-OFF

| COMPANY | TRADE | DATE |
|---------|-------|------|
| CONTI | ELEC. | /// |
| | | /// |
| | | /// |
Music City Center
 Nashville, Tennessee

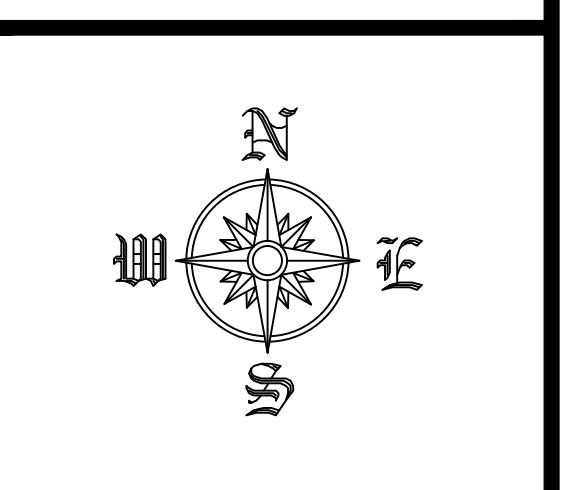


REVISIONS

| NO. | DATE | DESCRIPTION |
|-----|------|-------------|
| | | |
| | | |
| | | |
| | | |


RECORD DRAWINGS STAMP

CONTI ELECTRIC DATE (Last Update): 2/21/2012 9:25:47
 DRAWING FILE NAME: 212-604
 CAD OPERATOR: GEMMAN
 PRINTED BY: FRYMAN, GREGG
 PLOT DATE: 2/21/2012 10:29:41
 SUBMITTED BY: GEMMAN
 ASSIGNED TO:

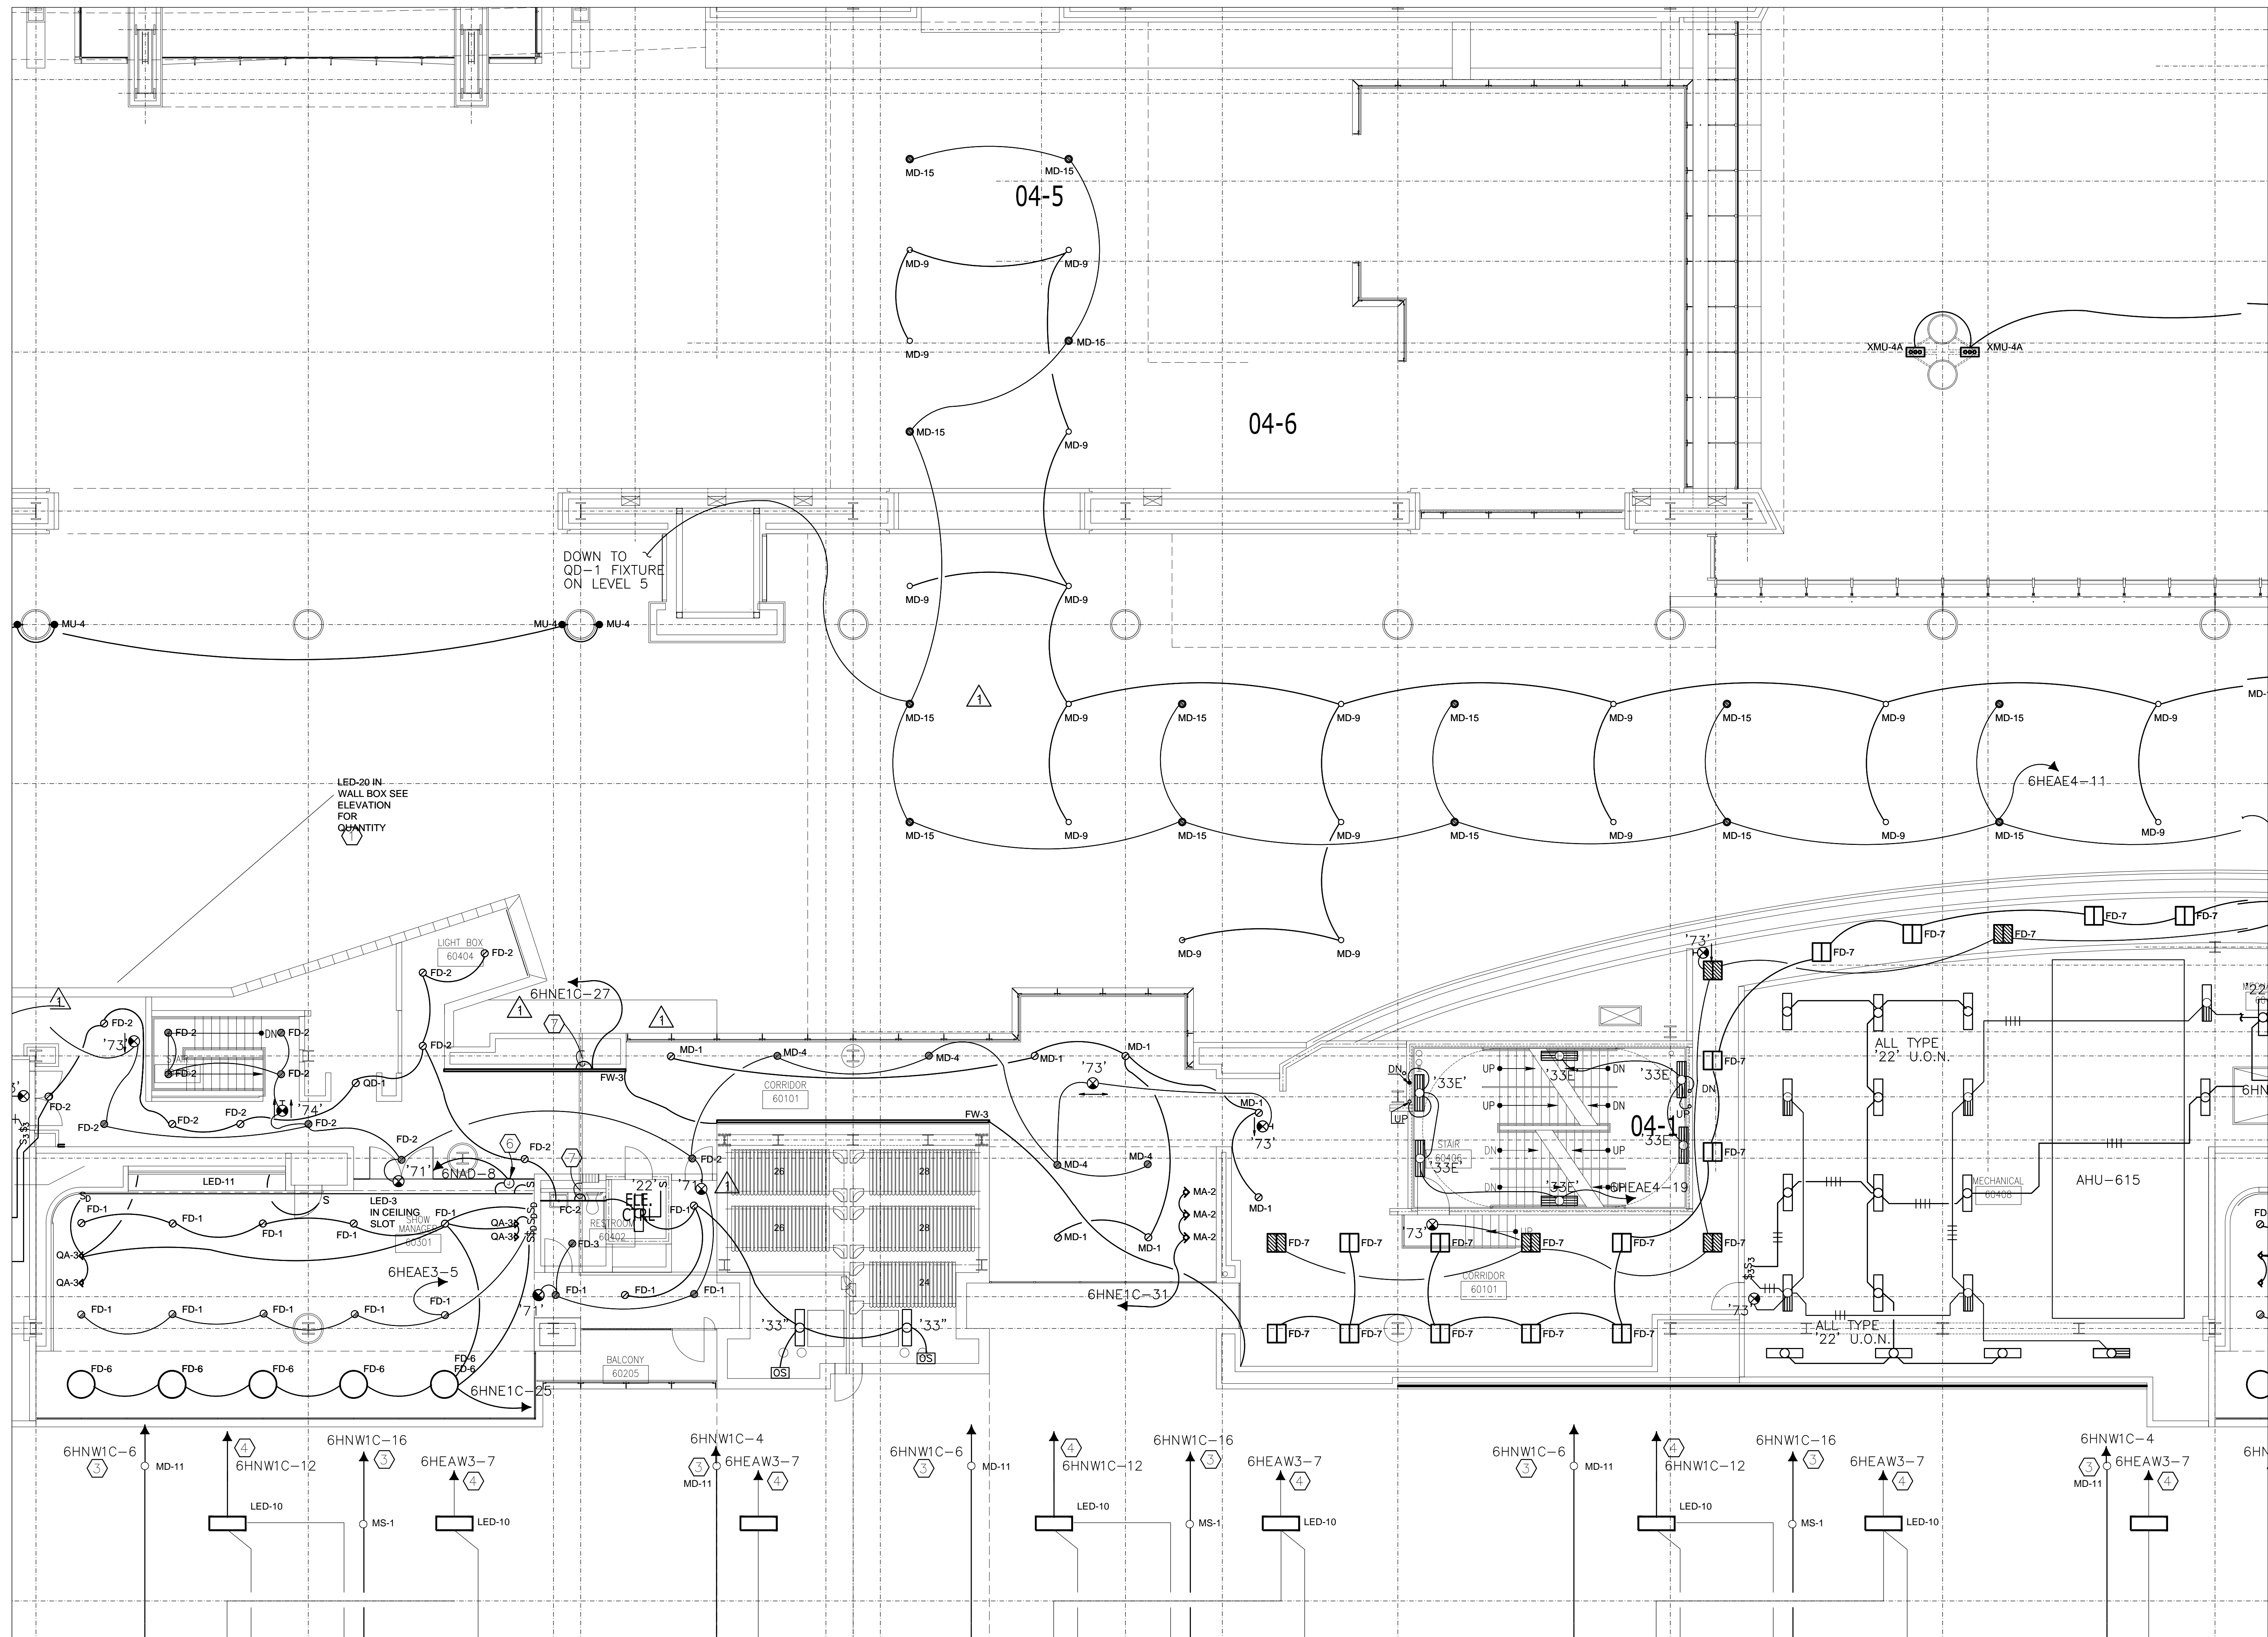

LEVEL 6 LIGHTING
 ZONE 04
 SCALE: 1/8" = 1'-0"


EL2-604

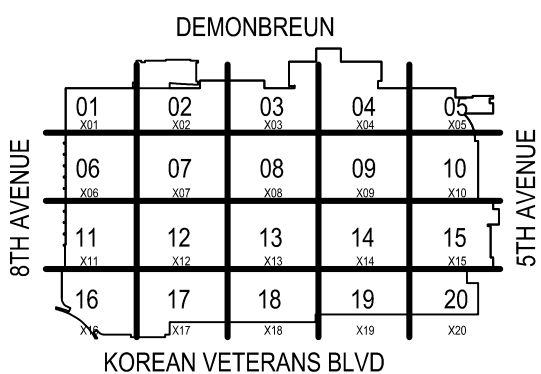

KEY PLAN
NO SCALE

| COORDINATION SIGN-OFF | | DATE | NAME | TRADE |
|-----------------------|-------|------|------|-------|
| COMPANY | CONTI | / / | | ELEC. |
| | | / / | | |
| | | / / | | |
| | | / / | | |
| | | / / | | |

Music City Center
Nashville, Tennessee

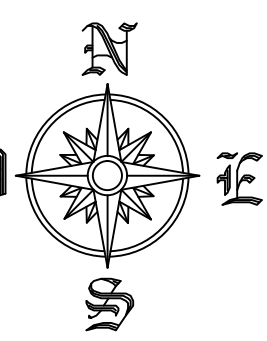


| REVISIONS | | |
|-----------|------|-------------|
| NO. | DATE | DESCRIPTION |
| | | |
| | | |
RECORD DRAWINGS STAMP

CONTRACT DATE (Last Update):
 2/21/2012 10:29 AM
 DRAWING FILE NAME:
 ELEC-04
 CAD OPERATOR:
 GERTMAN
 PRINTED BY:
 FREDMAN, GREGG
 PLOT DATE:
 2/21/2012 10:29 AM
 SUBMITTED BY:
 GMP
 ASSIGNED TO:

LEVEL 6 LIGHTING
 ZONE 05
 SCALE: 1/8" = 1'-0"

EL2-605

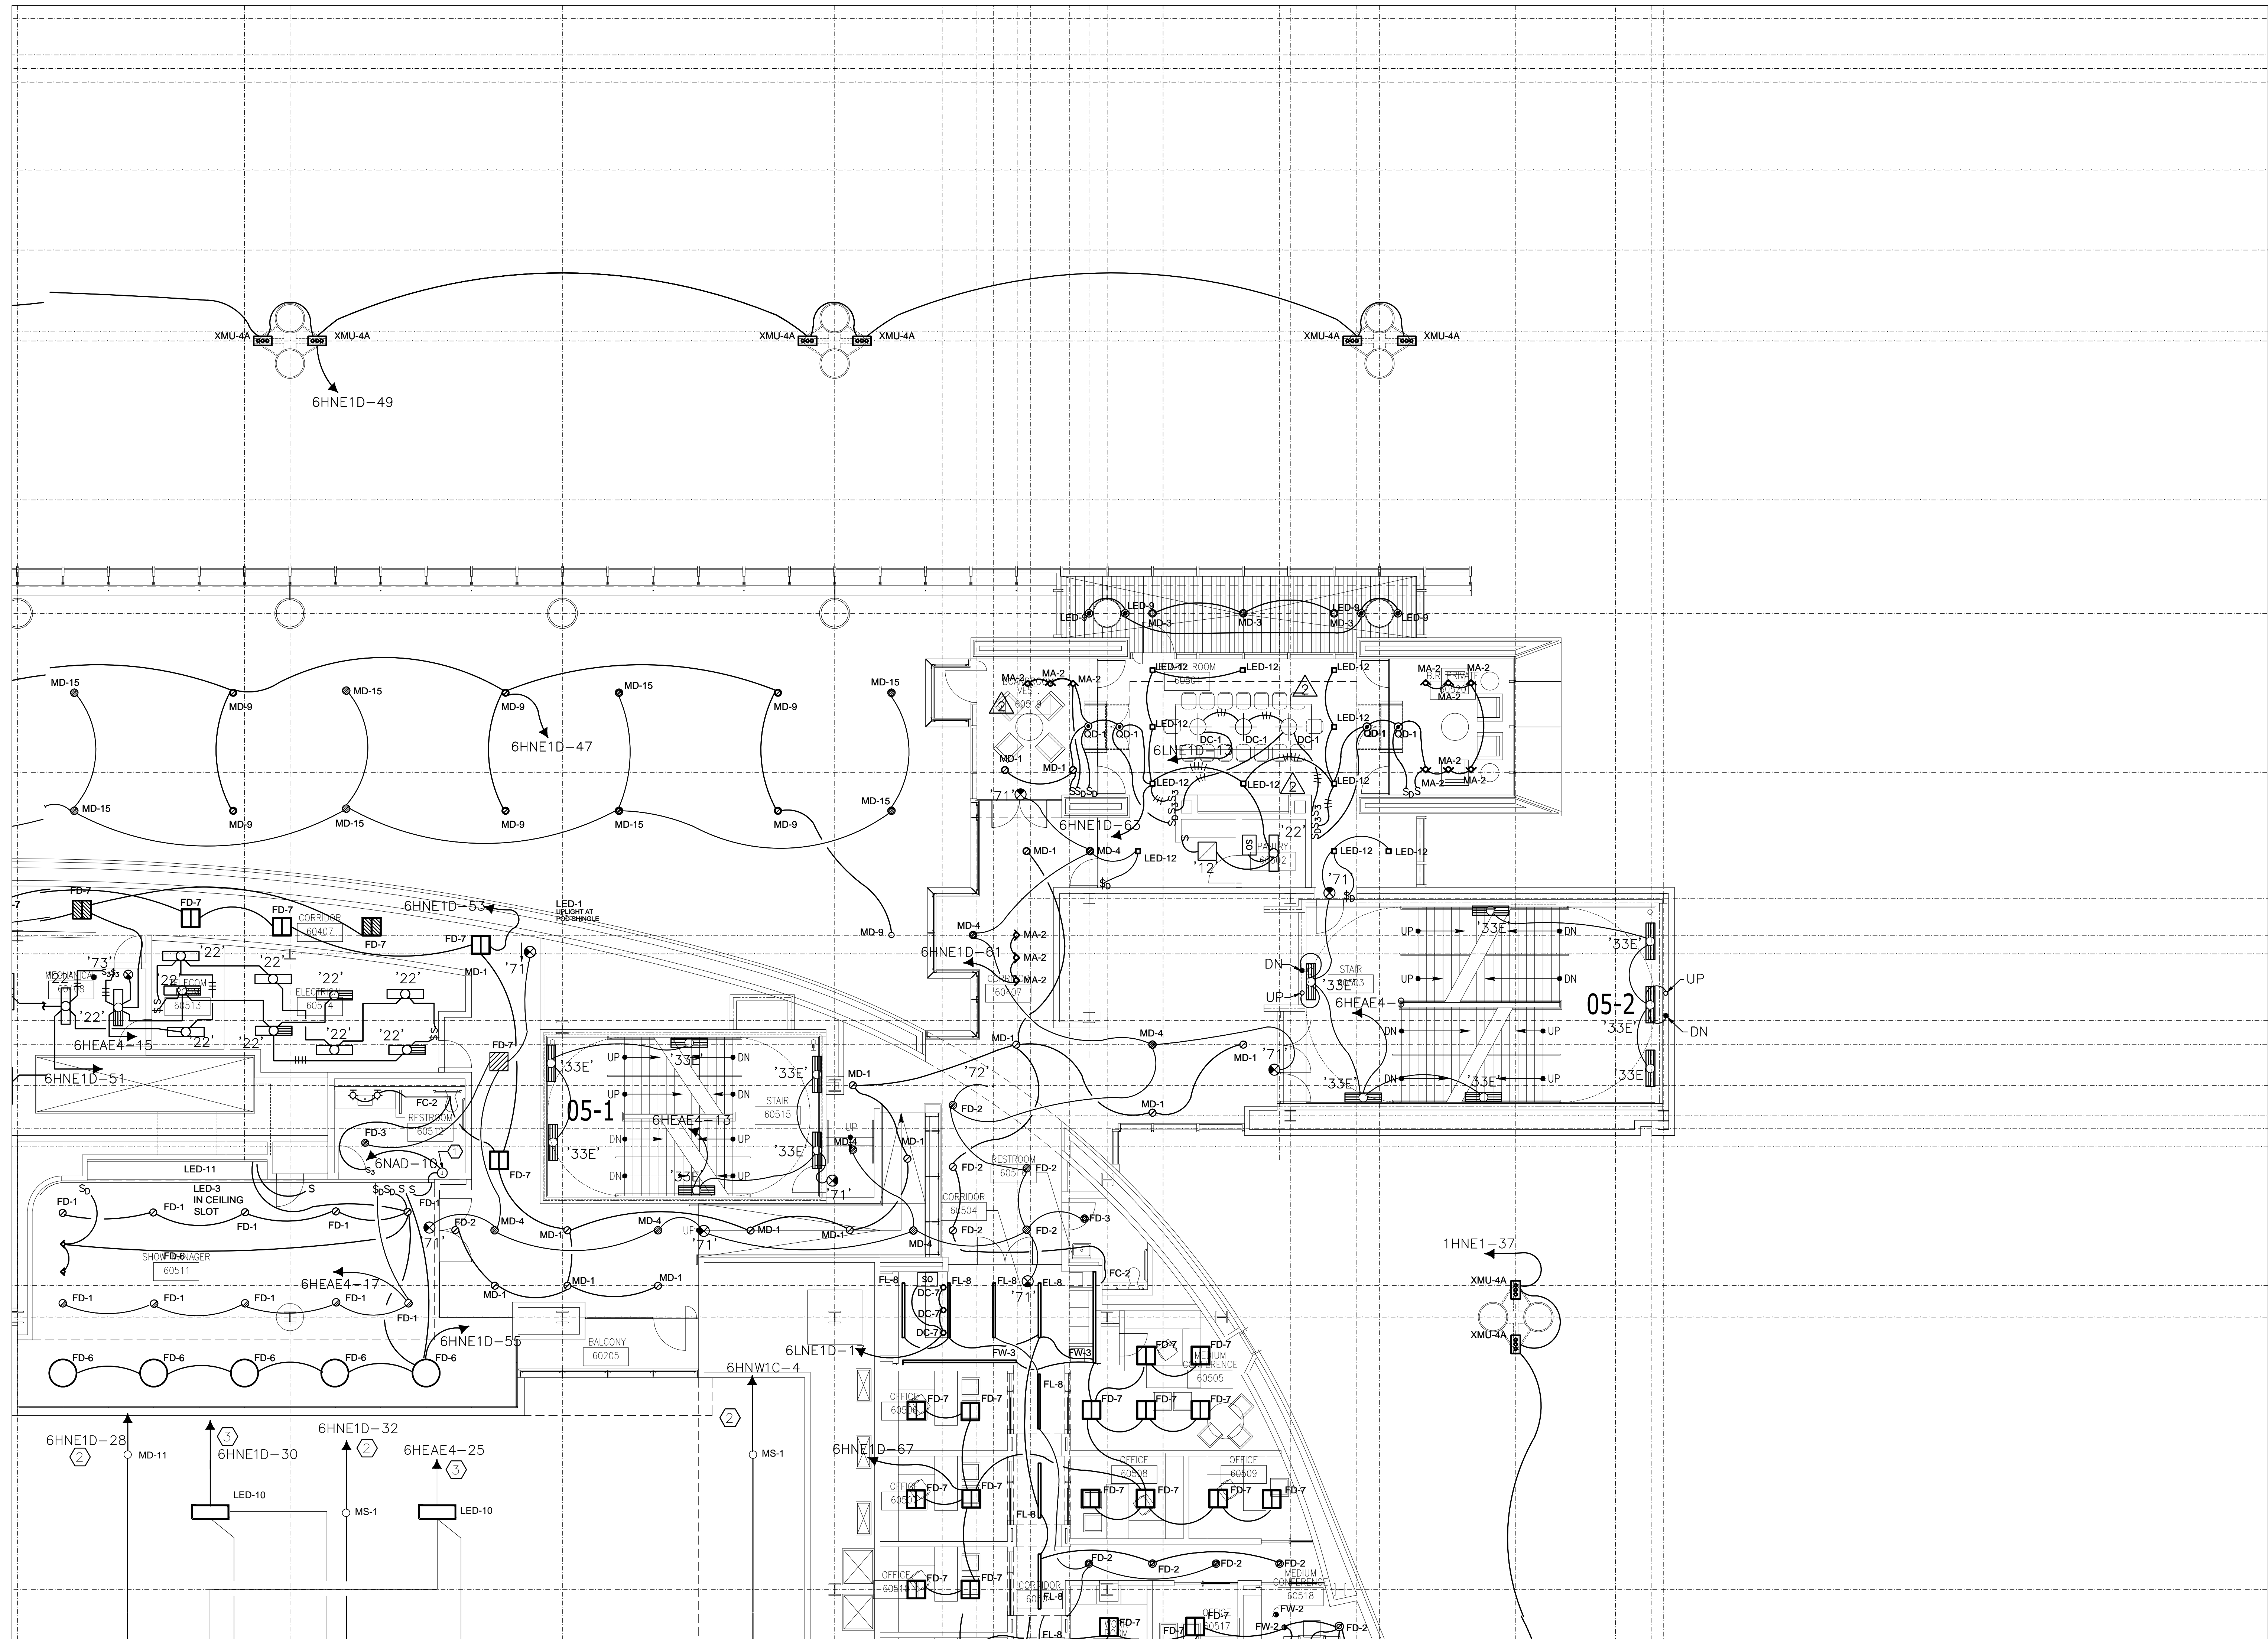


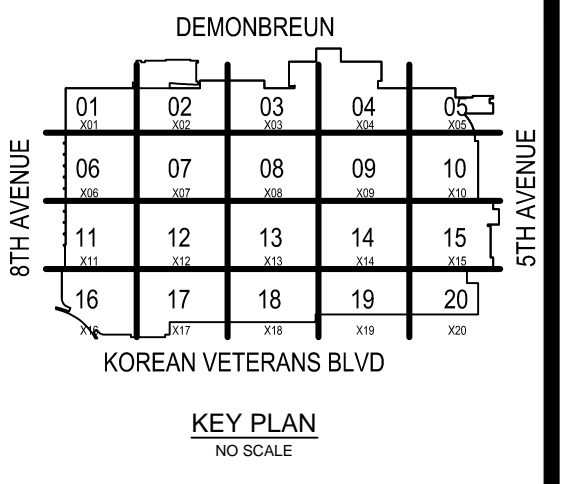

COORDINATION SIGN-OFF

| COMPANY | TRADE | DATE |
|---------|-------|------|
| CONTI | ELEC. | / / |
| | | / / |
| | | / / |
Music City Center
 Nashville, Tennessee

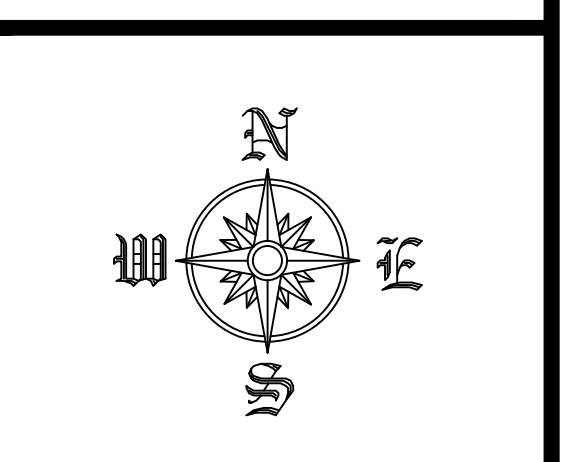

REVISIONS


| NO. | DATE | DESCRIPTION |
|-----|------|-------------|
| | | |
| | | |
RECORD DRAWINGS STAMP

CONTI ELECTRIC DATE (Last Update): 2/21/2012 9:25 AM
 DRAWING FILE NAME: E22-04
 CAD OPERATOR: GERTMAN
 PRINTED BY: GERTMAN
 PLOT DATE: 2/21/2012 10:40 AM
 SUBMITTED BY: G.P.
 ASSIGNED TO:

LEVEL 6 LIGHTING
 ZONE 06
 SCALE: 1/8" = 1'-0"

EL2-606

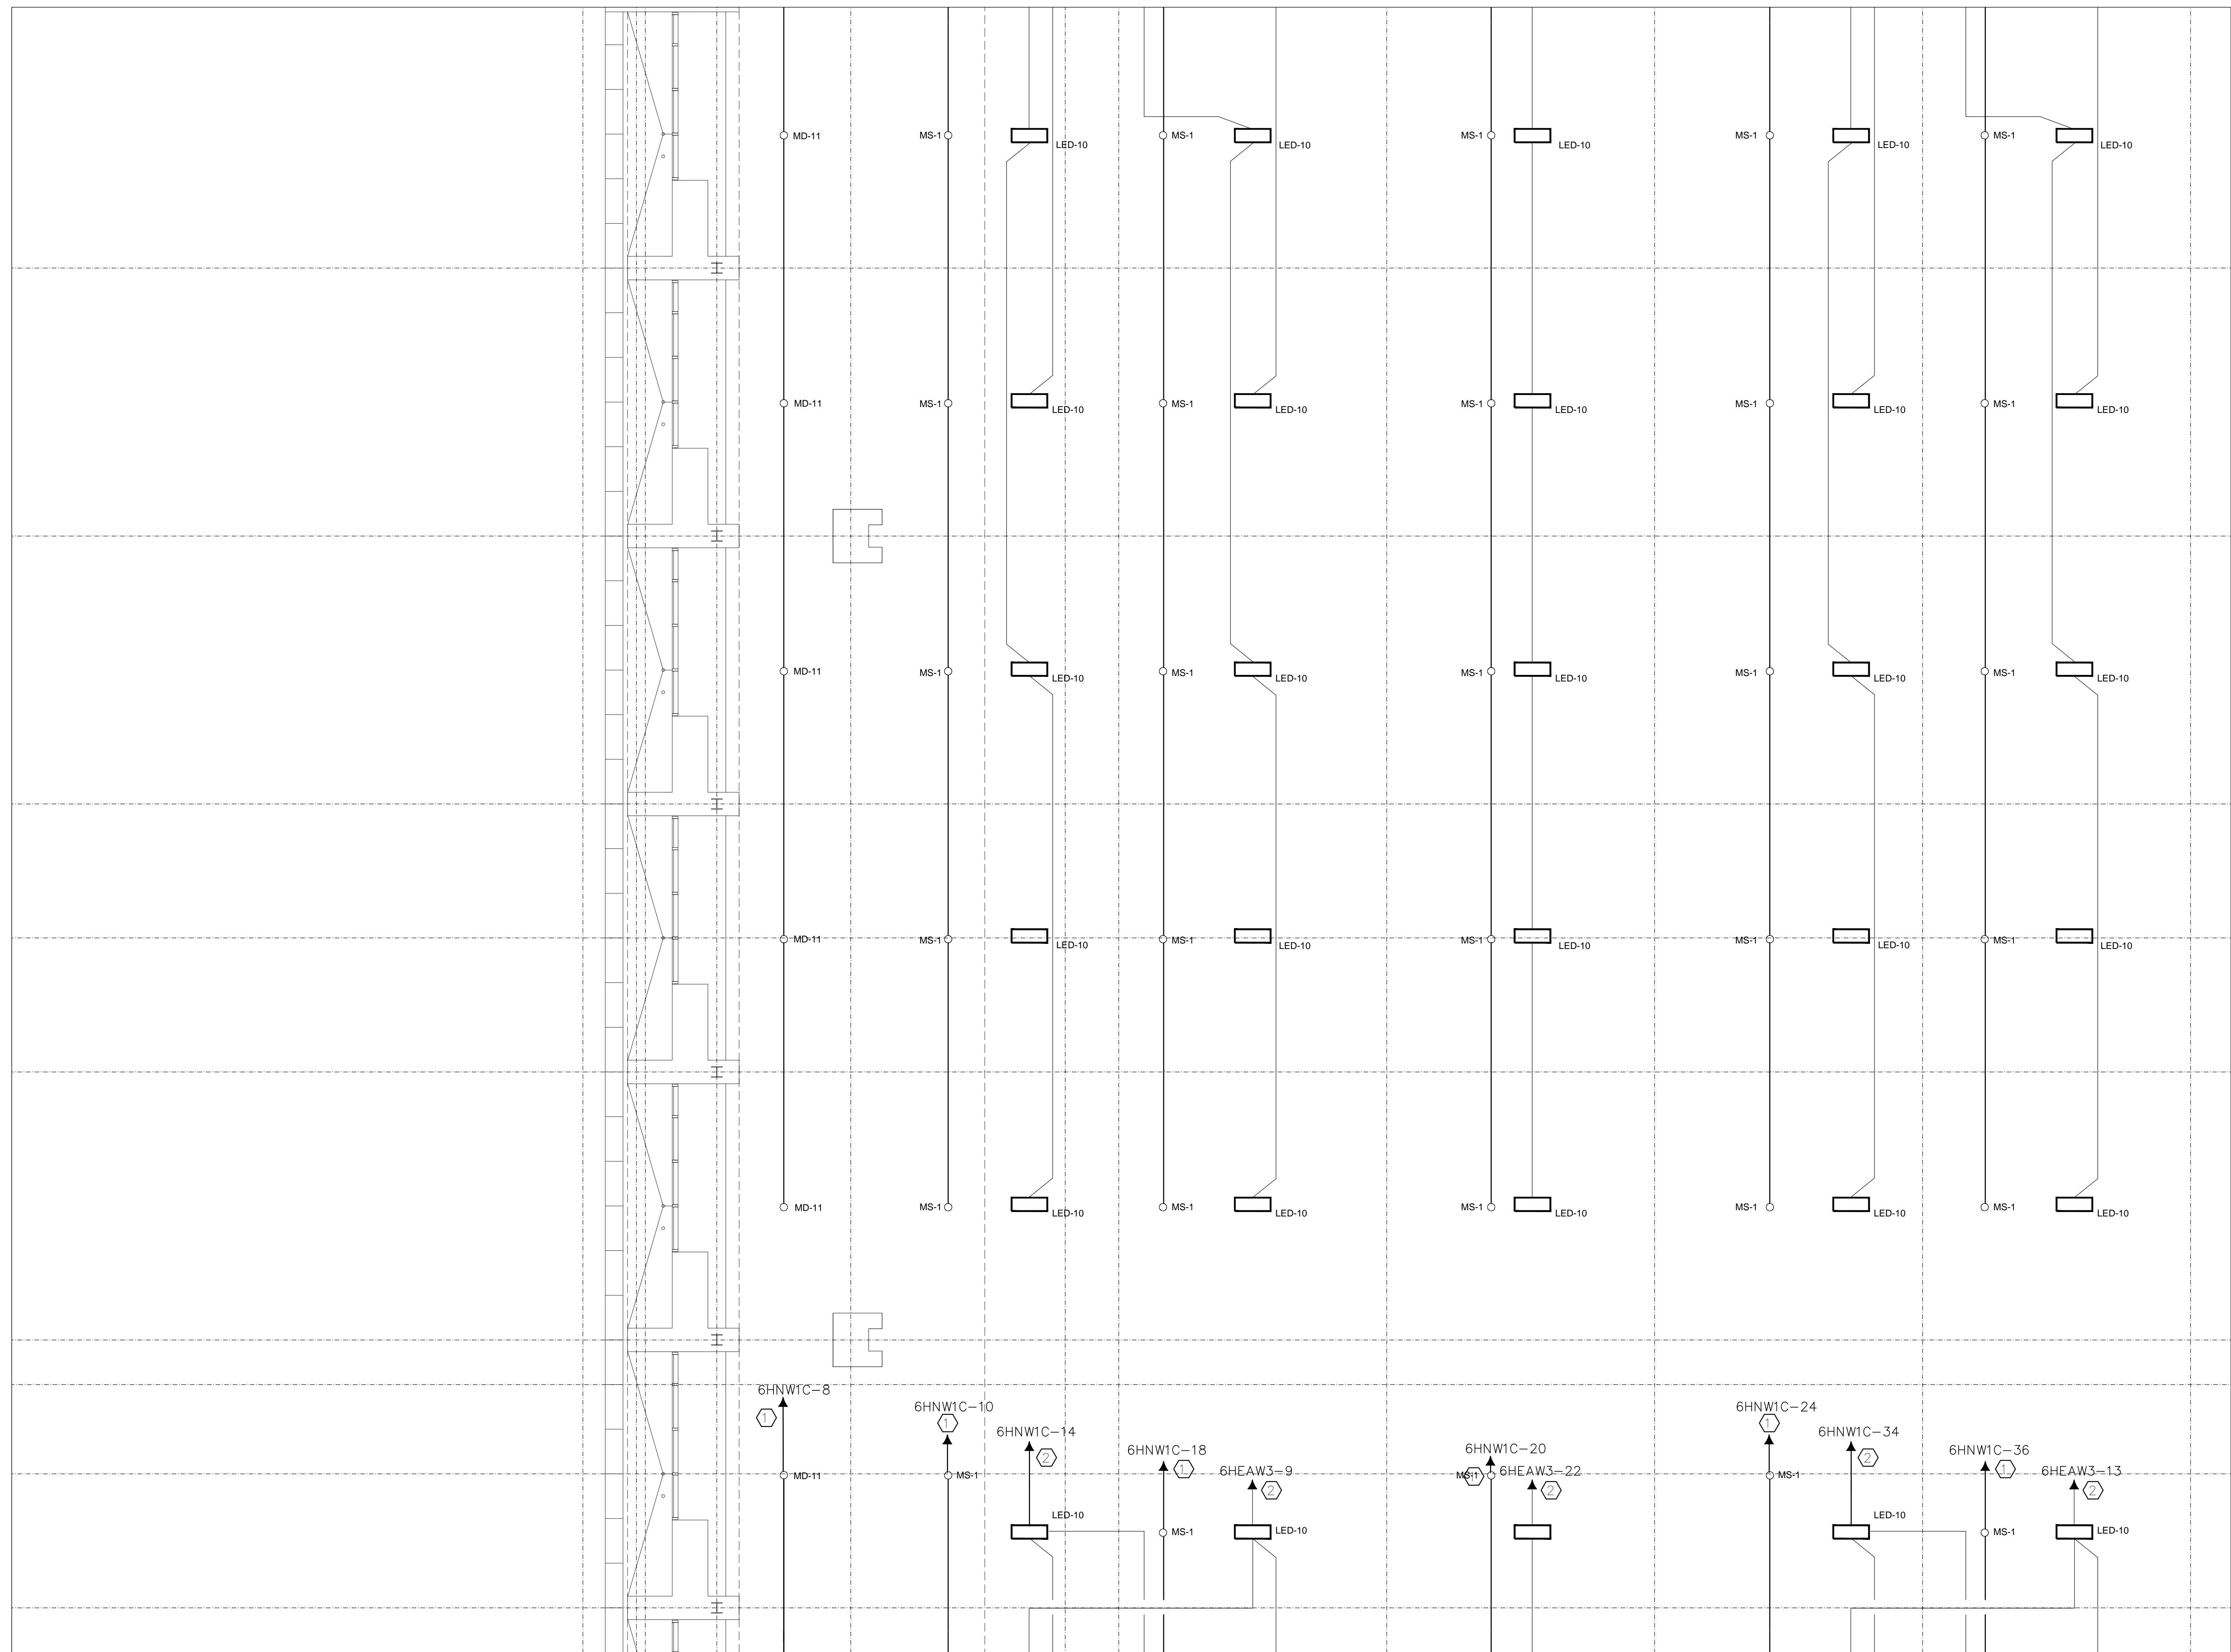


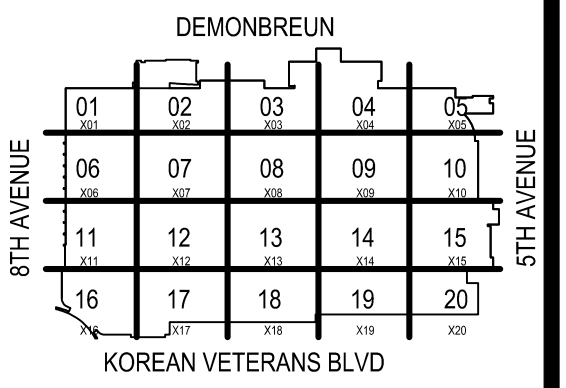

COORDINATION SIGN-OFF

| COMPANY | TRADE | DATE |
|---------|-------|------|
| CONTI | ELEC. | /// |
| | | /// |
| | | /// |
Music City Center
 Nashville, Tennessee

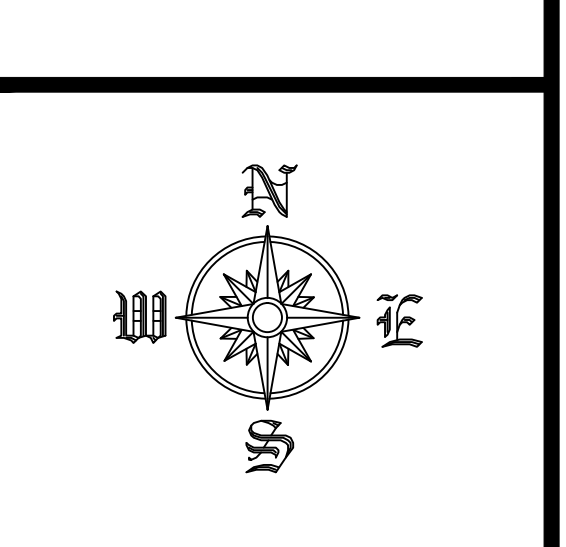

REVISIONS


| NO. | DATE | DESCRIPTION |
|-----|------|-------------|
| | | |
| | | |
RECORD DRAWINGS STAMP



CONTELECTRIC DATE (Last Update): 2/21/2012 9:59 AM
 DRAWING FILE NAME: EL2-607
 CAD OPERATOR: GERRMAN
 PRINTED BY: FREDMAN, GREG
 PLOT DATE: 2/21/2012 10:40 AM
 SUBMITTED BY: G.P.F.
 ASSIGNED TO:

LEVEL 6 LIGHTING
 ZONE 07
 SCALE: 1/8" = 1'-0"

EL2-607

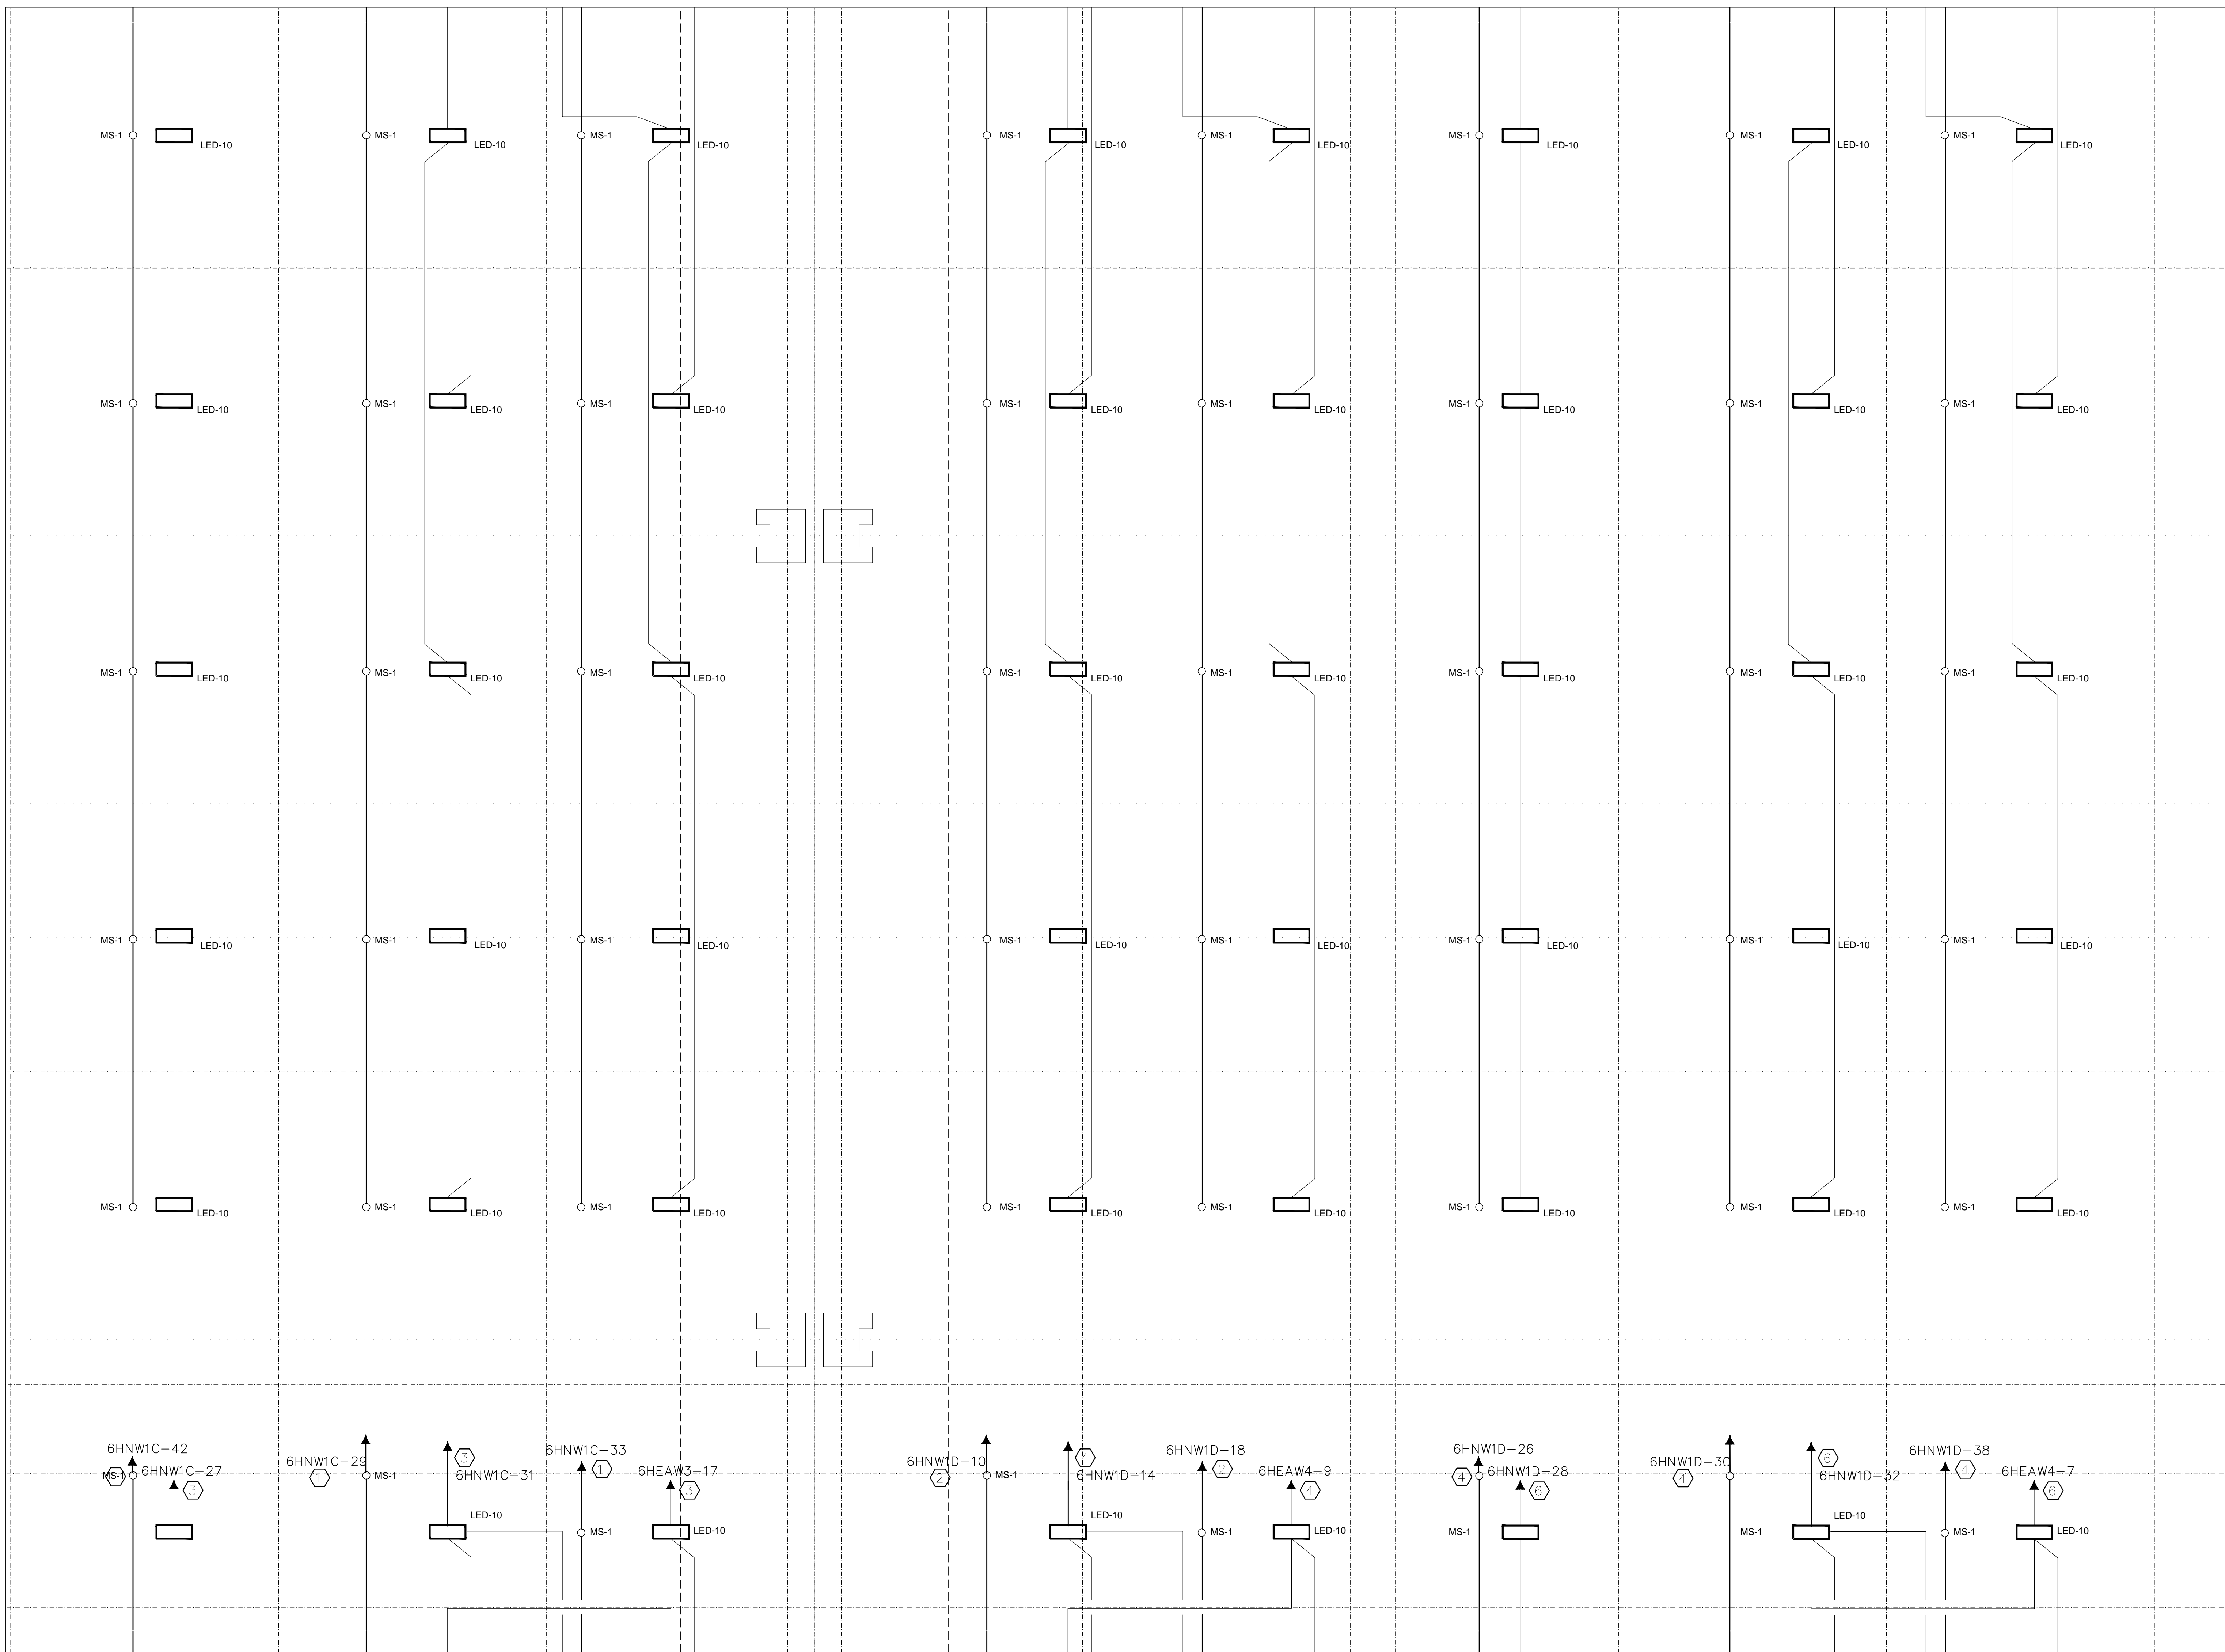


FILE PATH FOR CAD OPERATOR USE ONLY: C:\Users\Gerrman\Documents\Projects\2012\02\EL2-607\Level 6 Lighting\Zone 07.dwg

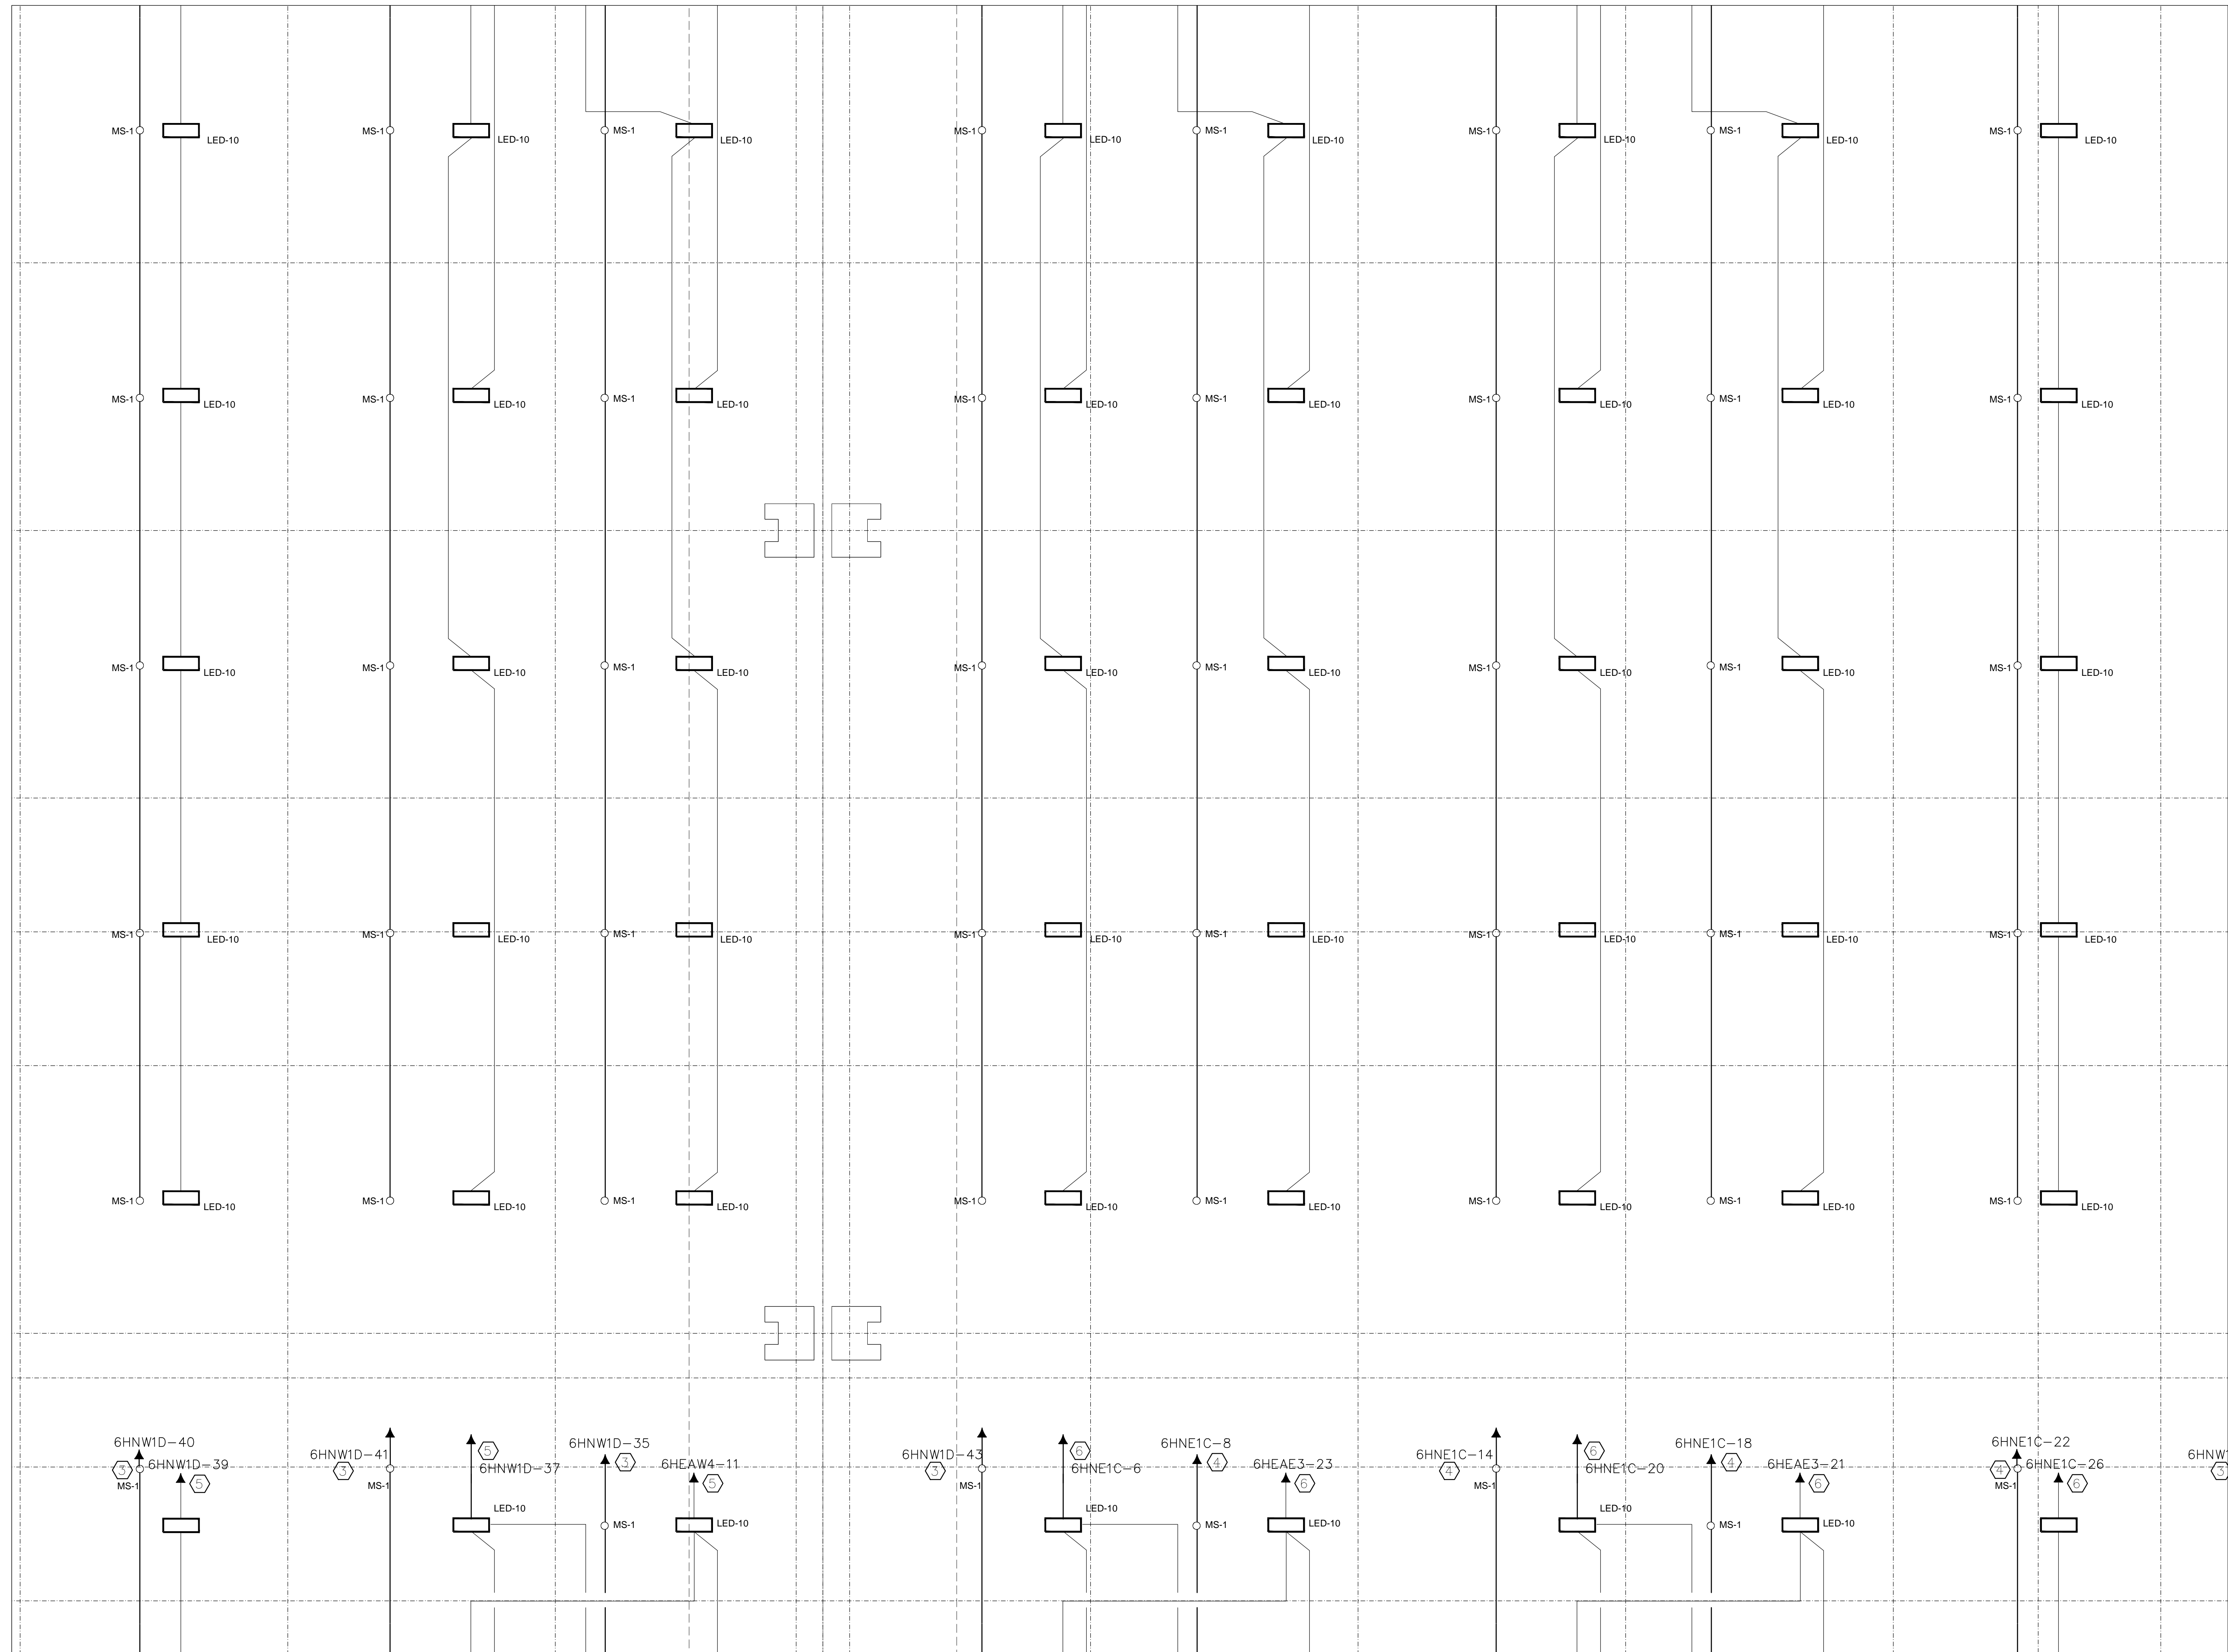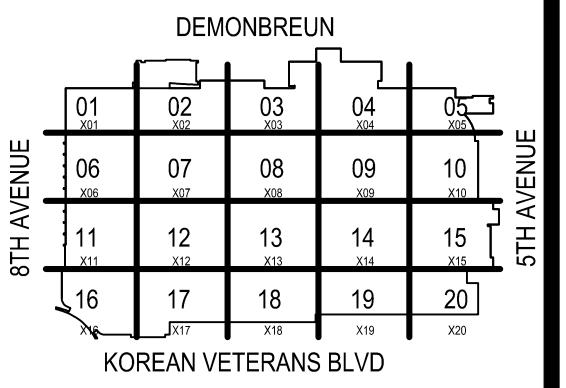

COORDINATION SIGN-OFF

| COMPANY | TRADE | DATE |
|---------|-------|------|
| CONTI | ELEC. | / / |
| | | / / |
| | | / / |
Music City Center
Nashville, Tennessee

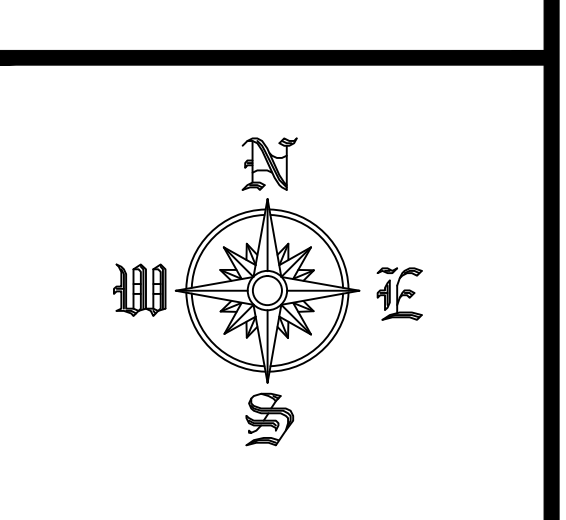

REVISIONS

| NO. | DATE | DESCRIPTION |
|-----|------|-------------|
| | | |
| | | |
RECORD DRAWINGS STAMP

CONTIELECTRIC DATE (Last Update): 2/21/2012 10:40 AM
 DRAWING FILE NAME: E22-04
 CAD OPERATOR: GERTMAN
 PRINTED BY: FREDMAN, GREG
 PLOT DATE: 2/21/2012 10:40 AM
 SUBMITTED BY: G.P.
 ASSIGNED TO:

LEVEL 6 LIGHTING
 ZONE 08
 SCALE: 1/8" = 1'-0"

EL2-608


FILE PATH FOR CAD OPERATOR USE ONLY: P:\2012\Conti Electric\Projects\MCC\Zone 08 - Ballroom\EL2-608.dwg

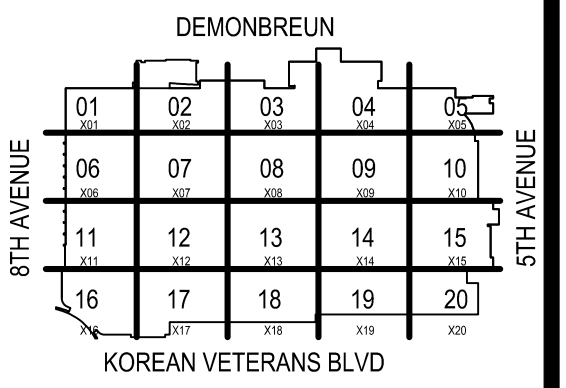

KEY PLAN
NO SCALE

| COORDINATION SIGN-OFF | DATE | NAME | TRADE |
|-----------------------|------|------|-------|
| | / / | / / | / / |
| COMPANY | | | |
| CONTI | | | |

Music City Center
Nashville, Tennessee

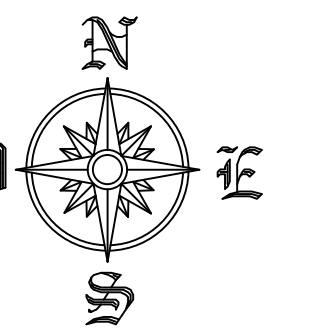


| REVISIONS | | |
|-----------|------|-------------|
| NO. | DATE | DESCRIPTION |
| | | |
| | | |
| RECORD DRAWINGS STAMP | |
|----------------------------------|--------------------|
| CONTELECTRIC DATE (Last Update): | 2/21/2012 9:50 AM |
| DRAWING FILE NAME: | EL2-609 |
| CAD OPERATOR: | GERMAN |
| PRINTED BY: | GERMAN, GREG |
| PLOT DATE: | 2/21/2012 10:40 AM |
| SUBMITTED BY: | BLP |
| ASSIGNED TO: | |

LEVEL 6 LIGHTING
 ZONE 09
 SCALE: 1/8" = 1'-0"

EL2-609

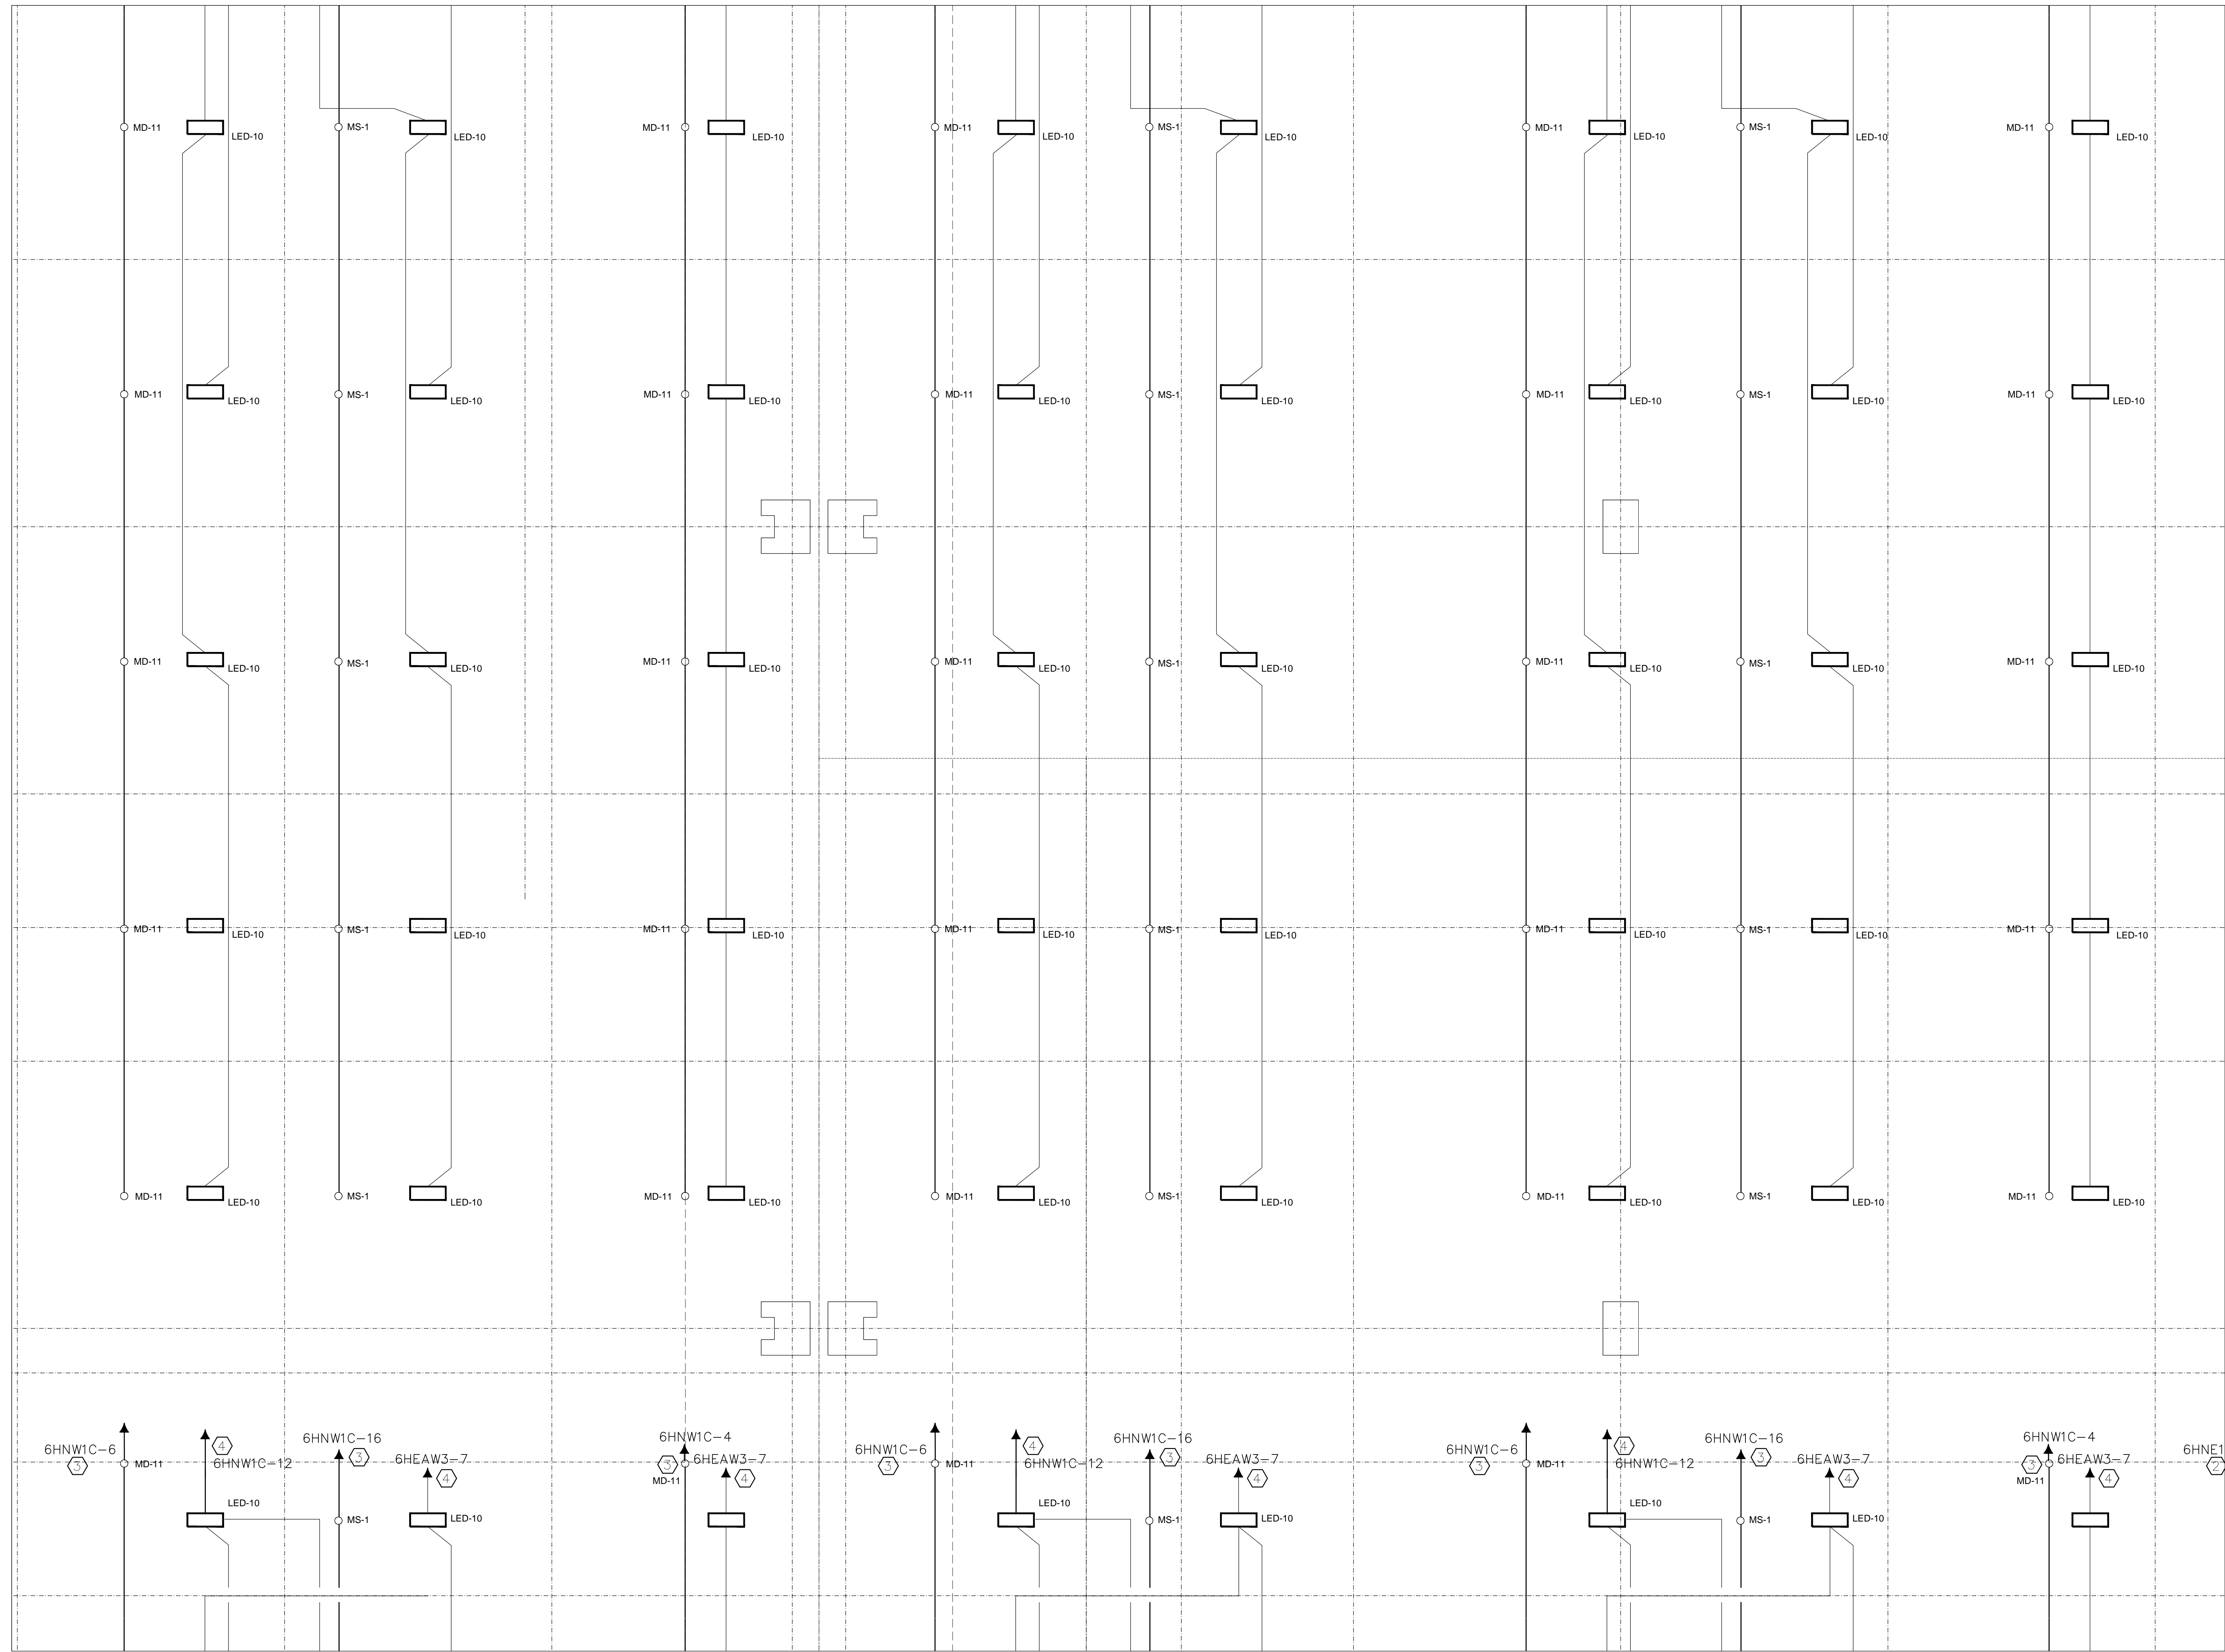


FILE PATH FOR CAD OPERATOR USE ONLY: C:\Users\Conti\Desktop\Projects\Level 6 Lighting\Zone 09\Level 6 Lighting\Zone 09.dwg

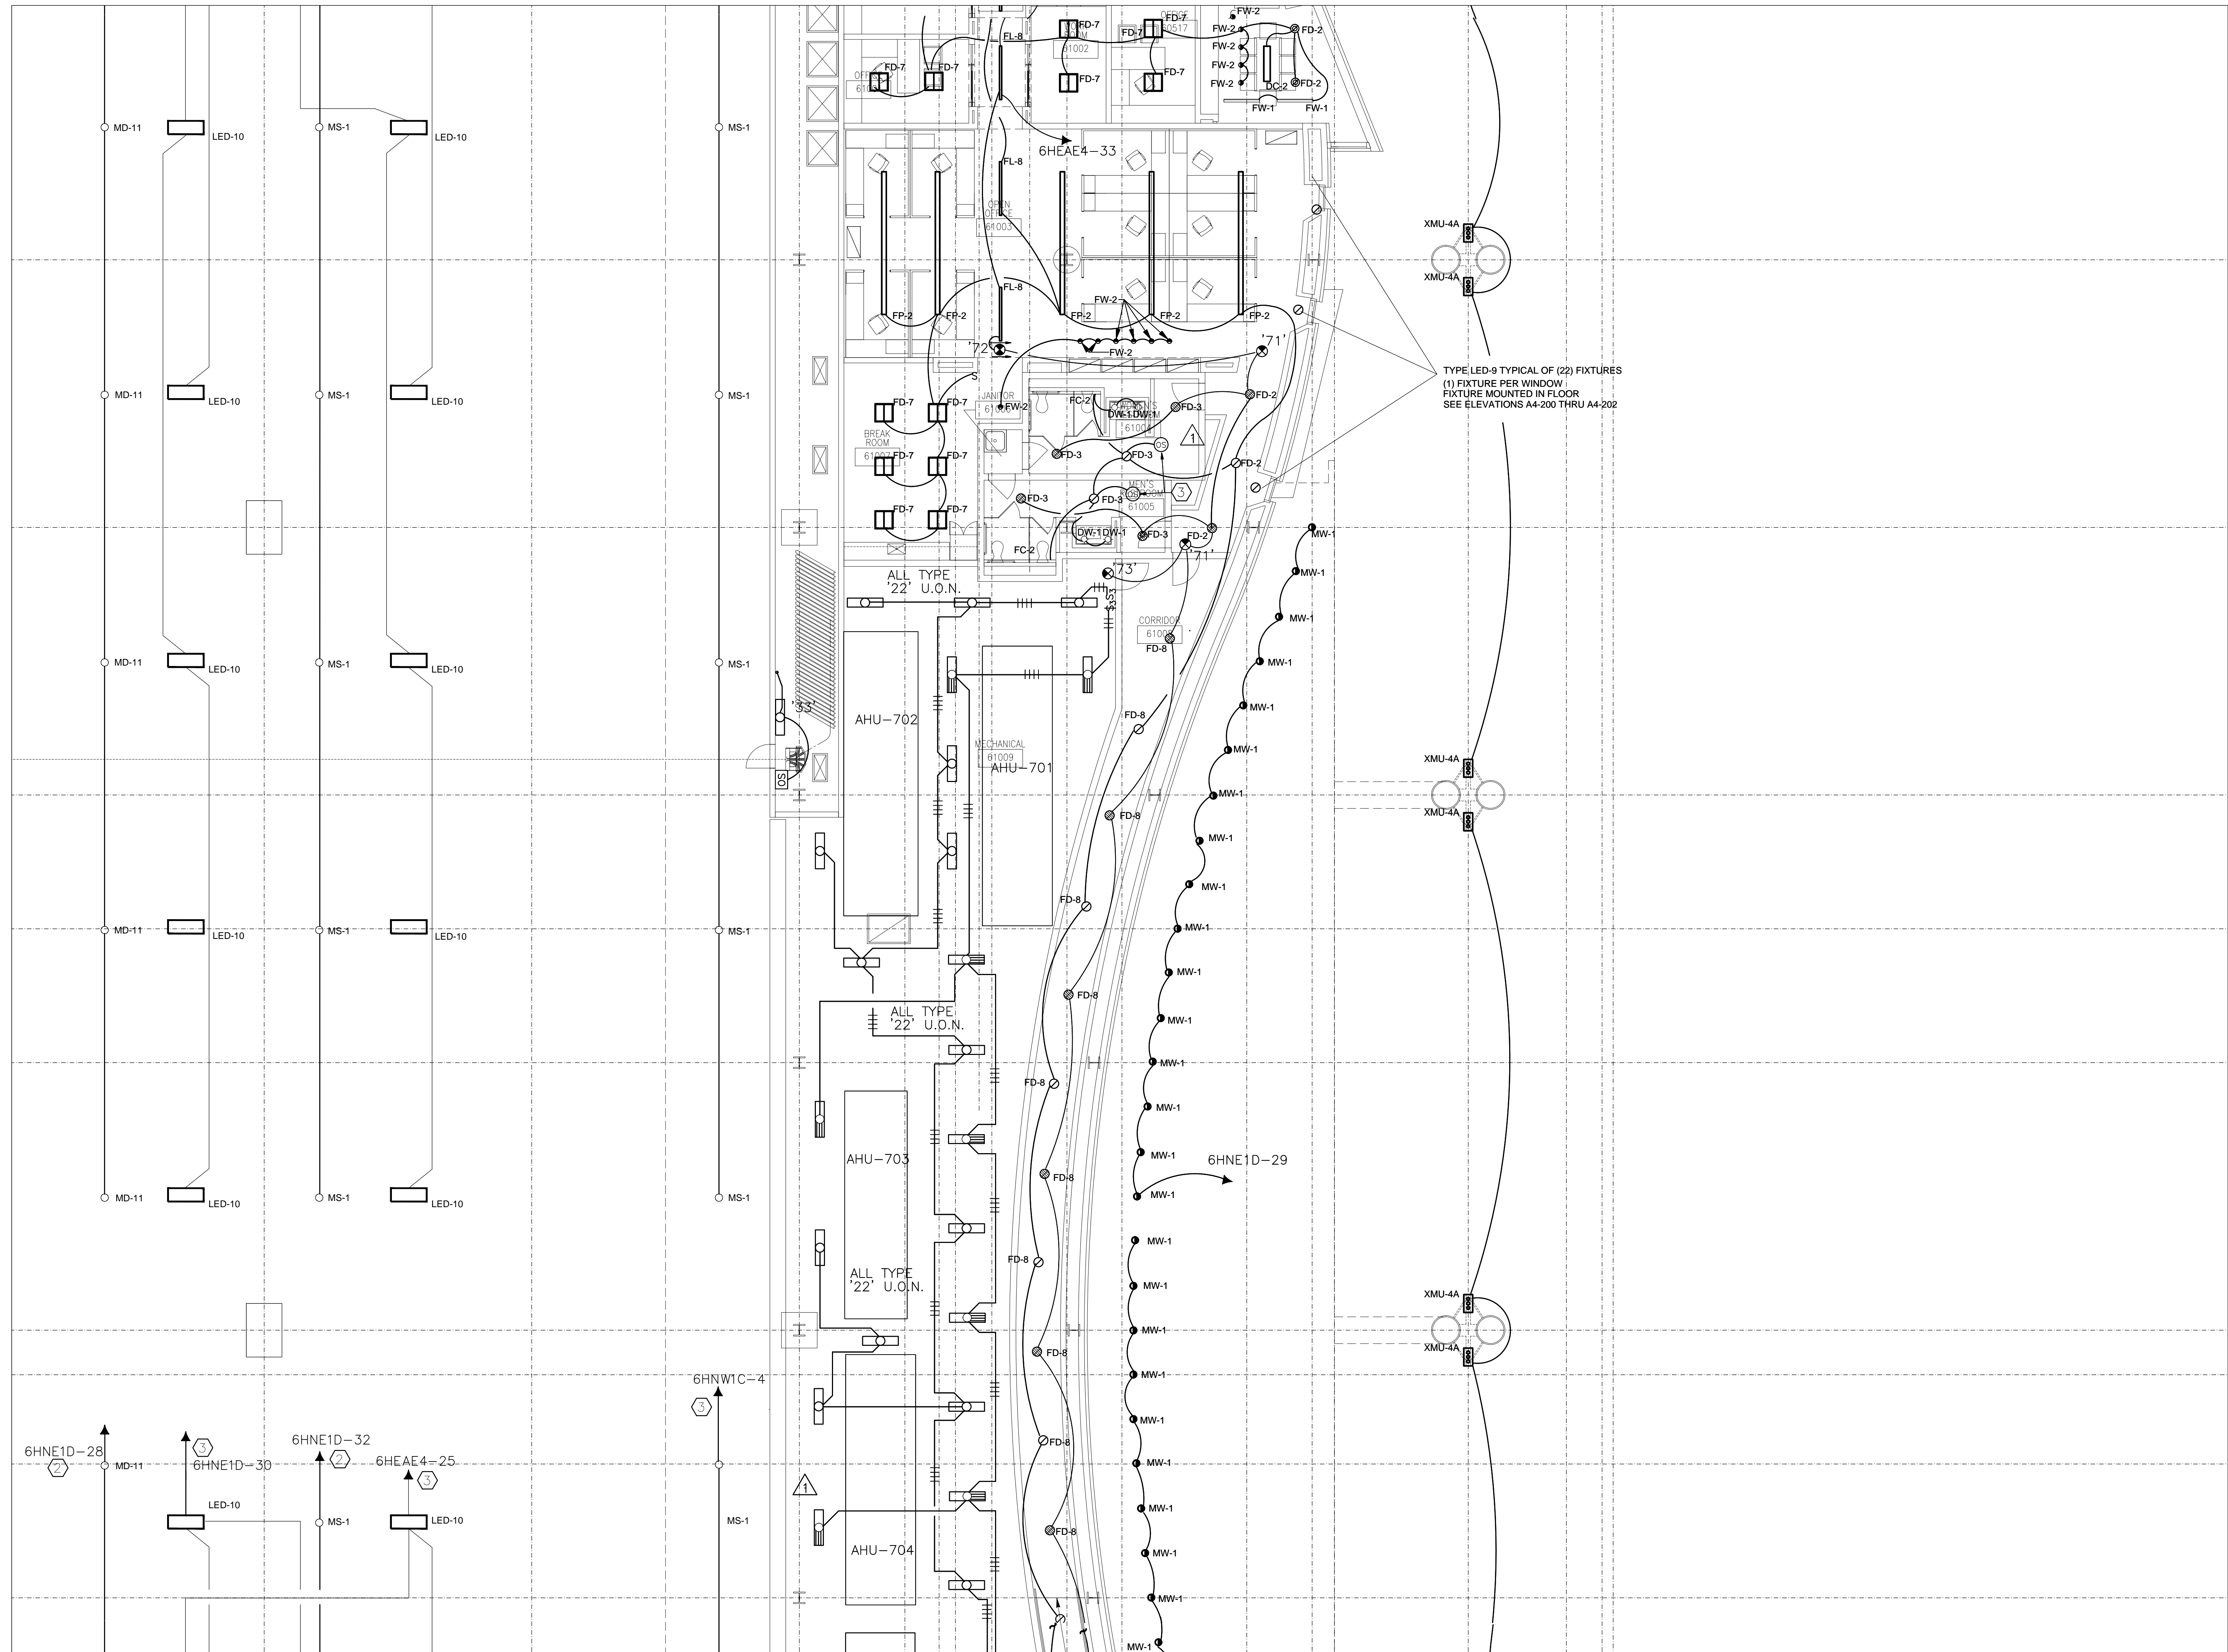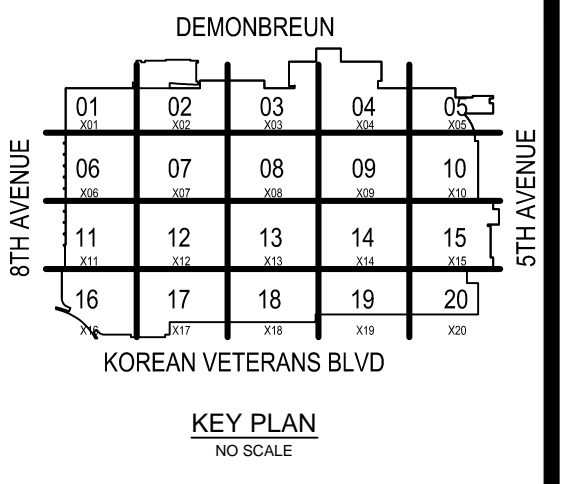

COORDINATION SIGN-OFF

| COMPANY | TRADE | DATE |
|---------|-------|------|
| CONTI | ELEC. | / / |
| | | / / |
| | | / / |
Music City Center
Nashville, Tennessee

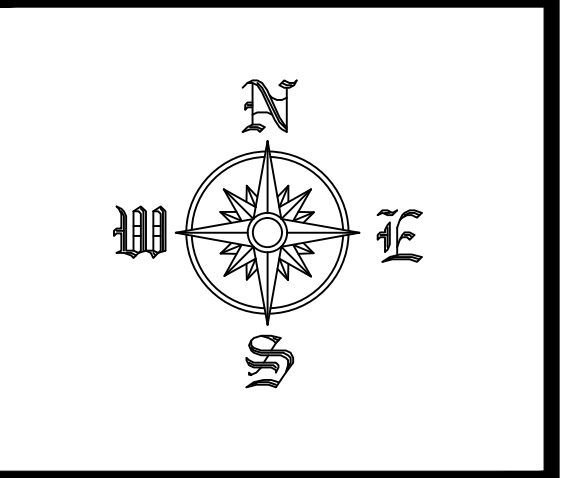

REVISIONS

| NO. | DATE | DESCRIPTION |
|-----|------|-------------|
| | | |
| | | |
RECORD DRAWINGS STAMP

CONTELECTRIC DATE (Last Update): 2/21/2012 9:25 AM
 DRAWING FILE NAME: E22-610
 CAD OPERATOR: GERTMAN
 PRINTED BY: FREDMAN, GREG
 PLOT DATE: 2/21/2012 10:40 AM
 SUBMITTED BY: GERTMAN
 ASSIGNED TO:

LEVEL 6 LIGHTING
 ZONE 10
 SCALE: 1/8" = 1'-0"

EL2-610


FILE PATH FOR CAD OPERATOR: C:\Users\Gertman\OneDrive\Documents\Projects\2012\201202\20120210\20120210_40 AM\20120210_40 AM.dwg

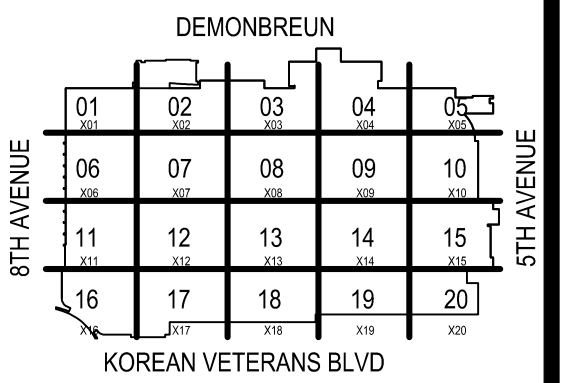

KEY PLAN
NO SCALE

| COORDINATION SIGN-OFF | | DATE | DATE | DATE | DATE | DATE |
|-----------------------|-------|------|------|------|------|------|
| COMPANY | TRADE | NAME | NAME | NAME | NAME | NAME |
| CONTI | ELEC. | | | | | |

Music City Center
Nashville, Tennessee

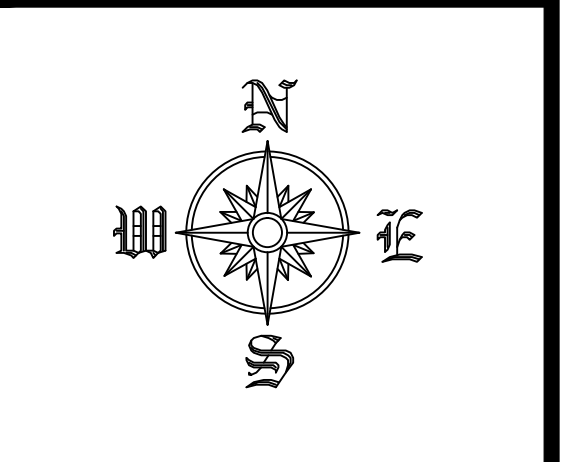


| REVISIONS | | |
|-----------|------|-------------|
| NO. | DATE | DESCRIPTION |
| | | |
| | | |
RECORD DRAWINGS STAMP



CONTELECTRIC DATE (Last Update): 2/21/2012 9:59 AM
 DRAWING FILE NAME: E22-04
 CAD OPERATOR: GERRMAN
 PRINTED BY: FREDMAN, GREGG
 PLOT DATE: 2/21/2012 10:40 AM
 SUBMITTED BY: G.L.P.
 ASSIGNED TO:

LEVEL 6 LIGHTING
 ZONE 11
 SCALE: 1/8" = 1'-0"

EL2-611

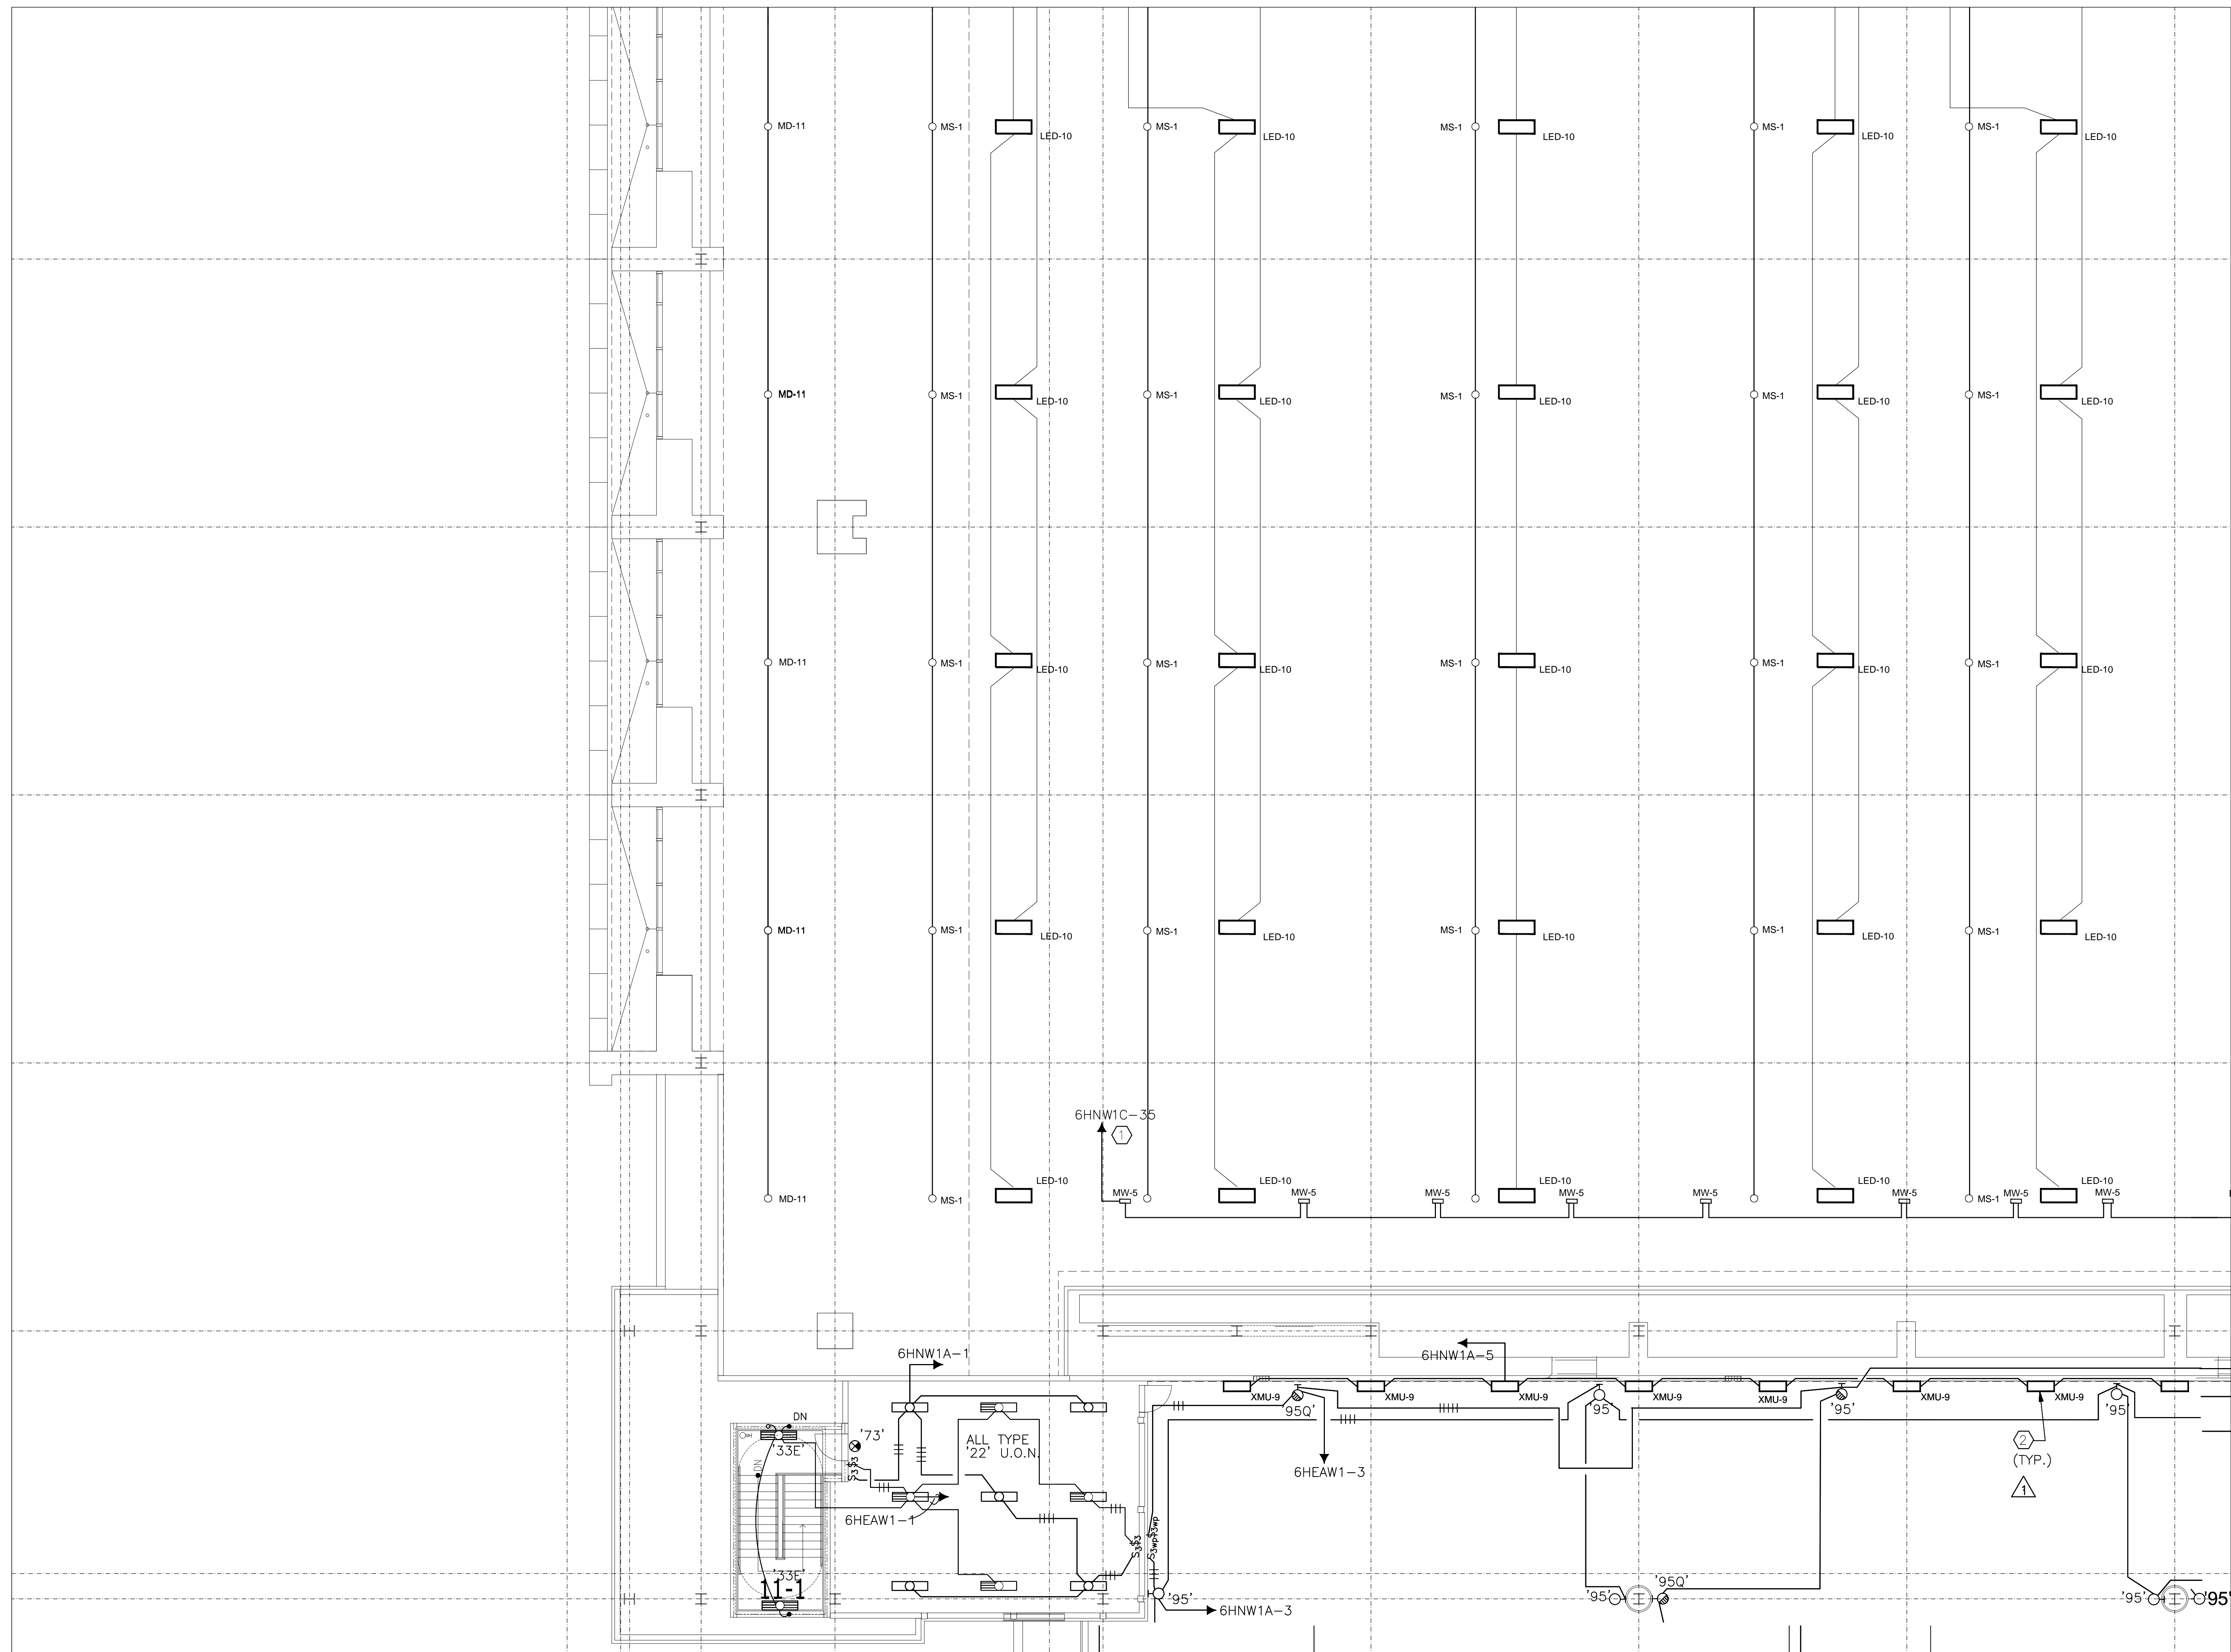


FILE PATH FOR CAD OPERATOR USE ONLY: C:\Users\Gerrman\Documents\Projects\Conti\Conti - Music City Center - 4/13/12\Level 6 Lighting\Zone 11 For Opening

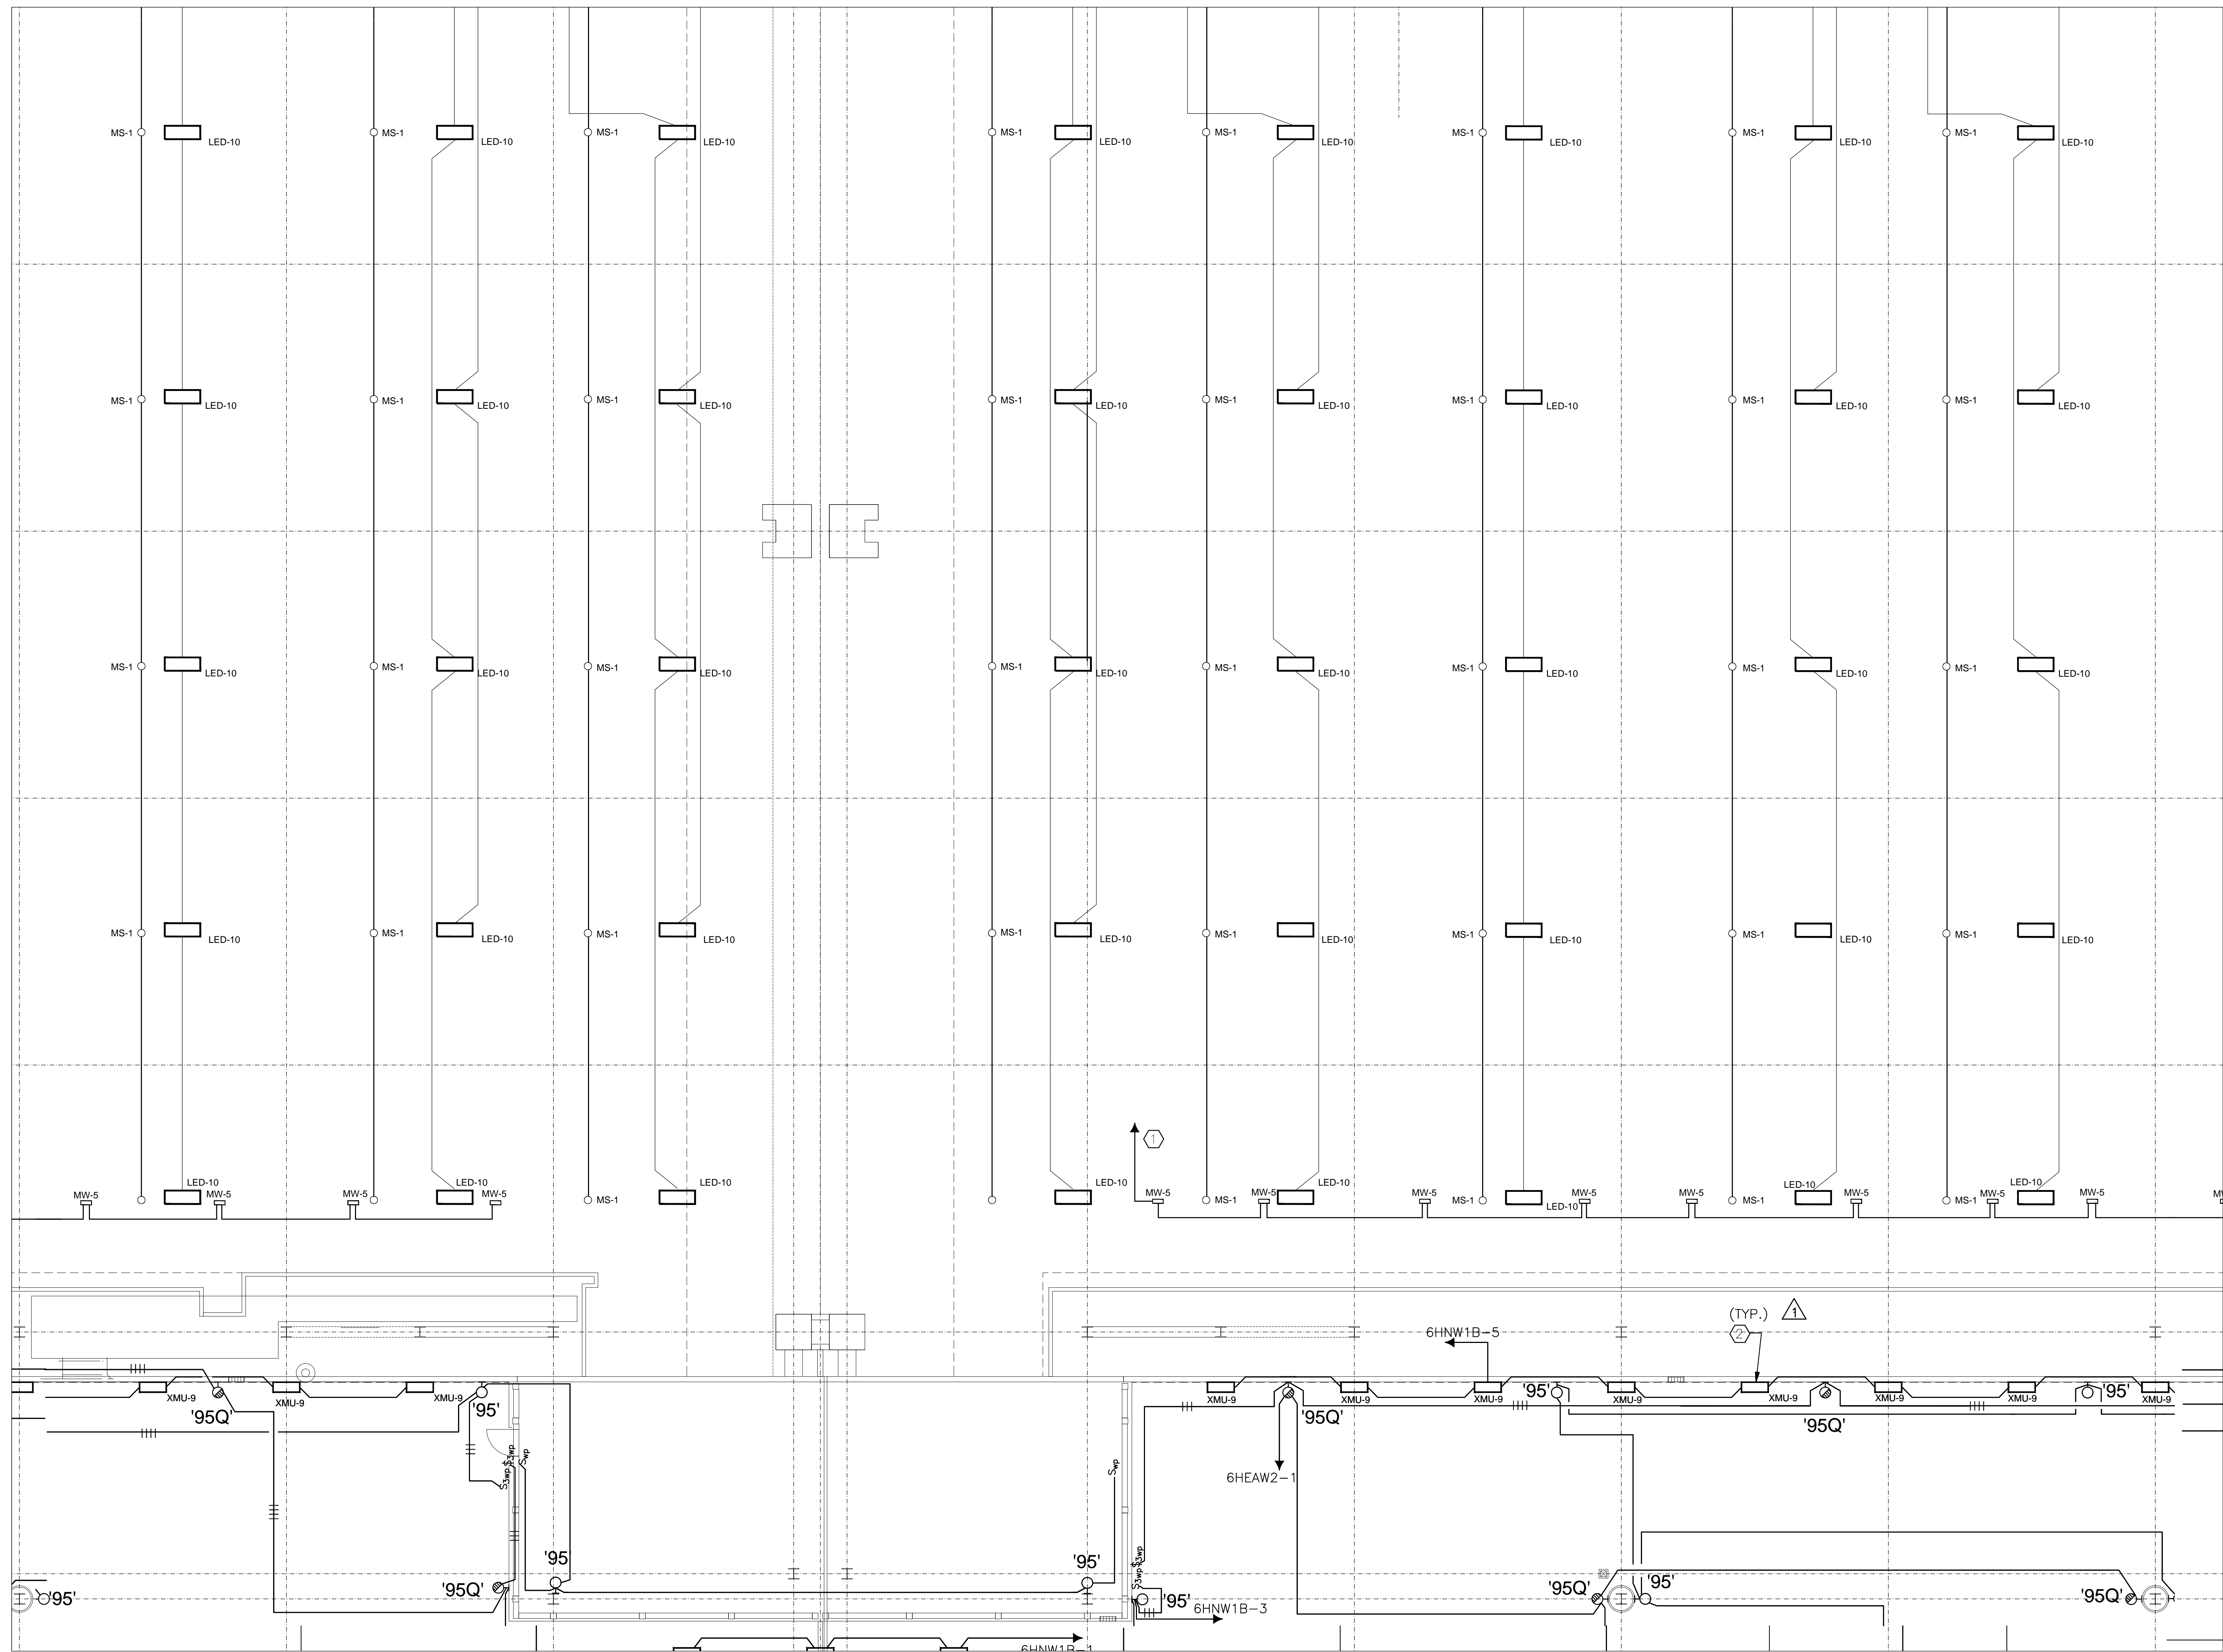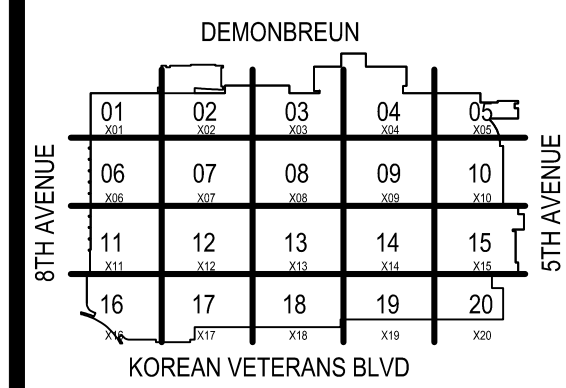

| COORDINATION SIGN-OFF | |
|-----------------------|------|
| COMPANY | DATE |
| CONTI | / / |
| | / / |
| | / / |
Music City Center
 Nashville, Tennessee

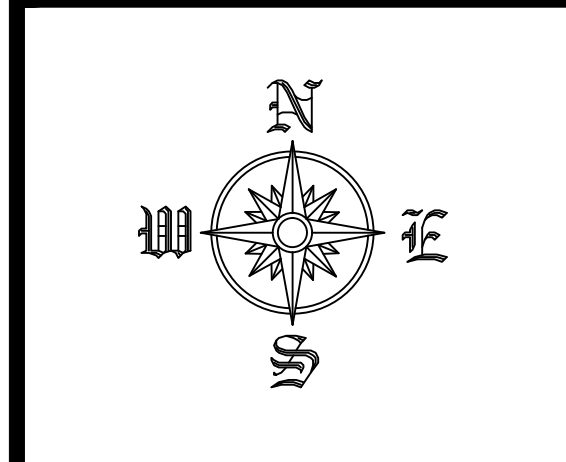

| REVISIONS | | |
|-----------|------|-------------|
| NO. | DATE | DESCRIPTION |
| | | |
| | | |
RECORD DRAWINGS STAMP

CONTELECTRIC DATE (Last Update):
 2/21/2012 9:59 AM
 DRAWING FILE NAME:
 E22-04
 CAD OPERATOR:
 GERRMAN
 PRINTED BY:
 FREDMAN, GREGG
 PLOT DATE:
 2/21/2012 10:40 AM
 SUBMITTED BY:
 G.L.F.
 ASSIGNED TO:

LEVEL 6 LIGHTING
 ZONE 12
 SCALE: 1/8" = 1'-0"


EL2-612

FILE PATH FOR CAD OPERATOR USE ONLY: P:\2012\Conti\Bids\Nashville_MCC\Zone 12 Lighting\Zone 12 Lighting_Schedule For Owner.rvt

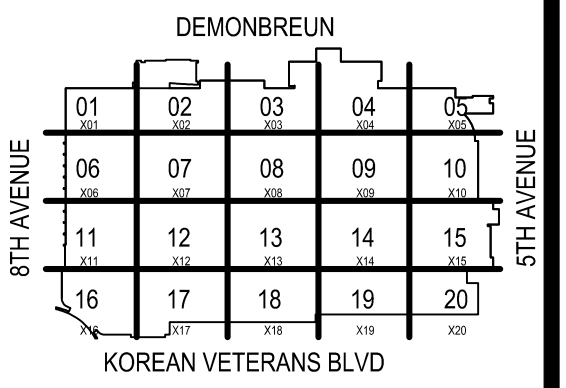

| COMPANY | TRADE | NAME | DATE | |
|---------|-------|------|------|------|
| | | | DATE | DATE |
| CONTI | ELEC. | | / | / |
| | | | / | / |
| | | | / | / |
Music City Center
Nashville, Tennessee

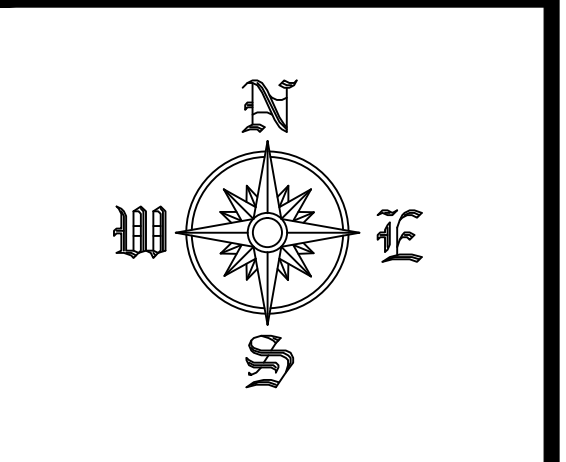


| REVISIONS | | |
|-----------|------|-------------|
| NO. | DATE | DESCRIPTION |
| | | |
| | | |
RECORD DRAWINGS STAMP


CONTELECTRIC DATE (Last Update): 2/21/2013 9:25 AM
 DRAWING FILE NAME: E22-04
 CAD OPERATOR: GERRITMAN
 PRINTED BY: FREDMAN.GREGG
 PLOT DATE: 2/21/2013 10:40 AM
 SUBMITTED BY: G.L.P.
 ASSIGNED TO:

LEVEL 6 LIGHTING
 ZONE 13
 SCALE: 1/8" = 1'-0"

EL2-613

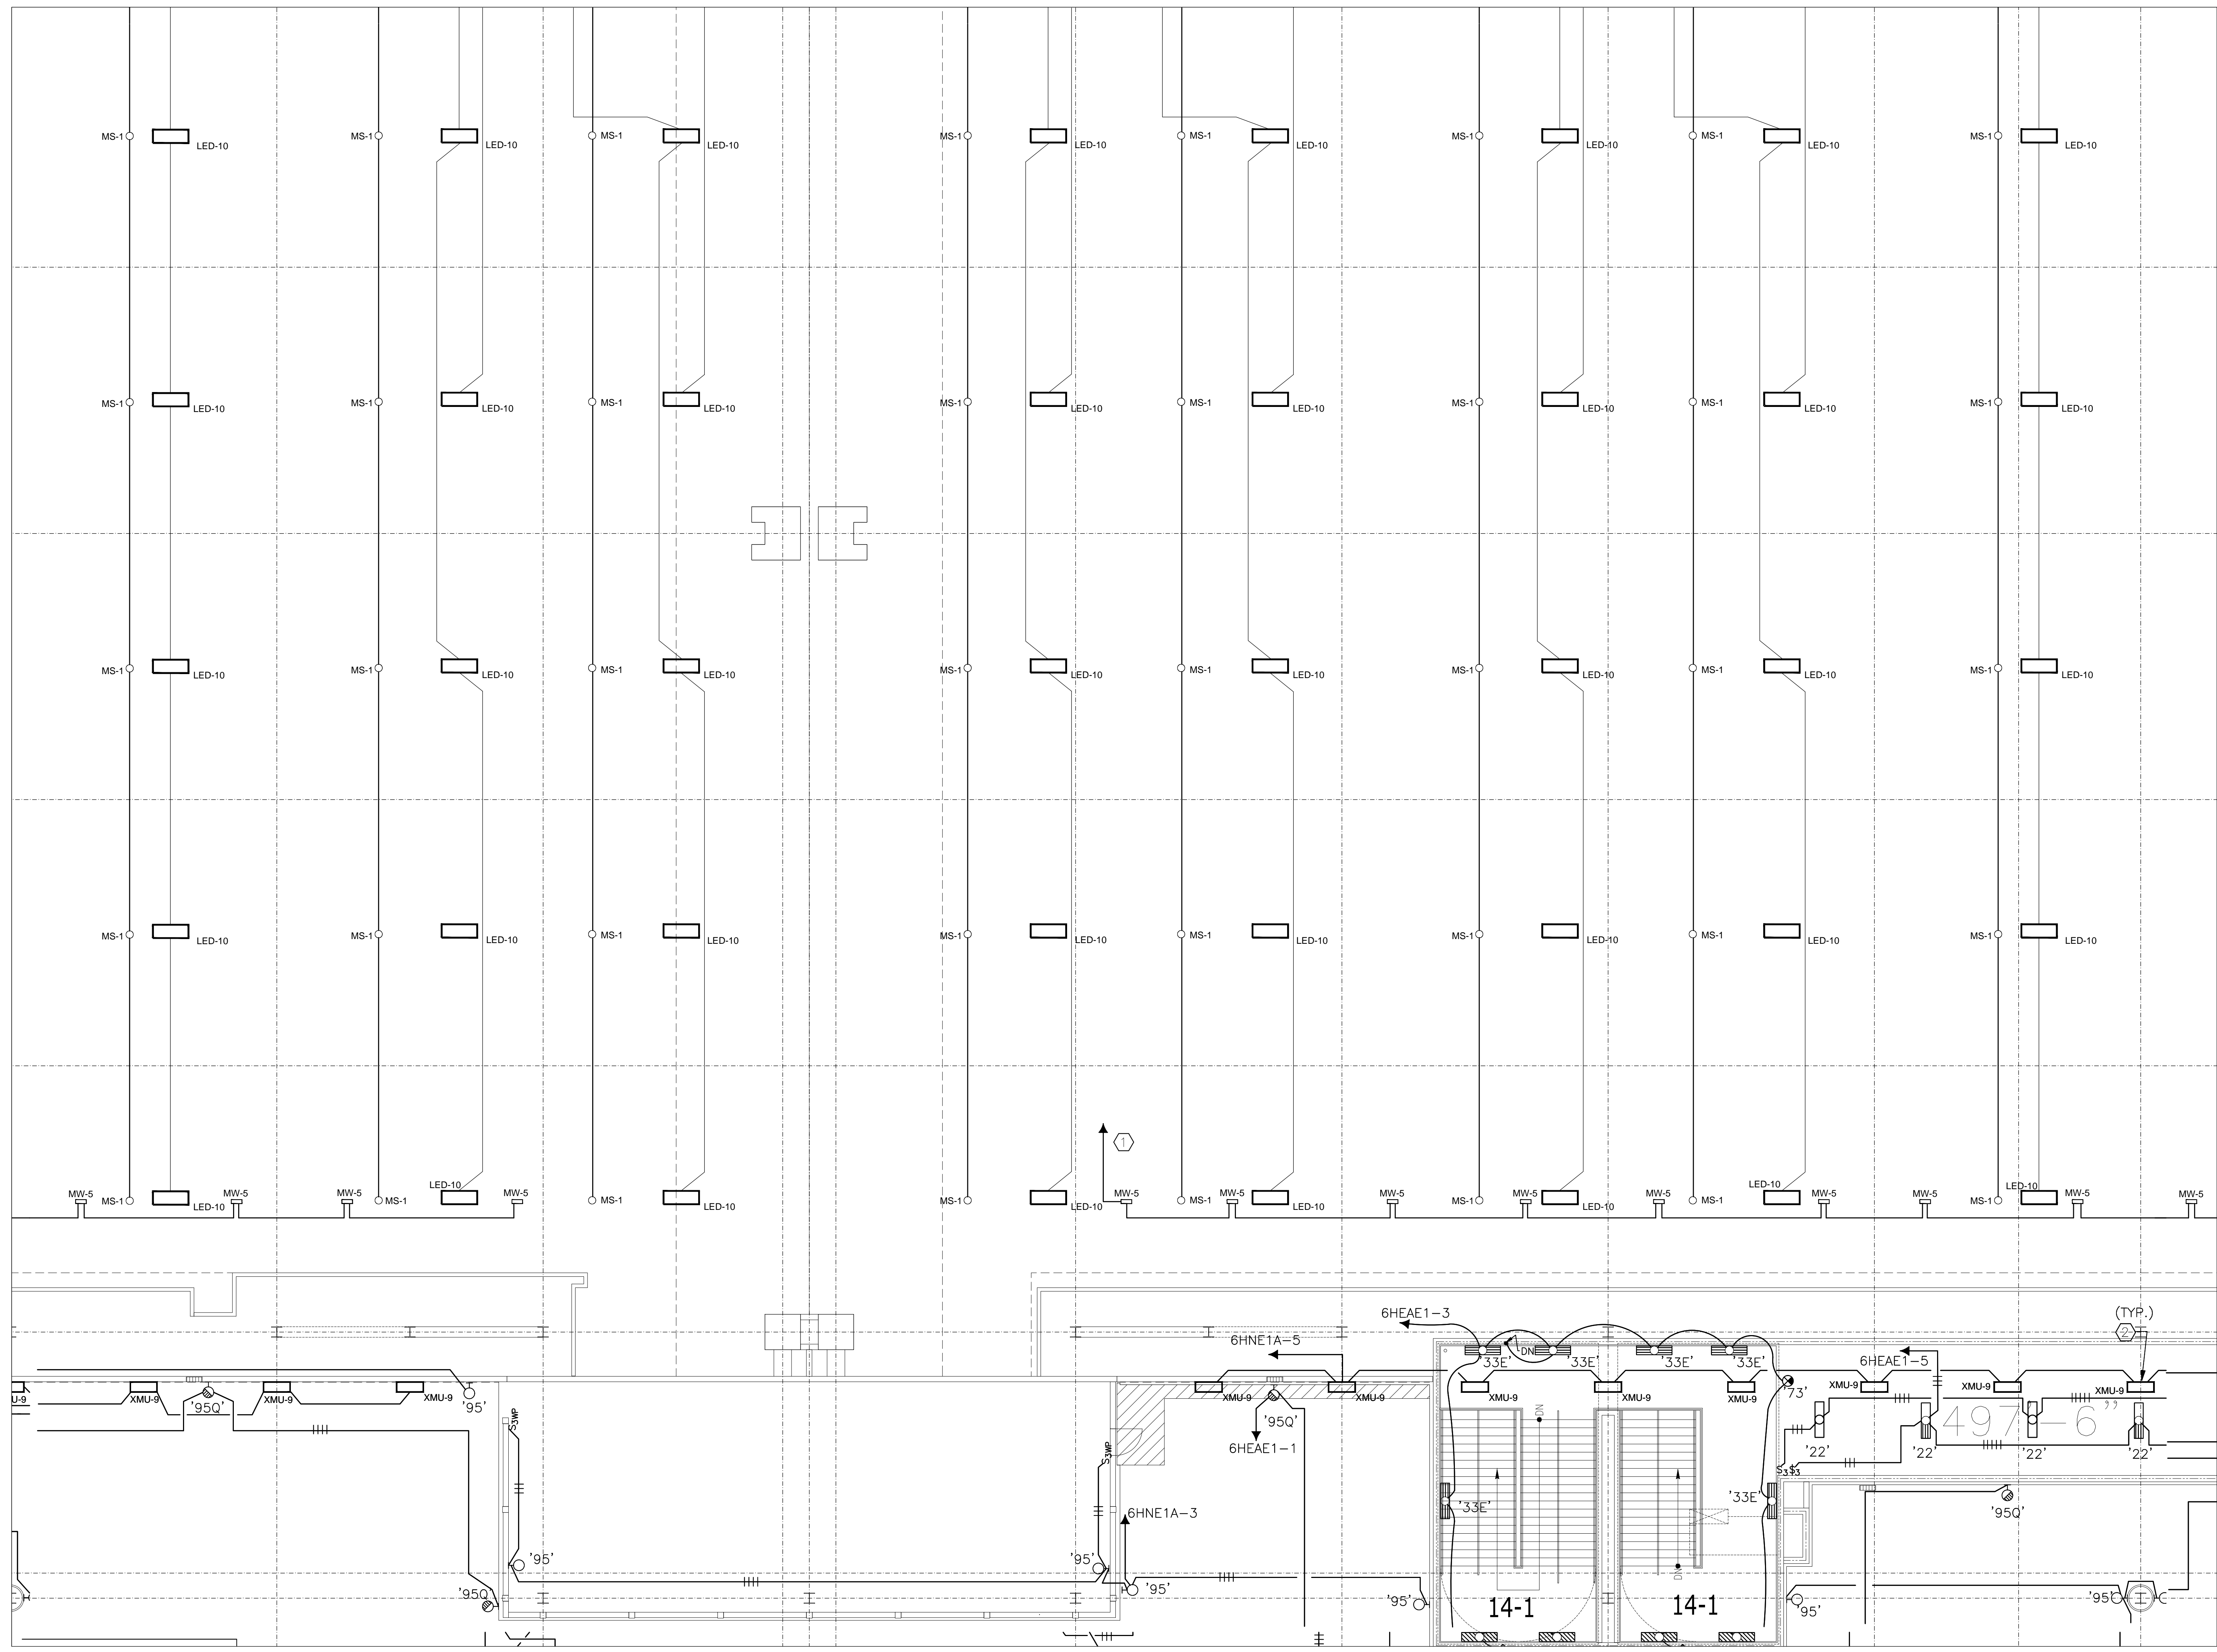


FILE PATH FOR CAD OPERATOR USE ONLY: P:\2013\Conti\Bldg\Nashville_MusicCity\Level 6 Lighting\Zone 13.dwg

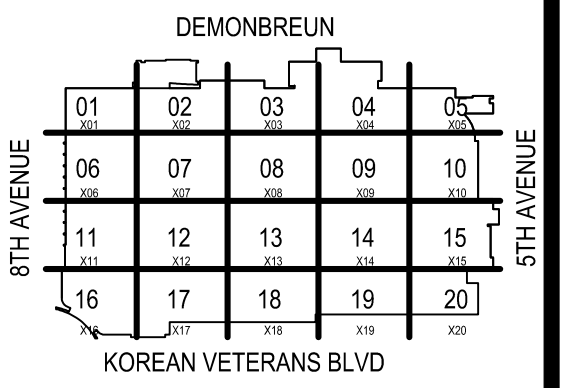

KEY PLAN
NO SCALE

| COORDINATION SIGN-OFF | |
|-----------------------|-------|
| DATE | NAME |
| / / | |
| / / | |
| TRADE | ELEC. |
| | |
| | |
| COMPANY | EDUC. |
| CONTI | |

Music City Center
Nashville, Tennessee

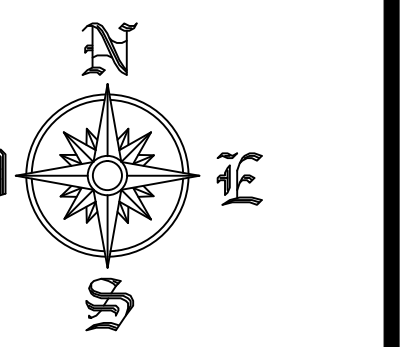


| REVISIONS | | |
|-----------|------|-------------|
| NO. | DATE | DESCRIPTION |
| | | |
| | | |
| RECORD DRAWINGS STAMP | |
|------------------------------------|--------------------|
| CONTI ELECTRIC DATE (Last Update): | 2/21/2012 9:25 AM |
| DRAWING FILE NAME: | EL2-614 |
| OPERATOR: | GERMAN |
| CAD OPERATOR: | GERMAN, GREGG |
| PRINTED BY: | GERMAN, GREGG |
| PLOT DATE: | 2/21/2012 10:40 AM |
| SUBMITTED BY: | ELP |
| ASSIGNED TO: | |

LEVEL 6 LIGHTING
ZONE 14
SCALE: 1/8" = 1'-0"

EL2-614

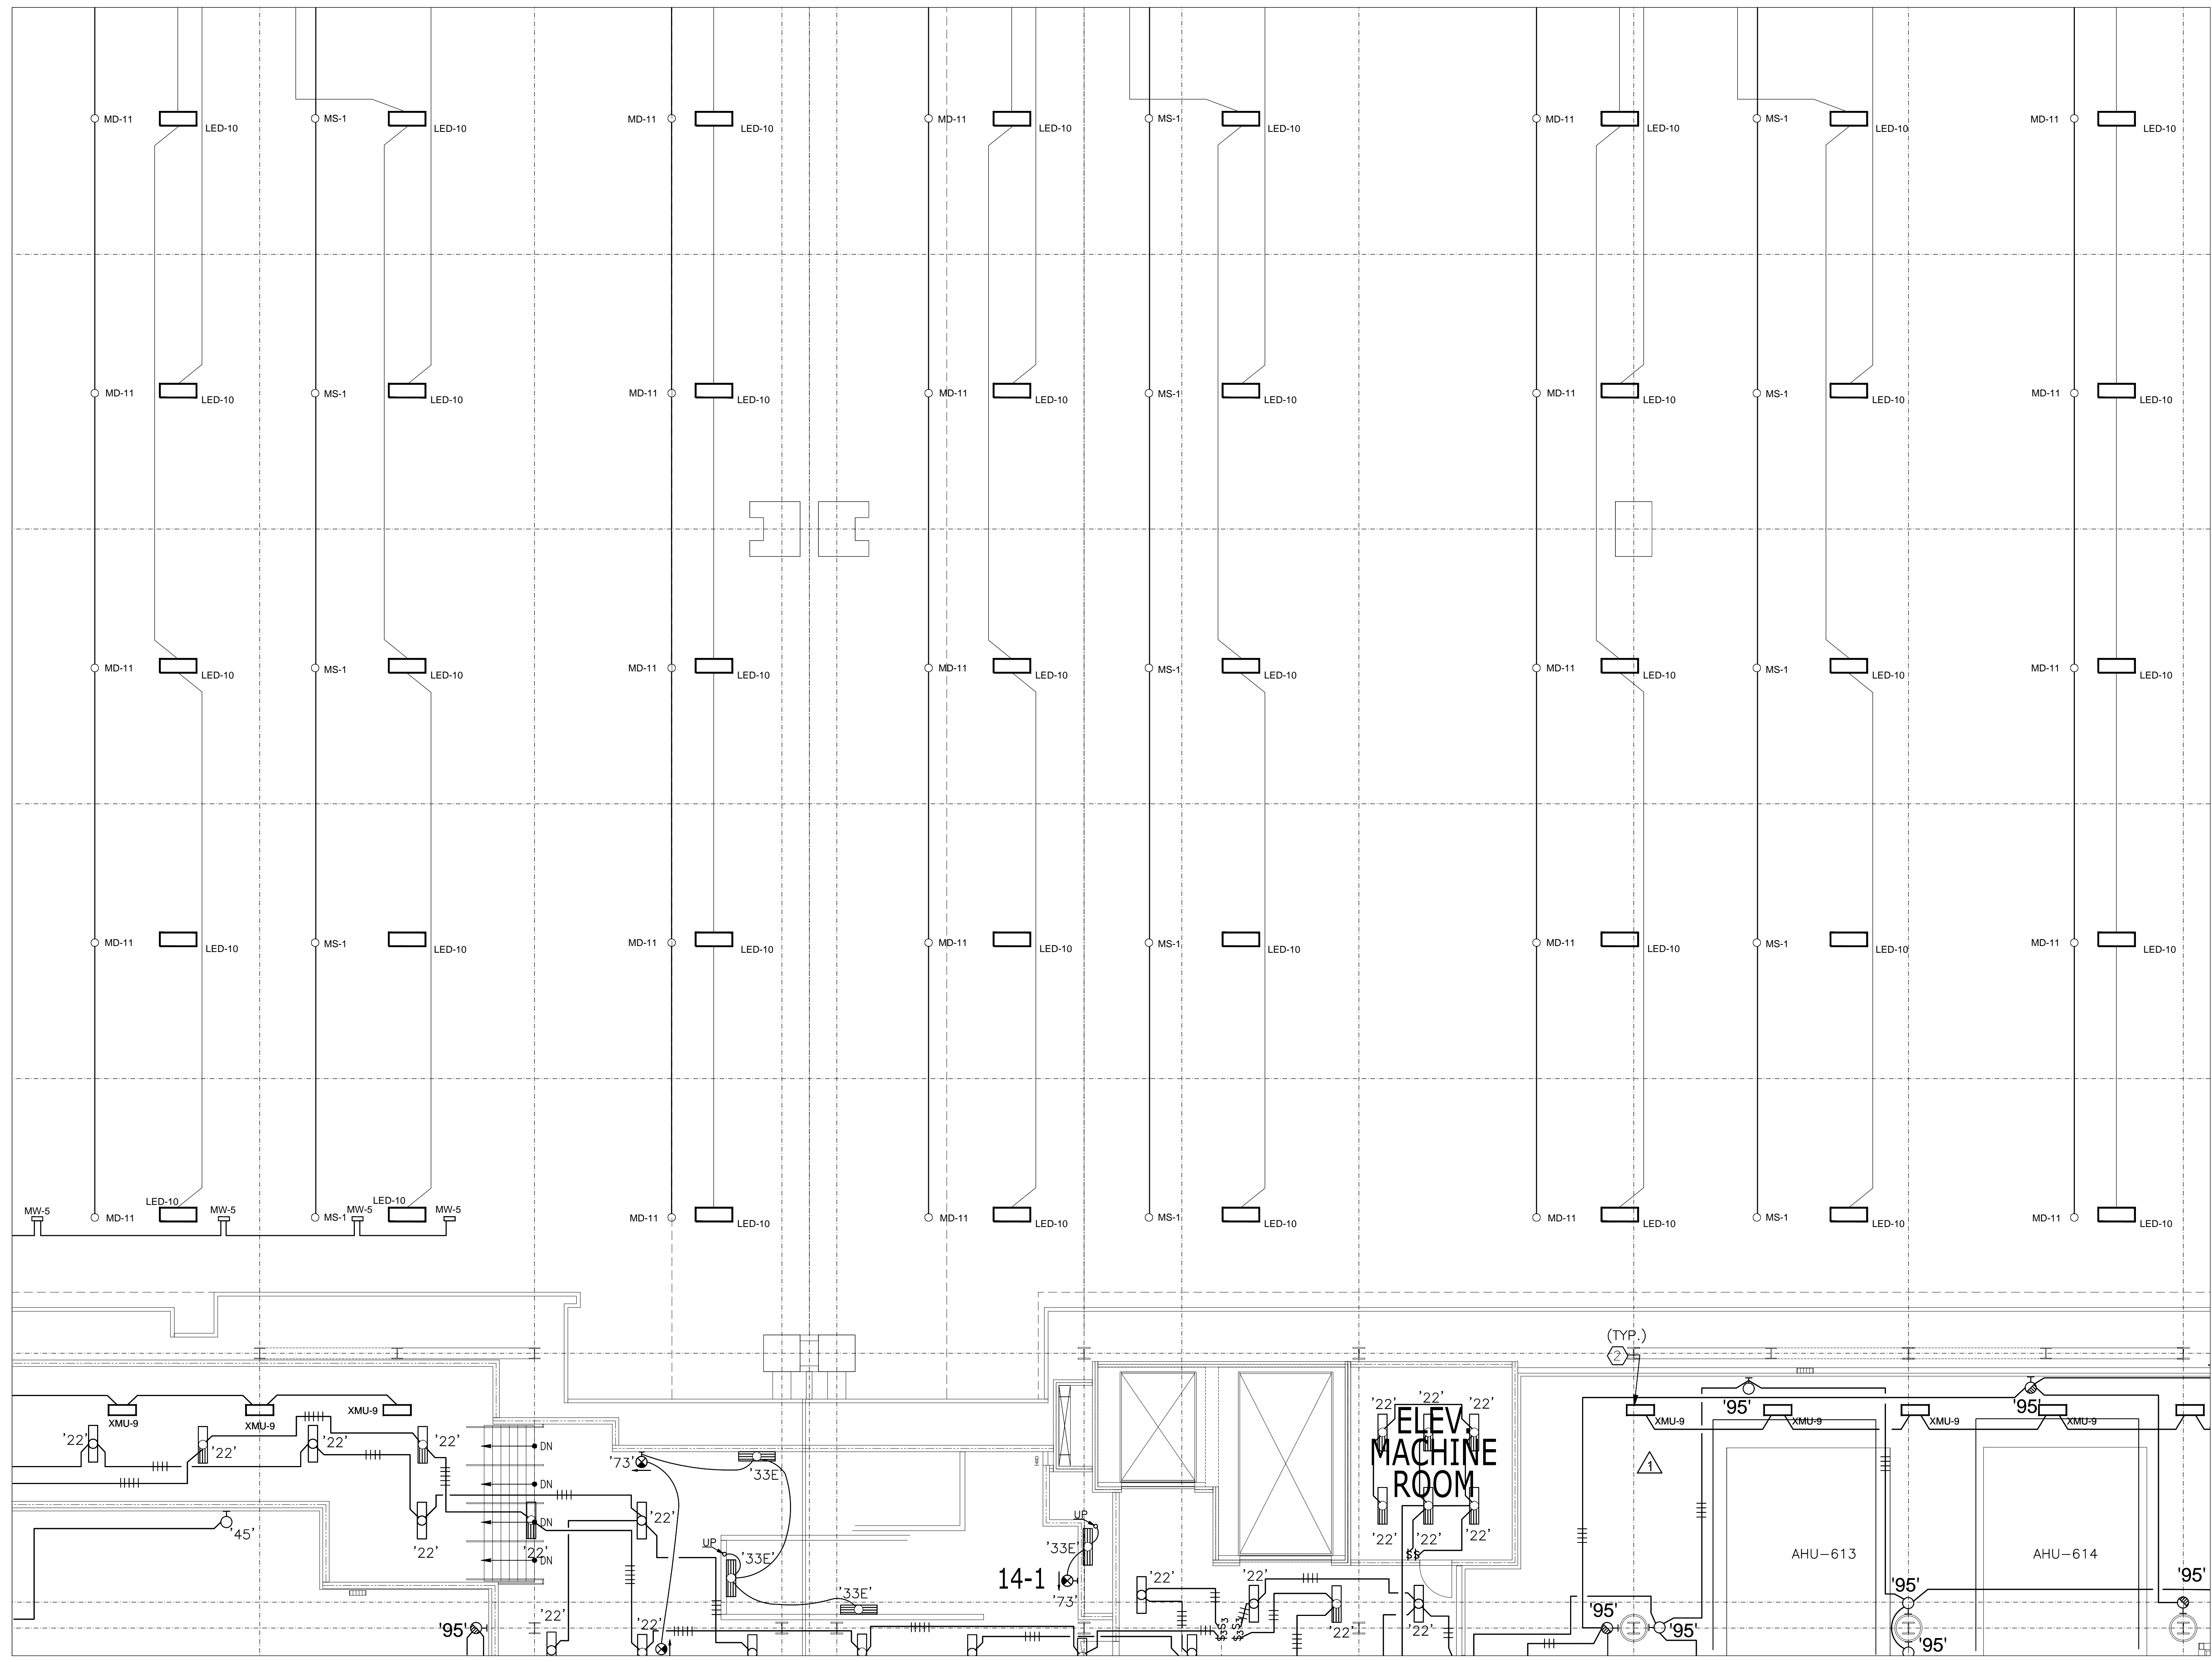


FILE PATH FOR CAD OPERATOR USE ONLY: P:\2012\Conti Electric\Nashville MusicCity_City Center As-Built\41313\Level 6 Lighting\Zone 14 For Opening.dwg

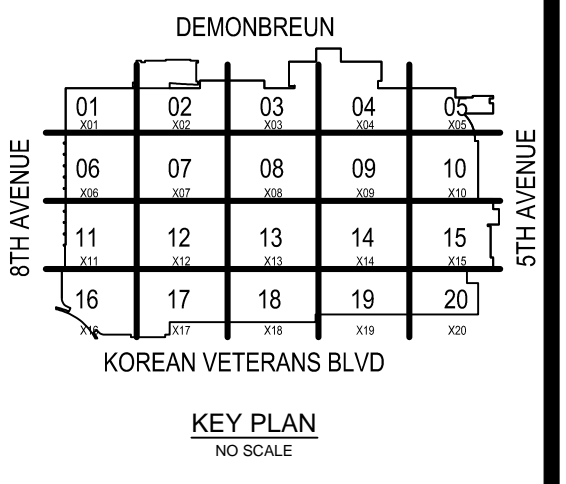

| COORDINATION SIGN-OFF | |
|-----------------------|------|
| COMPANY | DATE |
| NAME | DATE |
| TRADE | DATE |
| ELEC. | DATE |
| CONTI | DATE |

Music City Center
Nashville, Tennessee

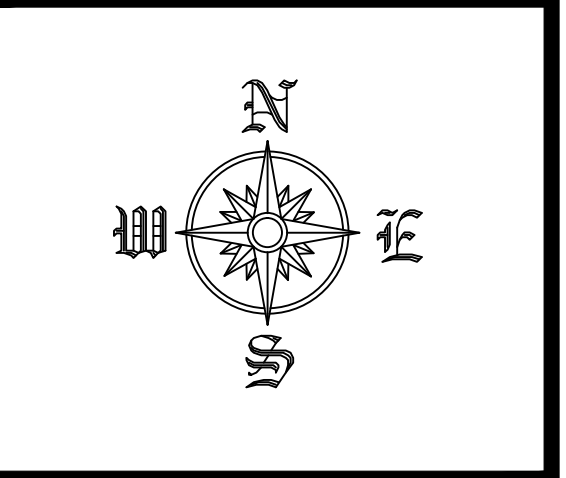


| REVISIONS | | |
|-----------|------|-------------|
| NO. | DATE | DESCRIPTION |
| | | |
| | | |
| RECORD DRAWINGS STAMP | |
|----------------------------------|--------------------|
| CONTELECTRIC DATE (Last Update): | 2/21/2012 9:55 AM |
| DRAWING FILE NAME: | EL2-615 |
| CAD OPERATOR: | SEANMAN |
| PRINTED BY: | SEANMAN |
| PLOT DATE: | 2/21/2012 10:40 AM |
| SUBMITTED BY: | SEAN |
| ASSIGNED TO: | |

LEVEL 6 LIGHTING
 ZONE 15
 SCALE: 1/8" = 1'-0"

EL2-615

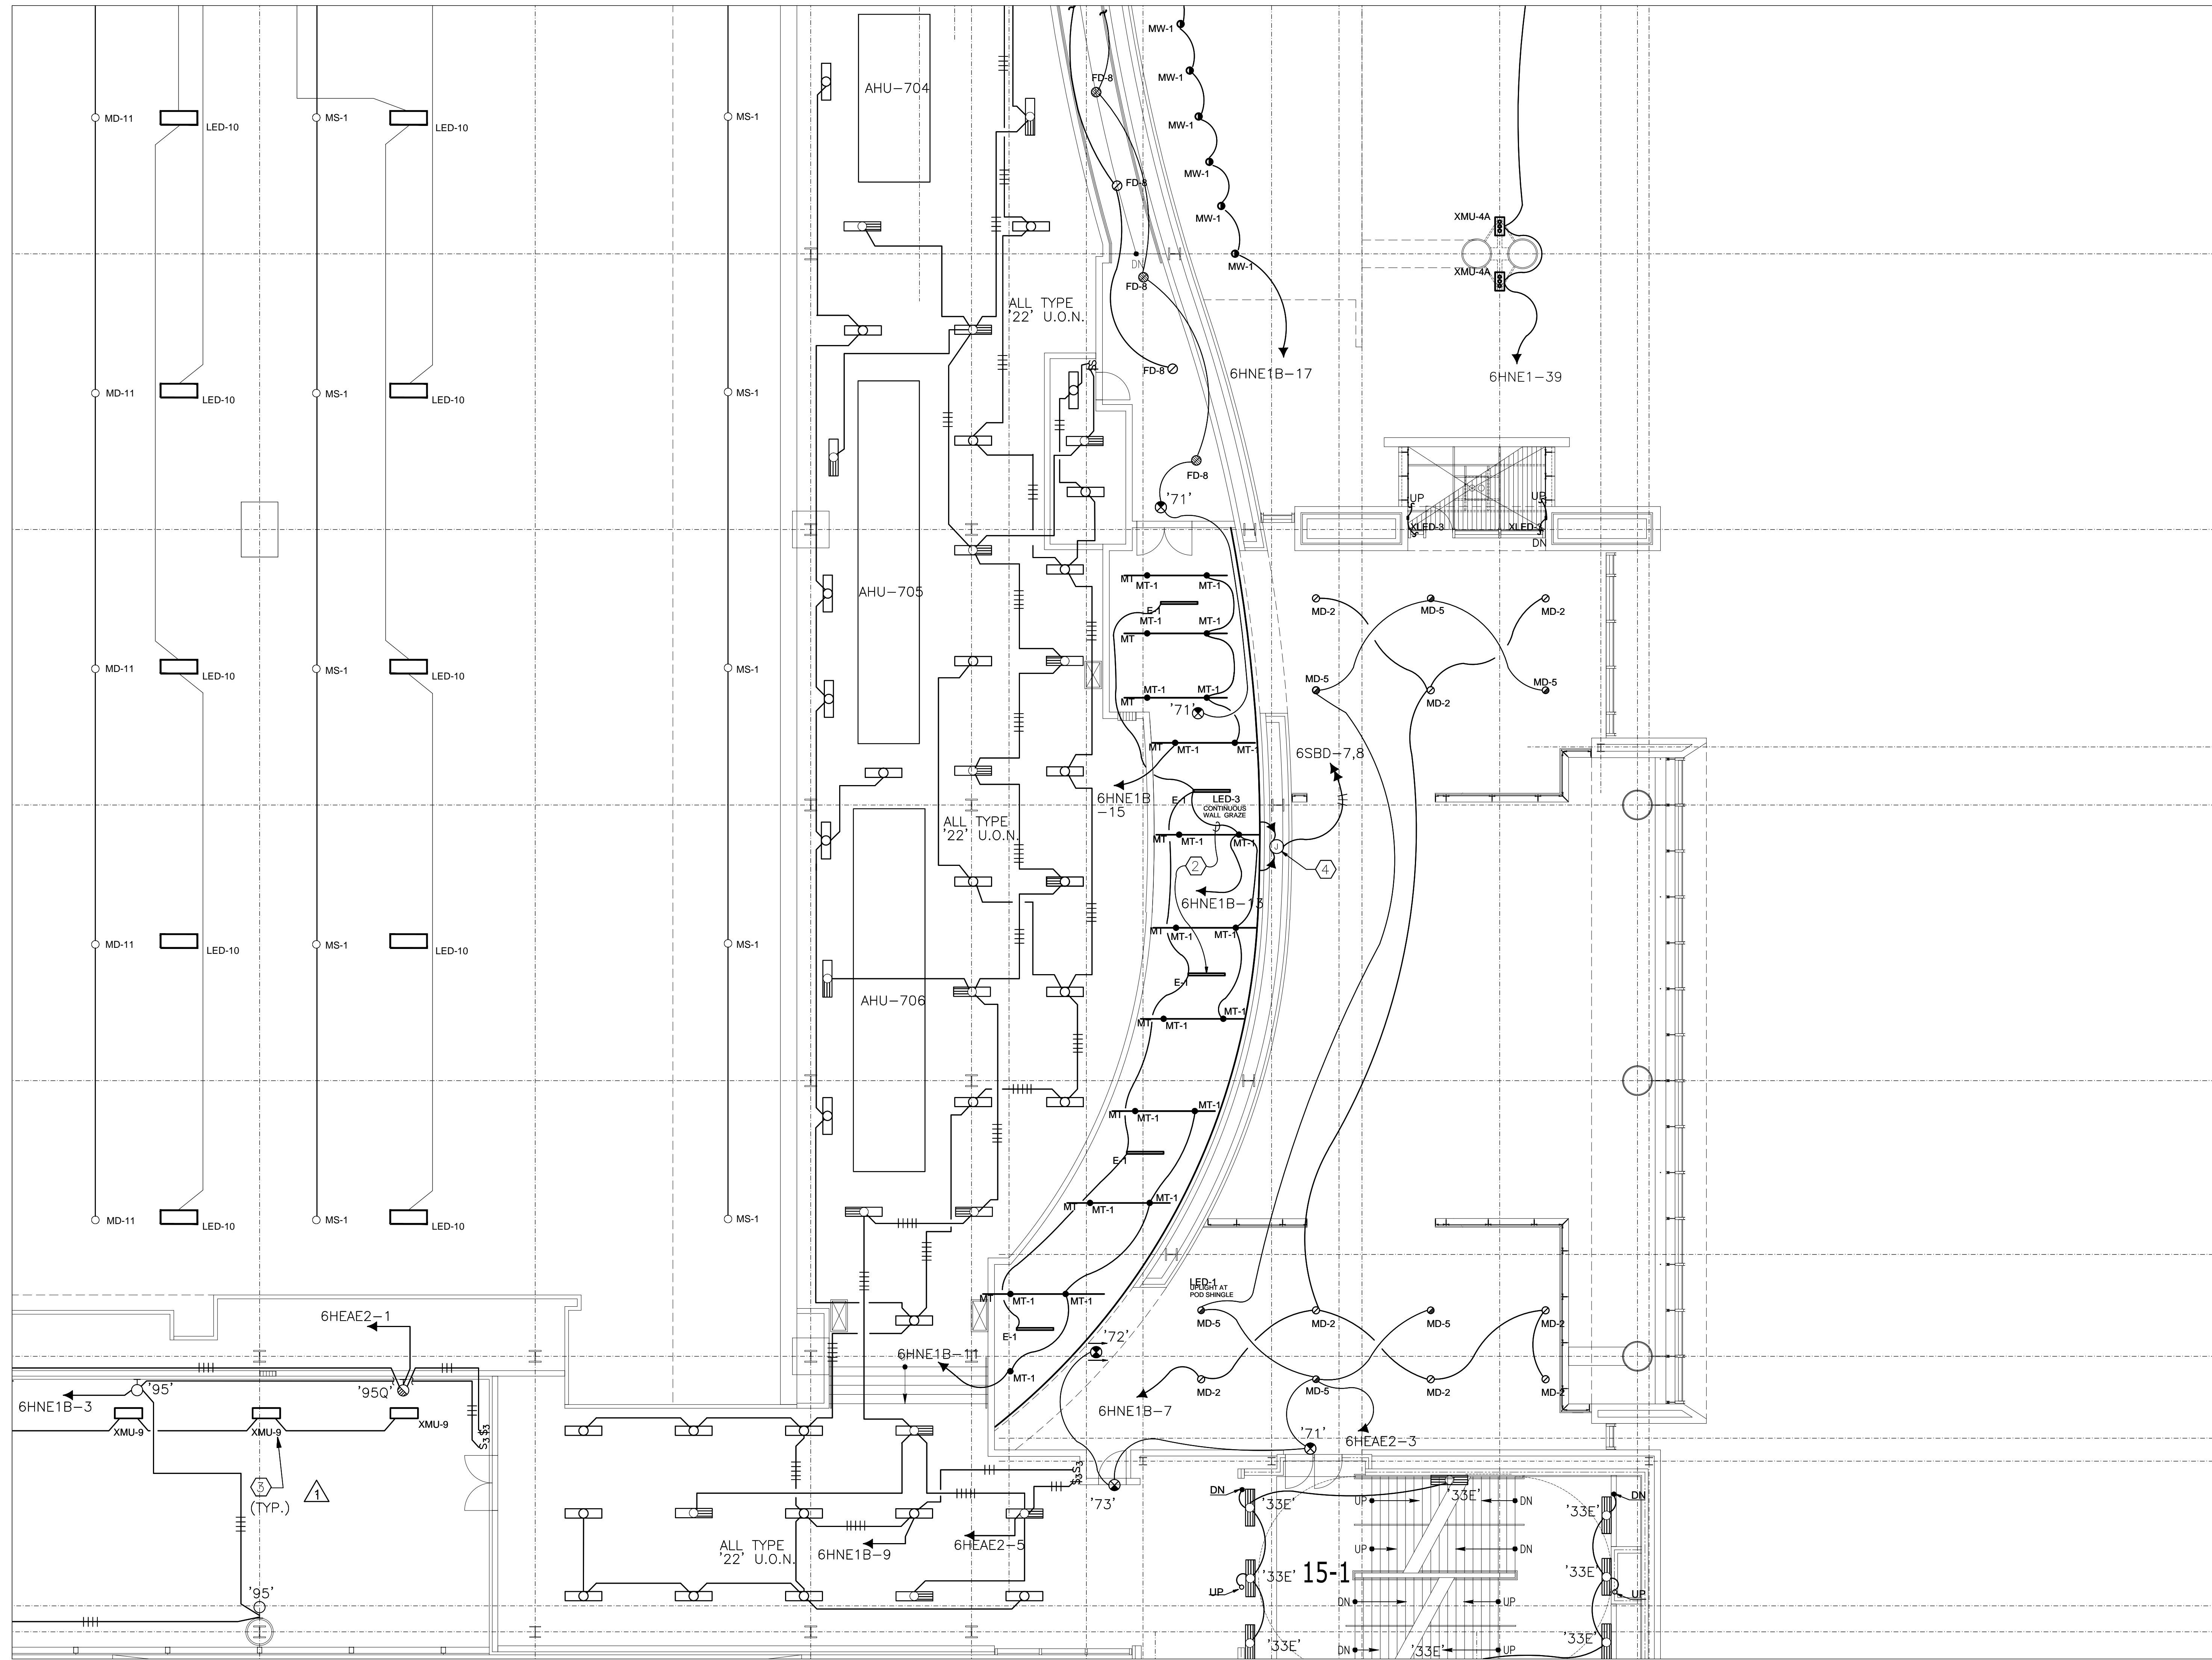


FILE PATH FOR CAD OPERATOR USE ONLY: P:\2012\Conti\Bids\Nashville_MCC\Level 6 Lighting\Zone 15 For Operating

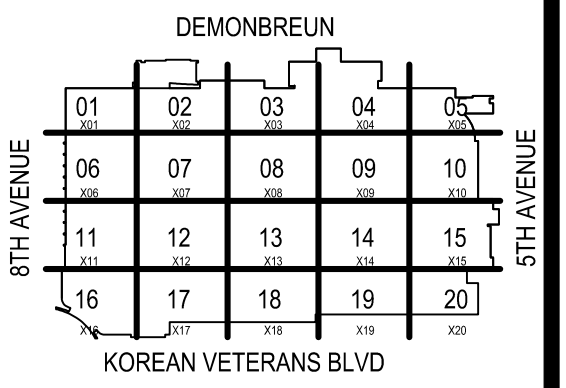

KEY PLAN
NO SCALE

| COORDINATION SIGN-OFF | | DATE |
|-----------------------|-------|------|
| COMPANY | TRADE | NAME |
| CONTI | ELEC. | / / |
| | | / / |
| | | / / |
Music City Center
Nashville, Tennessee

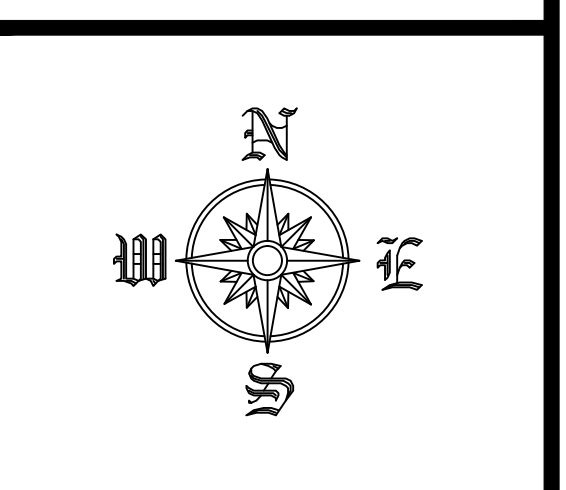

REVISIONS


| NO. | DATE | DESCRIPTION |
|-----|------|-------------|
| | | |
| | | |
RECORD DRAWINGS STAMP

CONTI ELECTRIC DATE (Last Update): 2/21/2012 10:40 AM
 DRAWING FILE NAME: EL2-616
 CAD OPERATOR: GERTMAN
 PRINTED BY: FREDMAN, GREG
 PLOT DATE: 2/21/2012 10:40 AM
 SUBMITTED BY: G.L.P.
 ASSIGNED TO:

LEVEL 6 LIGHTING
 ZONE 16
 SCALE: 1/8" = 1'-0"

EL2-616

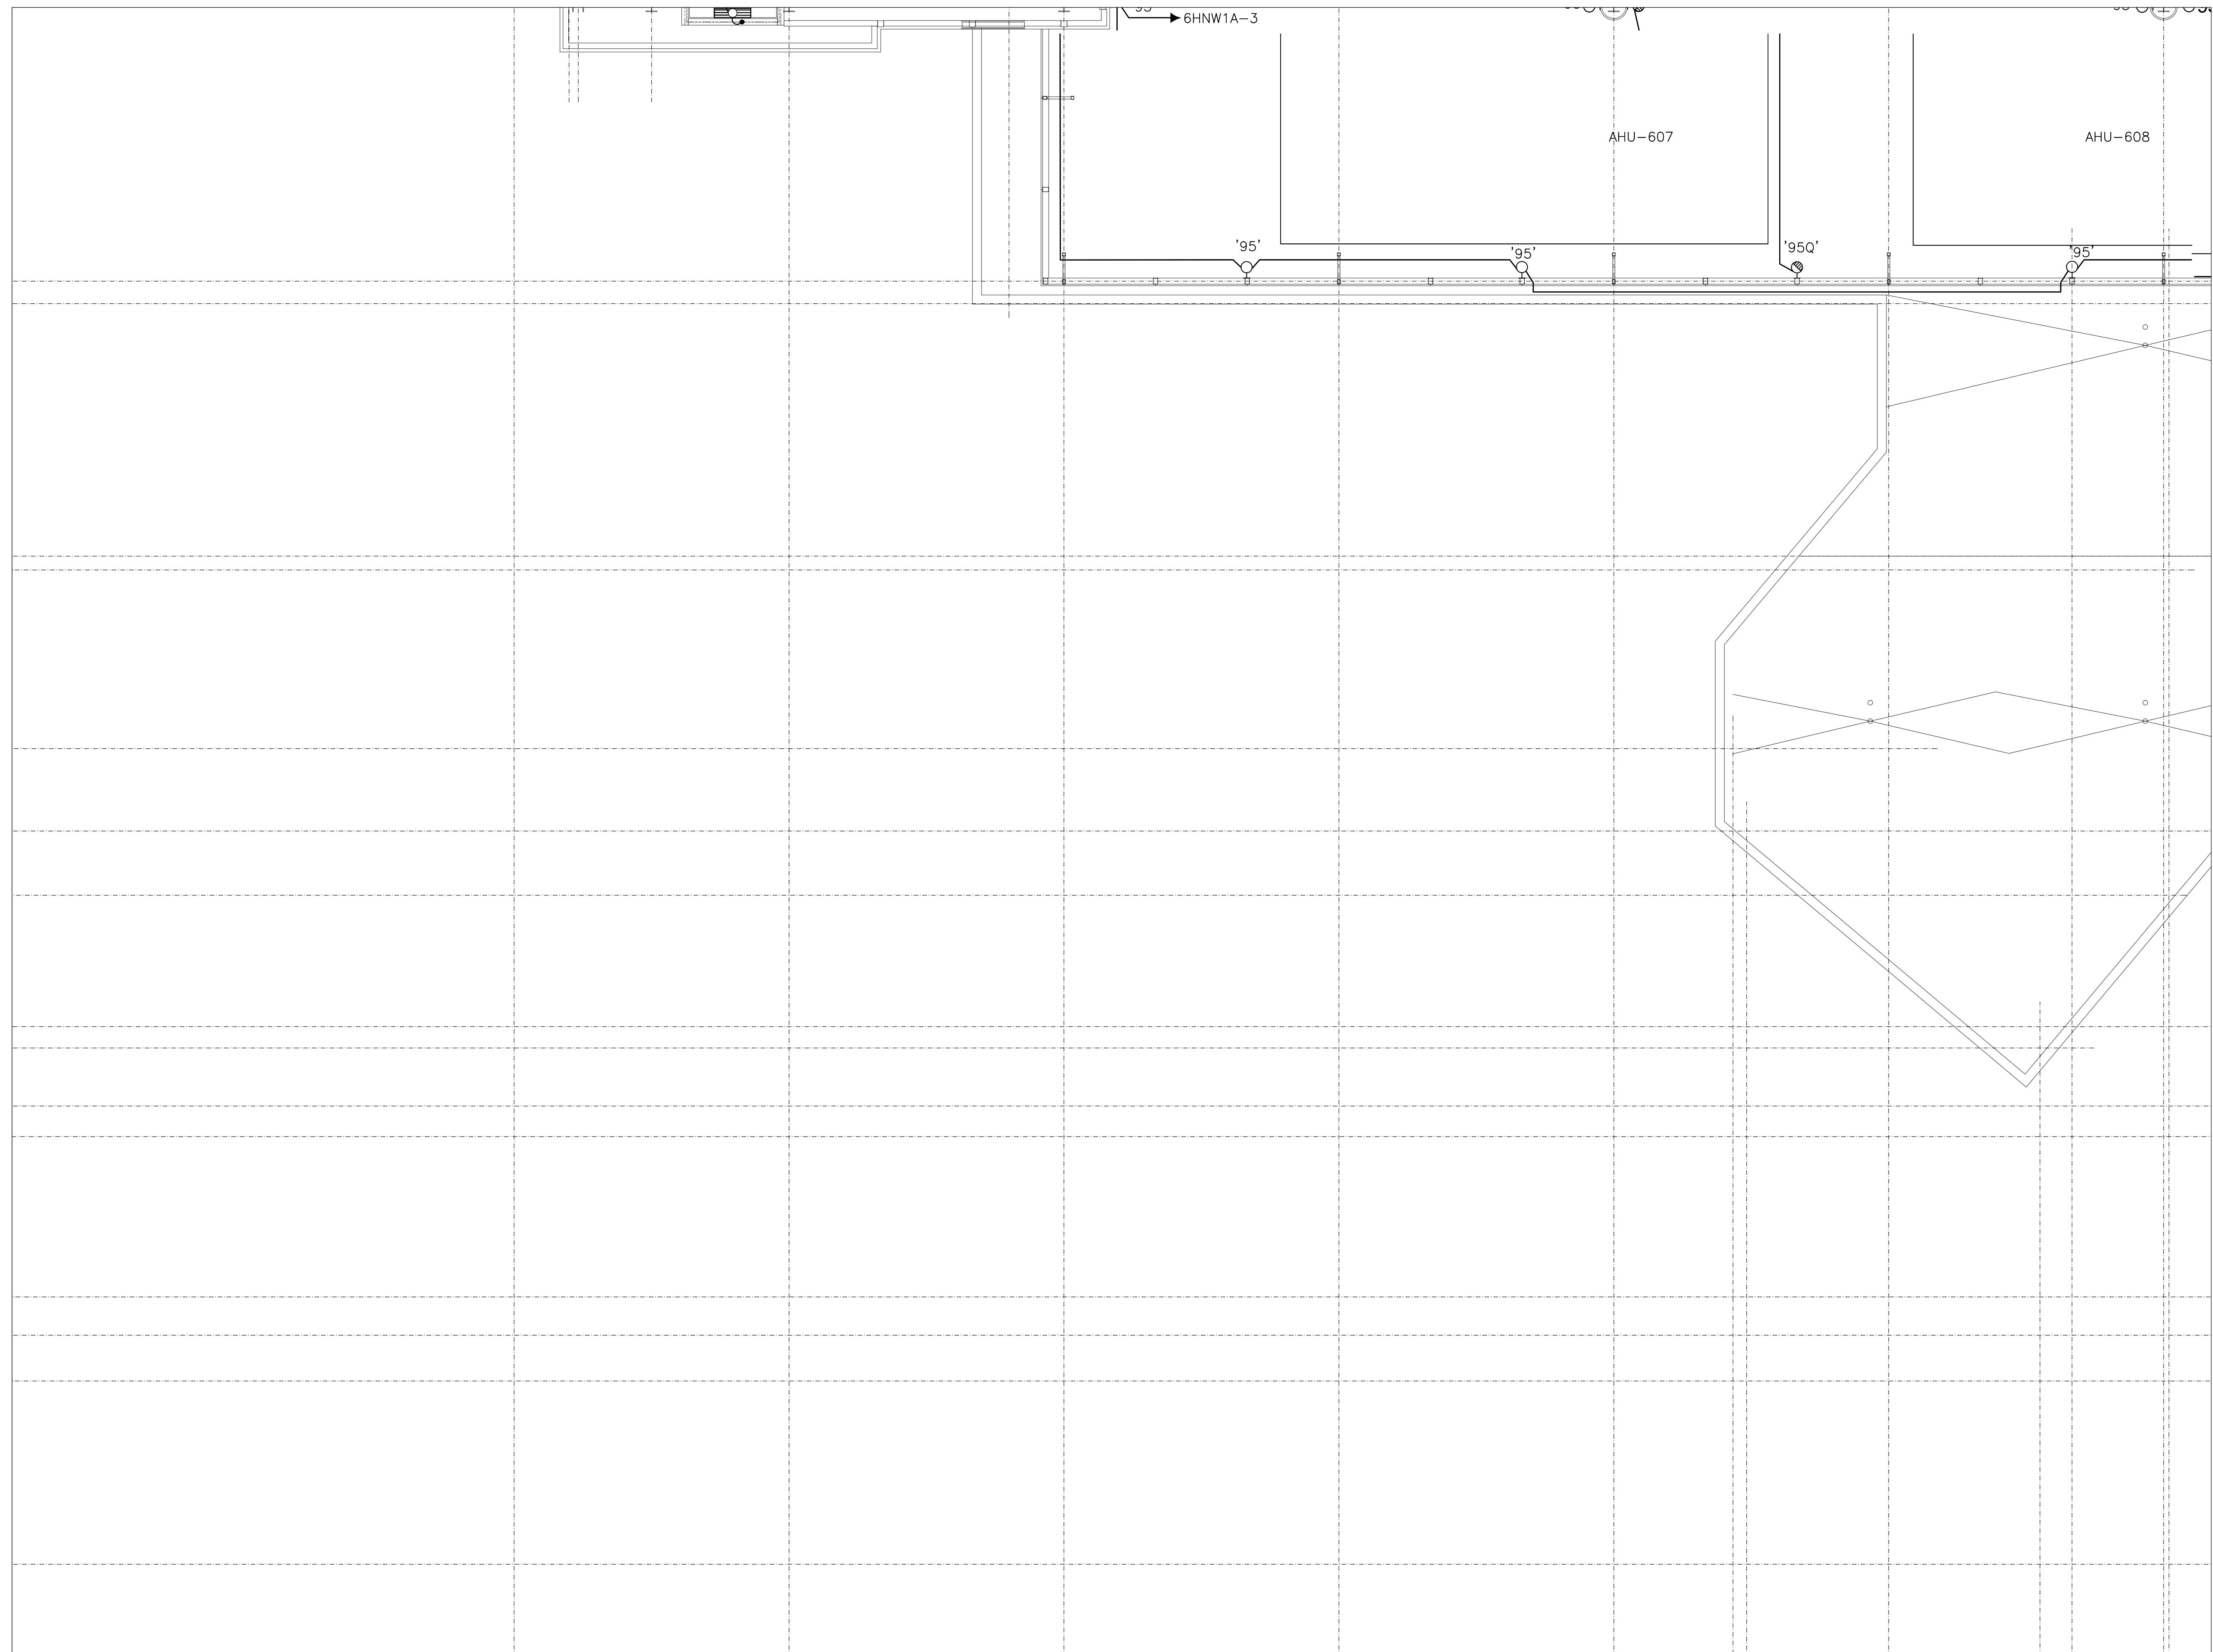

FILE PATH FOR CAD DEPARTMENT USE ONLY: C:\Users\Conti\Desktop\Projects\MusicCity\Zone 16\Zone 16 Lighting Symbols For Open.rvt

DEMONBREUN

| | | | | |
|----|----|----|----|----|
| 01 | 02 | 03 | 04 | 05 |
| 06 | 07 | 08 | 09 | 10 |
| 11 | 12 | 13 | 14 | 15 |
| 16 | 17 | 18 | 19 | 20 |


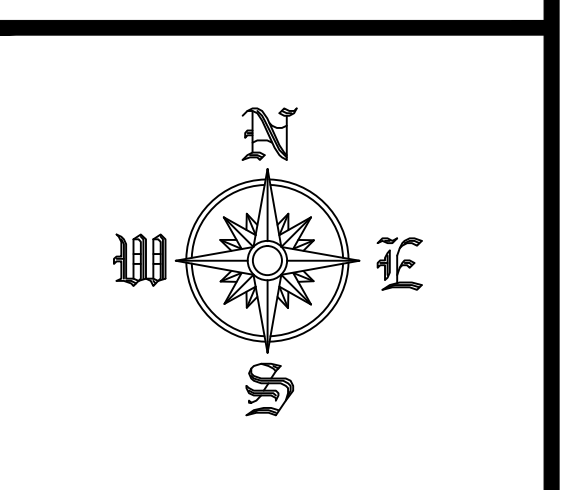
KOREAN VETERANS BLVD

KEY PLAN
NO SCALE

COORDINATION SIGN-OFF

| | | |
|---------|-------|------|
| COMPANY | TRADE | DATE |
| CONTI | ELEC. | / / |
| | | / / |
| | | / / |
Music City Center
Nashville, Tennessee

REVISIONS


| NO. | DATE | DESCRIPTION |
|-----|------|-------------|
| | | |
| | | |
RECORD DRAWINGS STAMP

CONTI ELECTRIC DATE (Last Update): 2/21/2012 9:25 AM
 DRAWING FILE NAME: EL2-617
 CAD OPERATOR: GREGG
 PRINTED BY: GREGG
 PLOT DATE: 2/21/2012 10:40 AM
 SUBMITTED BY: GREGG
 ASSIGNED TO:

LEVEL 6 LIGHTING
 ZONE 17
 SCALE: 1/8" = 1'-0"

EL2-617

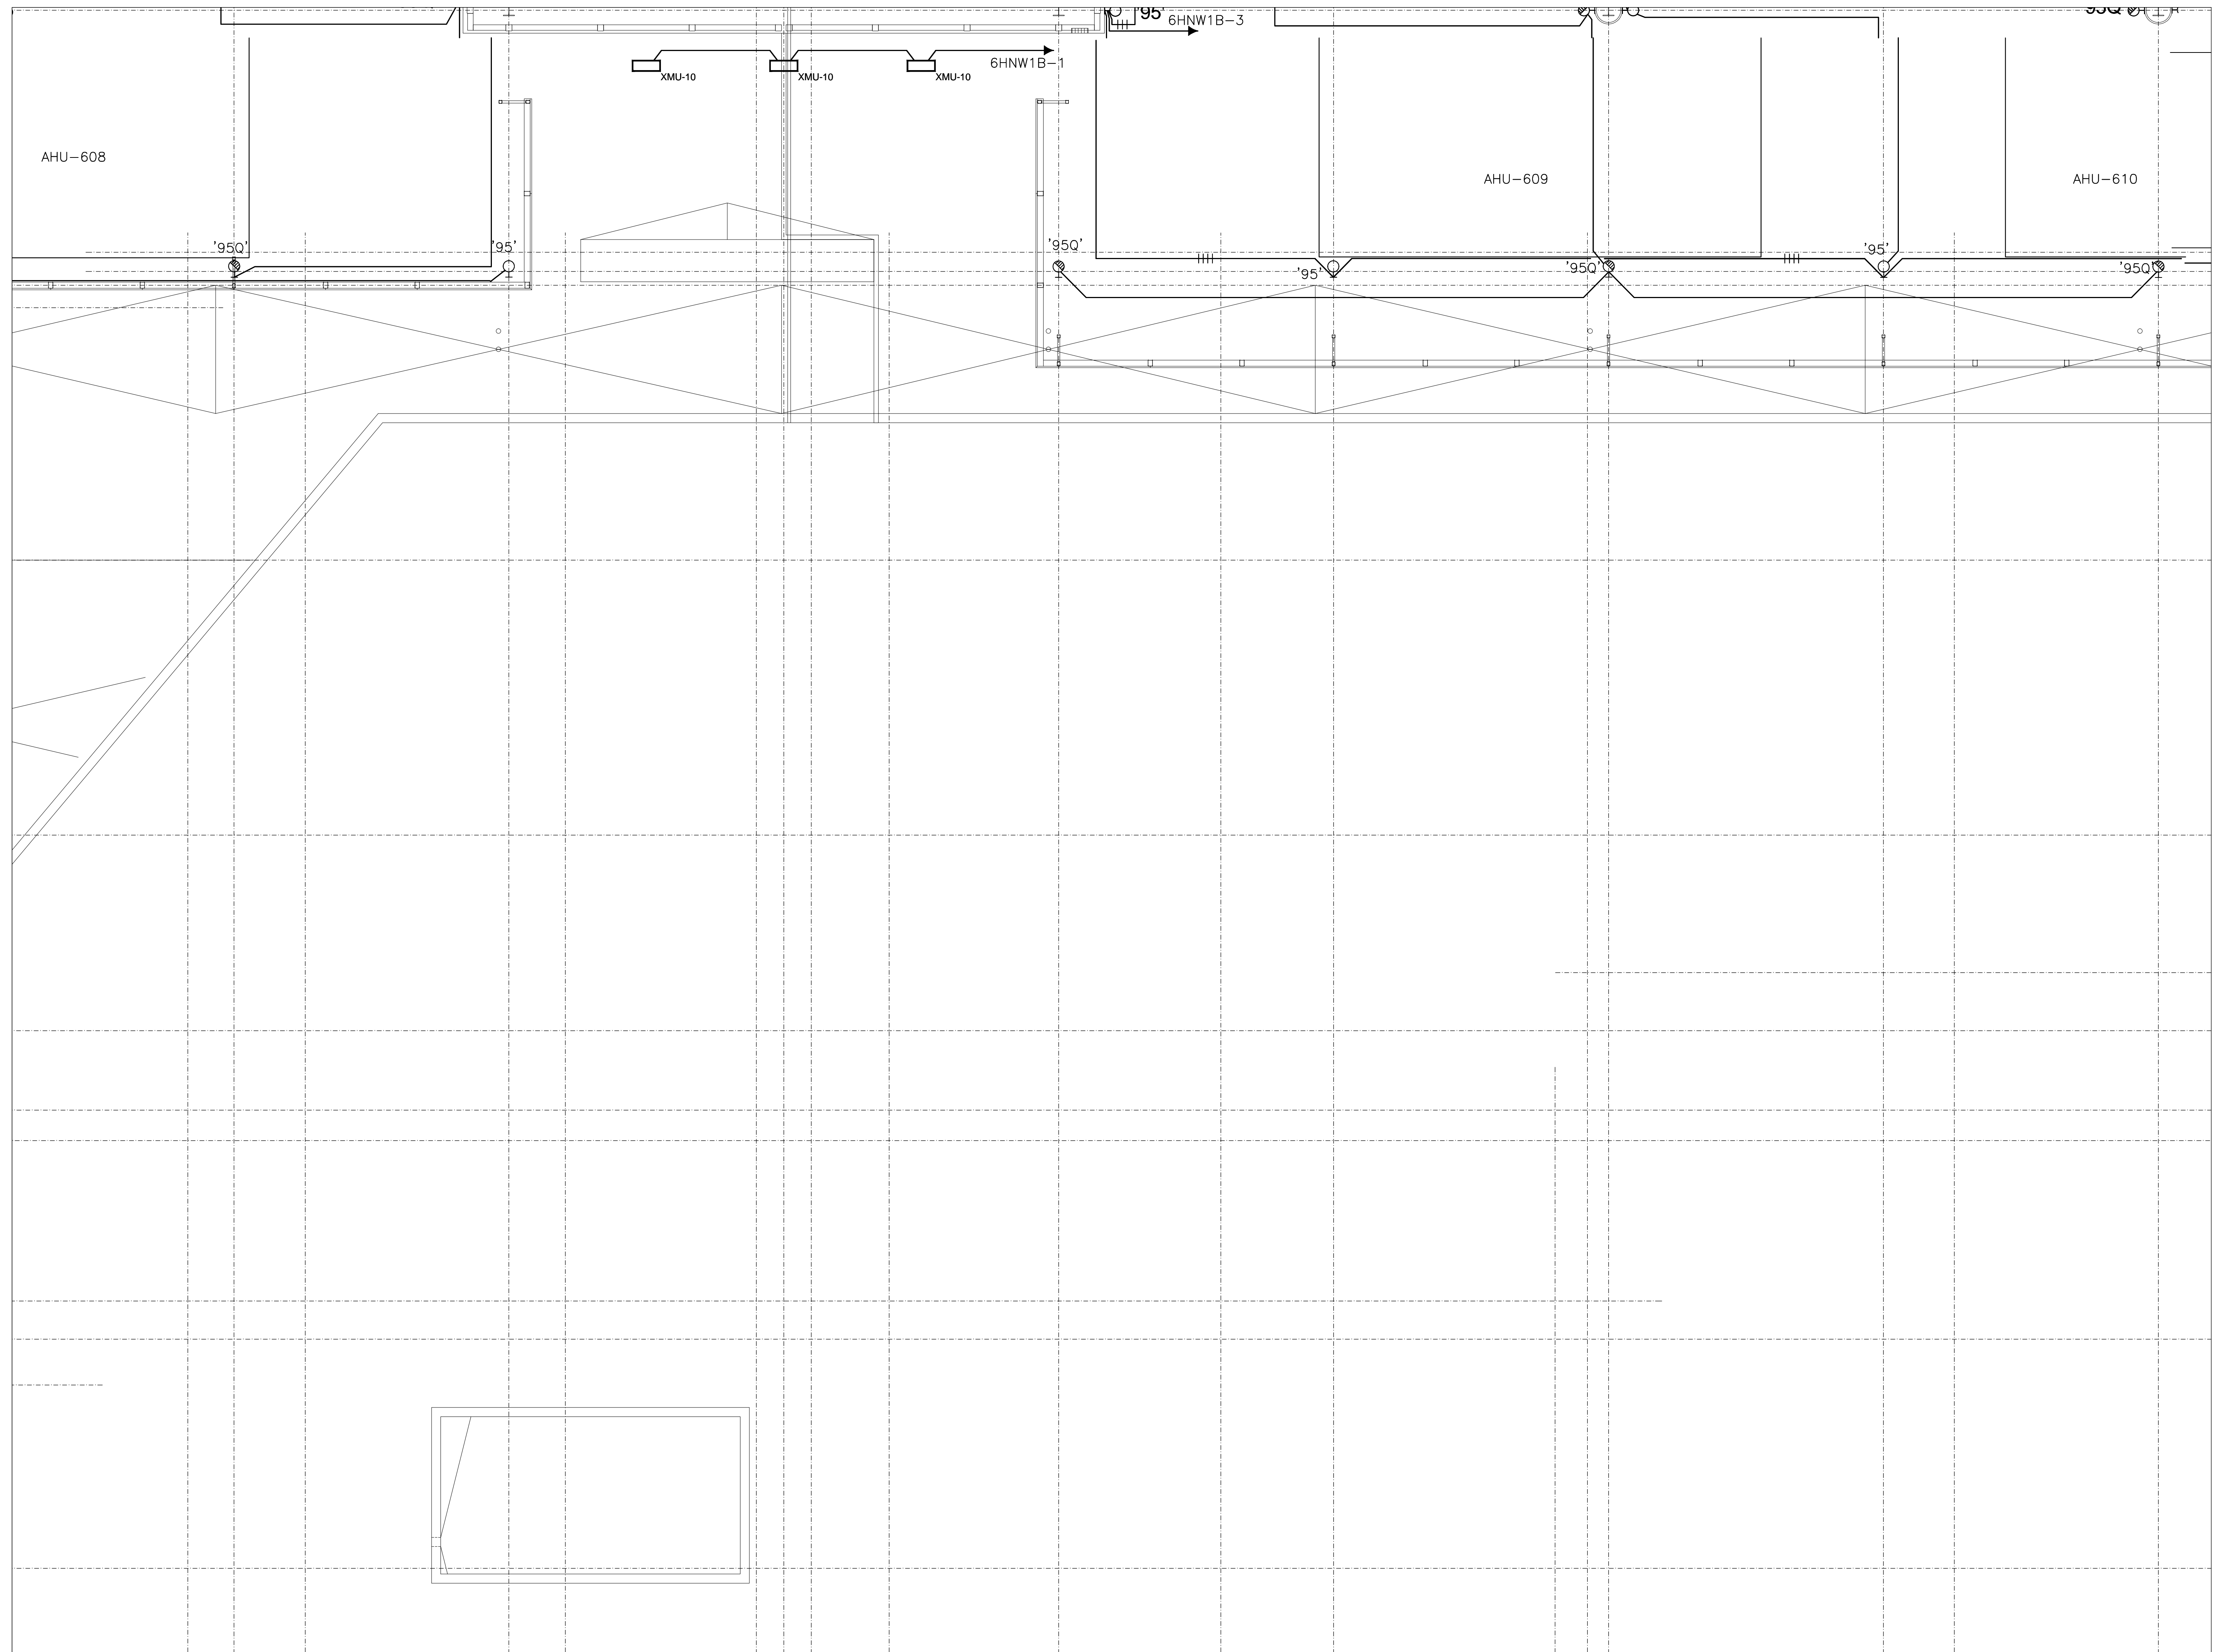


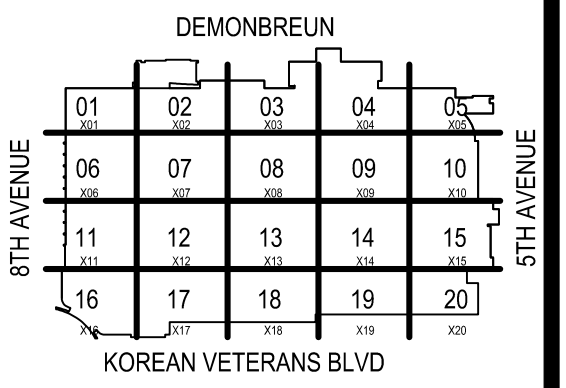

KEY PLAN
NO SCALE

| COORDINATION SIGN-OFF | | DATE | DATE | DATE | DATE | DATE |
|-----------------------|-------|------|------|------|------|------|
| COMPANY | TRADE | NAME | | | | |
| CONTI | ELEC. | | | | | |

Music City Center
Nashville, Tennessee

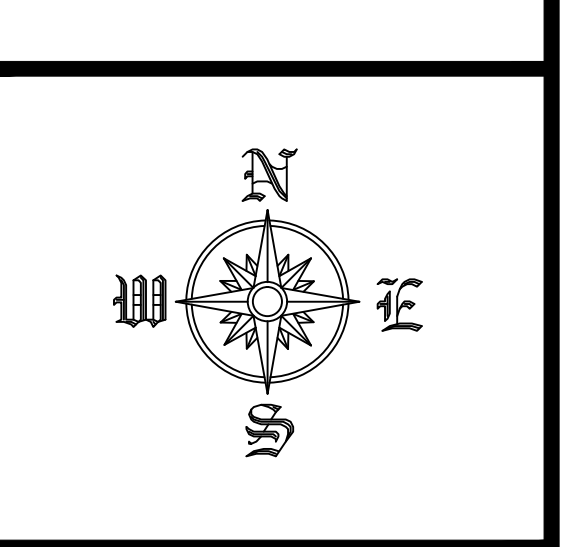

REVISIONS


| NO. | DATE | DESCRIPTION |
|-----|------|-------------|
| | | |
| | | |
RECORD DRAWINGS STAMP

CONTI ELECTRIC DATE (Last Update): 2/21/2012 10:40 AM
 DRAWING FILE NAME: EL2-618
 CAD OPERATOR: GREGG
 PRINTED BY: GREGG
 PLOT DATE: 2/21/2012 10:40 AM
 SUBMITTED BY: GREGG
 ASSIGNED TO:

LEVEL 6 LIGHTING
 ZONE 18
 SCALE: 1/8" = 1'-0"

EL2-618

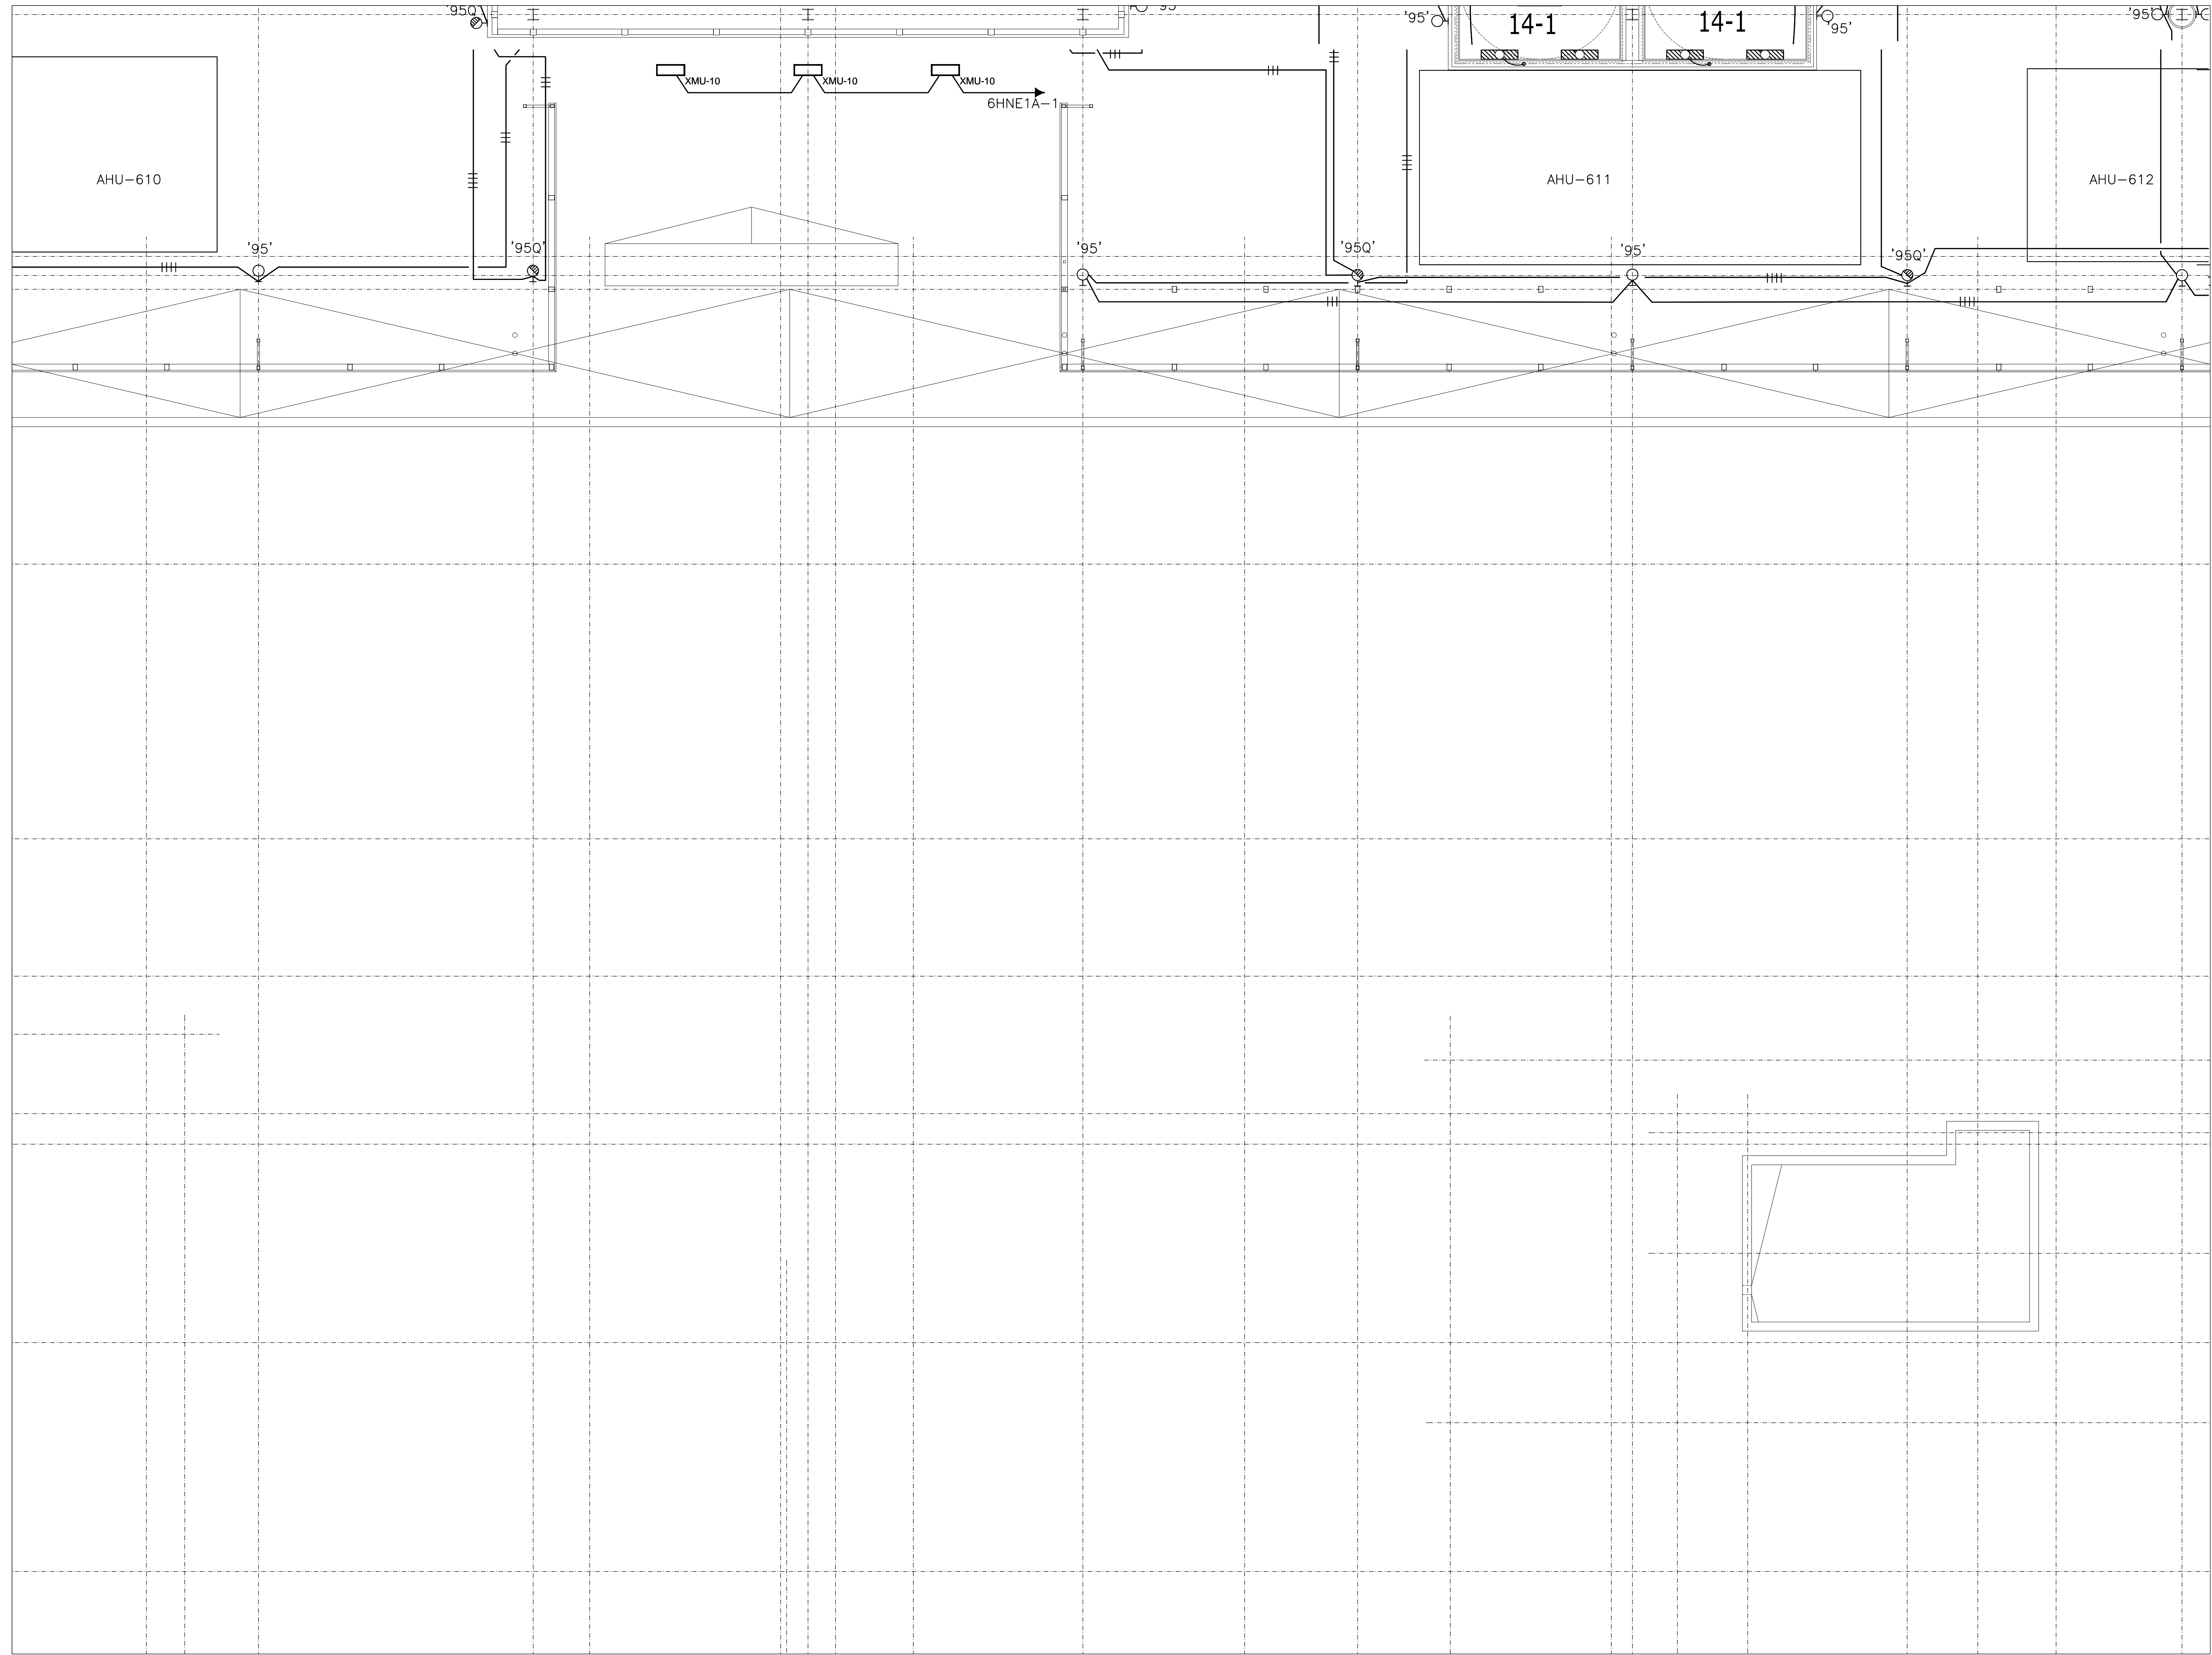


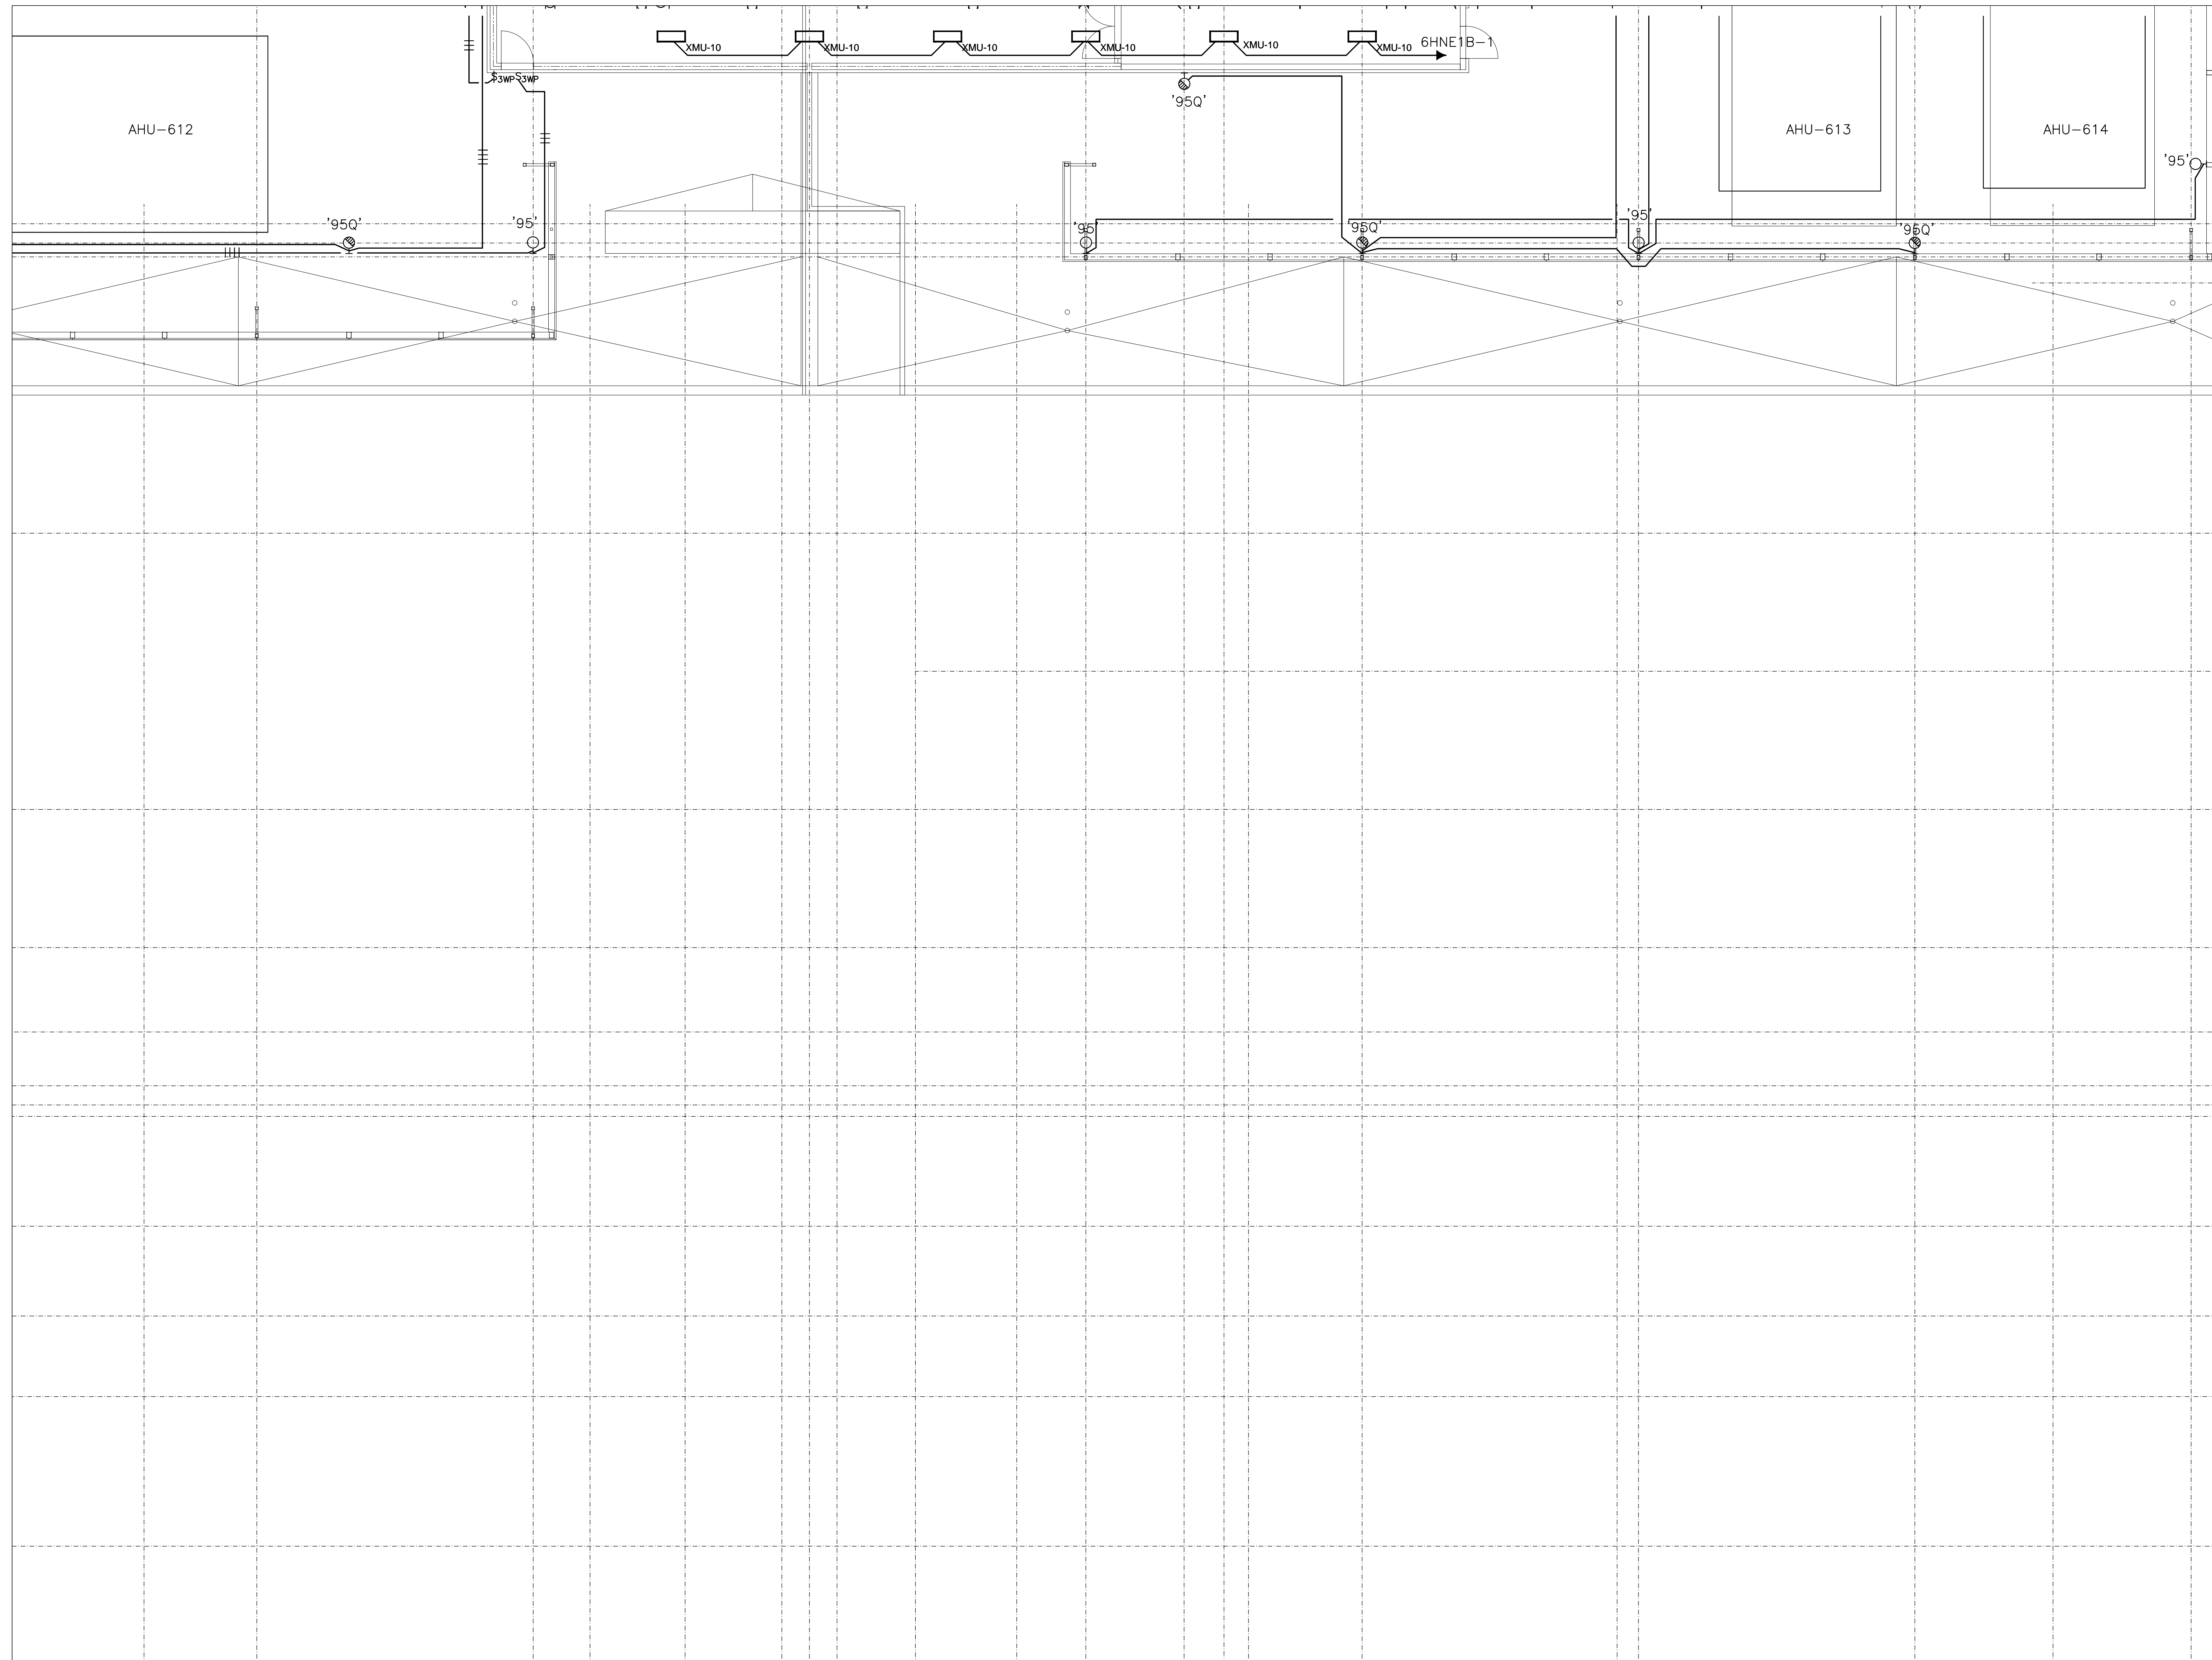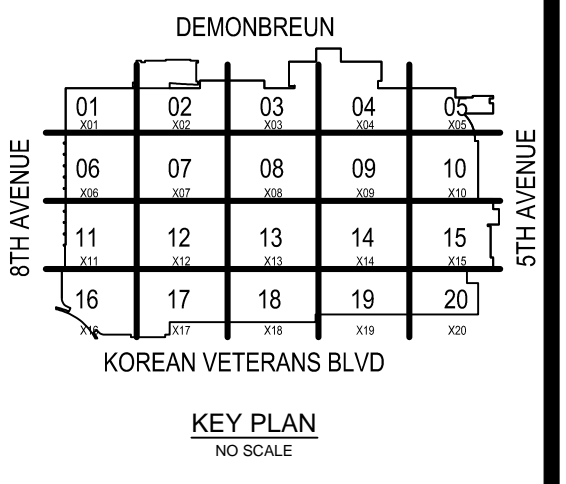

COORDINATION SIGN-OFF

| COMPANY | TRADE | DATE |
|---------|-------|------|
| CONTI | ELEC. | / / |
| | | / / |
| | | / / |
Music City Center
Nashville, Tennessee

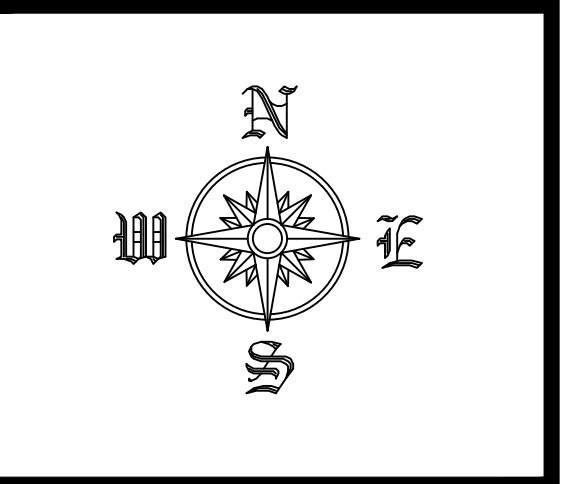

REVISIONS

| NO. | DATE | DESCRIPTION |
|-----|------|-------------|
| | | |
| | | |
RECORD DRAWINGS STAMP

CONTI ELECTRIC DATE (Last Update): 2/21/2012 9:25 AM
 DRAWING FILE NAME: EL2-619
 CAD OPERATOR: GERTMAN
 PRINTED BY: FREDMAN, GREG
 PLOT DATE: 2/21/2012 10:40 AM
 SUBMITTED BY: G.L.P.
 ASSIGNED TO:

LEVEL 6 LIGHTING
 ZONE 19
 SCALE: 1/8" = 1'-0"

EL2-619