


COORDINATION SIGN-OFF

COMPANY	TRADE	DATE
CONTI	ELEC.	/ /
		/ /
		/ /
Music City Center
 Nashville, Tennessee

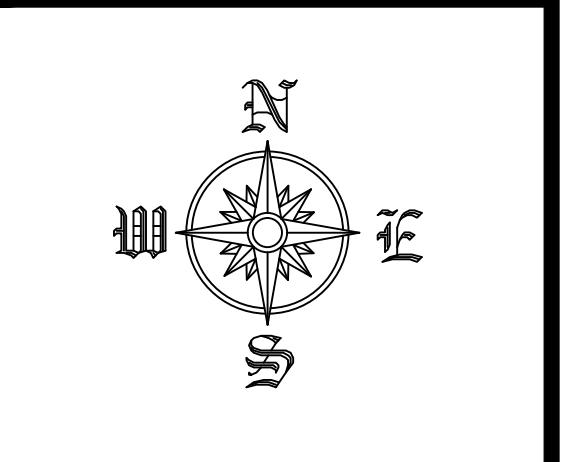

REVISIONS


NO.	DATE	DESCRIPTION

RECORD DRAWINGS STAMP


CONTI ELECTRIC DATE (Last Update): 2/24/2015 10:59 AM
 DRAWING FILE NAME: E2-701
 CAD OPERATOR: GREGG
 PRINTED BY: GREGG
 PLOT DATE: 6/4/2015 8:11 AM
 SUBMITTED BY: GREGG
 ASSIGNED TO:

LEVEL 7 LIGHTING
 ZONE 01
 SCALE: 1/8" = 1'-0"

EL2-701

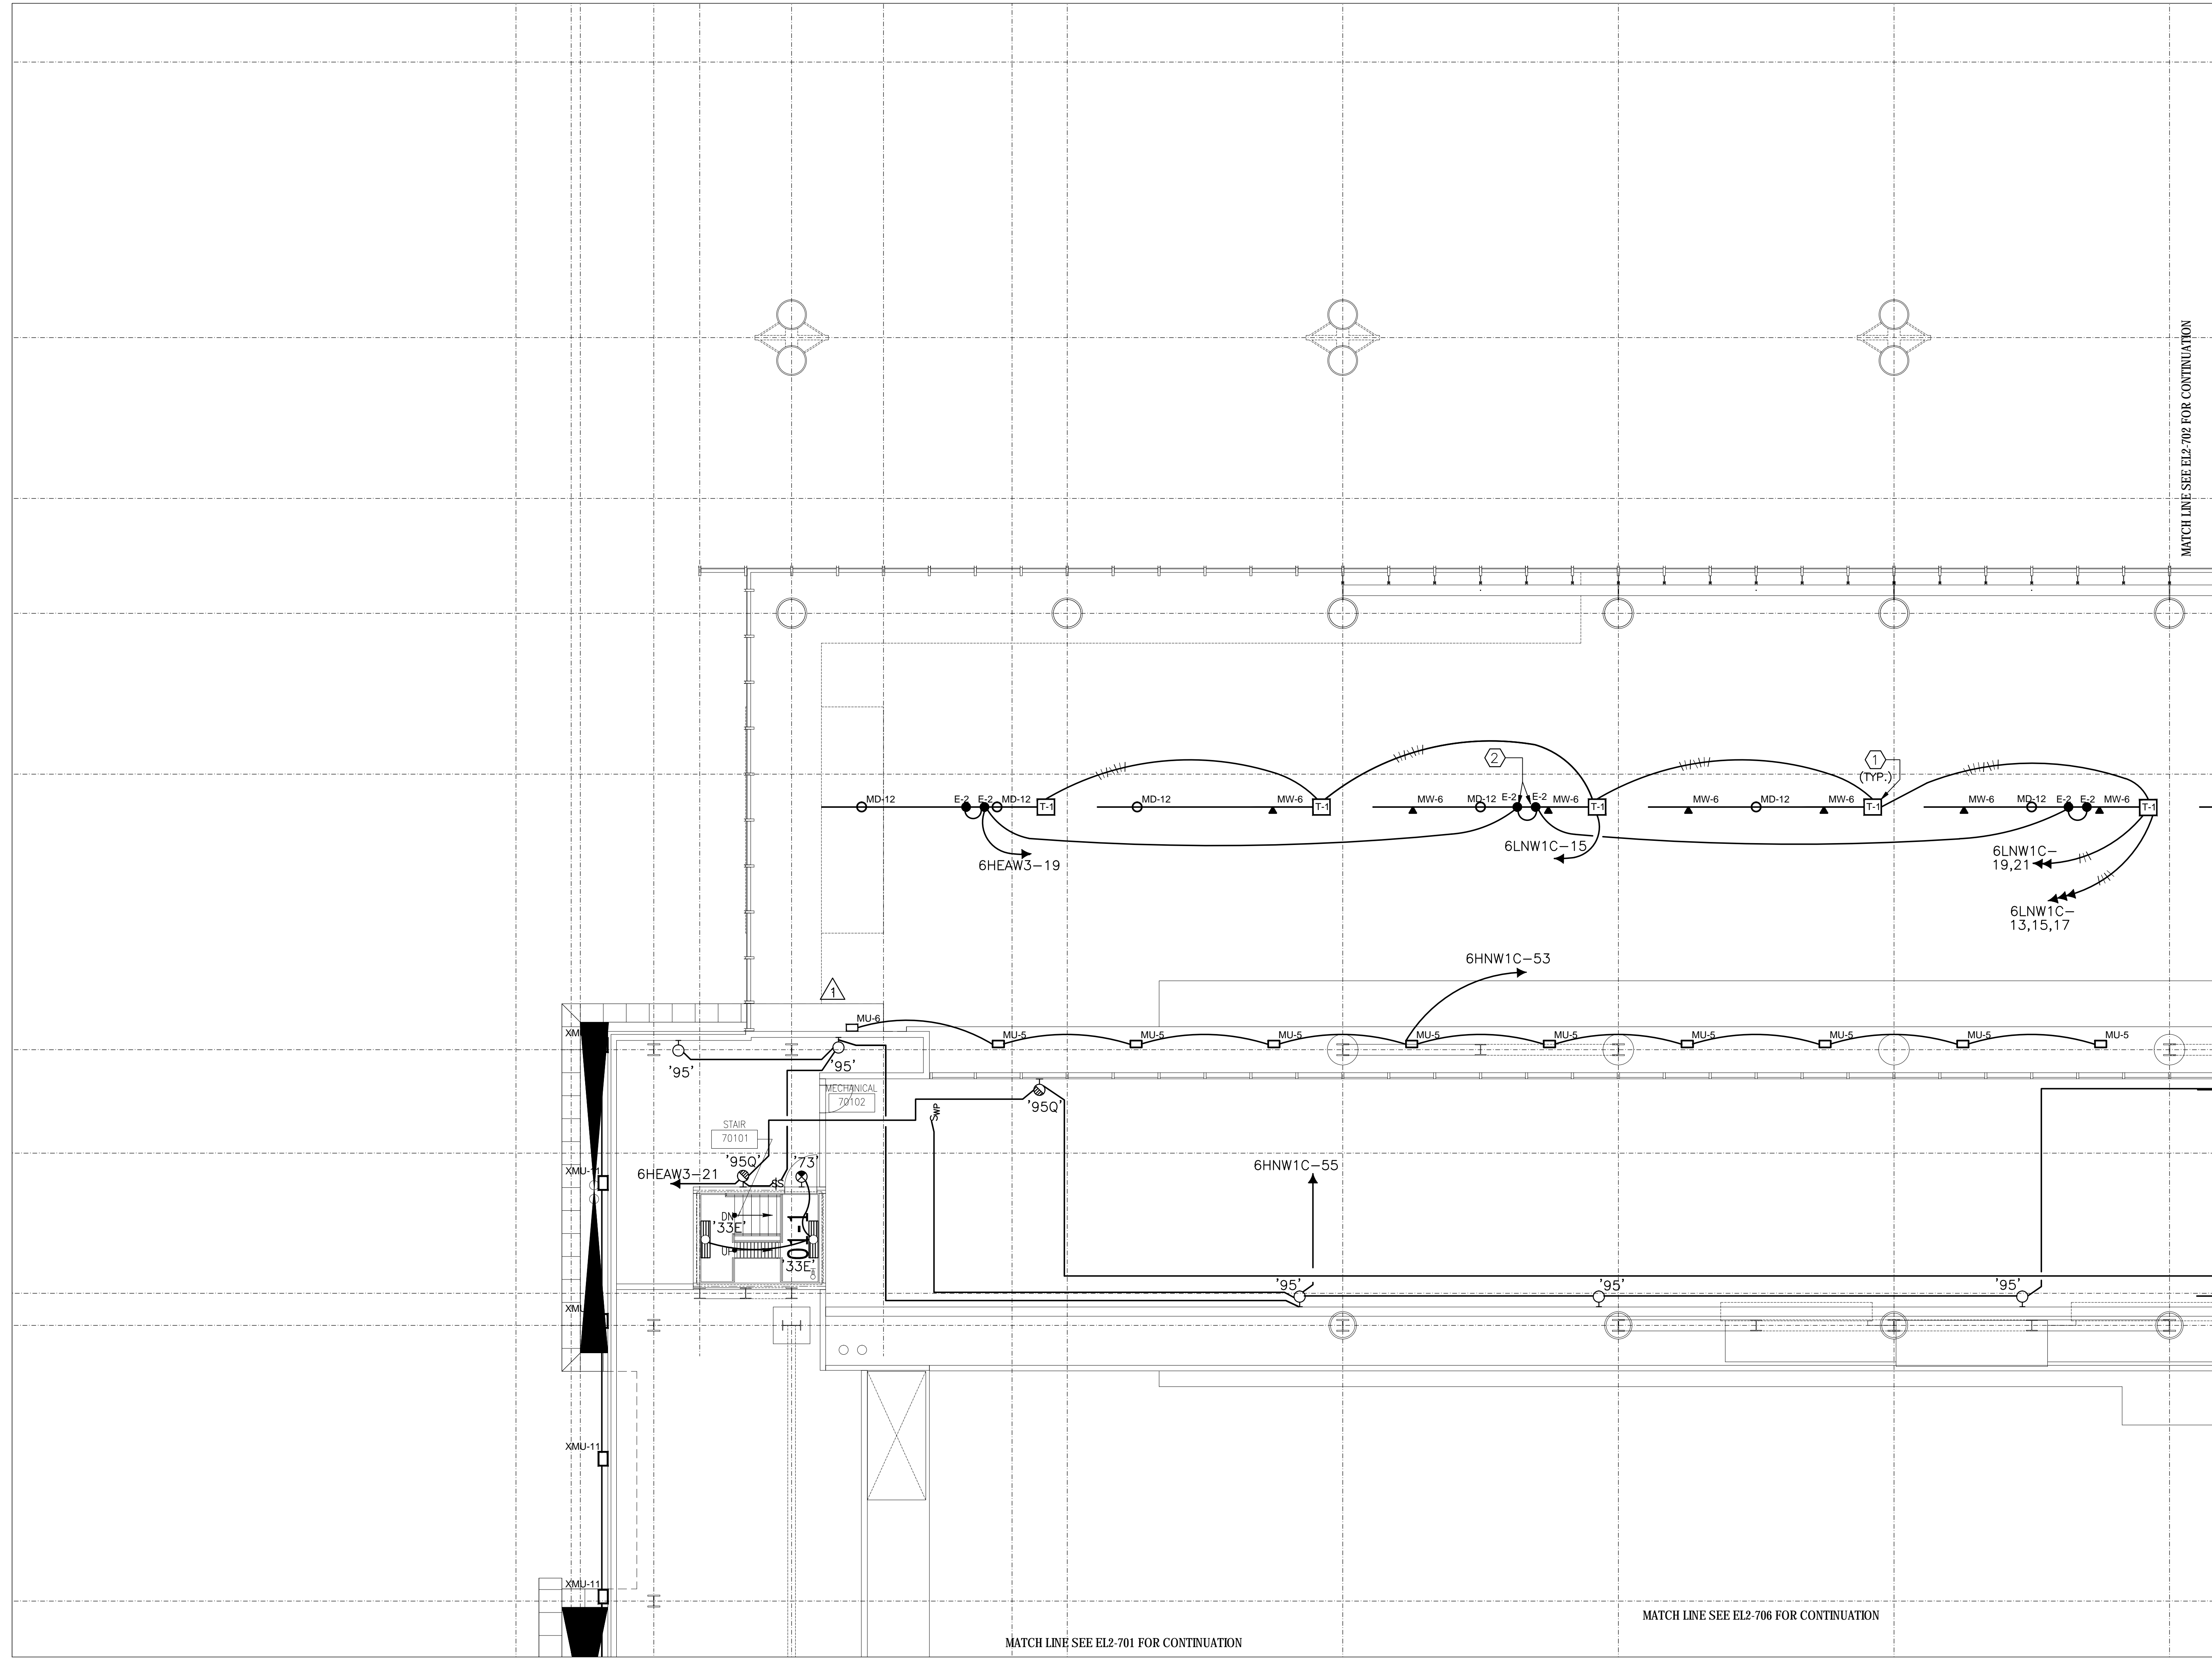


FILE PATH FOR CAD DEPARTMENT USE ONLY: P:\3085\Conti Electric\Projects\MCC\Level 07 Level 7 Lighting\Zone 01 For Opening.dwg

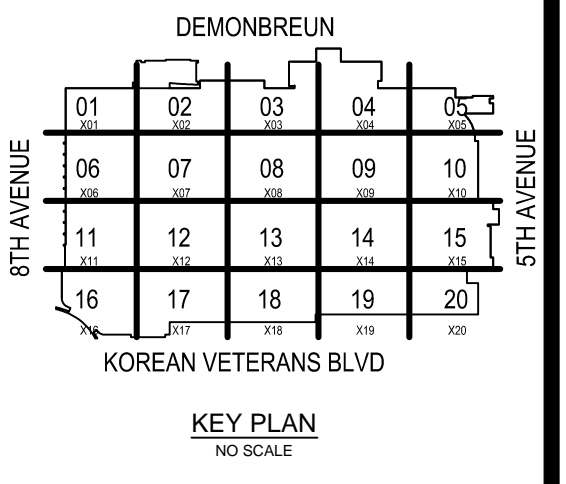

COORDINATION SIGN-OFF

COMPANY	TRADE	DATE
CONTI	ELEC.	/ /
		/ /
		/ /
Music City Center
 Nashville, Tennessee

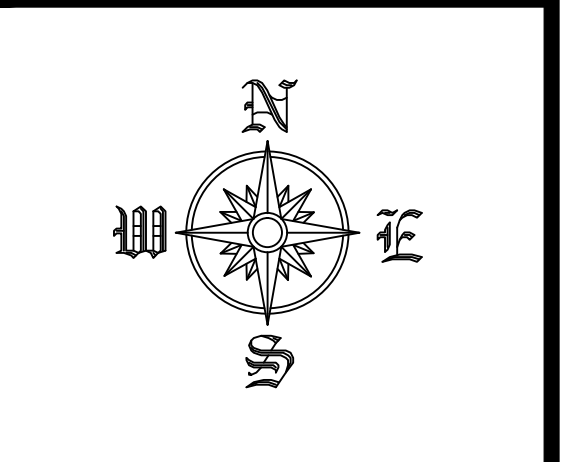

REVISIONS

NO.	DATE	DESCRIPTION

RECORD DRAWINGS STAMP

CONTI ELECTRIC DATE (Last Update):
 2/24/2015 10:59 AM

DRAWING FILE NAME:
 ES2-702

CAD OPERATOR:
 GREGGIAN

PRINTED BY:
 FREDMAN, GREGG


PLOT DATE:
 6/4/2012 8:11 AM

SUBMITTED BY:
 G.L.F.

ASSIGNED TO:


LEVEL 7 LIGHTING
 ZONE 02
 SCALE: 1/8" = 1'-0"

EL2-702

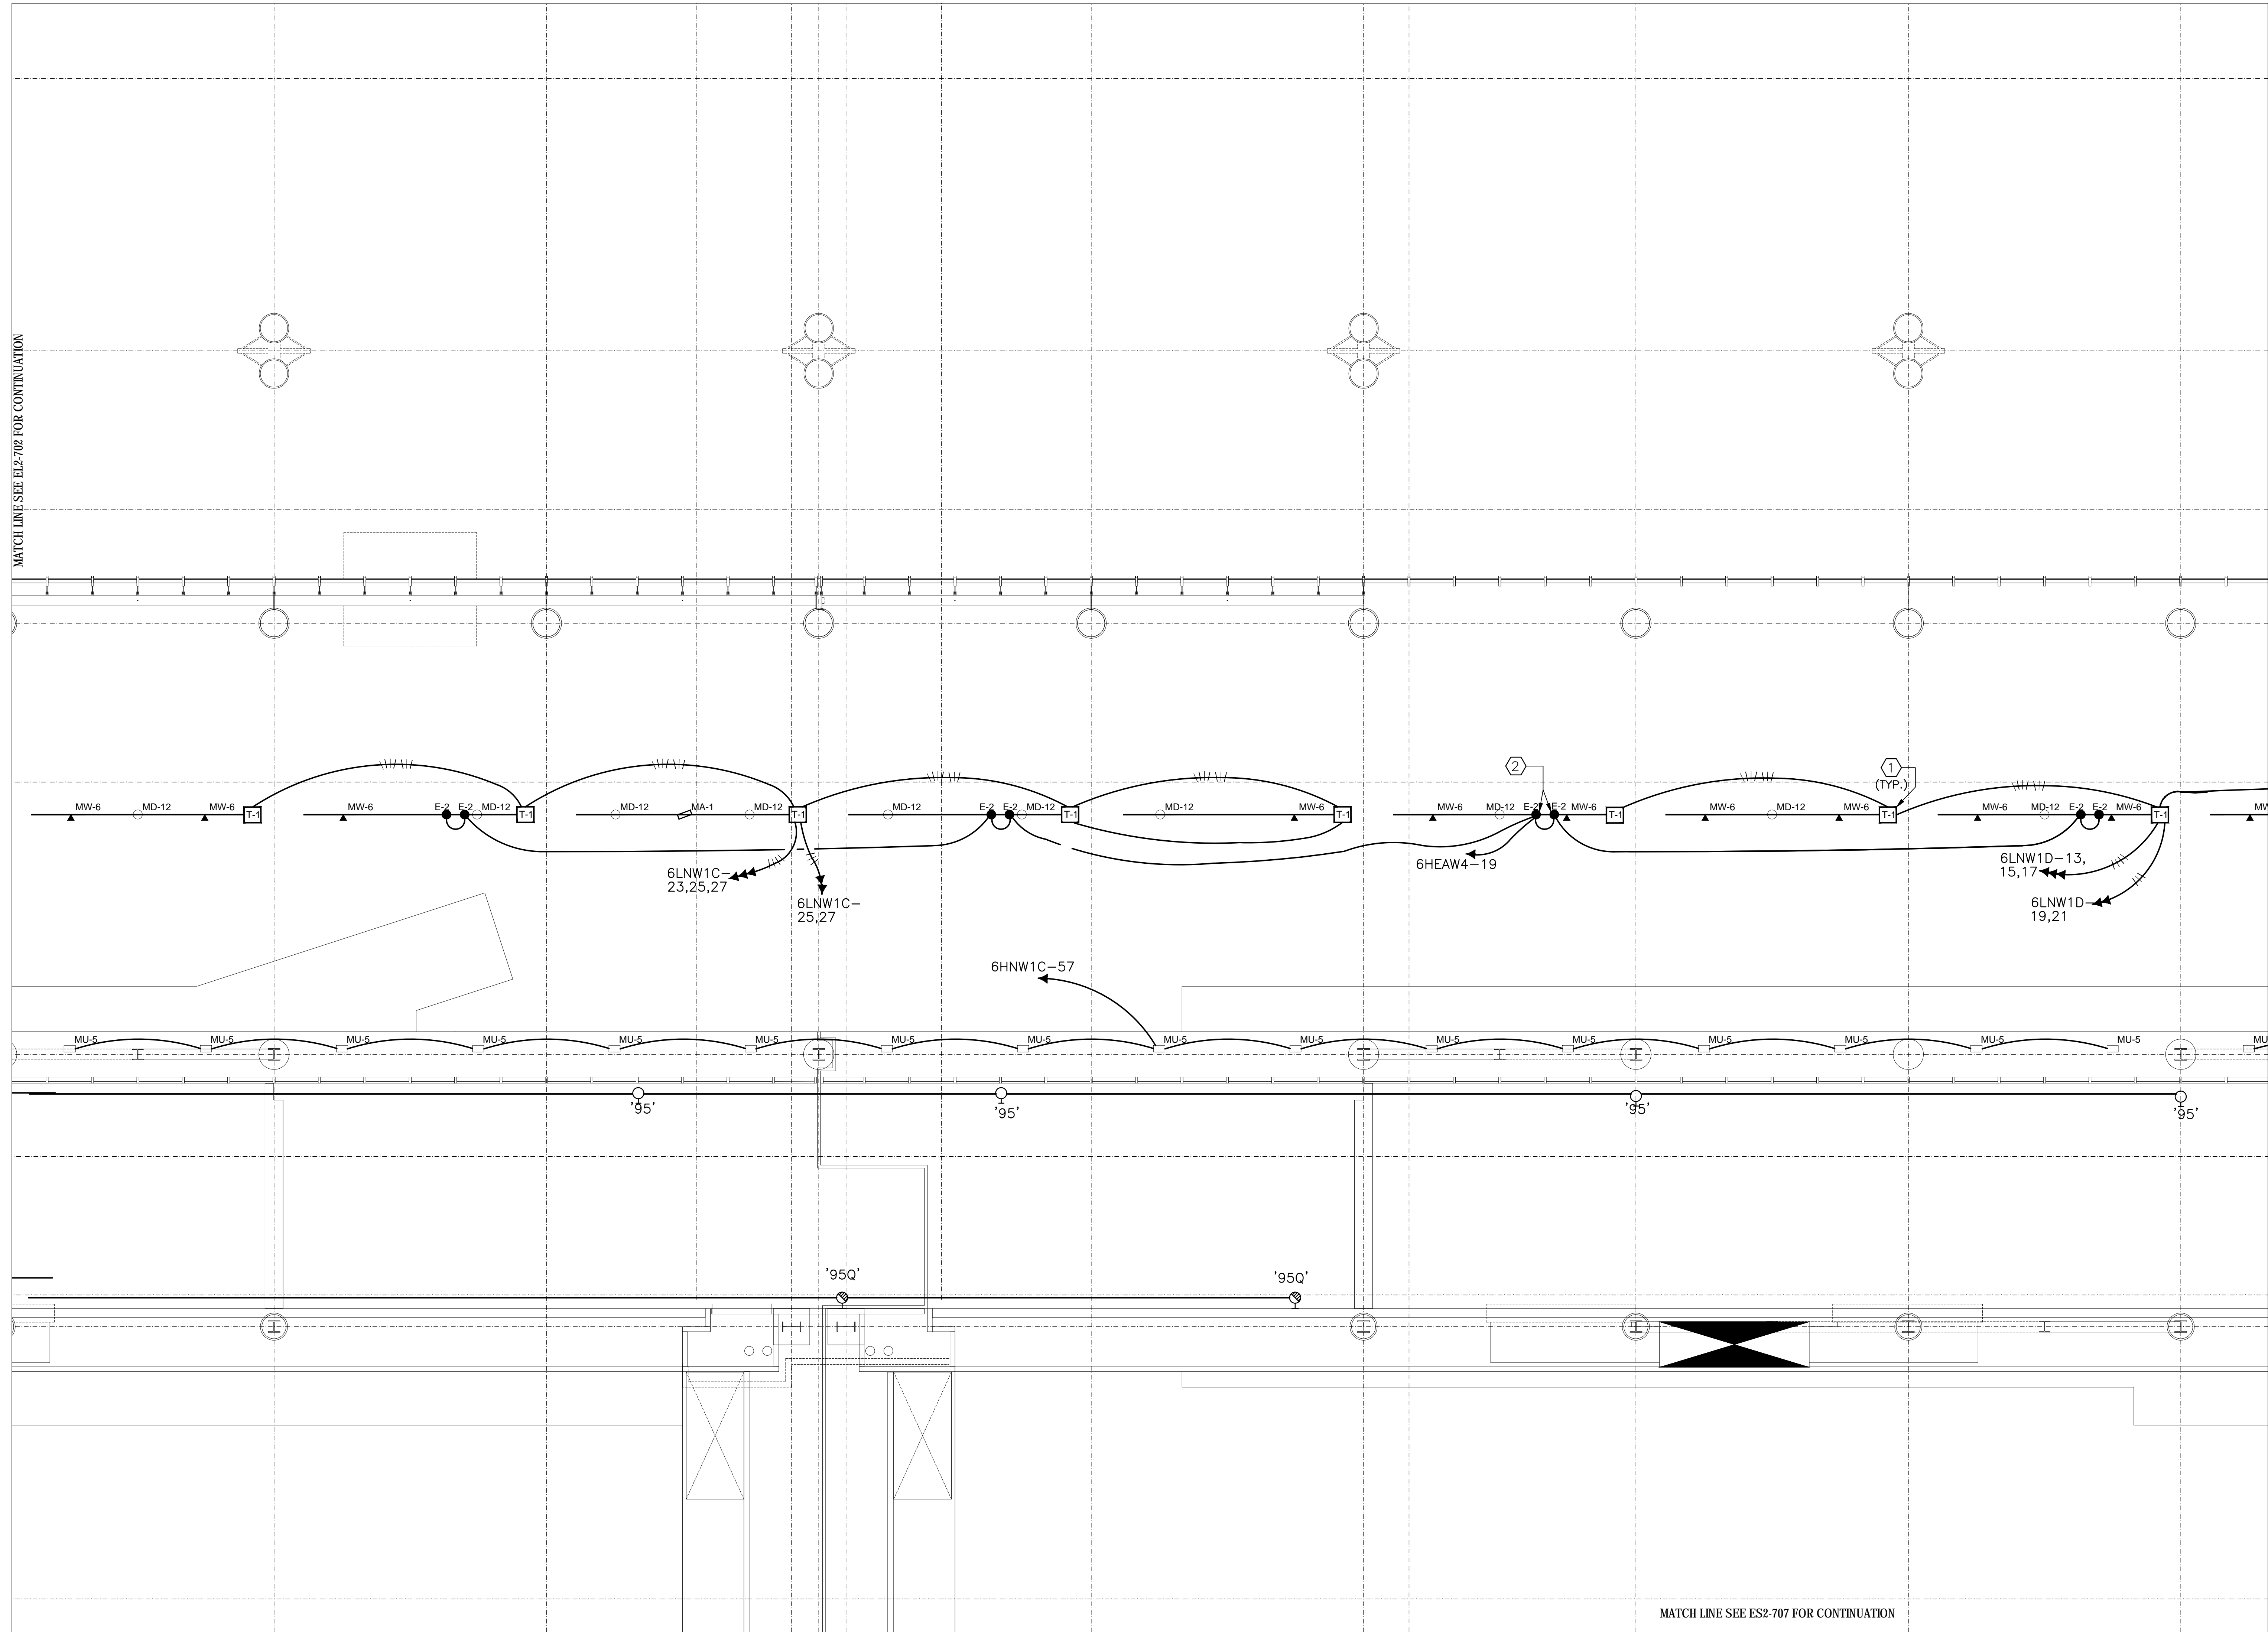

MATCH LINE SEE ES2-707 FOR CONTINUATION


MATCH LINE SEE ES2-707 FOR CONTINUATION

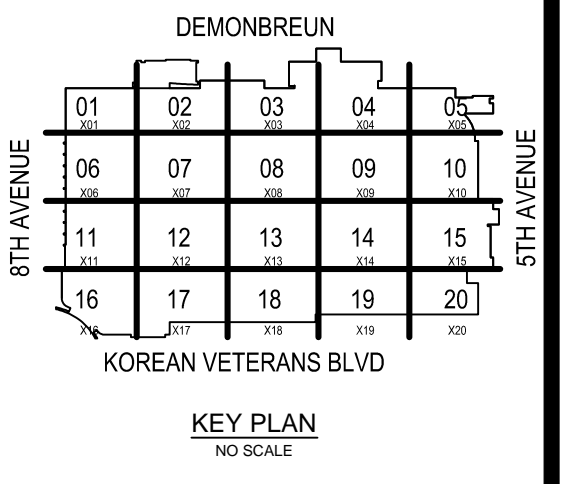

COORDINATION SIGN-OFF

COMPANY	TRADE	DATE
CONTI	ELEC.	/ /
		/ /
		/ /
Music City Center
 Nashville, Tennessee

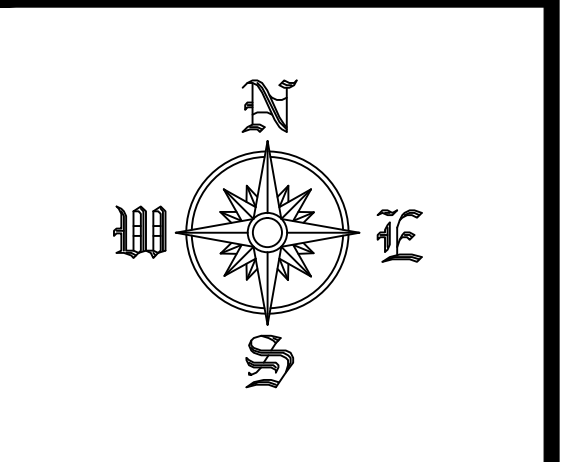

REVISIONS


NO.	DATE	DESCRIPTION

RECORD DRAWINGS STAMP


CONTELECTRIC DATE (Last Update):	2/24/2015 10:59 AM
DRAWING FILE NAME:	EL2-703
CAD OPERATOR:	GERMAN
PRINTED BY:	FREDMAN GREGG
PLOT DATE:	6/4/2015 8:11 AM
SUBMITTED BY:	ELF
ASSIGNED TO:	

LEVEL 7 LIGHTING
 ZONE 03
 SCALE: 1/8" = 1'-0"

EL2-703

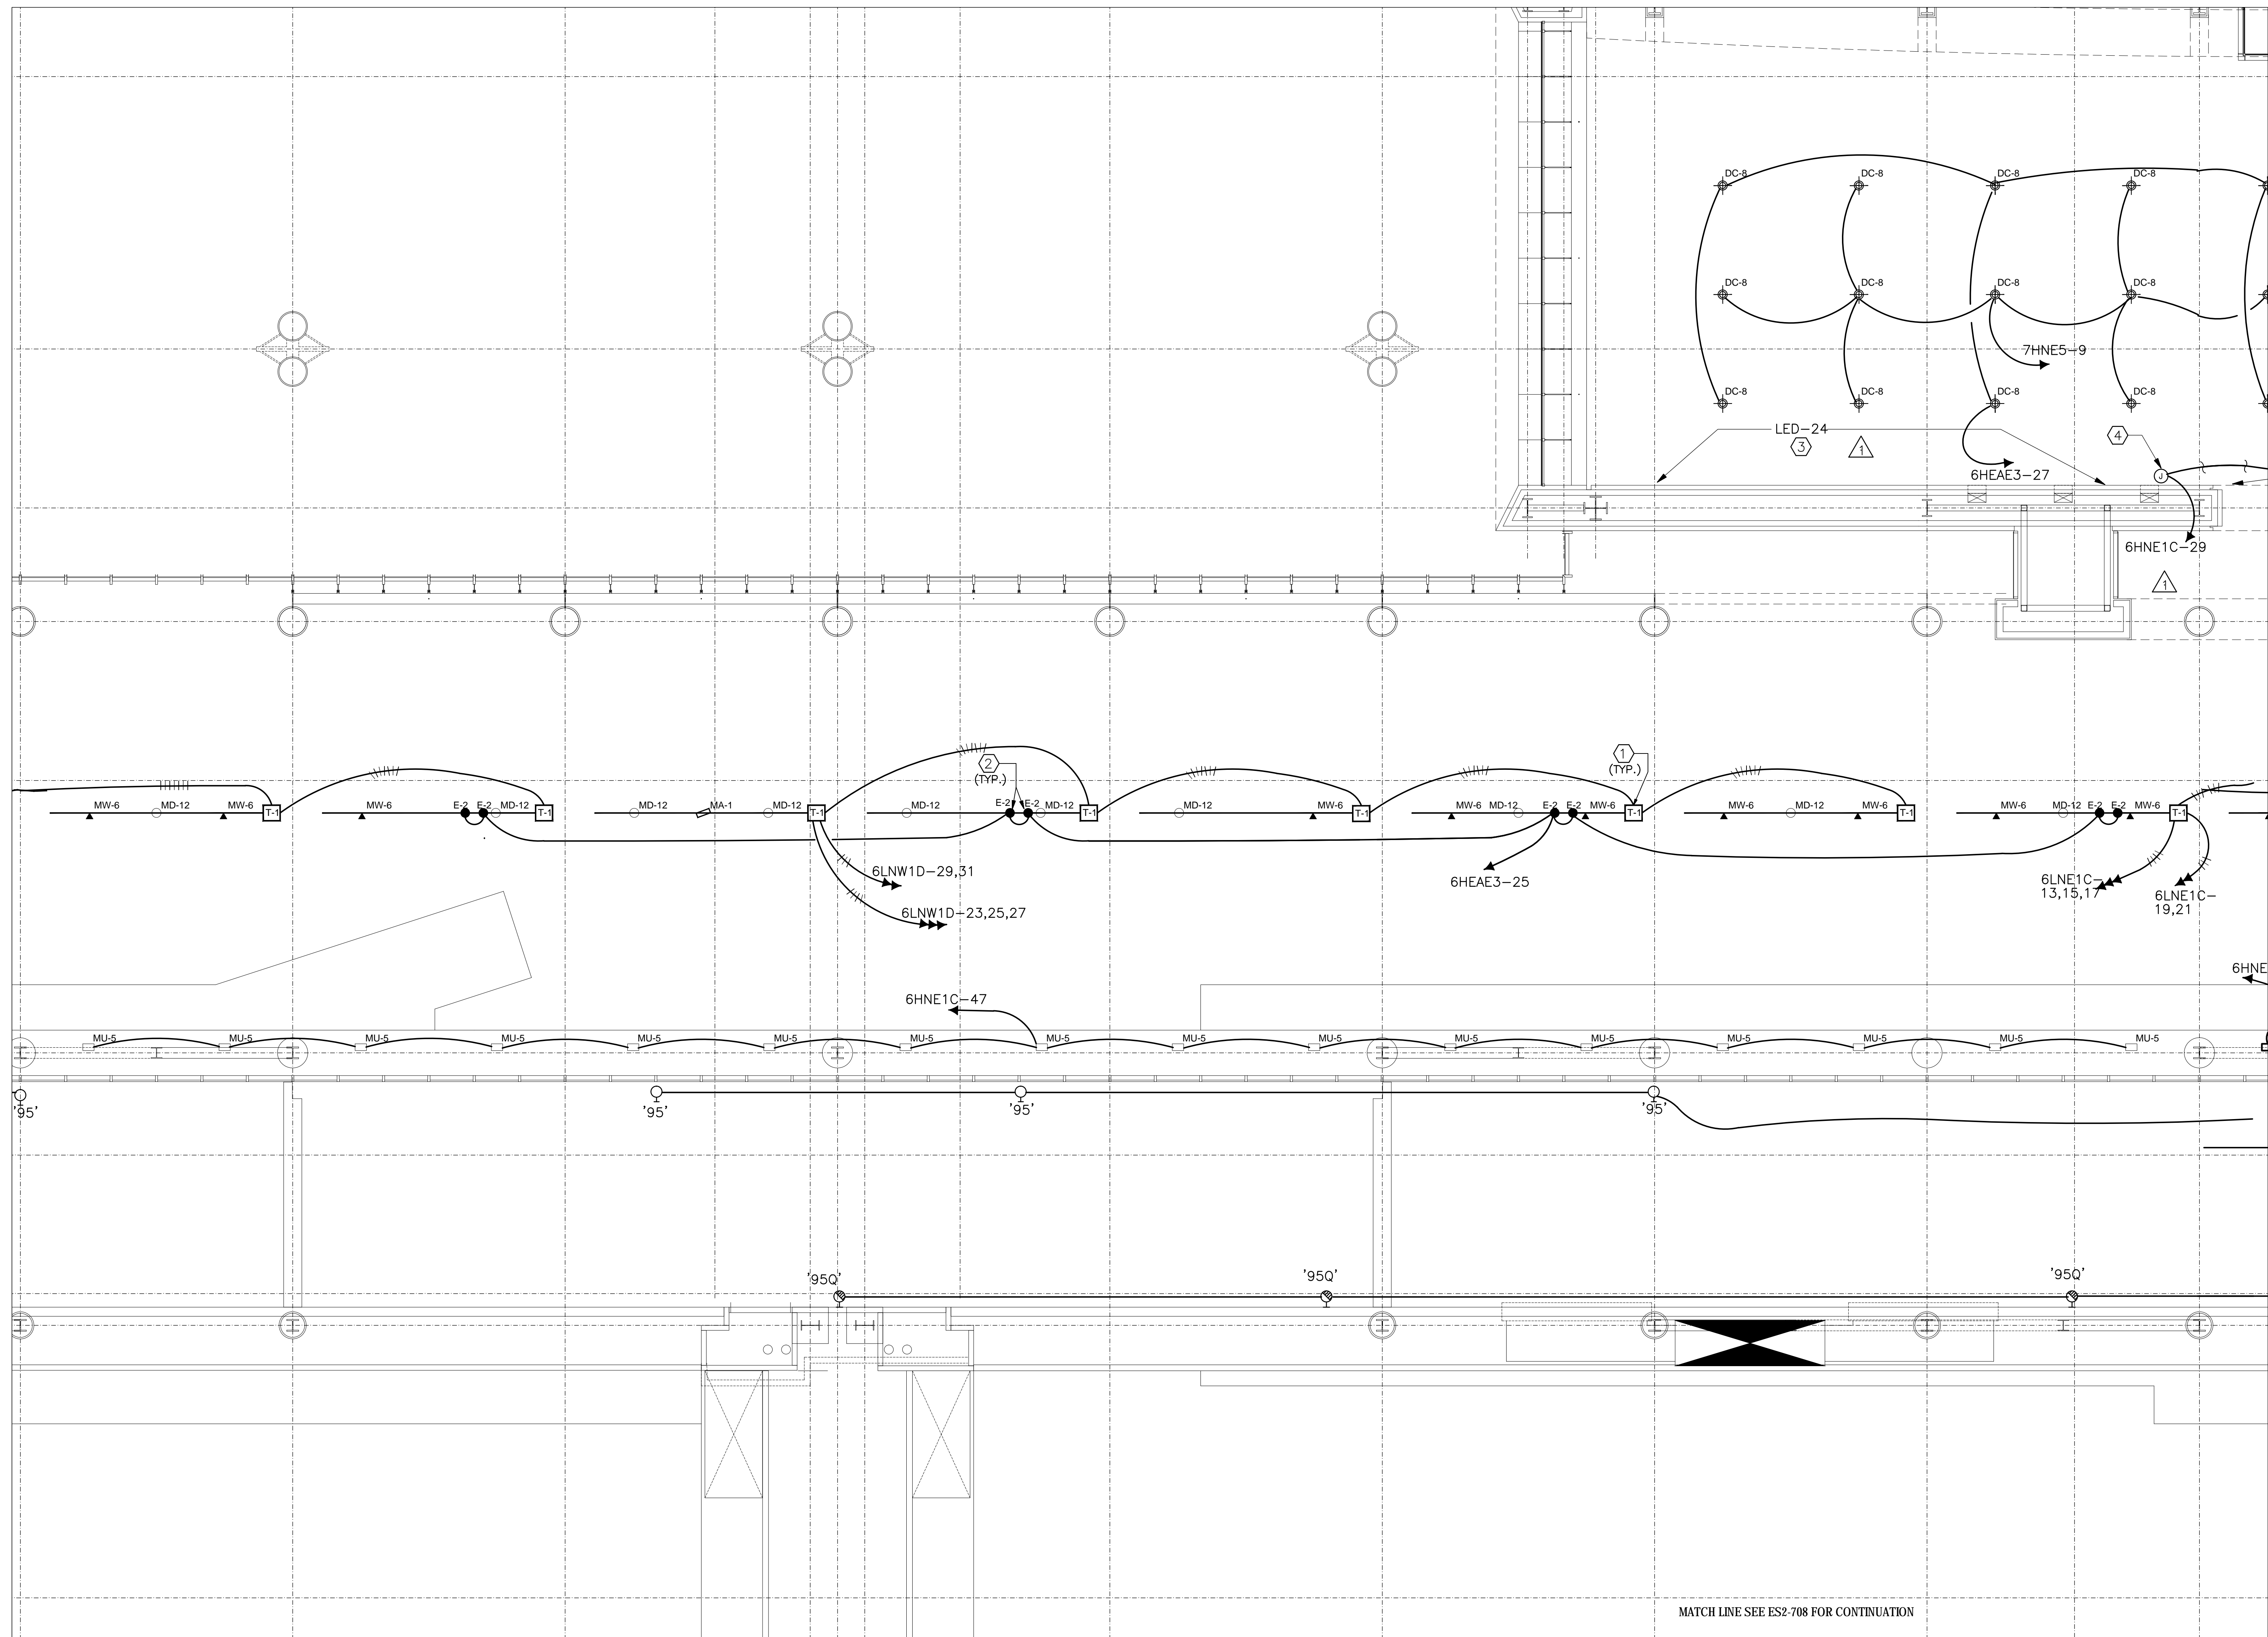


FILE PATH FOR CAD DEPARTMENT USE ONLY: C:\Users\Conti\Desktop\Projects\MCC\Level_03\Level_03\Lighting\Zone03 For Opening.dwg

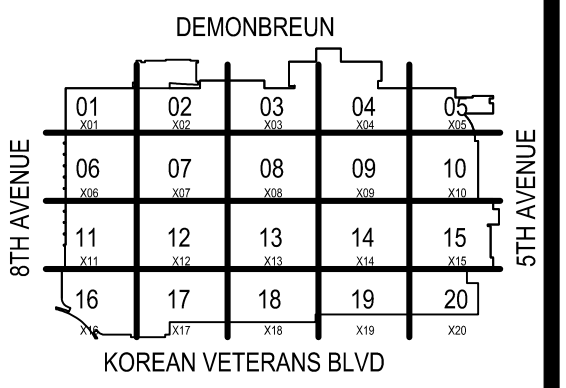

COORDINATION SIGN-OFF

COMPANY	TRADE	DATE
CONTI	ELEC.	///
		///
		///
Music City Center
 Nashville, Tennessee

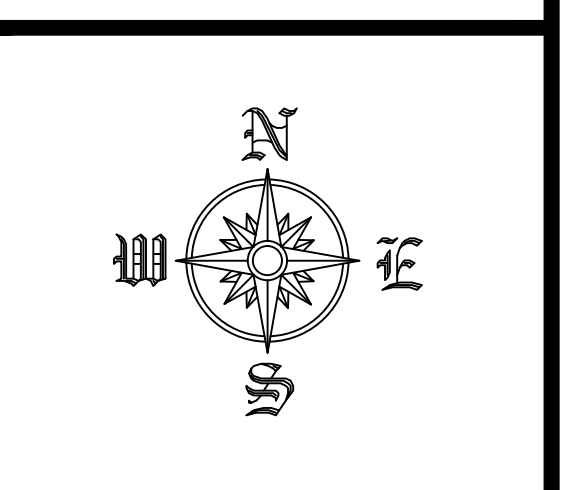

REVISIONS


NO.	DATE	DESCRIPTION


RECORD DRAWINGS STAMP

CONTI ELECTRIC DATE (last Update): 2/24/2015 10:59 AM
 DRAWING FILE NAME: E22-704
 CAD OPERATOR: GERRITAN
 PRINTED BY: FREDMAN GREGG
 PLOT DATE: 6/4/2015 11:41 AM
 SUBMITTED BY: GLENN
 ASSIGNED TO:

LEVEL 7 LIGHTING
 ZONE 04
 SCALE: 1/8" = 1'-0"

EL2-704

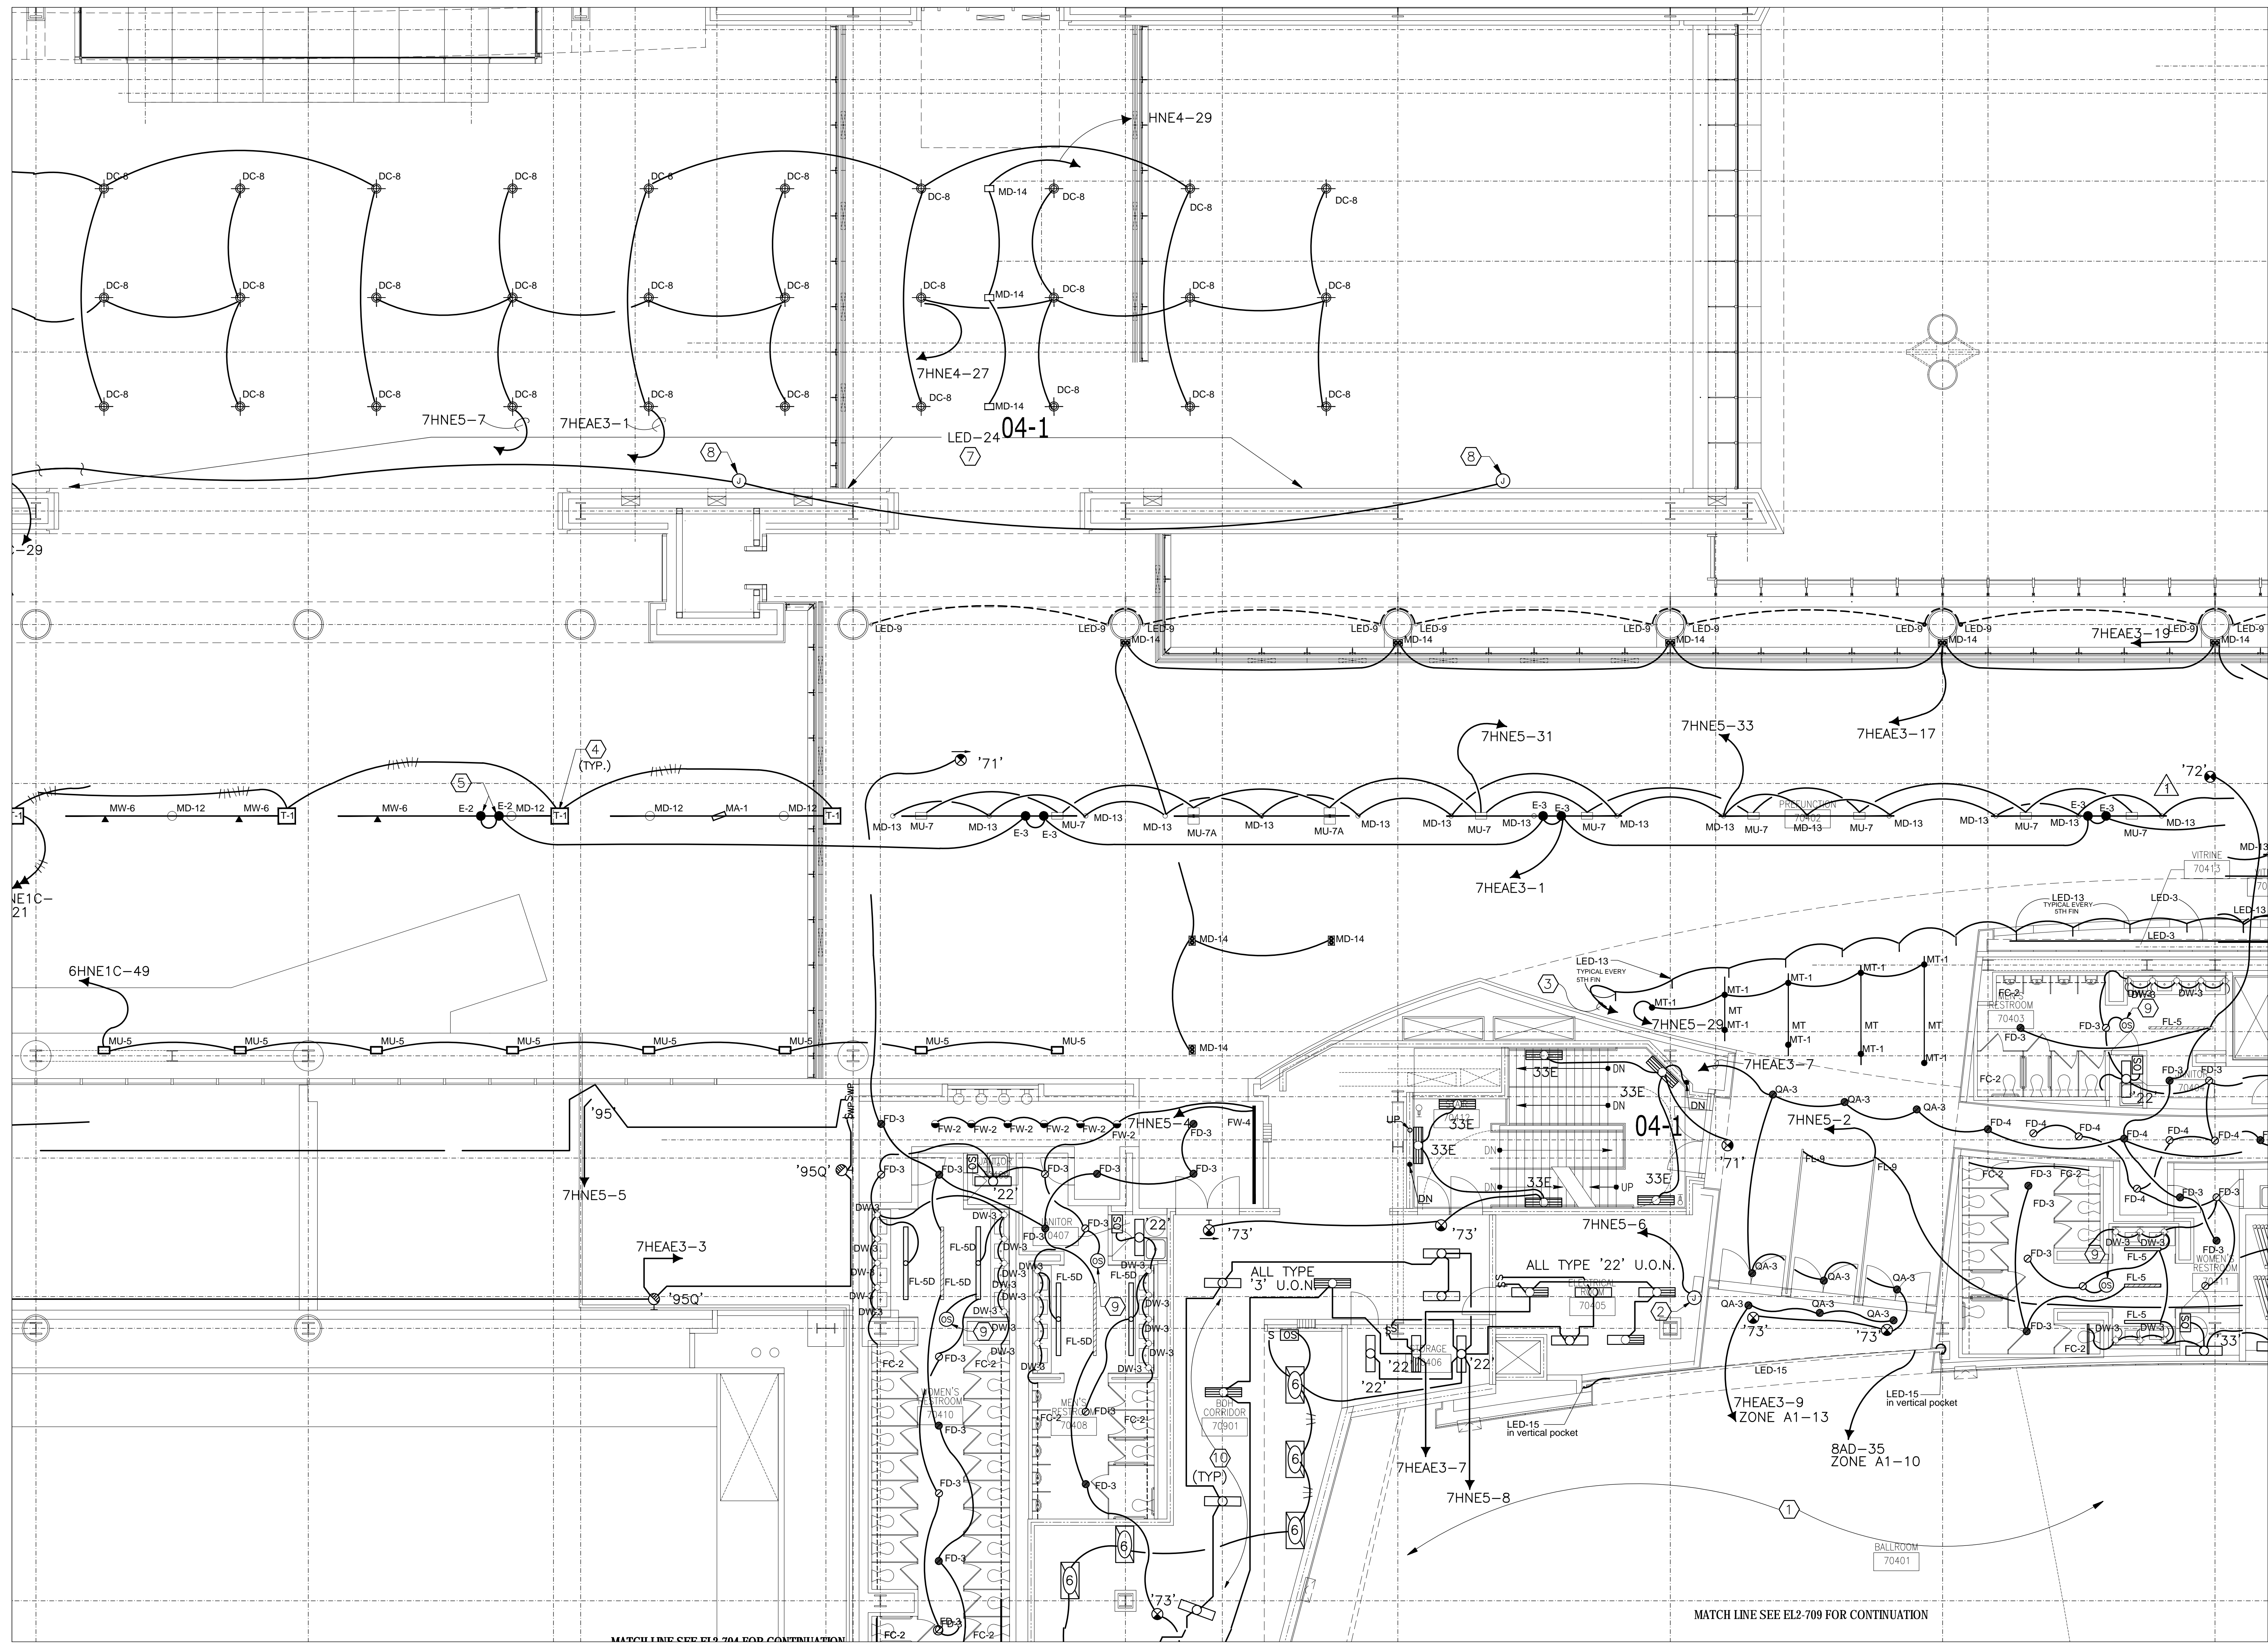


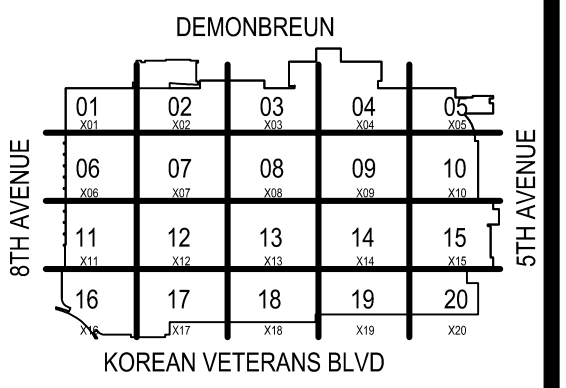

KEY PLAN
NO SCALE

COORDINATION SIGN-OFF		DATE	DATE	DATE	DATE	DATE
COMPANY	NAME					
TRADE	TRADE					
ELEC.	ELEC.					

Music City Center
Nashville, Tennessee

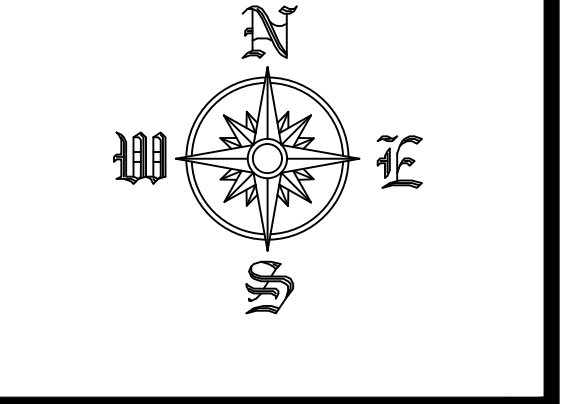

REVISIONS


NO.	DATE	DESCRIPTION

RECORD DRAWINGS STAMP

CONTRACT DATE (Last Update):	2/28/2012 10:59 AM
DRAWING FILE NAME:	EL2-705
CAD OPERATOR:	SEYMEN
PRINTED BY:	SEYMEN, GREG
PLOT DATE:	6/4/2012 8:18 AM
SUBMITTED BY:	ELP
ASSIGNED TO:	

LEVEL 7 LIGHTING
 ZONE 05
 SCALE: 1/8" = 1'-0"


EL2-705

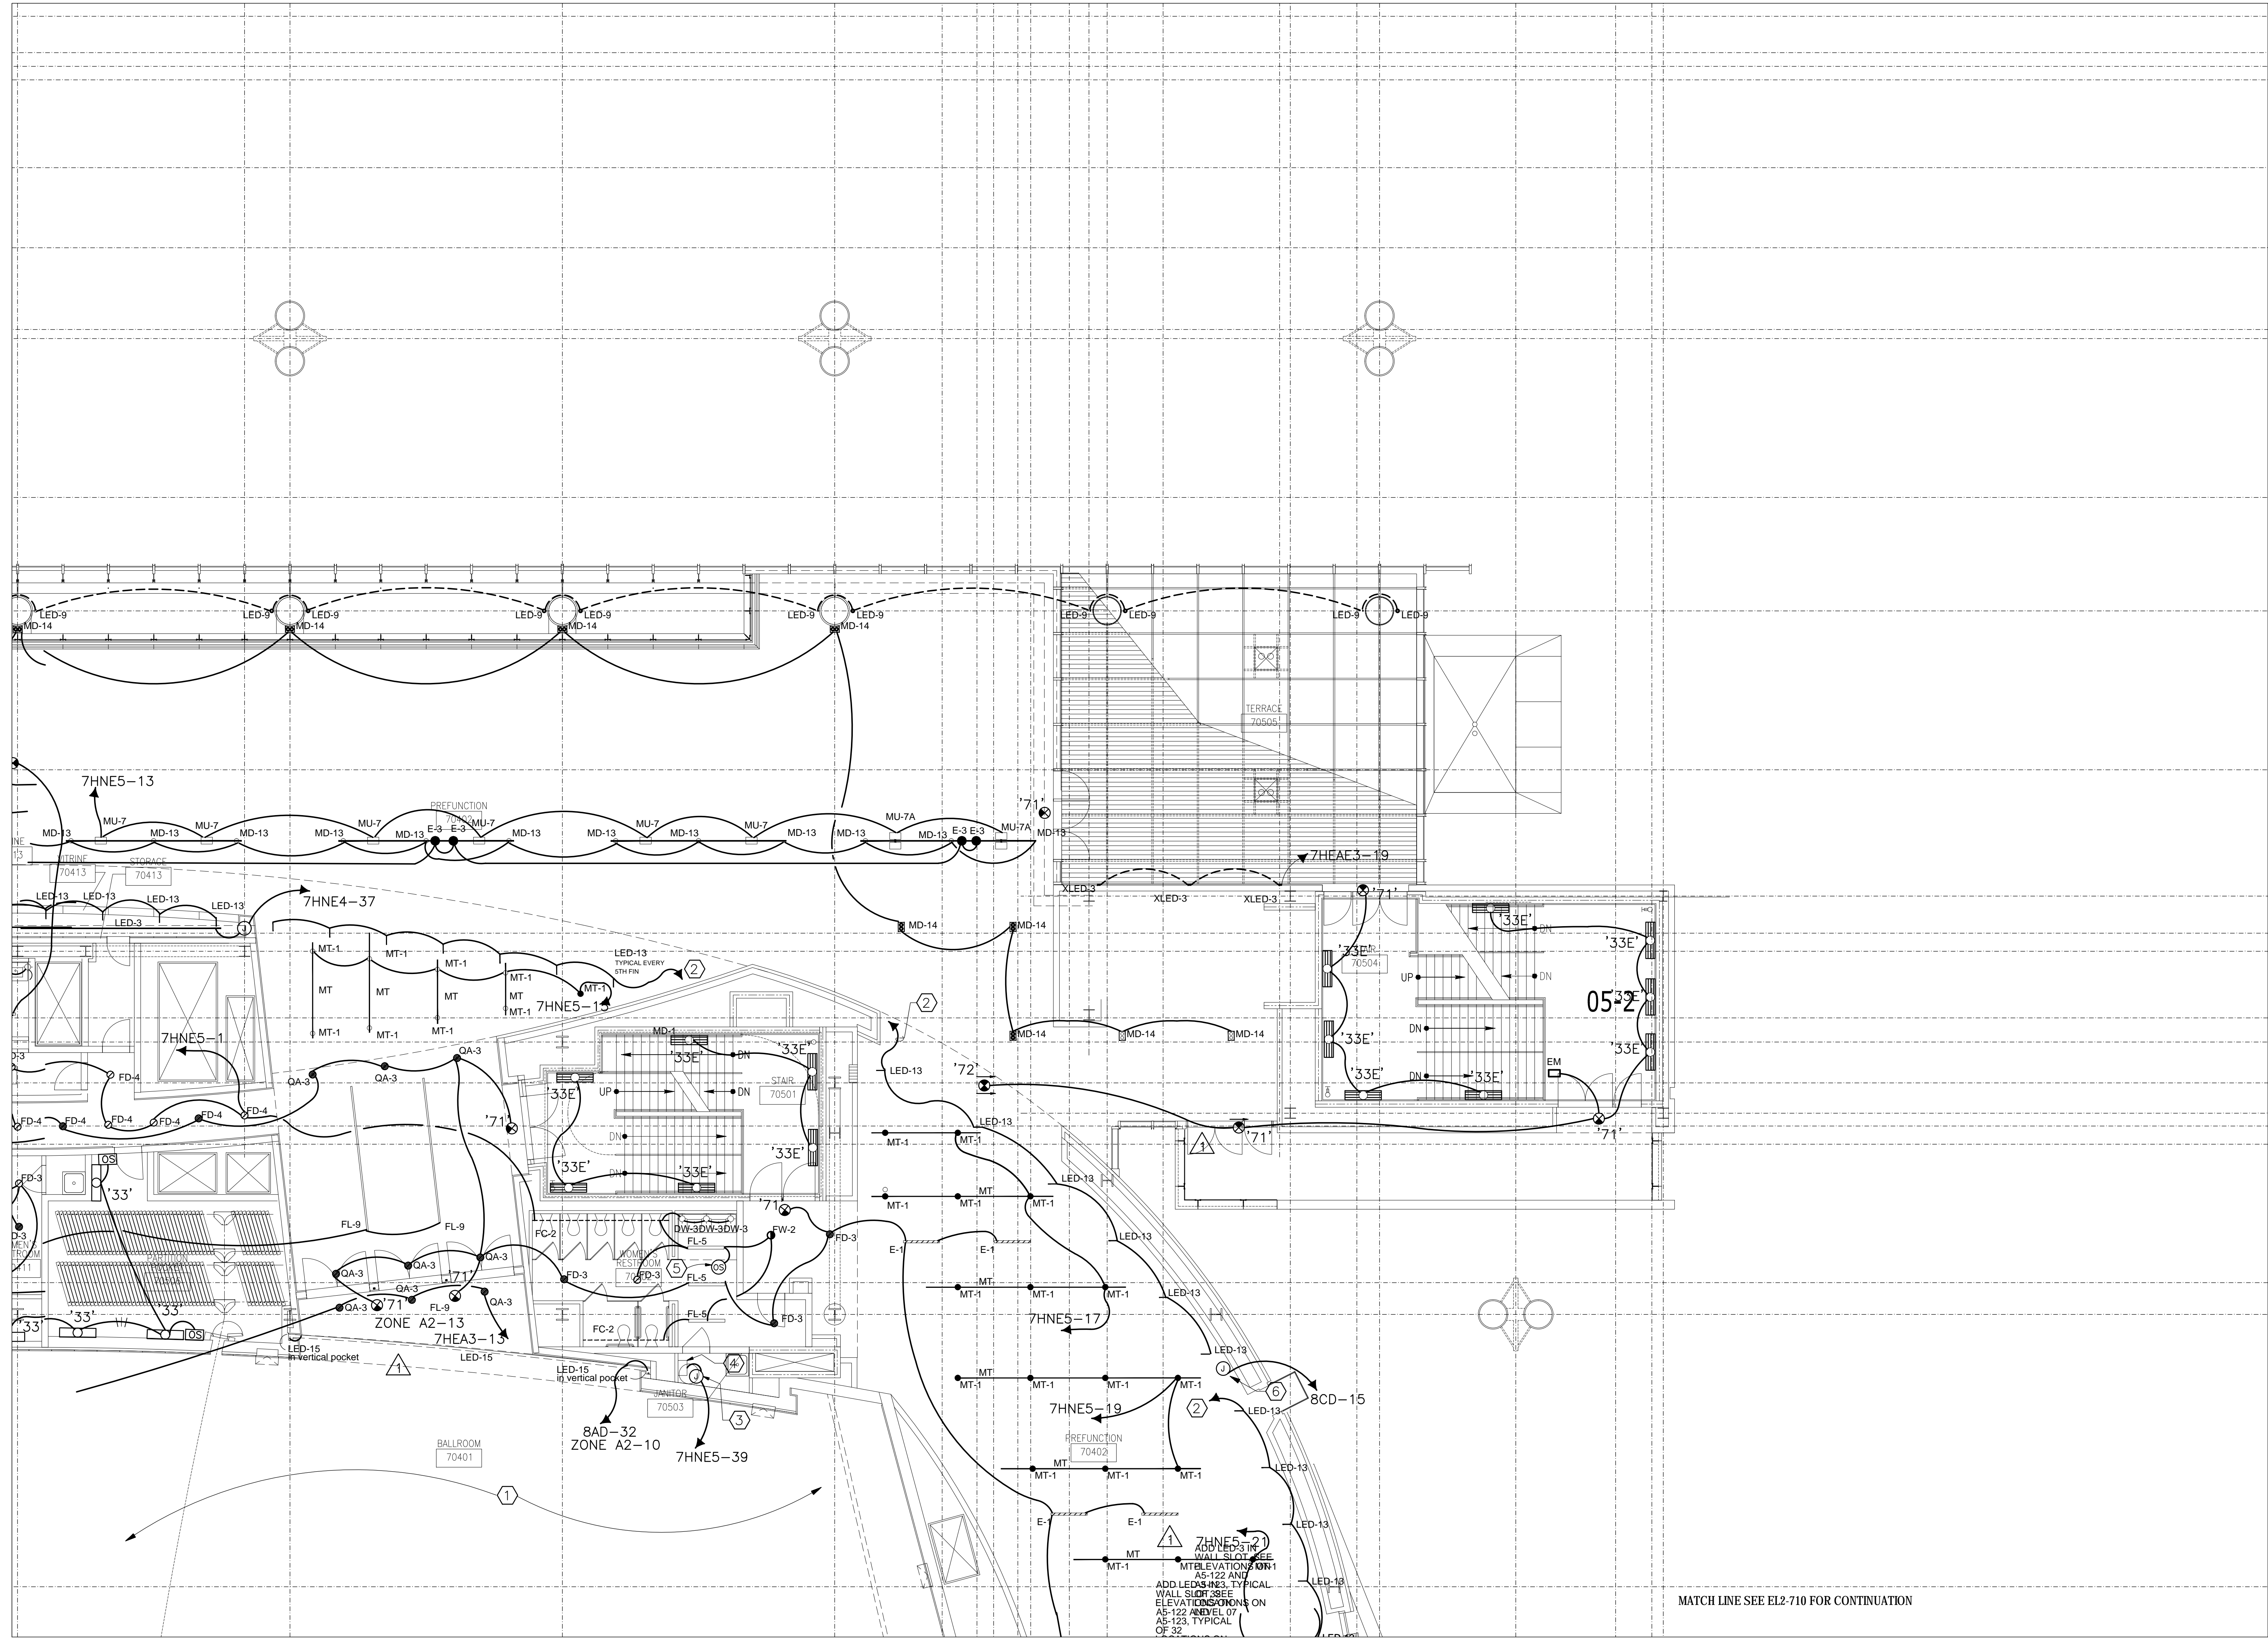

MATCH LINE SEE EL2-710 FOR CONTINUATION

ADD LEDS #83 TYPICAL WALL SLOTT SEE ELEVATIONS ON AS-122 AND AS-123 TYPICAL OF 32


FILE PATH FOR CAD OPERATOR USE ONLY: C:\Users\Conti\Desktop\Projects\MCC\Level 05 - Ballroom 4\EL2-705.dwg 7/1/2012 10:59 AM

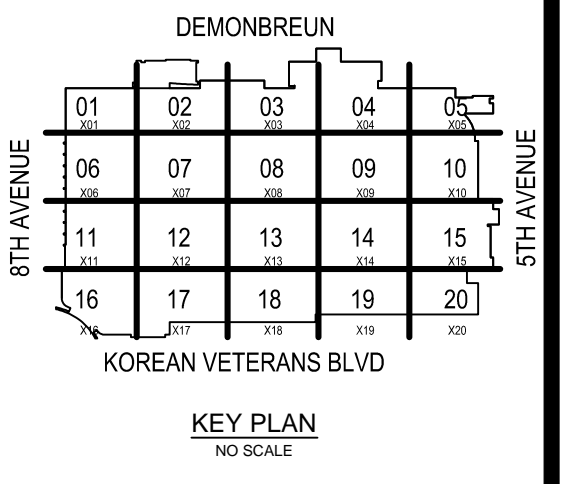

COORDINATION SIGN-OFF

COMPANY	TRADE	DATE
CONTI	ELEC.	/ /
		/ /
		/ /
Music City Center
 Nashville, Tennessee

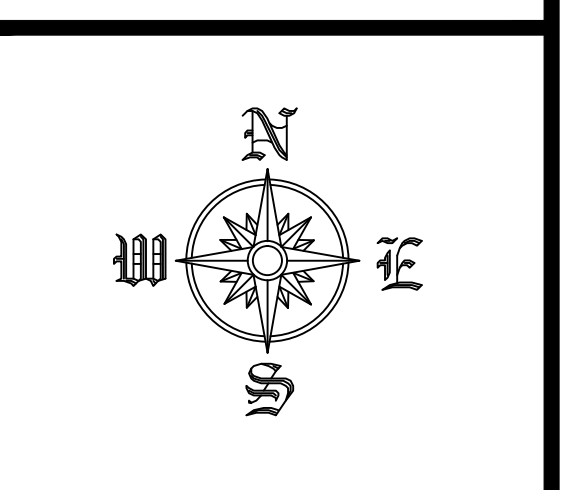

REVISIONS

NO.	DATE	DESCRIPTION

RECORD DRAWINGS STAMP

CONTI ELECTRIC DATE (Last Update):
 2/24/2015 10:59 AM

DRAWING FILE NAME:
 EL2-706

CAD OPERATOR:
 GREGG

PRINTED BY:
 FREDMAN GREGG


PLOT DATE:
 6/4/2015 8:18 AM


SUBMITTED BY:
 GREGG

ASSIGNED TO:

LEVEL 7 LIGHTING
 ZONE 06
 SCALE: 1/8" = 1'-0"

EL2-706

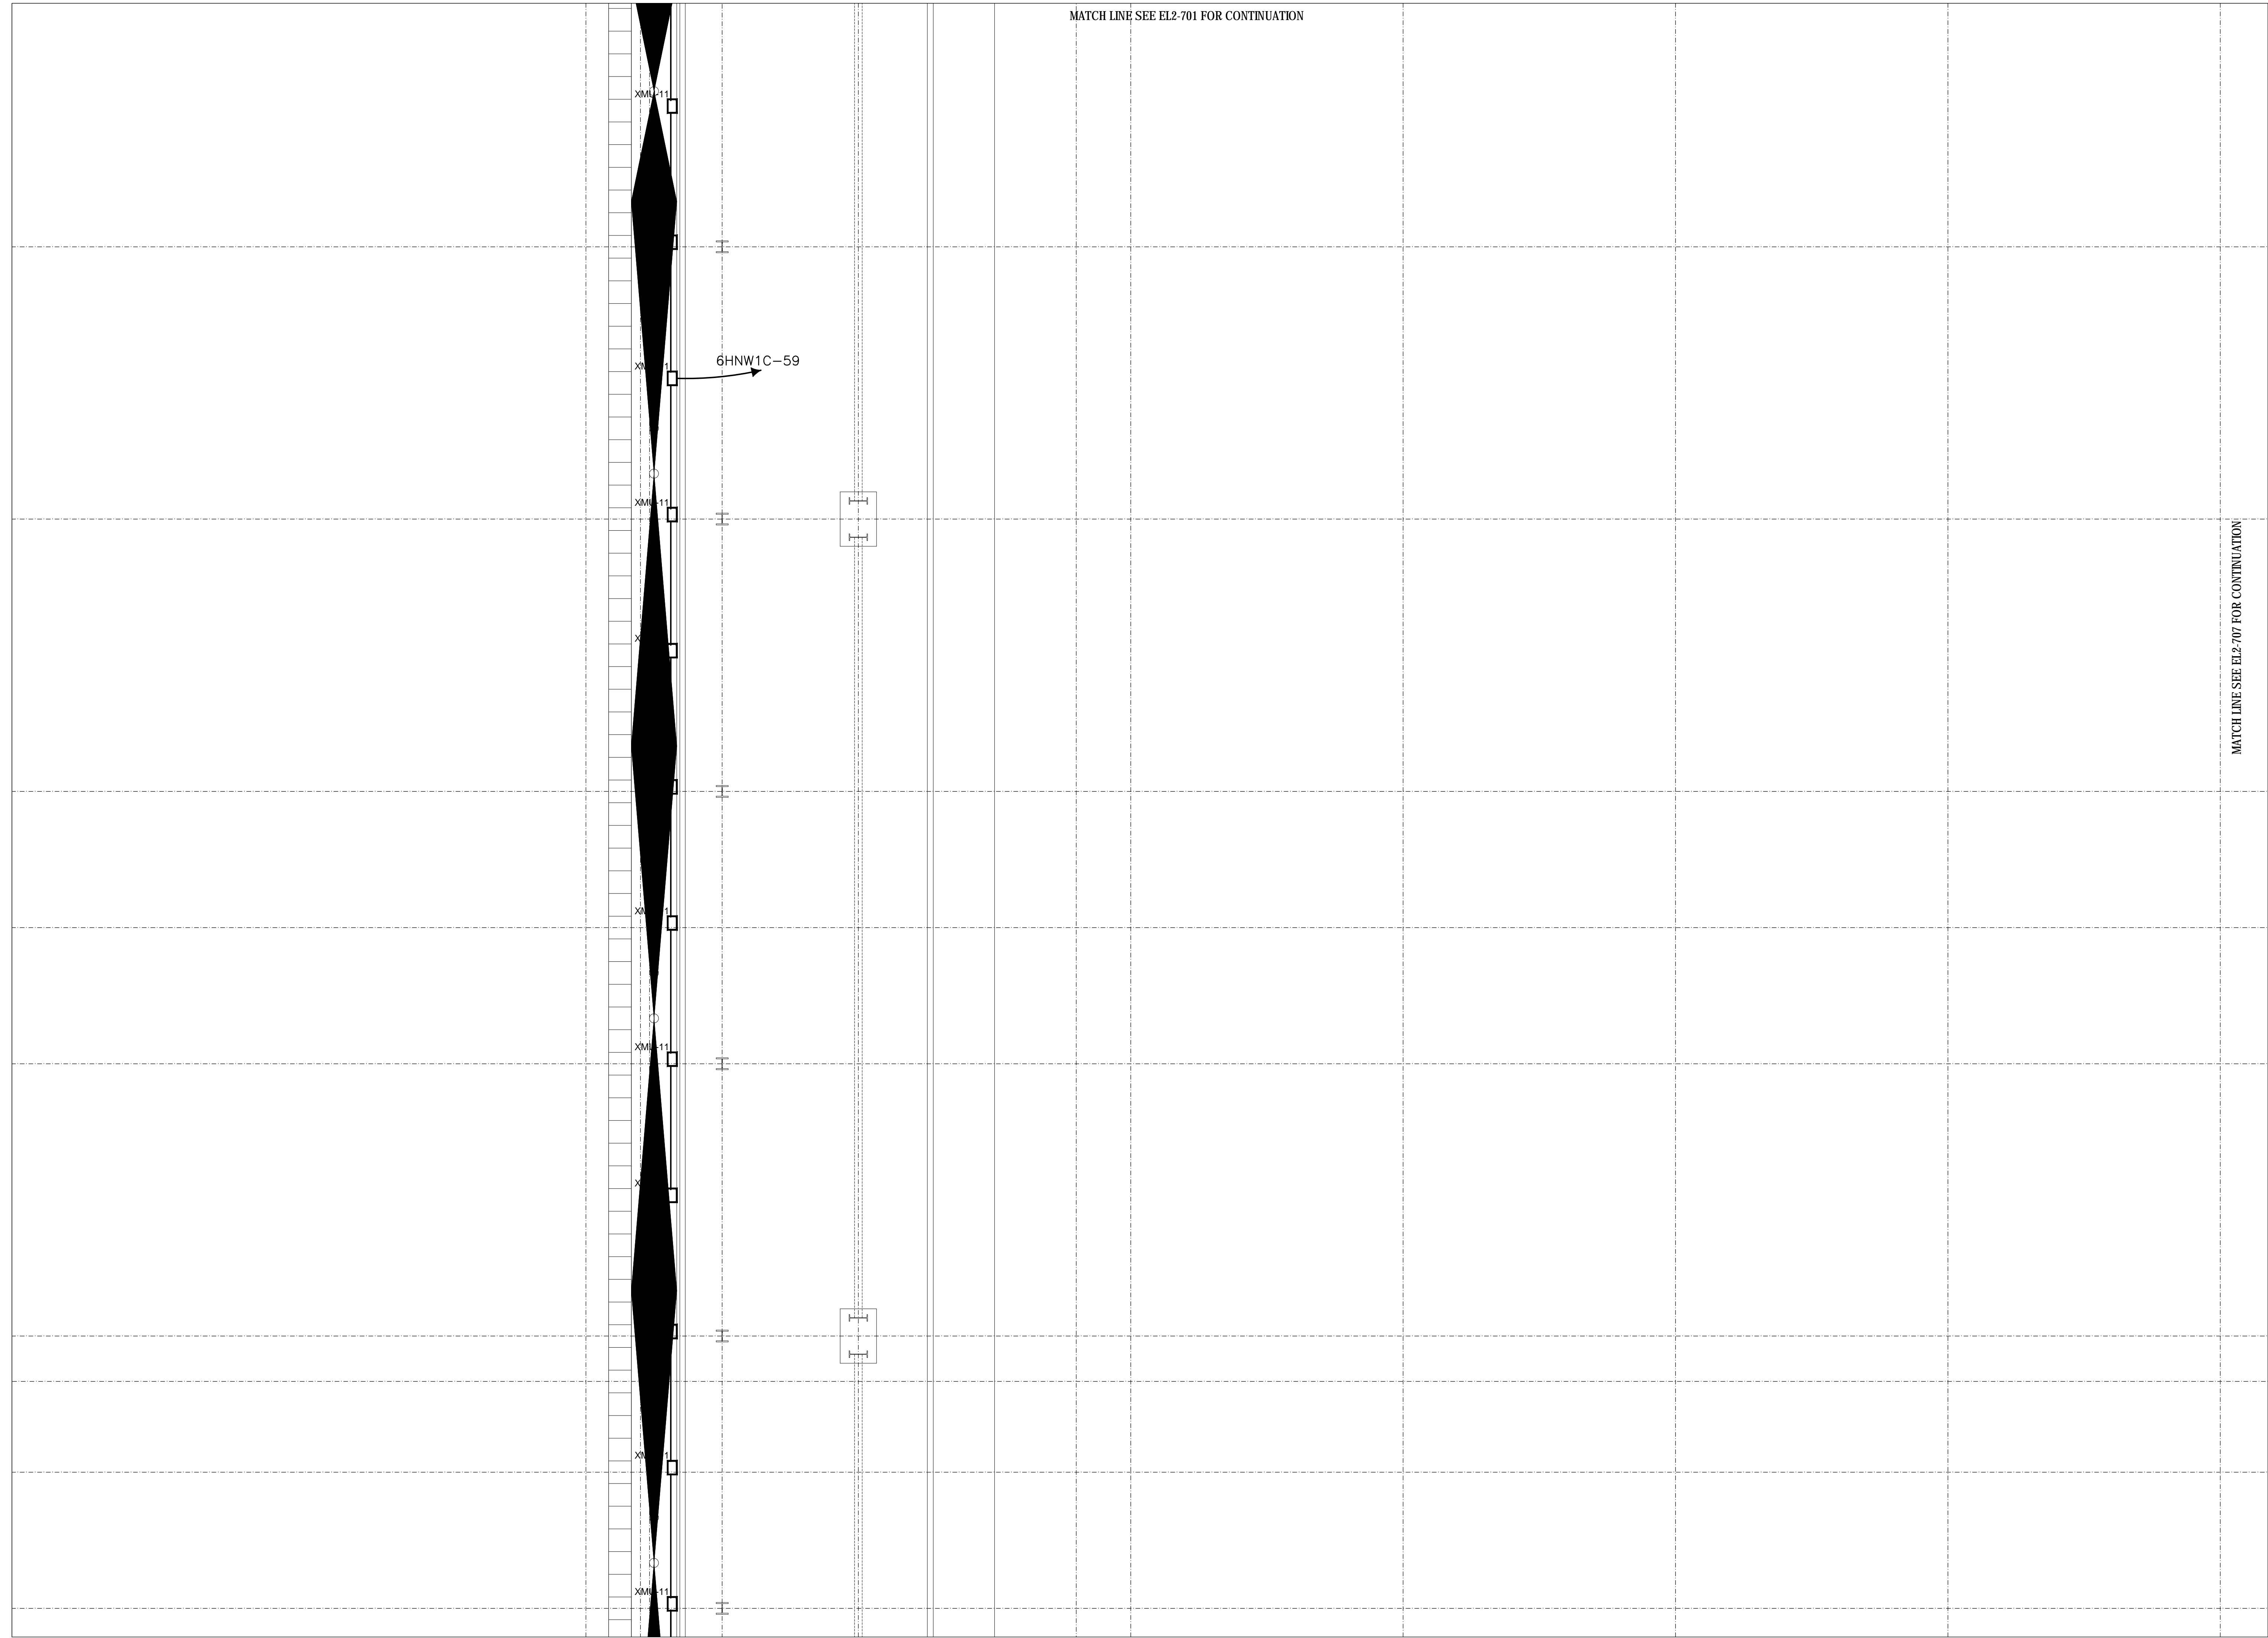


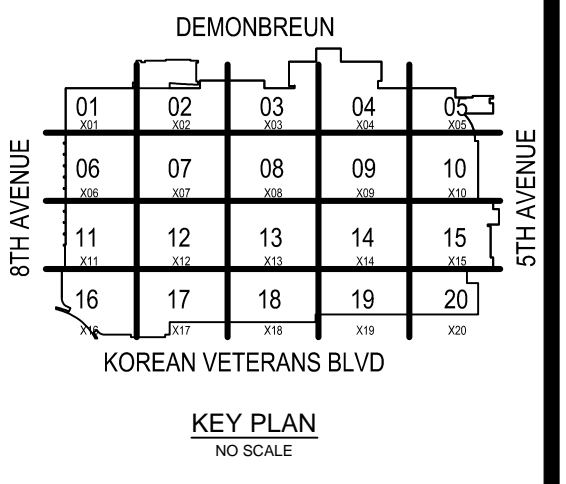

COORDINATION SIGN-OFF

COMPANY	TRADE	DATE
CONTI	ELEC.	/ /
		/ /
		/ /
Music City Center
 Nashville, Tennessee

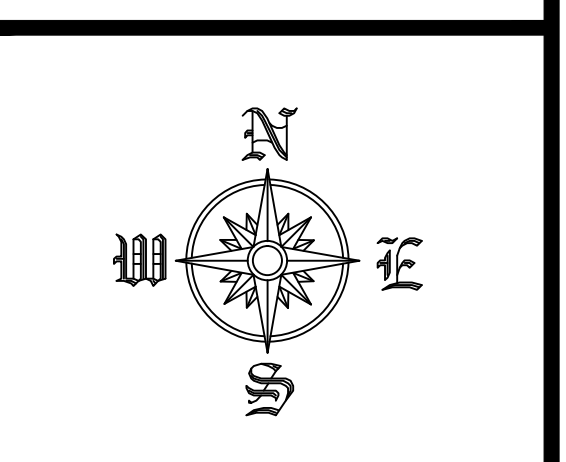

REVISIONS

NO.	DATE	DESCRIPTION

RECORD DRAWINGS STAMP

CONTI ELECTRIC DATE (Last Update):
 2/24/2015 10:59 AM

DRAWING FILE NAME:
 EL2-709

CAD OPERATOR:
 GREGG

PRINTED BY:
 GREGG

PLOT DATE:
 6/4/2015 8:18 AM

SUBMITTED BY:
 GREGG

ASSIGNED TO:

LEVEL 7 LIGHTING
 ZONE 9
 SCALE: 1/8" = 1'-0"

EL2-709





MATCH LINE SEE EL2-708 FOR CONTINUATION

MATCH LINE SEE EL2-704 FOR CONTINUATION

MATCH LINE SEE EL2-710 FOR CONTINUATION


MATCH LINE SEE EL2-714 FOR CONTINUATION

FILE PATH FOR CAD OPERATOR USE ONLY: P:\3085\Conti\Bids\Nashville_MCC\Level_09_Balls_4\EL2\Level 7 Lighting\Zone 9 For Opening.dwg

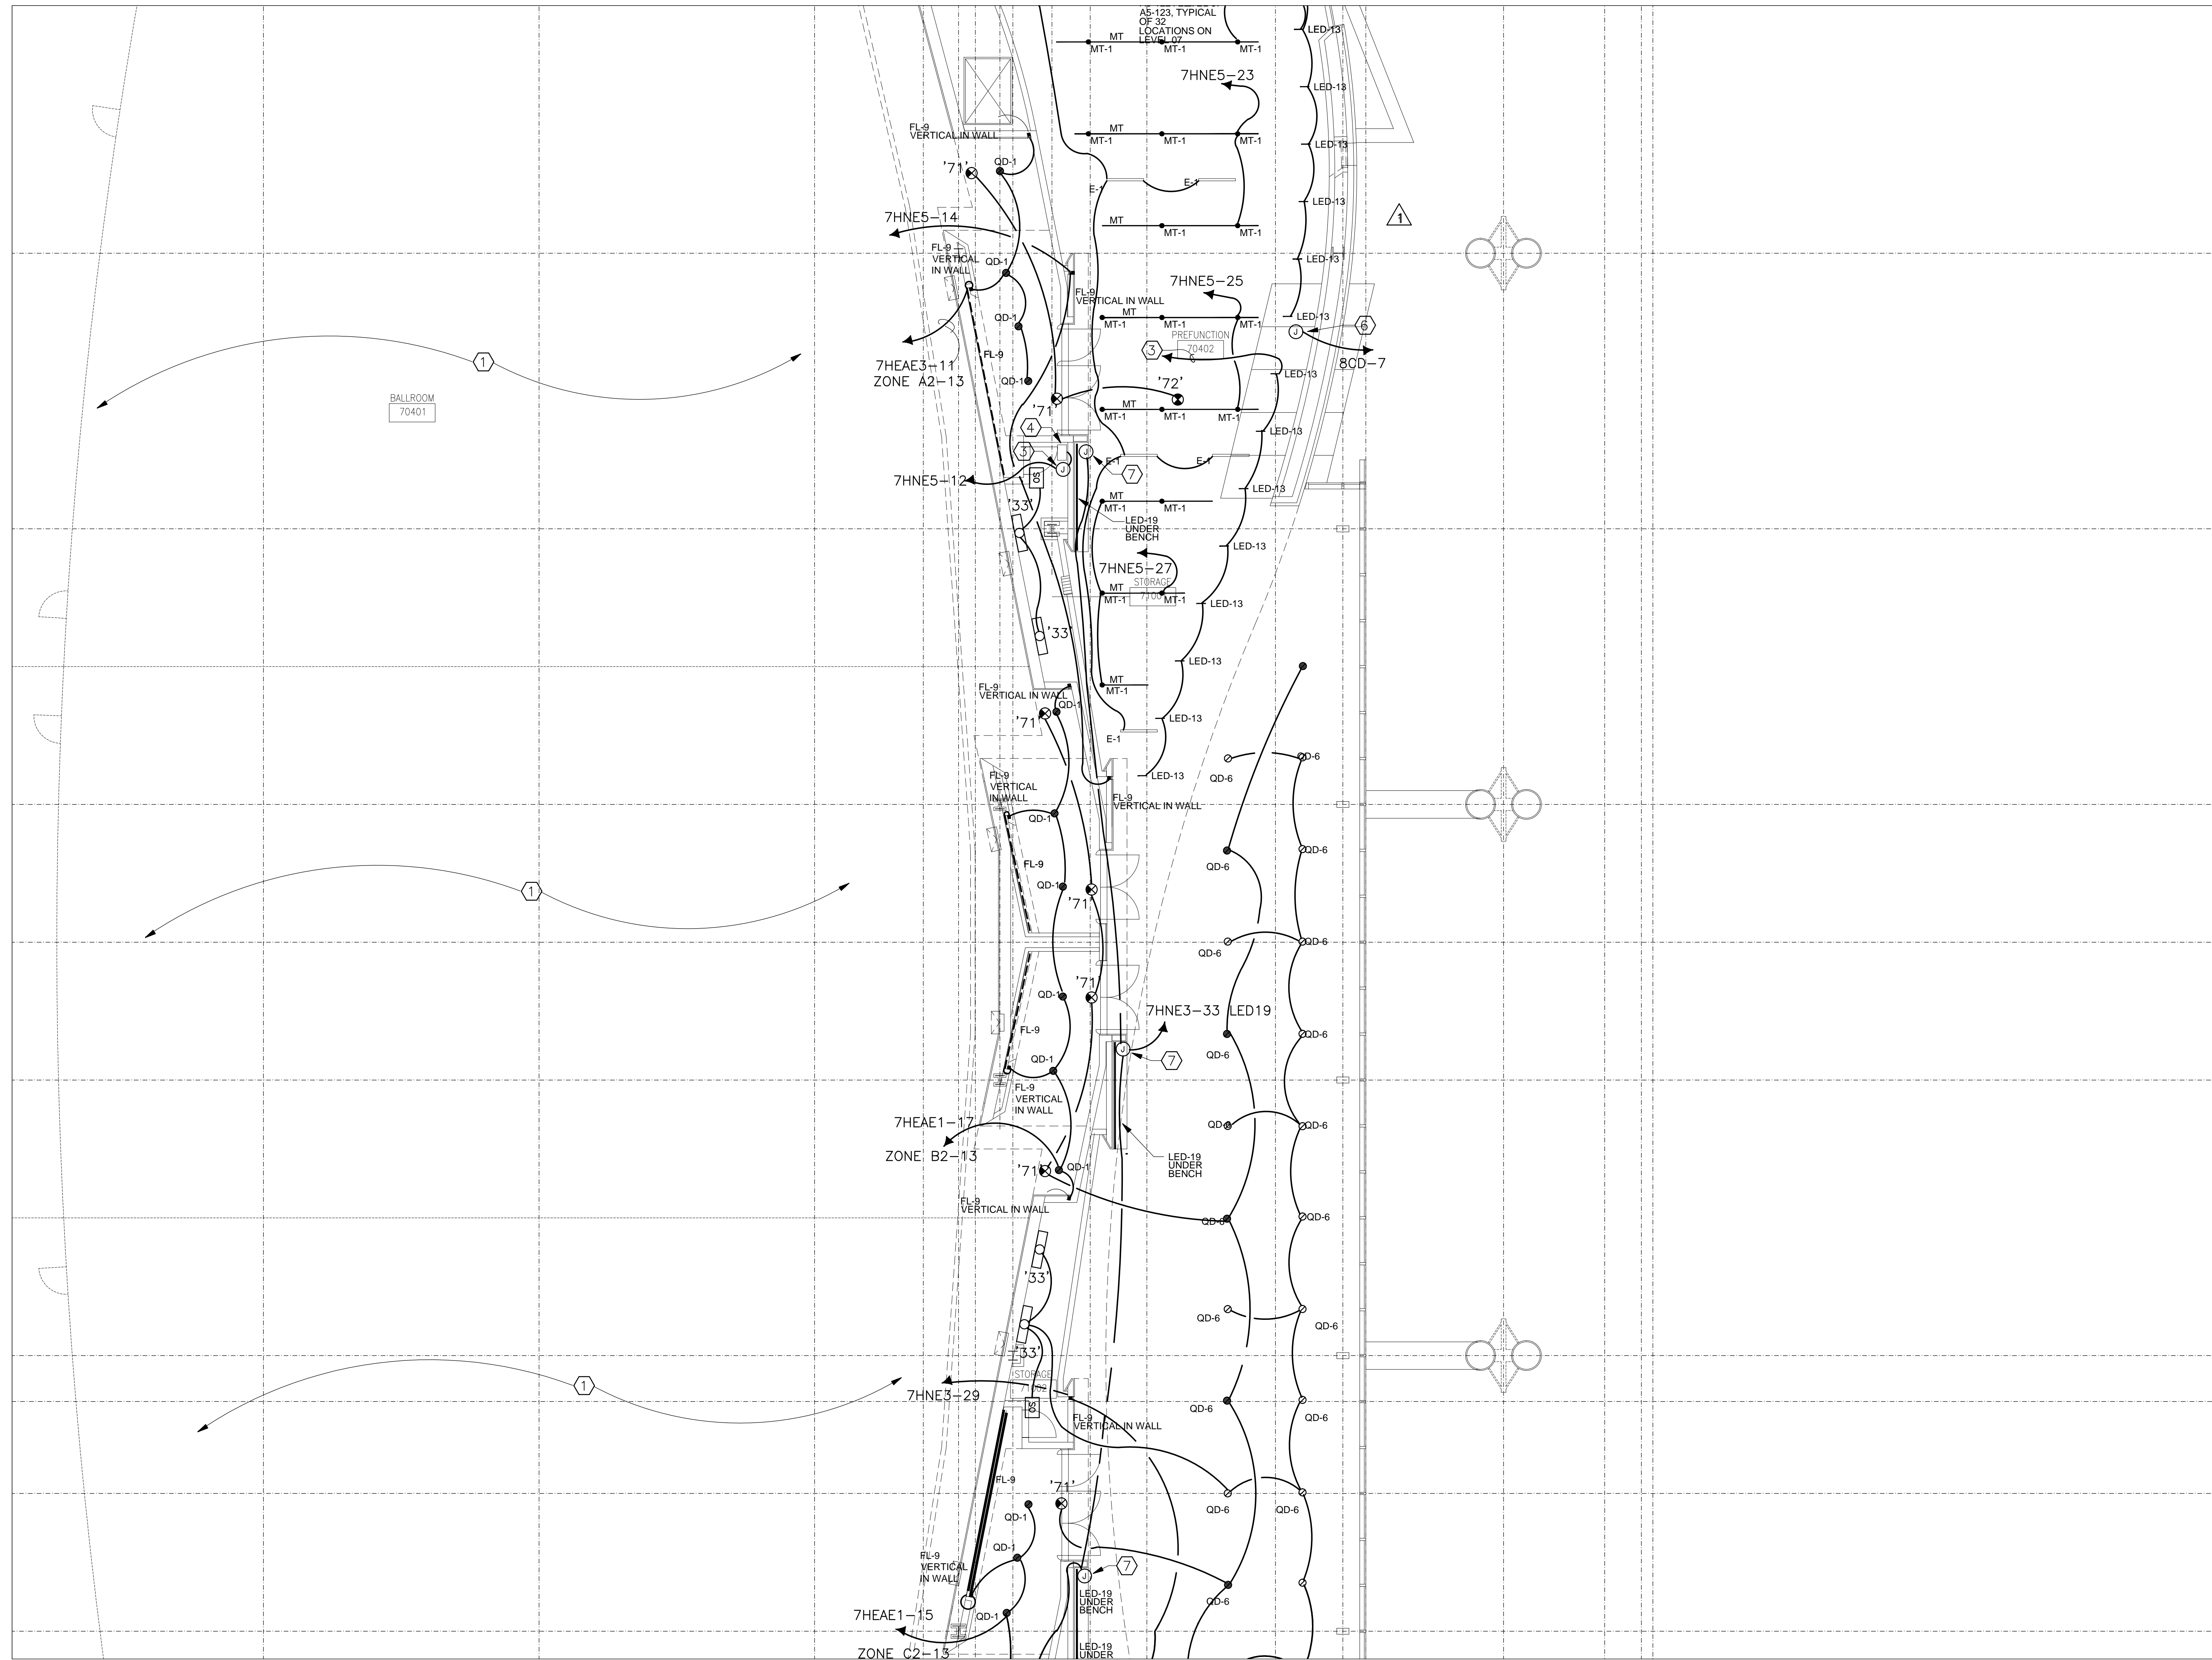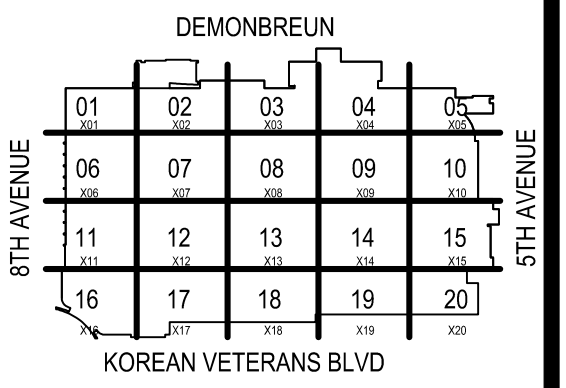

COORDINATION SIGN-OFF	
DATE	/ /
NAME	
TRADE	
ELEC.	
COMPANY	
CONTI	

Music City Center
Nashville, Tennessee

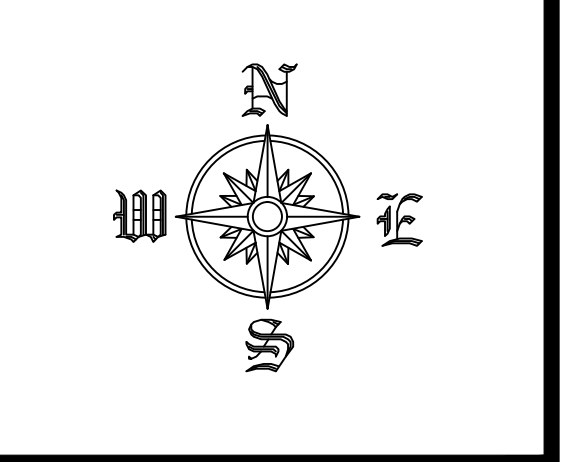

REVISIONS		
NO.	DATE	DESCRIPTION

RECORD DRAWINGS STAMP

CONTELECTRIC DATE (Last Update):
 2/24/2015 10:59 AM

DRAWING FILE NAME:
 E22-204

CAD OPERATOR:
 GERTMAN

PRINTED BY:
 FREDMAN, GREG

PLOT DATE:
 6/4/2015 8:18 AM


SUBMITTED BY:
 G.P.

ASSIGNED TO:

LEVEL 7 LIGHTING
 ZONE 10
 SCALE: 1/8" = 1'-0"


EL2-710

FILE PATH FOR CAD DEPARTMENT USE ONLY: P:\2015\Conti\Bids\Nashville_MusicCityCenter\04 - Ballroom\4-10-15\Level 7 Lighting\Submittal For Owner.rvt

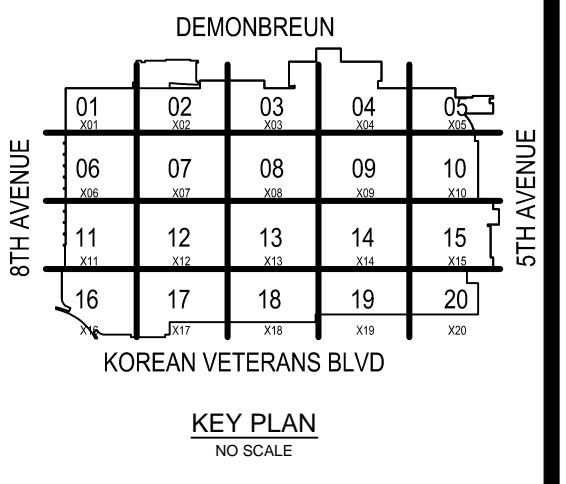

COORDINATION SIGN-OFF		DATE
COMPANY	NAME	/ /
TRADE		/ /
ELEC.		/ /
CONTI		/ /

Music City Center
Nashville, Tennessee

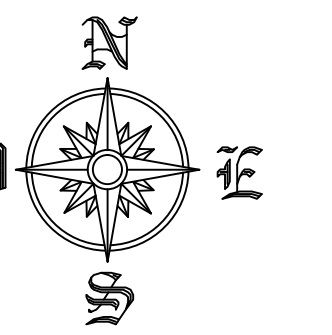


REVISIONS		
NO.	DATE	DESCRIPTION


RECORD DRAWINGS STAMP

CONTI ELECTRIC DATE (Last Update): 2/24/2012 10:59 AM
 DRAWING FILE NAME: EL2-711
 CAD OPERATOR: GERTMAN
 PRINTED BY: FREDMAN, GREG
 PLOT DATE: 6/4/2012 8:18 AM
 SUBMITTED BY: G.L.P.
 ASSIGNED TO:

LEVEL 7 LIGHTING
 ZONE 11
 SCALE: 1/8" = 1'-0"

EL2-711

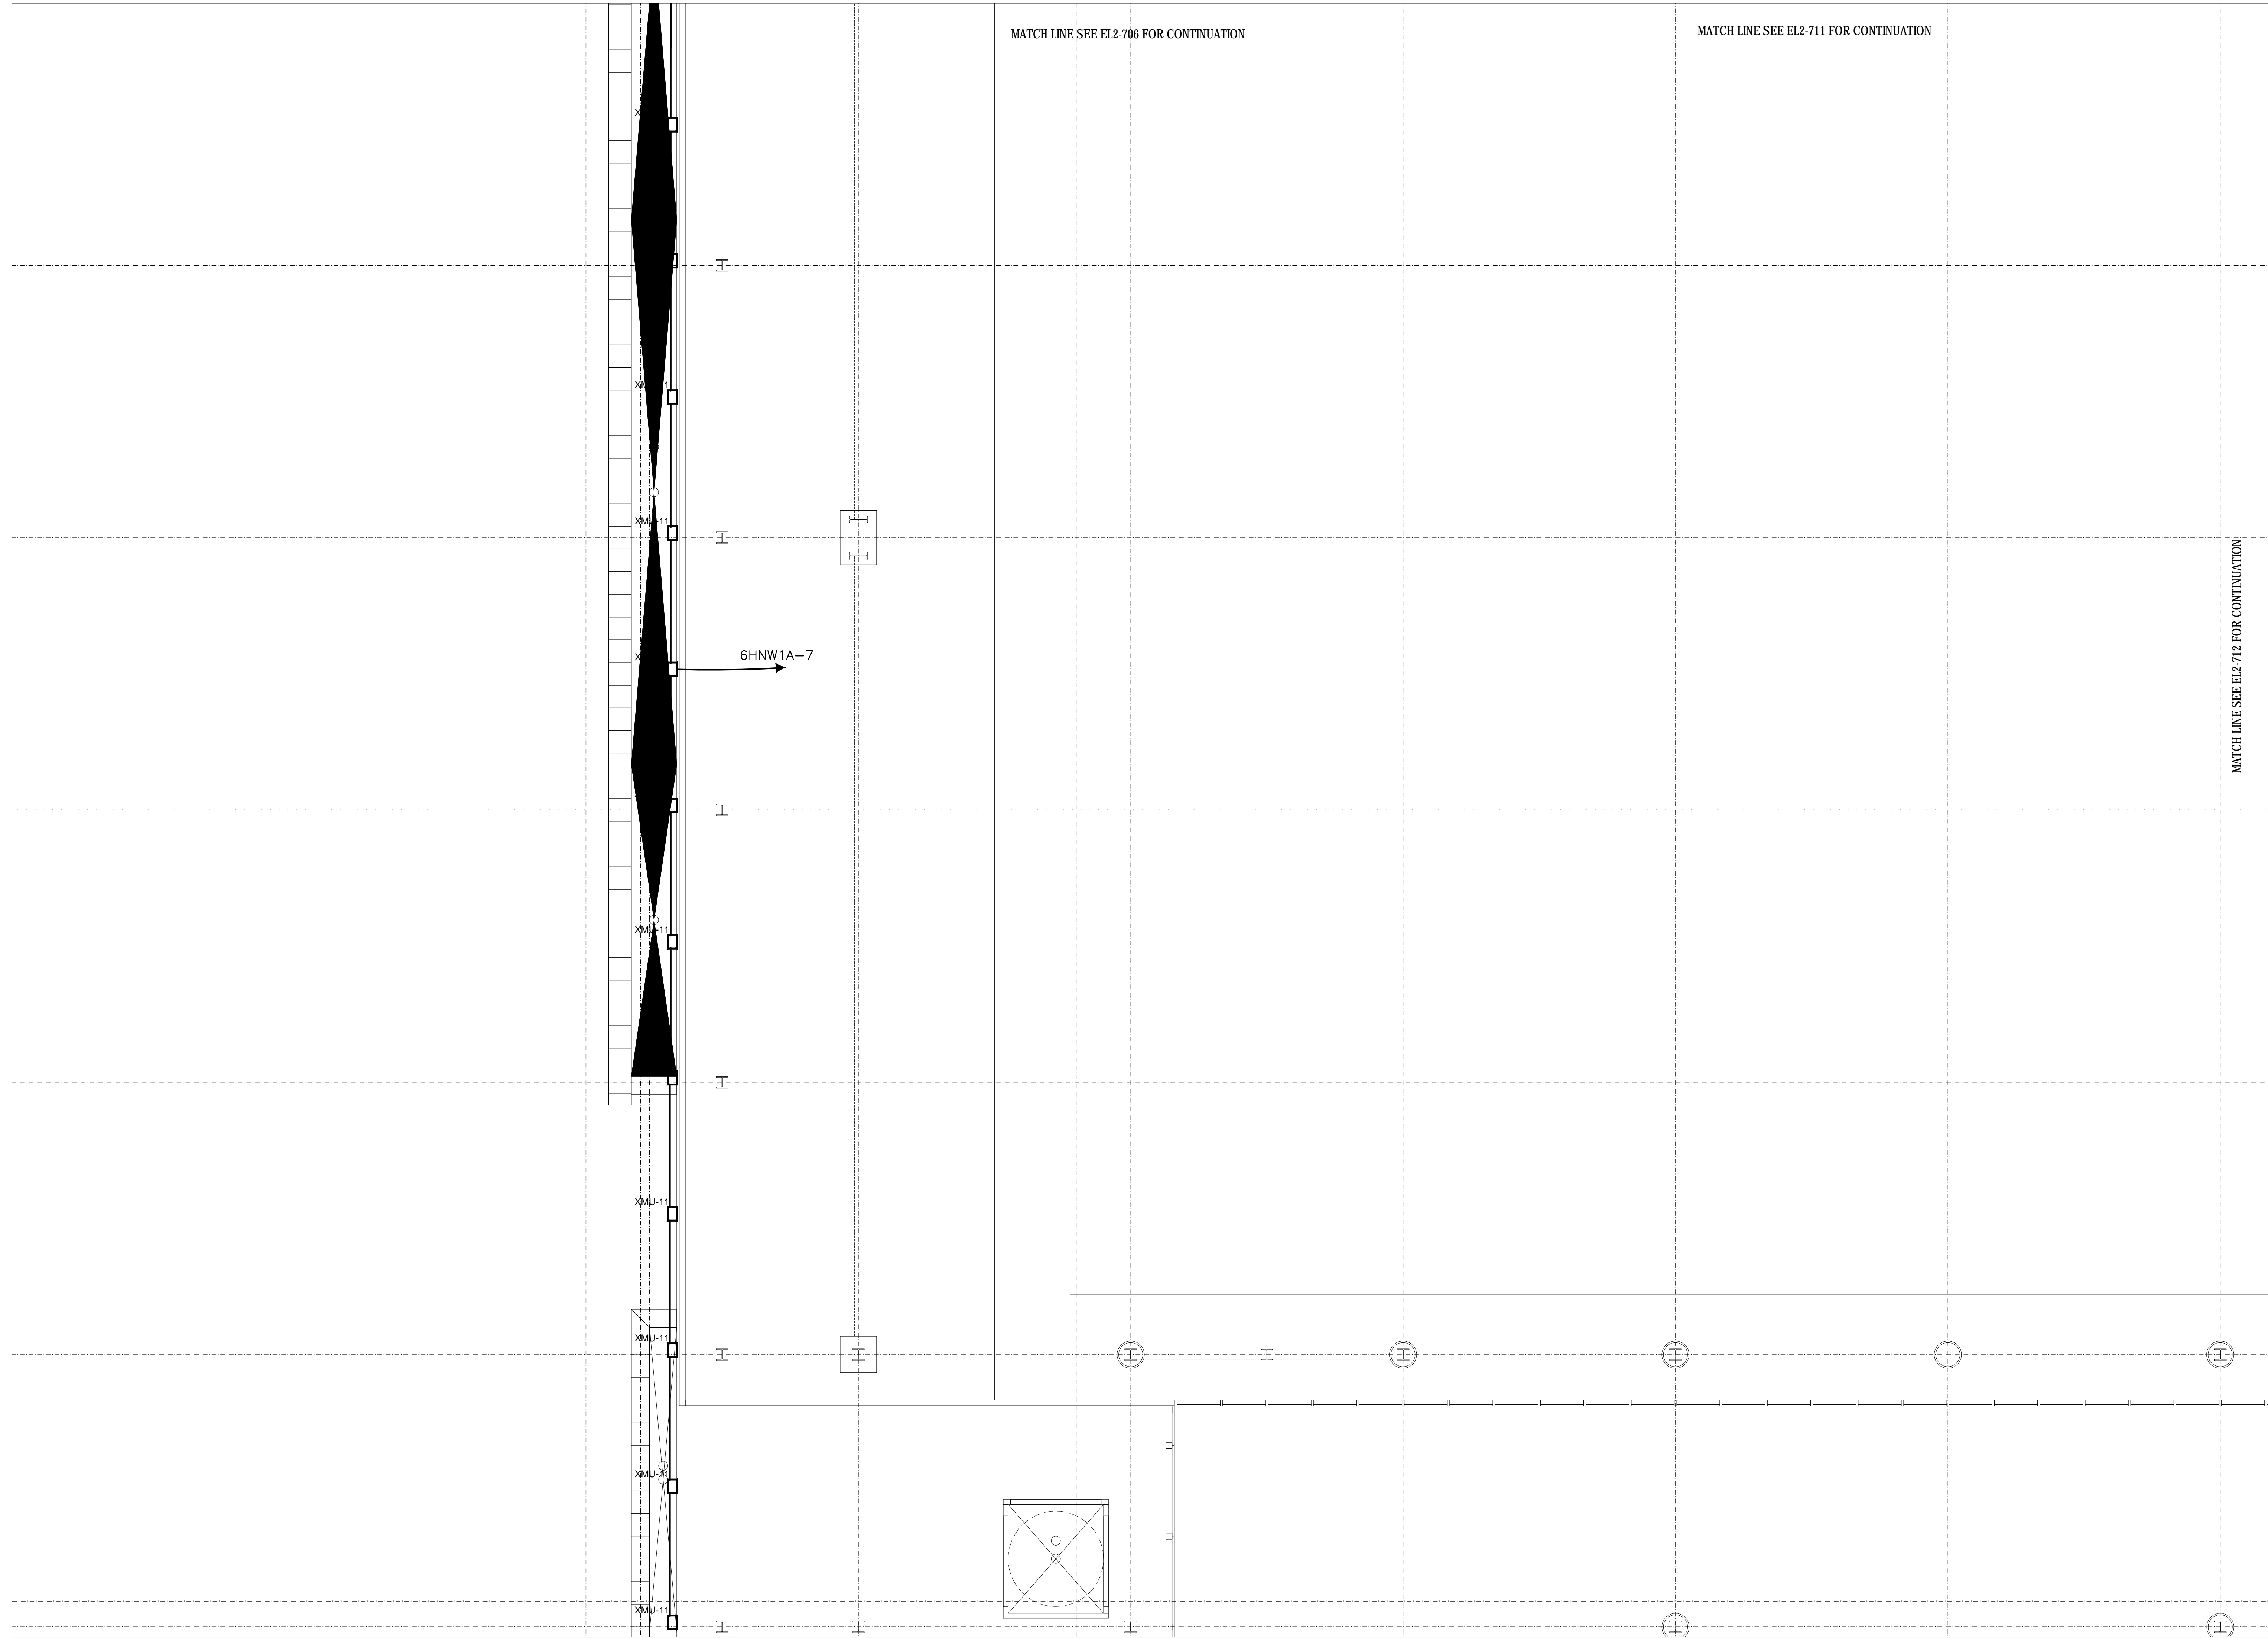


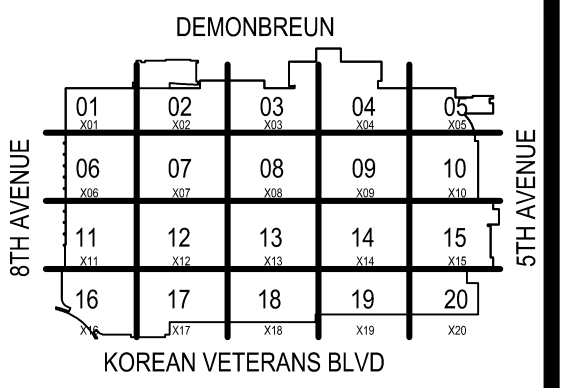

COORDINATION SIGN-OFF

COMPANY	TRADE	DATE
CONTI	ELEC.	/ /
		/ /
		/ /
Music City Center
 Nashville, Tennessee

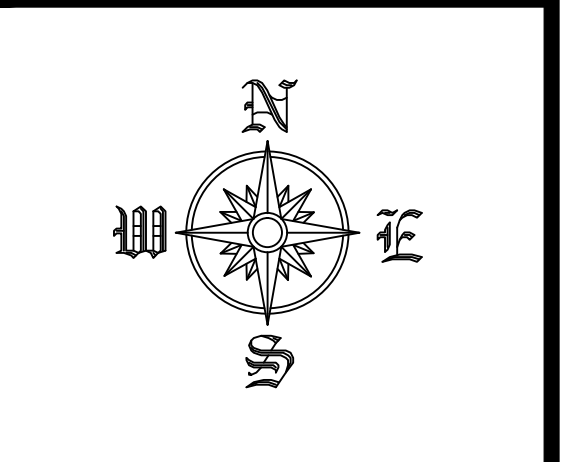

REVISIONS


NO.	DATE	DESCRIPTION

RECORD DRAWINGS STAMP

CONTI ELECTRIC DATE (Last Update):
 2/24/2015 10:59 AM
 DRAWING FILE NAME:
 EL2-714
 CAD OPERATOR:
 GREGGIAN
 PRINTED BY:
 FREDMAN, GREGG
 PLOT DATE:
 6/4/2015 8:18 AM
 SUBMITTED BY:
 GREGG
 ASSIGNED TO:

LEVEL 7 LIGHTING
 ZONE 14
 SCALE: 1/8" = 1'-0"

EL2-714

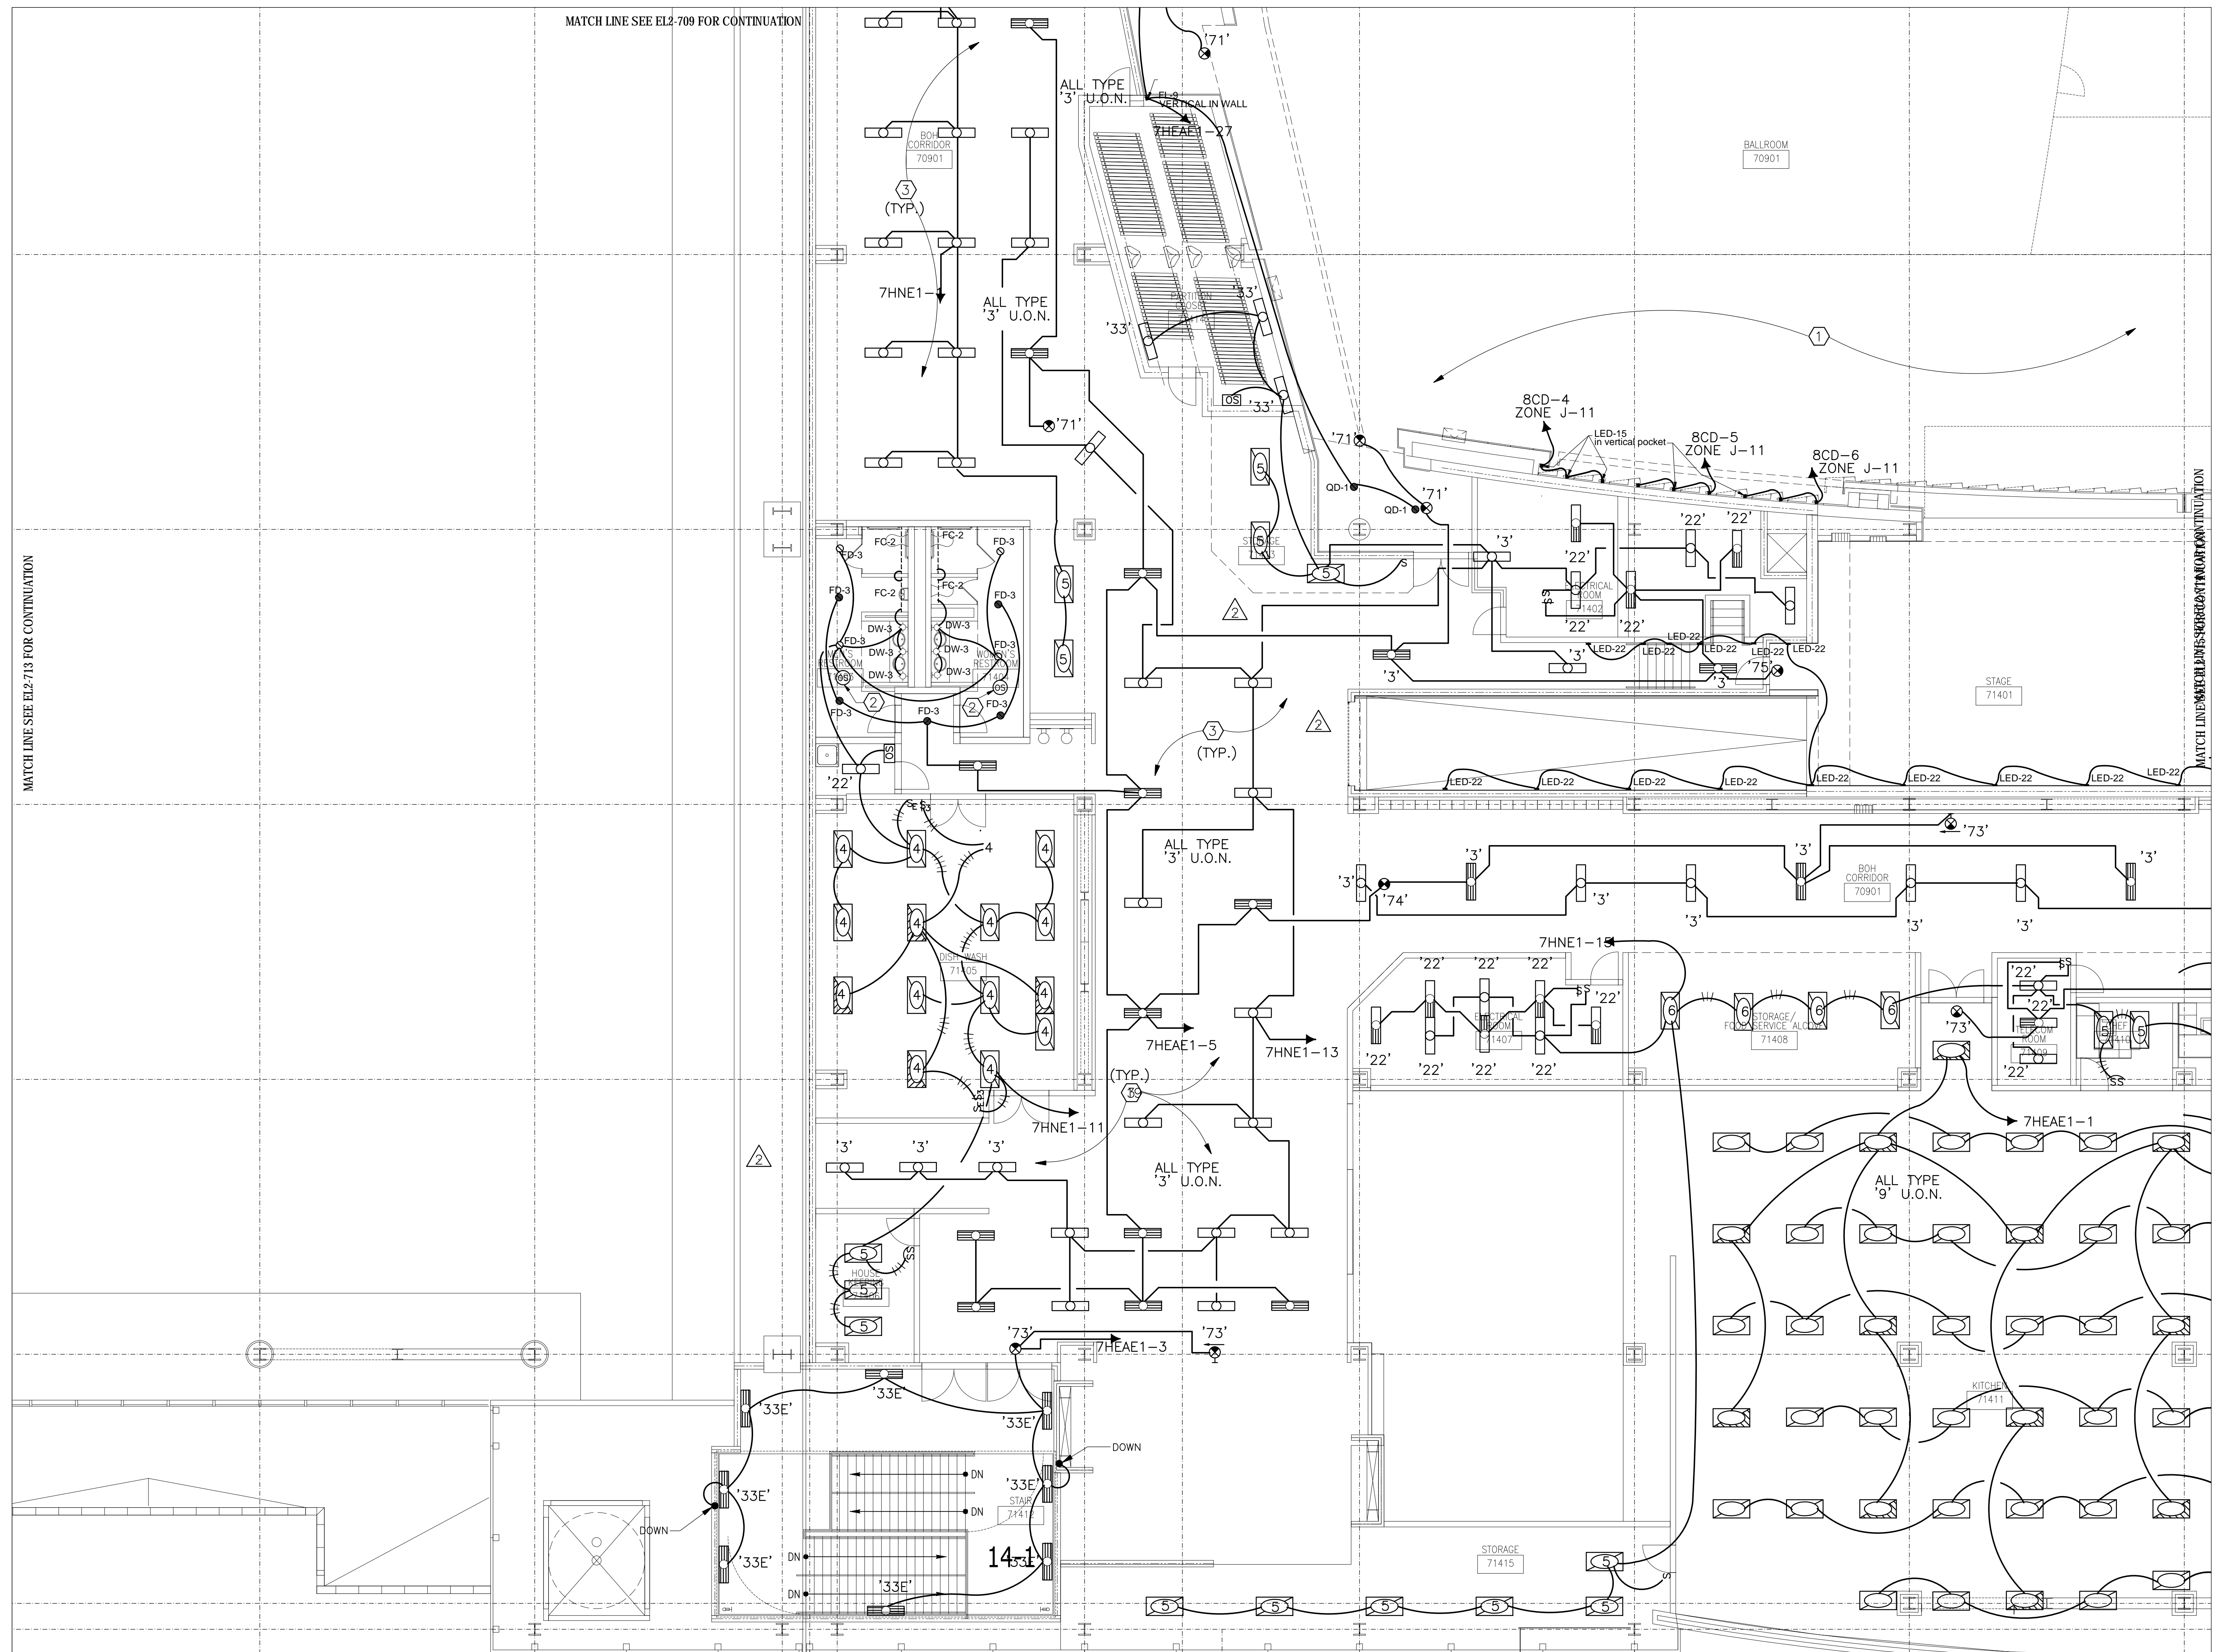


MATCH LINE SEE EL2-713 FOR CONTINUATION

MATCH LINE SEE EL2-709 FOR CONTINUATION

MATCH LINE SEE EL2-715 FOR CONTINUATION


FILE PATH FOR CAD DEPARTMENT USE ONLY - P:\3000\Conti Electric\Projects\Nashville_MusCity\Level 7 Lighting\Zone 14 For Opening.dwg

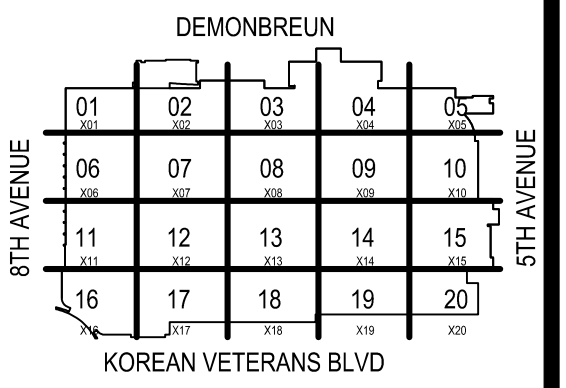

COORDINATION SIGN-OFF

COMPANY	TRADE	DATE
CONTI	ELEC.	/ /
		/ /
		/ /
Music City Center
 Nashville, Tennessee

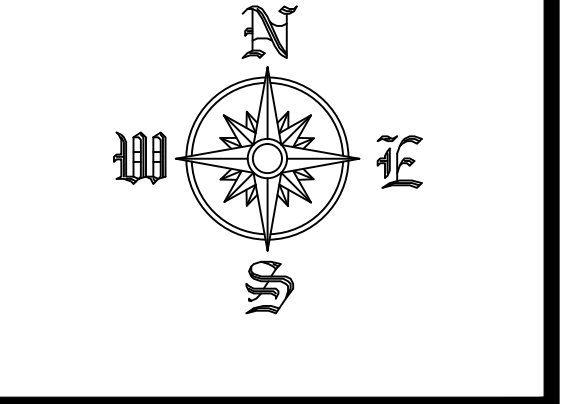

REVISIONS

NO.	DATE	DESCRIPTION

RECORD DRAWINGS STAMP

CONTI ELECTRIC DATE (Last Update):
 2/28/2013 10:59 AM
 DRAWING FILE NAME:
 E2-2-04
 CAD OPERATOR:
 GERTMAN
 PRINTED BY:
 FREYMAN, GREGG
 PLOT DATE:
 6/4/2013 8:18 AM
 SUBMITTED BY:
 G.P.F.
 ASSIGNED TO:

LEVEL 7 LIGHTING
 ZONE 15
 SCALE: 1/8" = 1'-0"

EL2-715

