


COORDINATION SIGN-OFF

COMPANY	TRADE	DATE
CONTI	ELEC.	///
		///
		///
**Music City Center**  
 Nashville, Tennessee

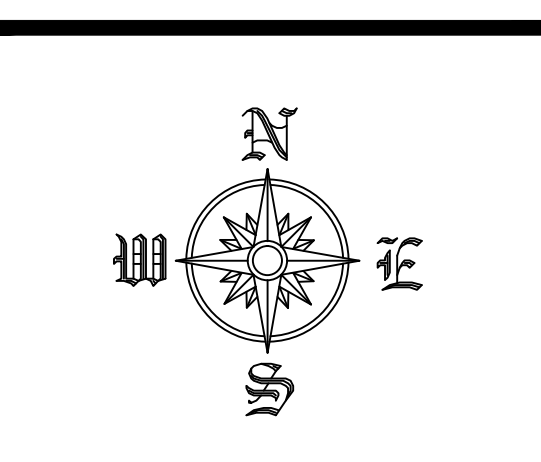

REVISIONS

NO.	DATE	DESCRIPTION

RECORD DRAWINGS STAMP

CONTI ELECTRIC DATE (Last Update):  
 2/21/2012 10:22 AM

DRAWING FILE NAME:  
 EL2-804


CAD OPERATOR:  
 GERRITMAN

PRINTED BY:  
 FREDMAN, GREGG

PLOT DATE:  
 2/21/2012 10:22 AM

SUBMITTED BY:  
 G.L.P.


ASSIGNED TO:

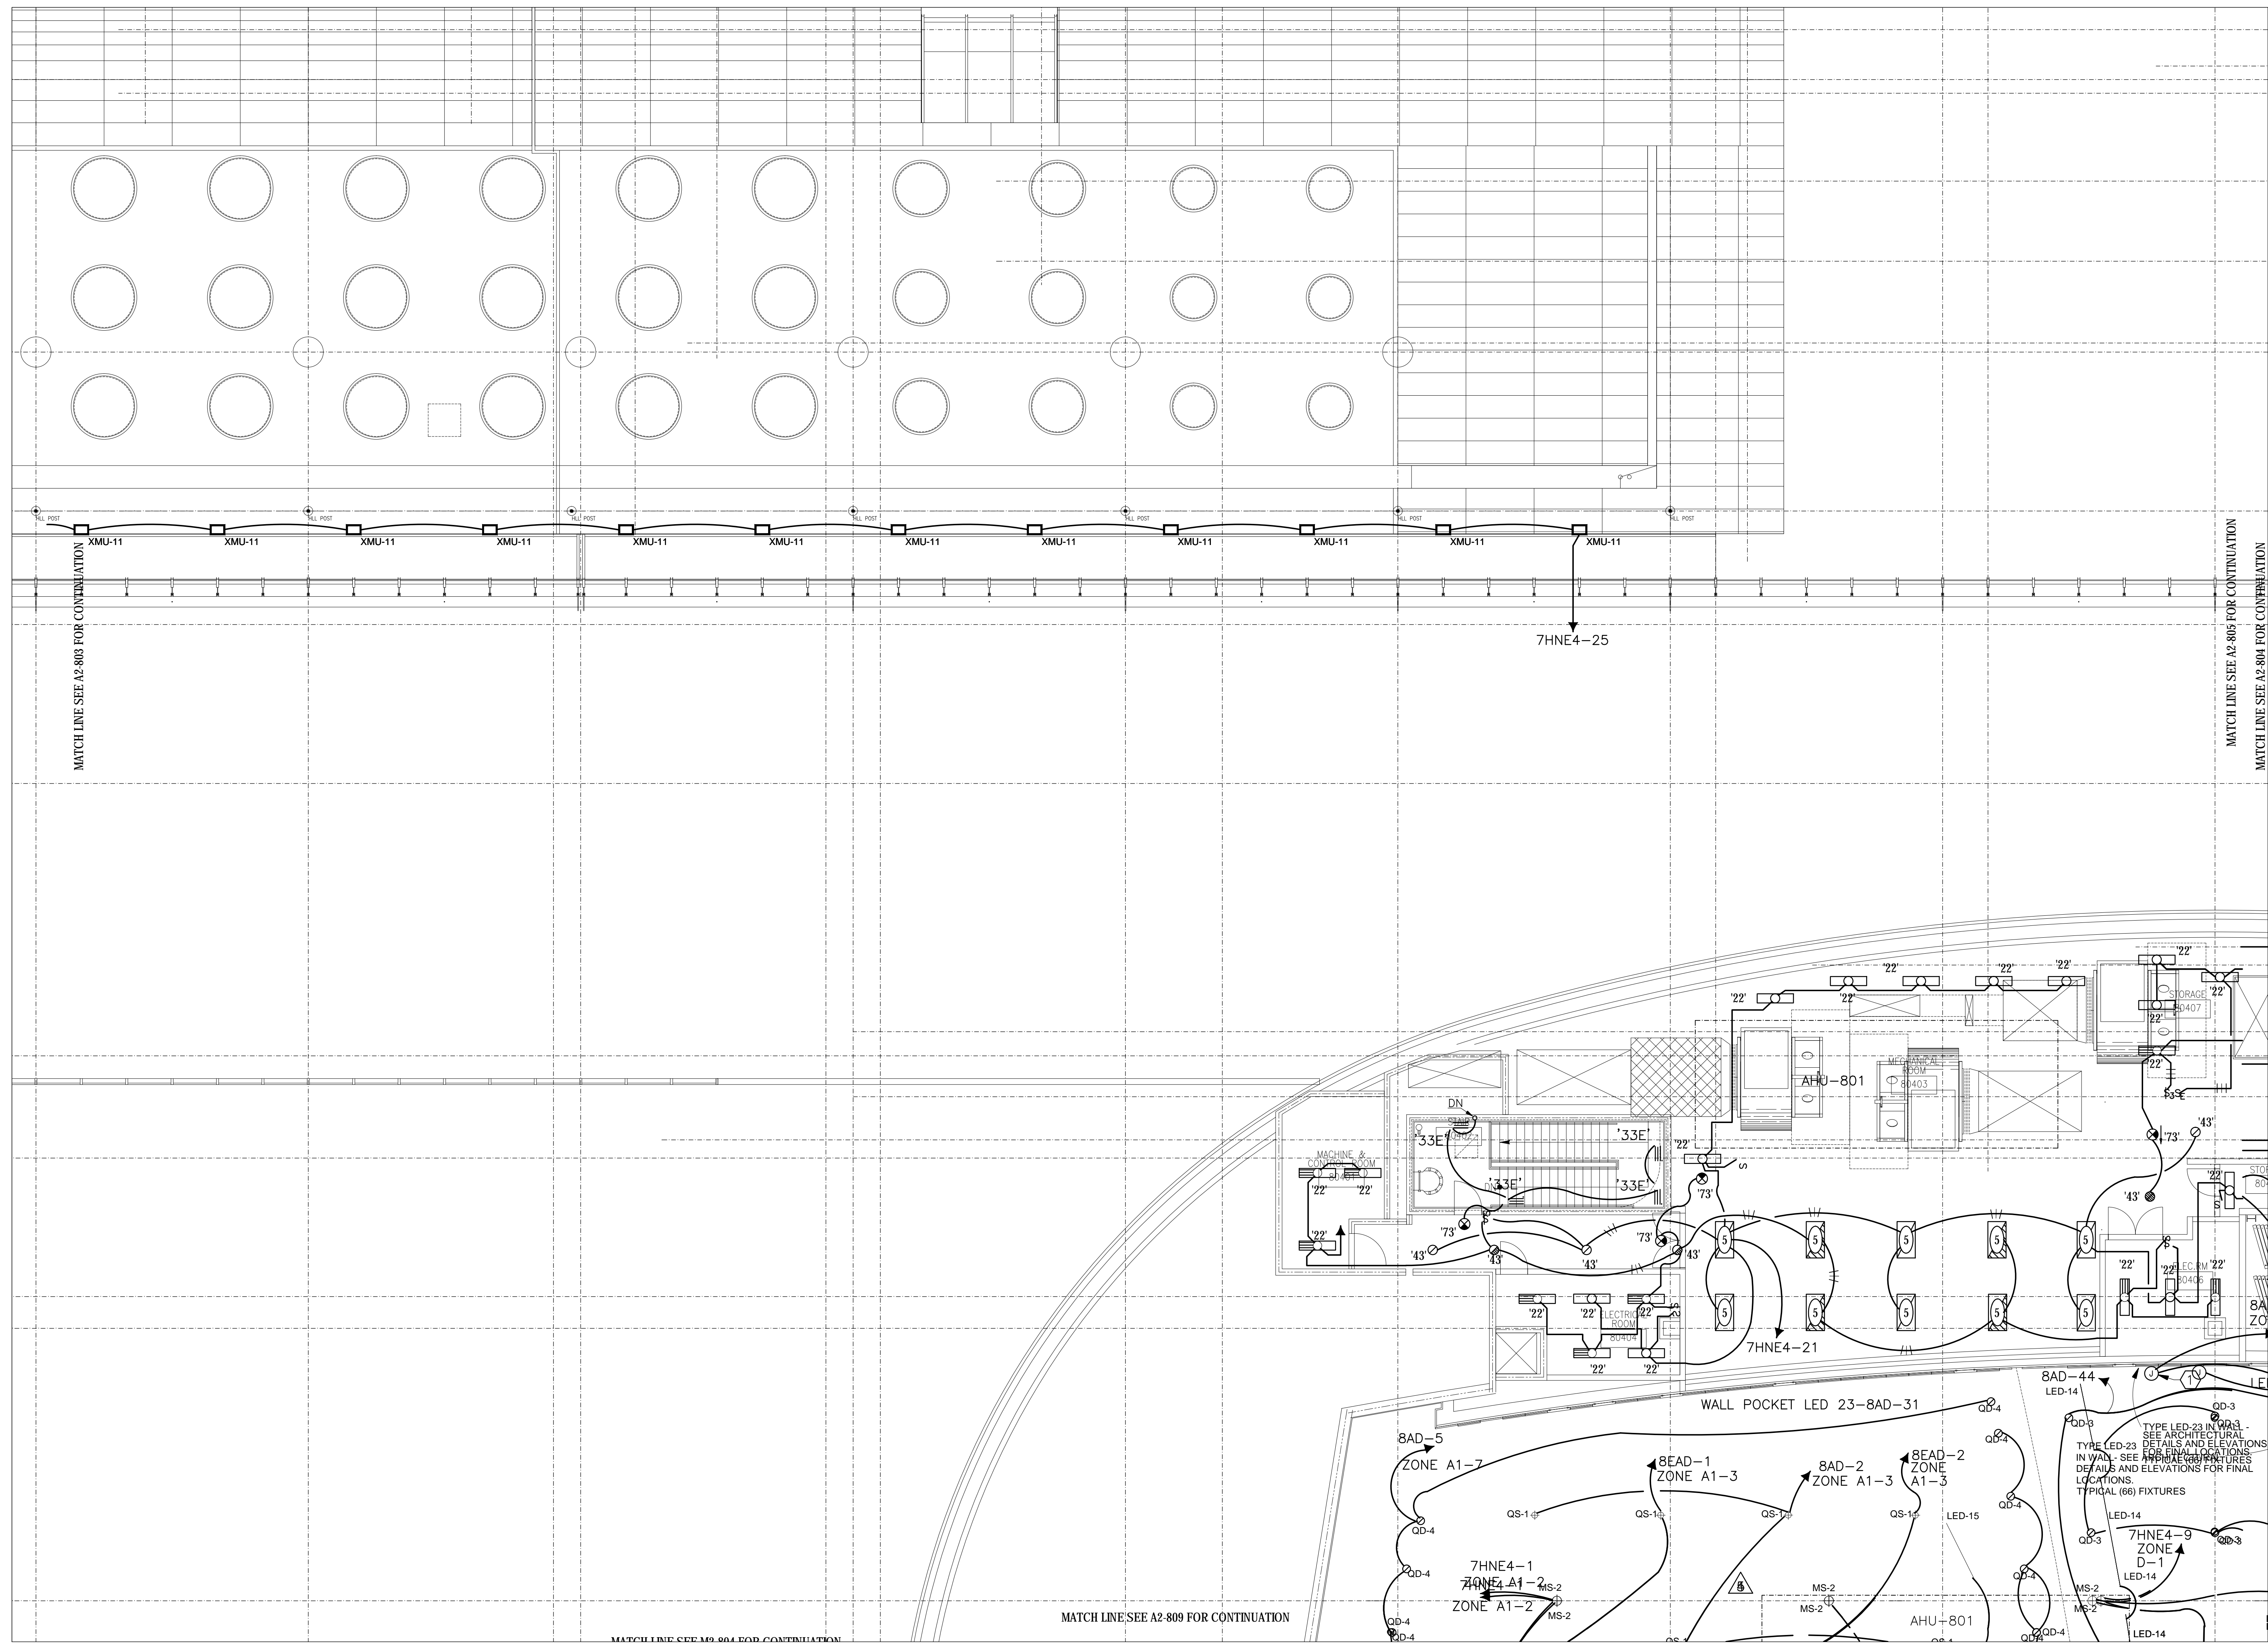

LEVEL 8 LIGHTING  
 ZONE 04  
 SCALE: 1/8" = 1'-0"


EL2-804

FILE PATH FOR CAD OPERATOR USE ONLY: P:\2012\Conti\Electric\Nashville\_MusicCity\_Center\_Arch\Bldg 4\EL2\Lighting\Zone 04 Lighting\_Schedule\_For\_Owner.rvt

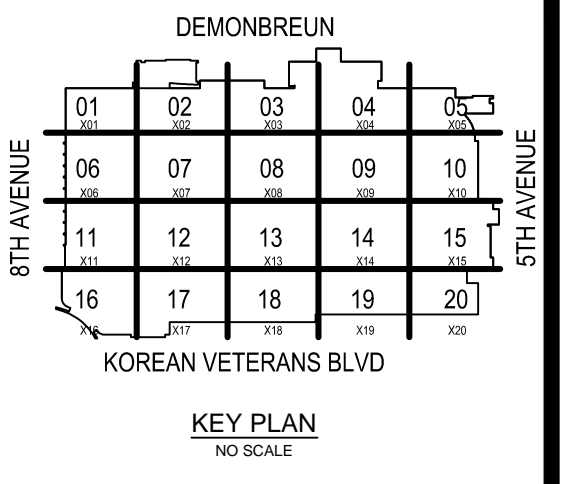

COORDINATION SIGN-OFF		DATE	NAME	TRADE
COMPANY	CONTI	/ /		ELEC.
		/ /		
		/ /		
**Music City Center**  
 Nashville, Tennessee

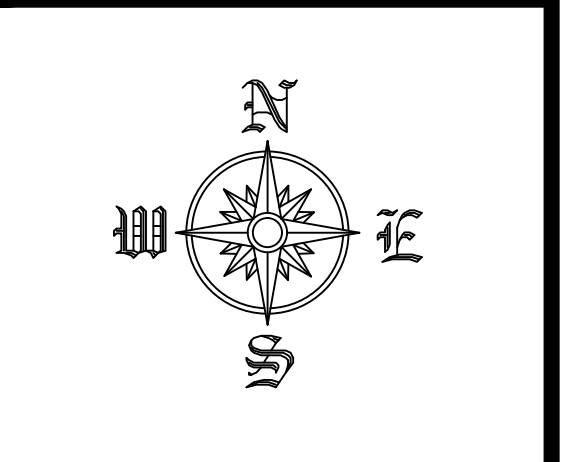


REVISIONS		
NO.	DATE	DESCRIPTION

**RECORD DRAWINGS STAMP**


CONTELECTRIC DATE (last Update):  
 2/21/2012 10:22 AM  
 DRAWING FILE NAME:  
 EL2-805  
 CAD OPERATOR:  
 GERRITAN  
 PRINTED BY:  
 FREDIAN GREGG  
 PLOT DATE:  
 2/21/2012 10:22 AM  
 SUBMITTED BY:  
 G.P.  
 ASSIGNED TO:

LEVEL 8 LIGHTING  
 ZONE 05  
 SCALE: 1/8" = 1'-0"

EL2-805

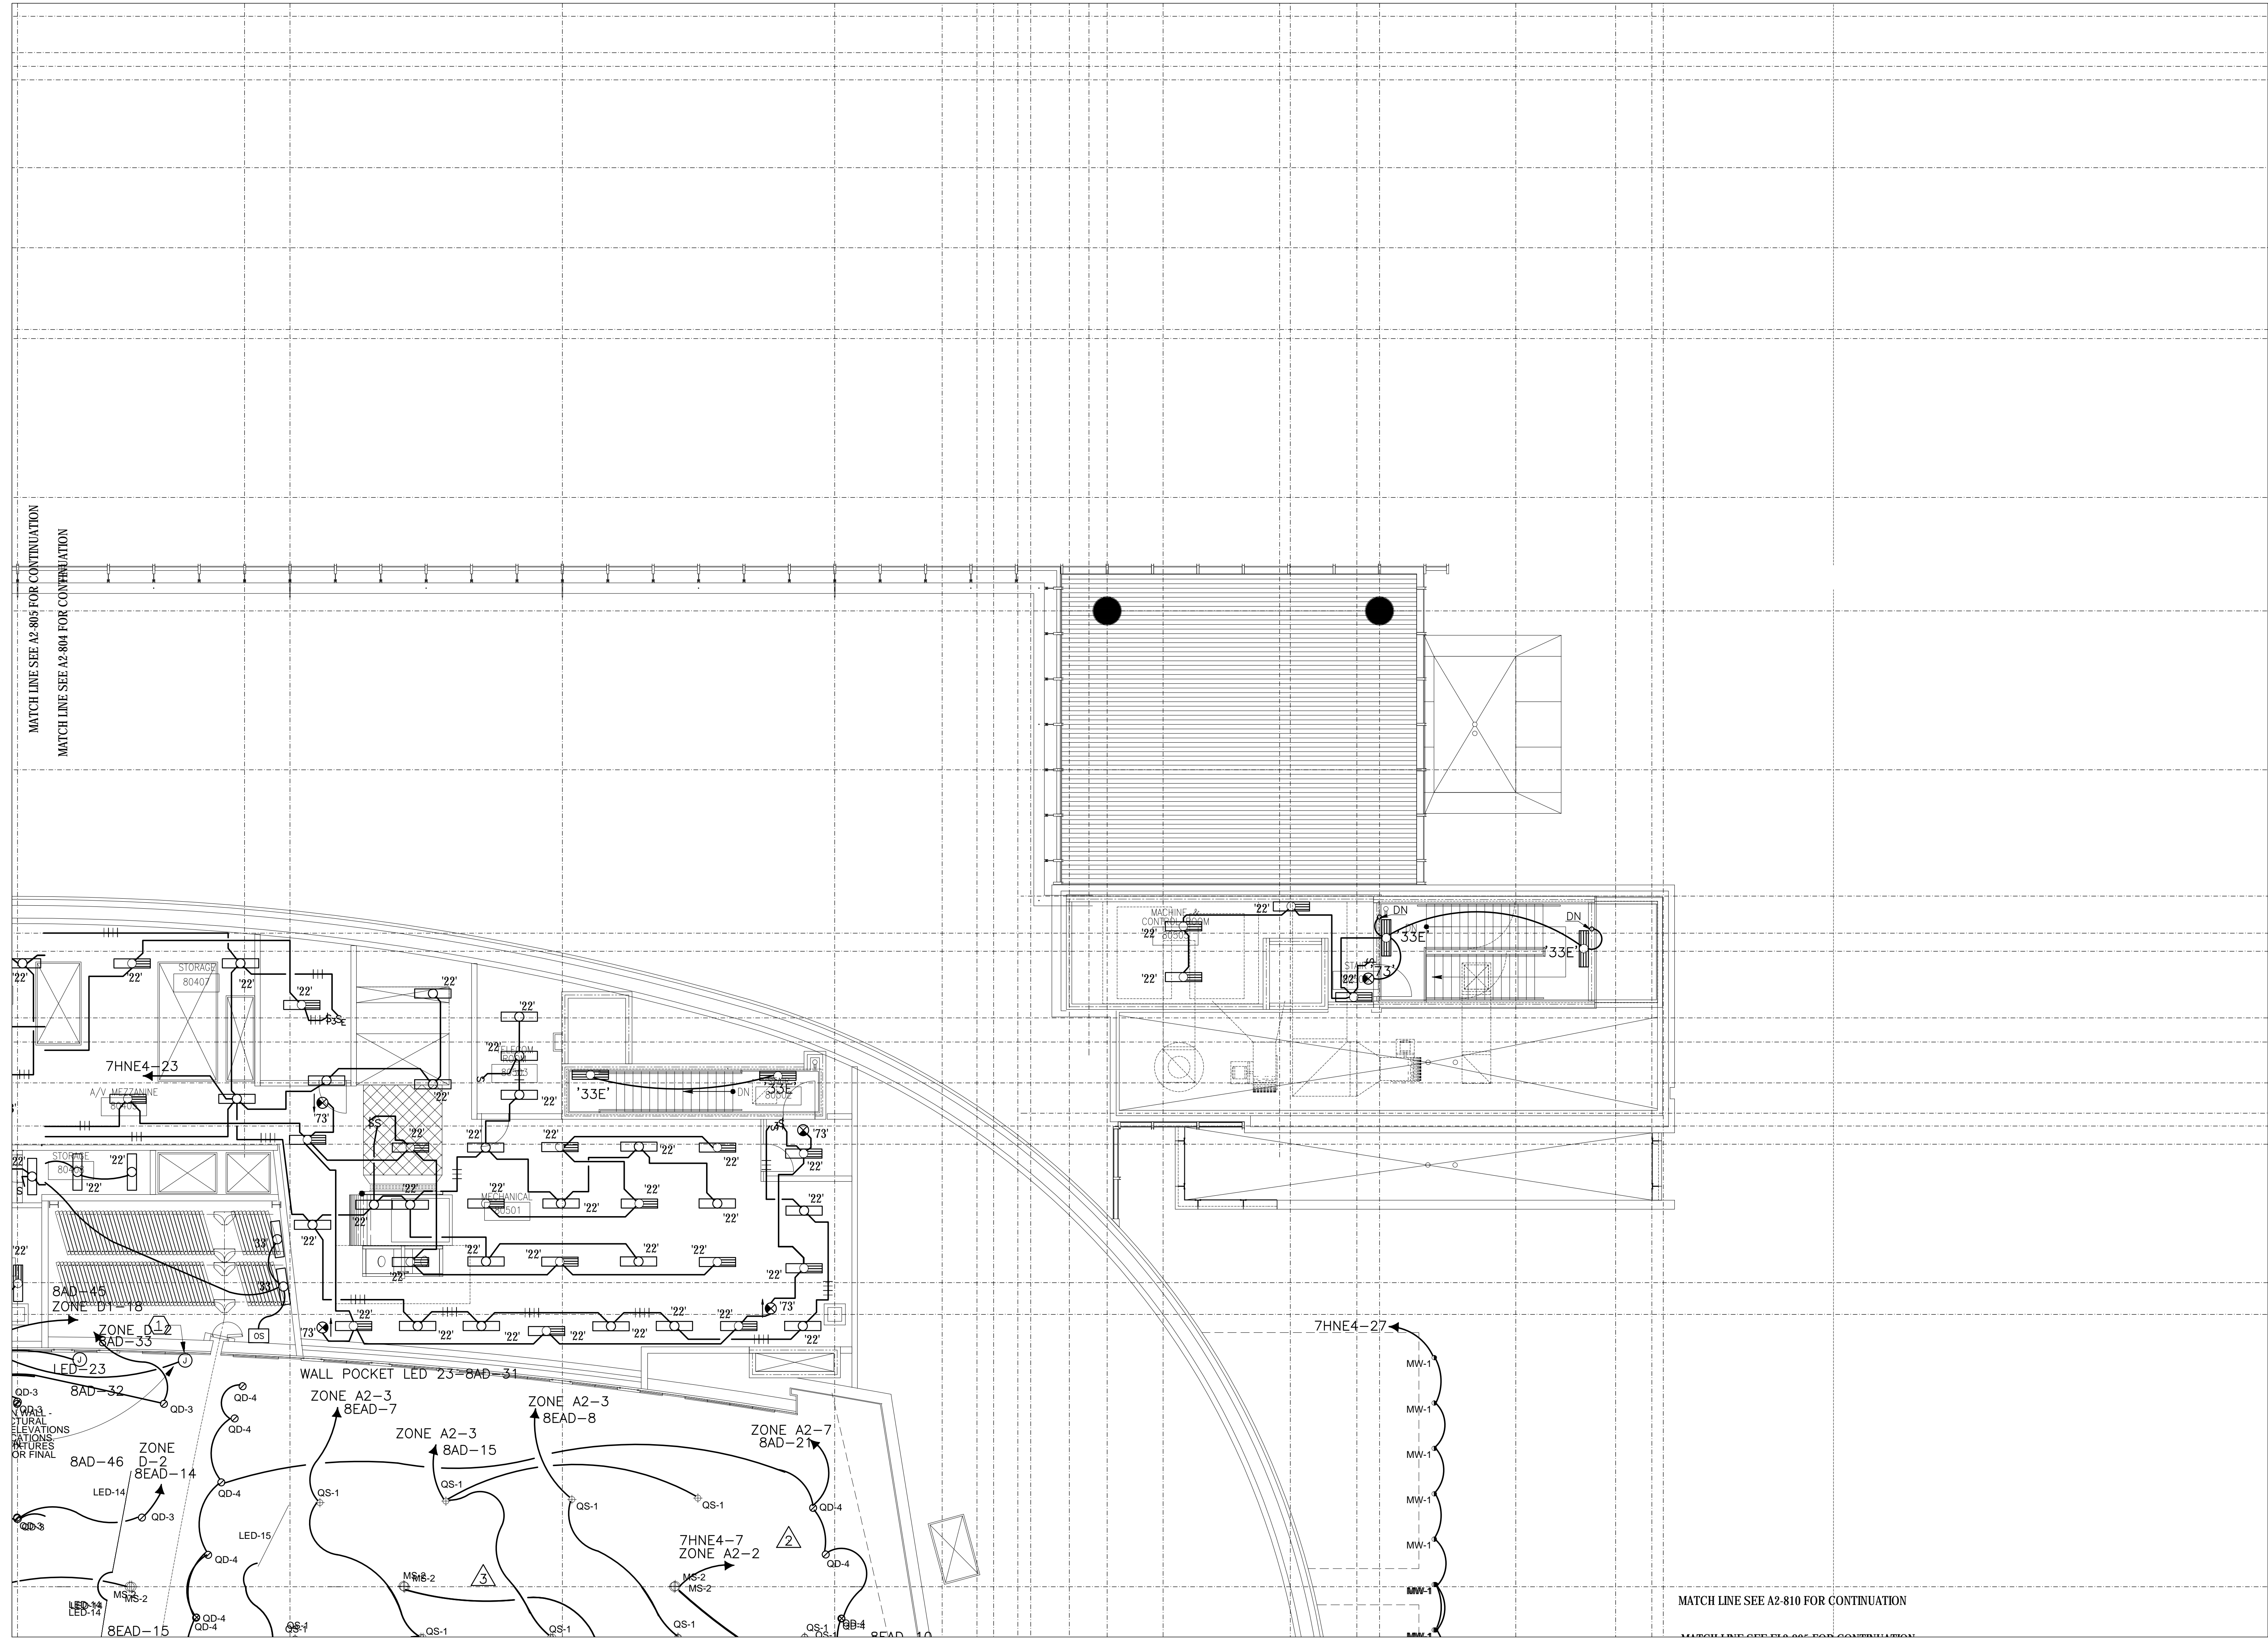


FILE PATH FOR CAD DEPARTMENT USE ONLY: C:\Users\Gerritan\OneDrive\My Documents\City Center\As-Built\4-13-12\Level 8 Lighting\Zone 05 For Opening.dwg

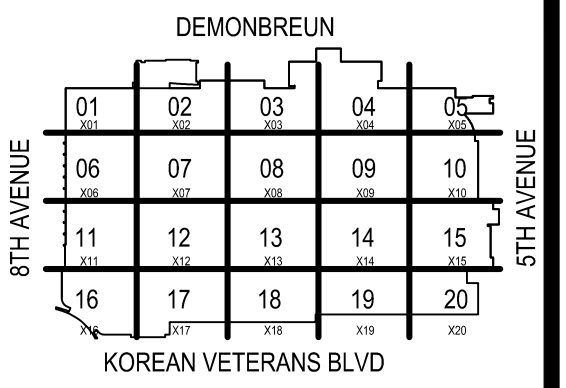

COORDINATION SIGN-OFF

COMPANY	TRADE	DATE
CONTI	ELEC.	/ /
		/ /
		/ /
**Music City Center**  
 Nashville, Tennessee

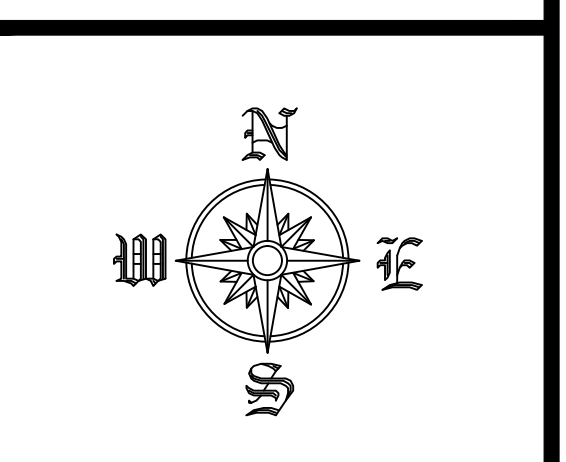

REVISIONS


NO.	DATE	DESCRIPTION

RECORD DRAWINGS STAMP

CONTELECTRIC DATE (Last Update): 2/21/2012 10:22 AM  
 DRAWING FILE NAME: E2-204  
 CAD OPERATOR: SHERMAN  
 PRINTED BY: FREDMAN, GREGG  
 PLOT DATE: 2/21/2012 10:22 AM  
 SUBMITTED BY: G.P.F.  
 ASSIGNED TO:

LEVEL 8 LIGHTING  
 ZONE 9  
 SCALE: 1/8" = 1'-0"

EL2-809

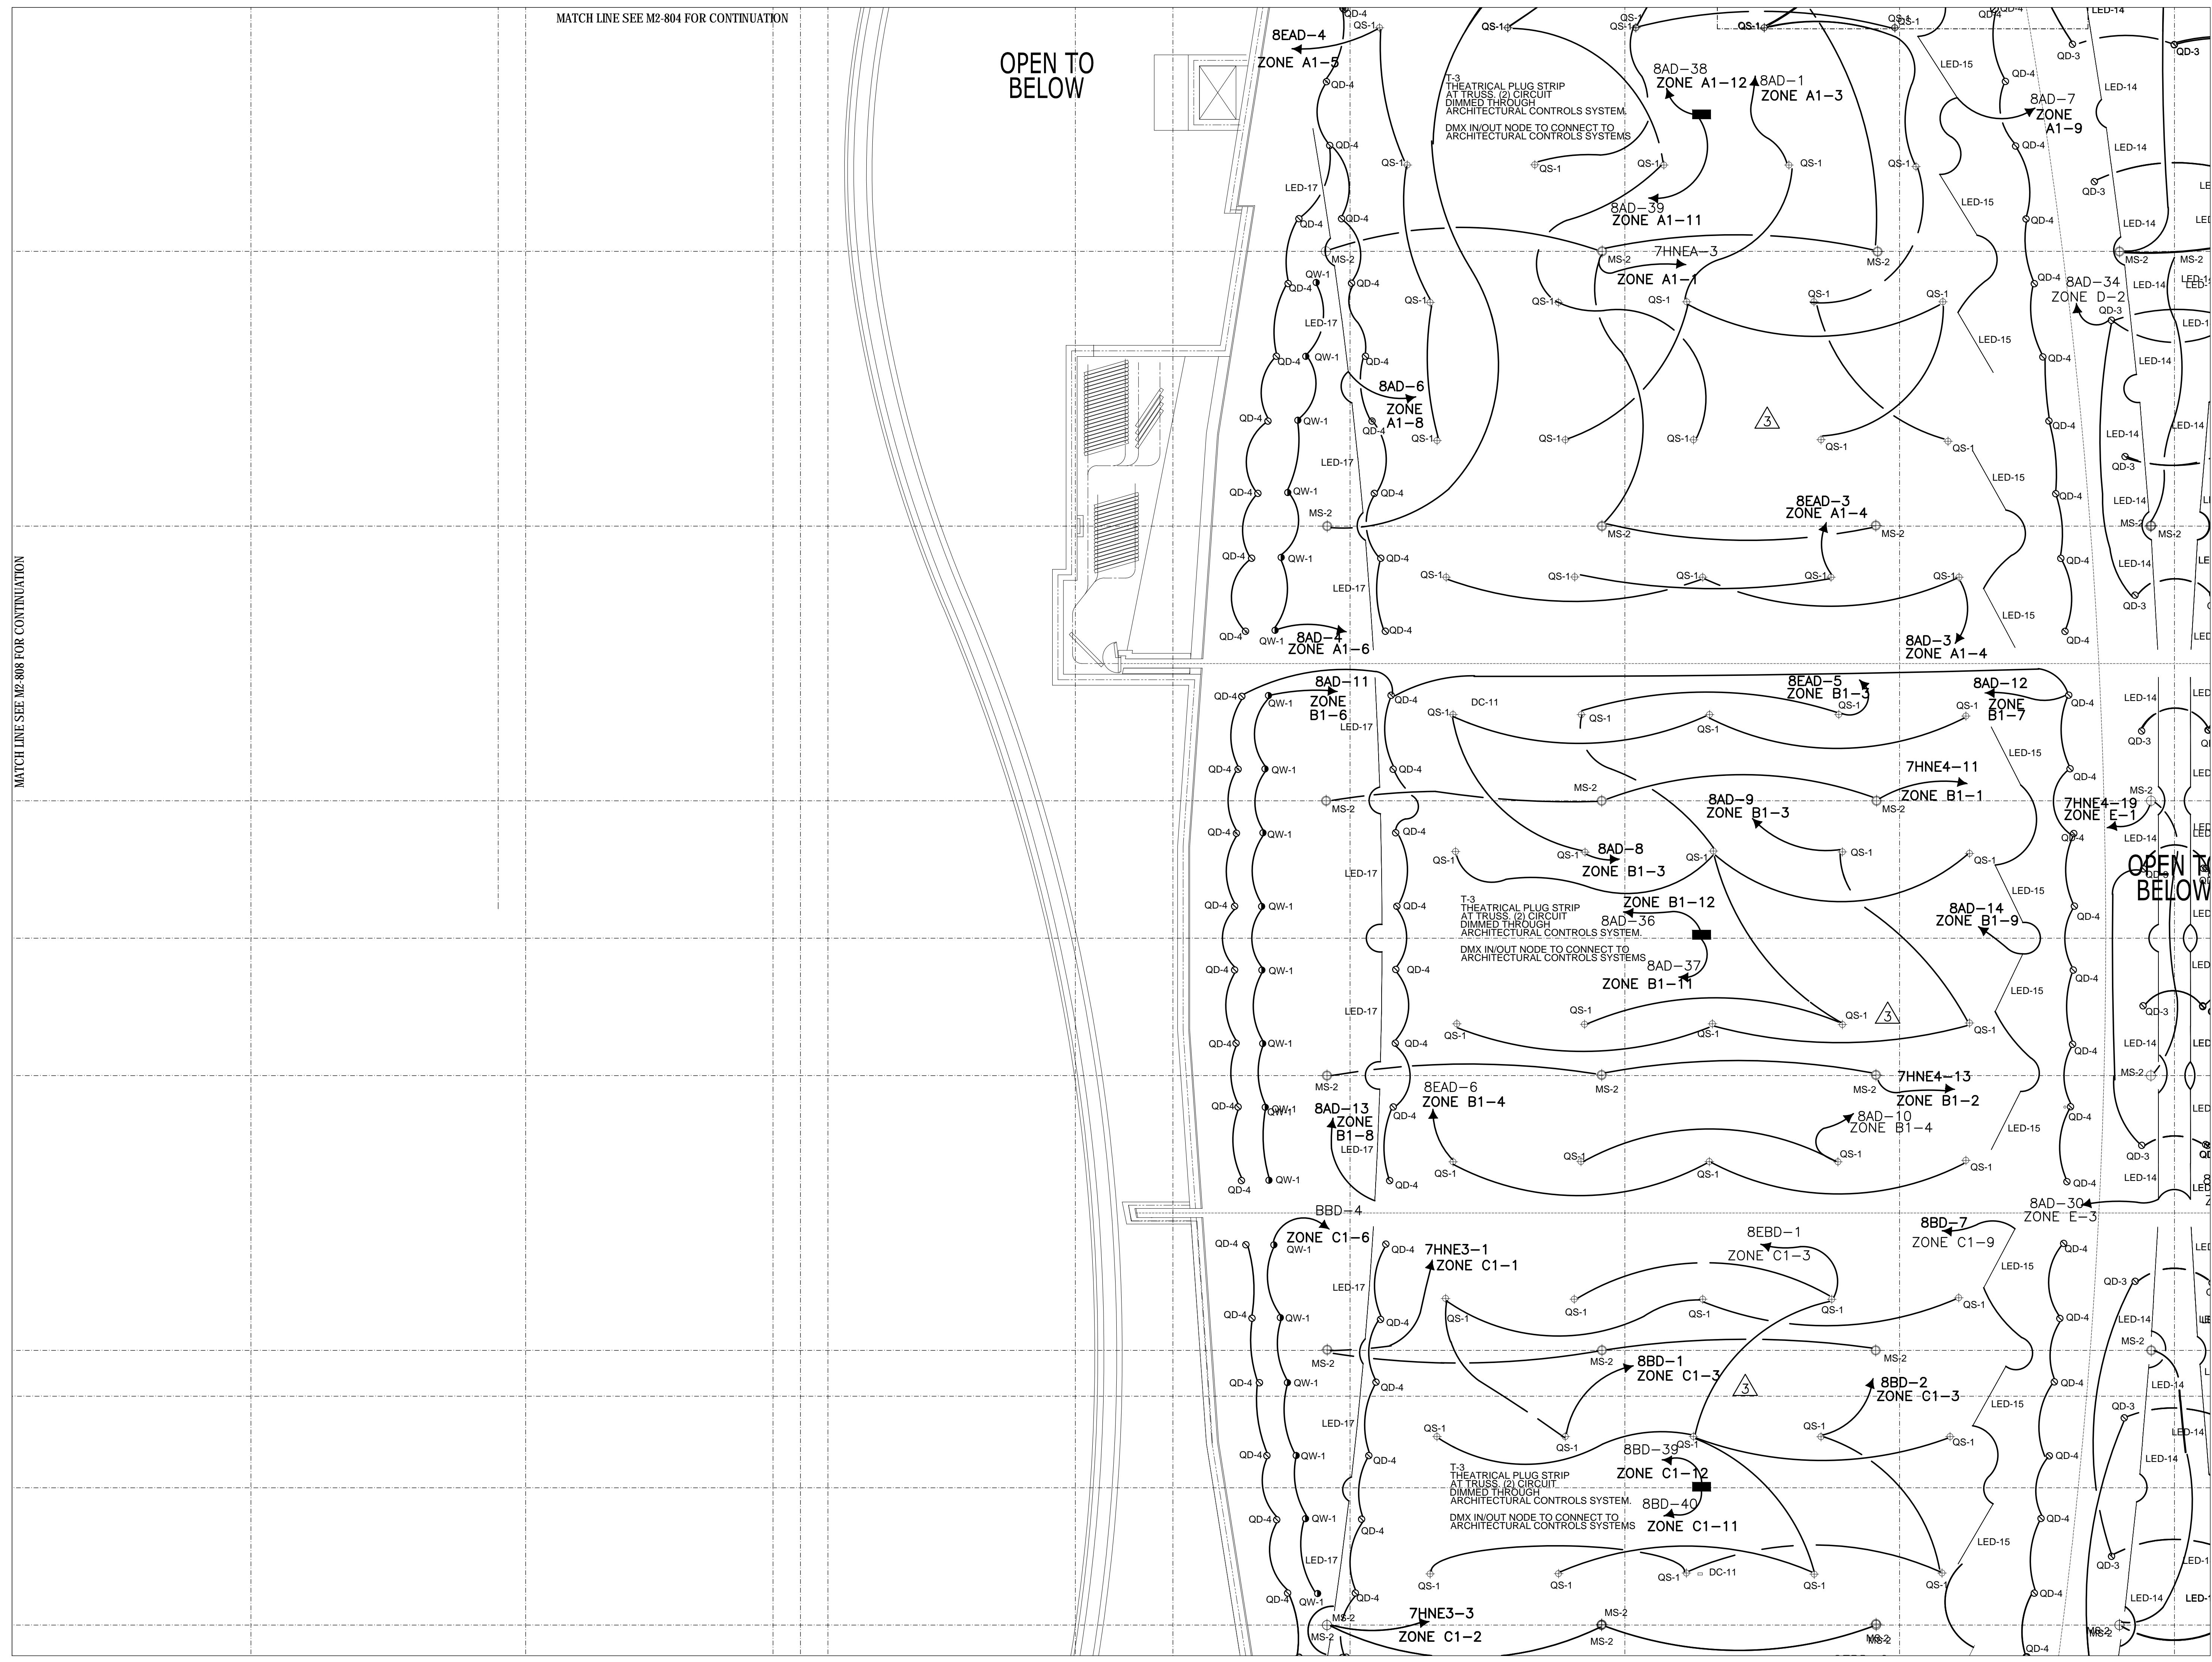


OPEN TO BELOW

OPEN TO BELOW

MATCH LINE SEE M2-808 FOR CONTINUATION


MATCH LINE SEE M2-804 FOR CONTINUATION

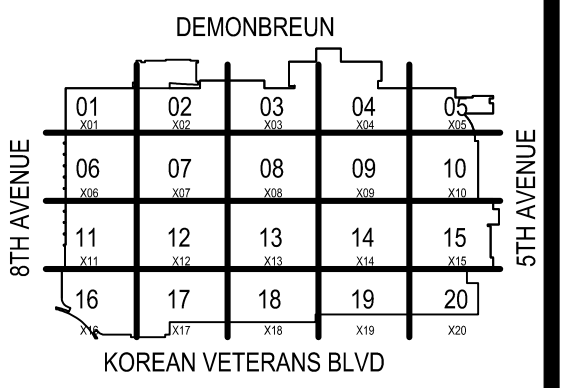

COORDINATION SIGN-OFF

COMPANY	TRADE	DATE
CONTI	ELEC.	///
		///
		///
**Music City Center**  
 Nashville, Tennessee

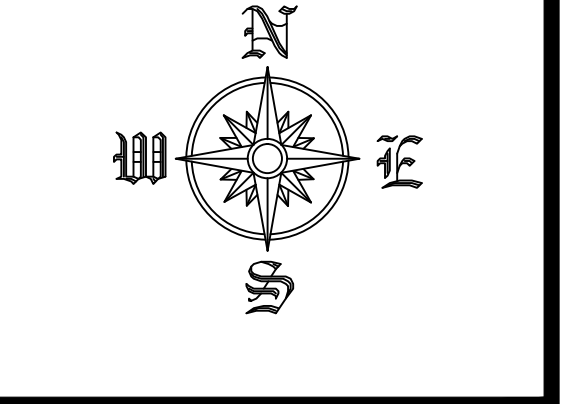


REVISIONS


NO.	DATE	DESCRIPTION

**RECORD DRAWINGS STAMP**

CONTELECTRIC DATE (Last Update):  
 2/21/2012 10:22 AM  
 DRAWING FILE NAME:  
 EL2-810  
 CAD OPERATOR:  
 GERTMAN  
 PRINTED BY:  
 FREDMAN, GREGG  
 PLOT DATE:  
 2/21/2012 10:22 AM  
 SUBMITTED BY:  
 G.P.  
 ASSIGNED TO:

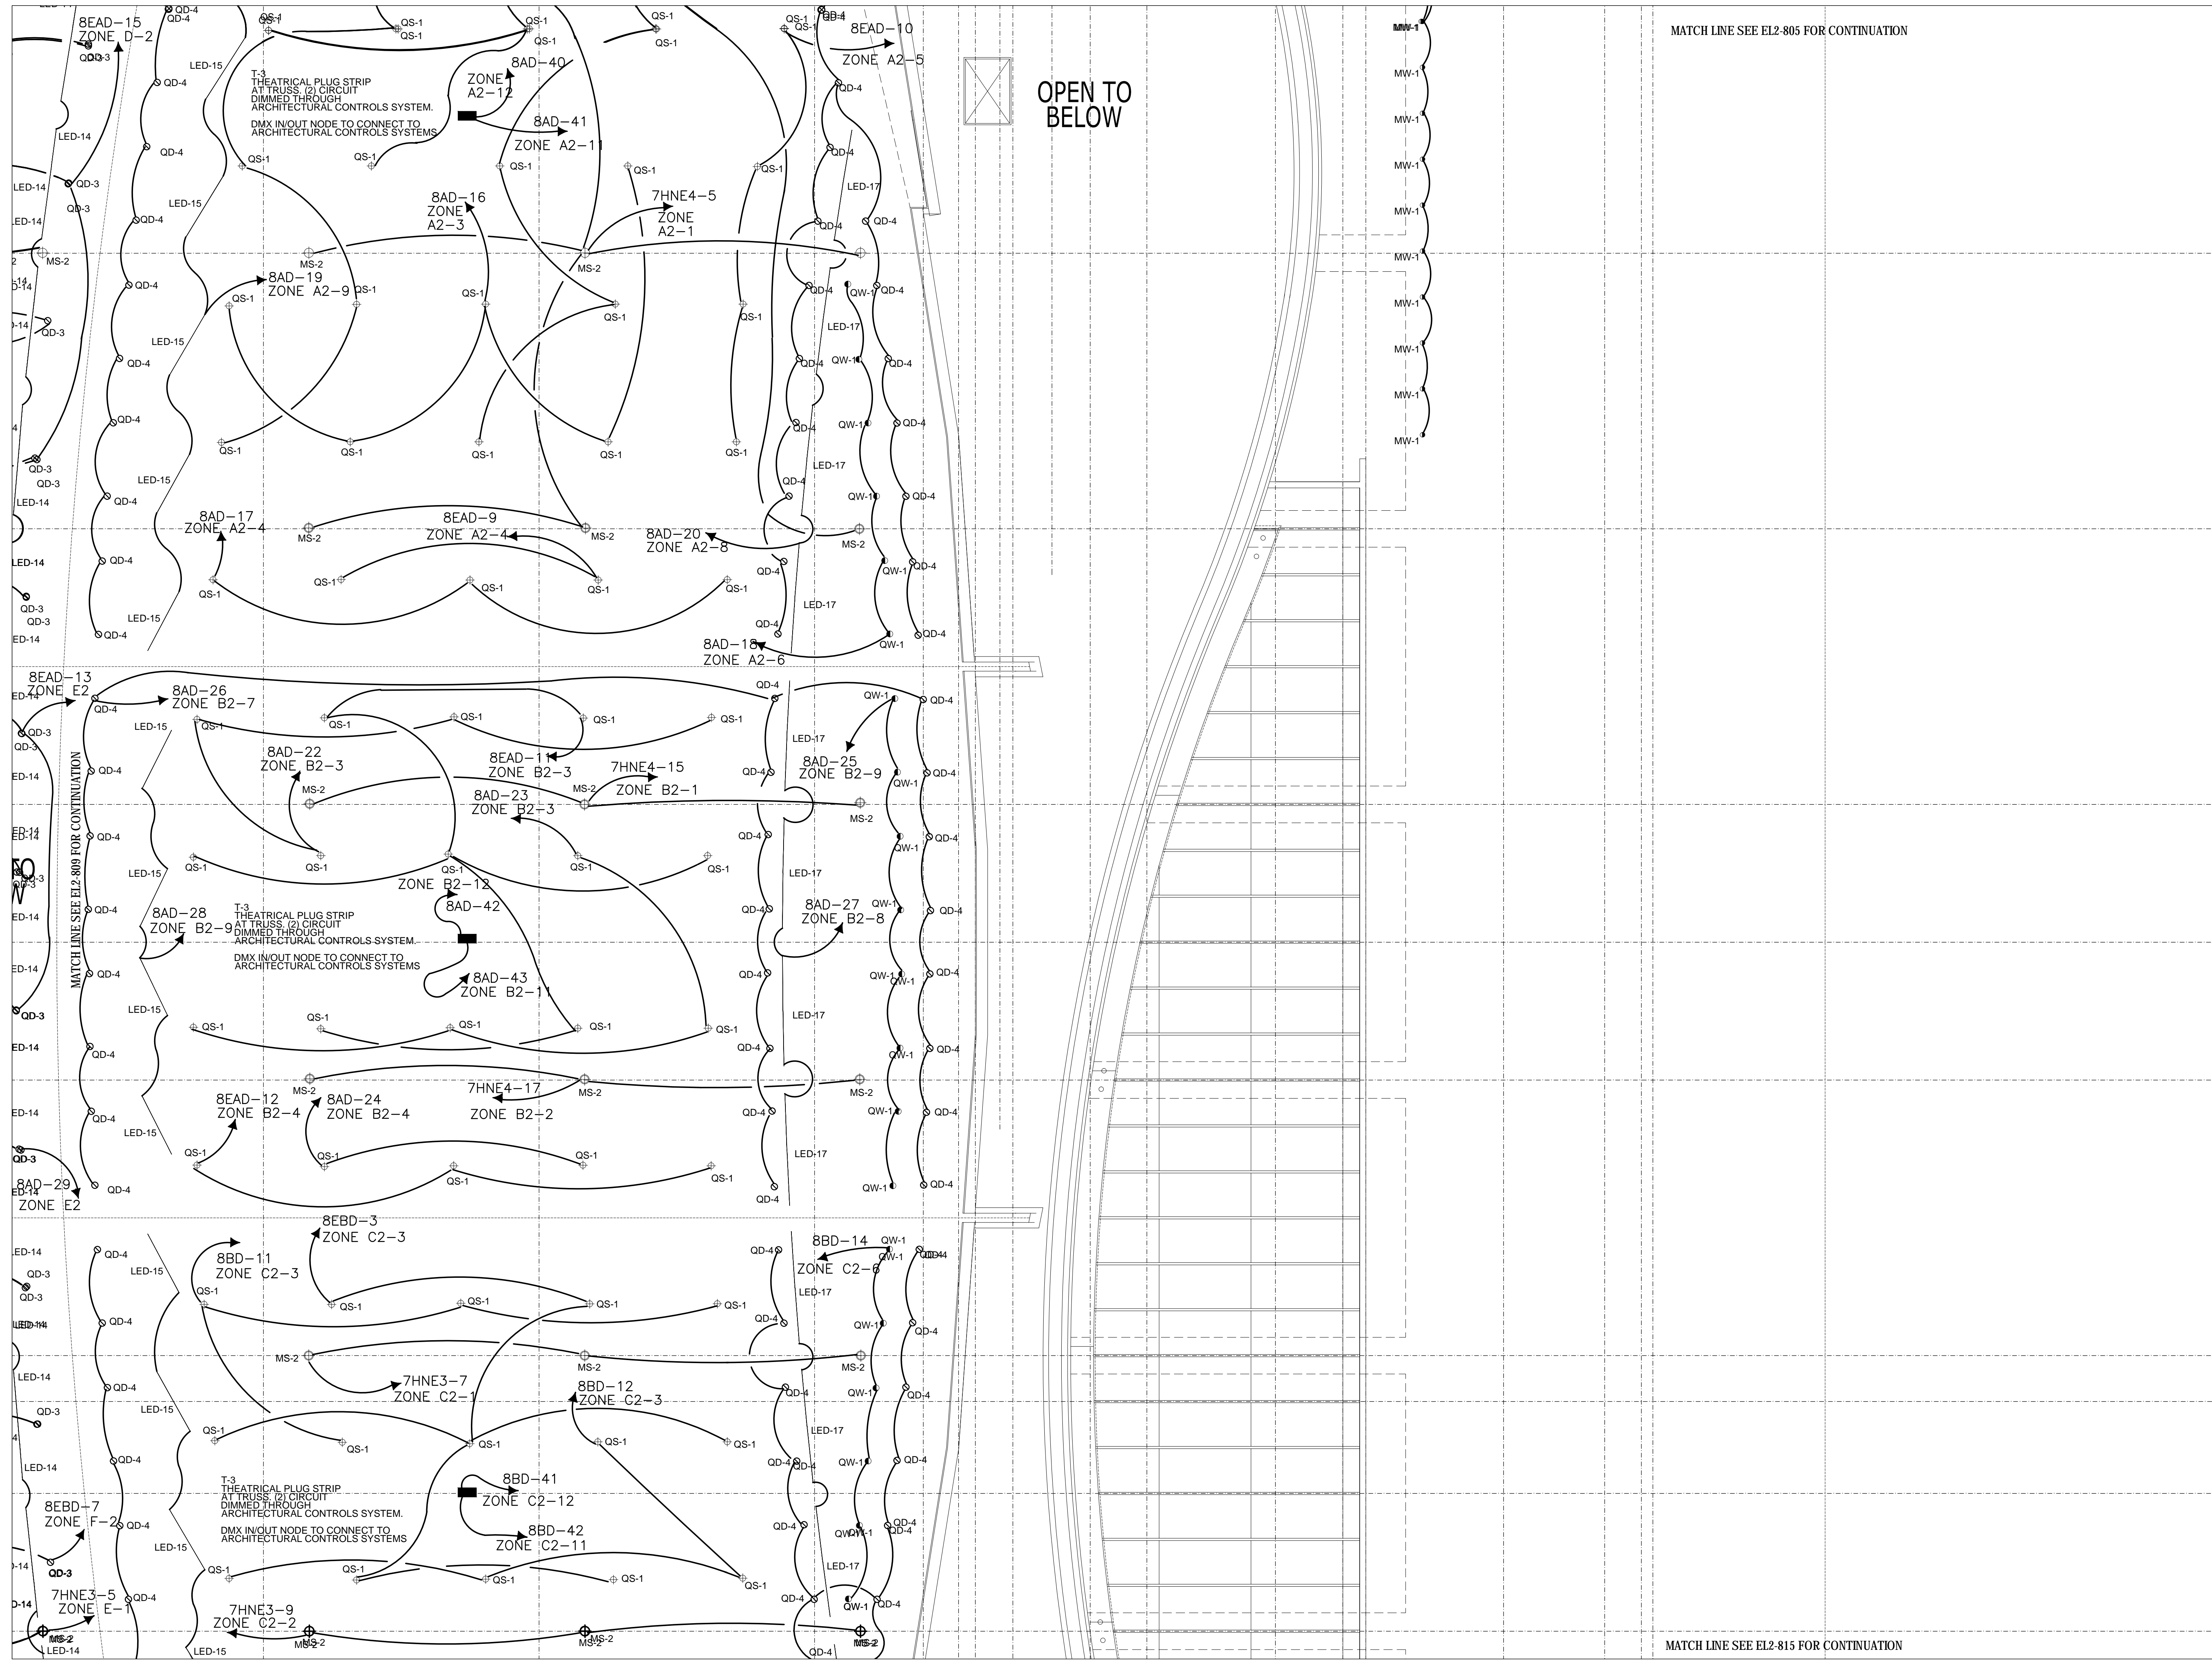


LEVEL 8 LIGHTING  
 ZONE 10  
 SCALE: 1/8" = 1'-0"

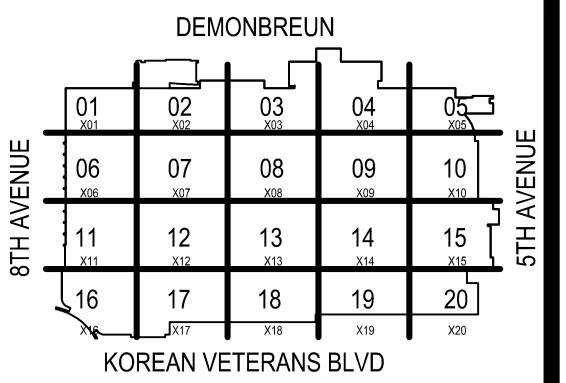

KEY PLAN  
 1/8" = 1'-0"

COORDINATION SIGN-OFF	
DATE	/ /
NAME	/ /
TRADE	/ /
ELEC.	/ /
COMPANY	/ /
CONTI	/ /

**Music City Center**  
 Nashville, Tennessee

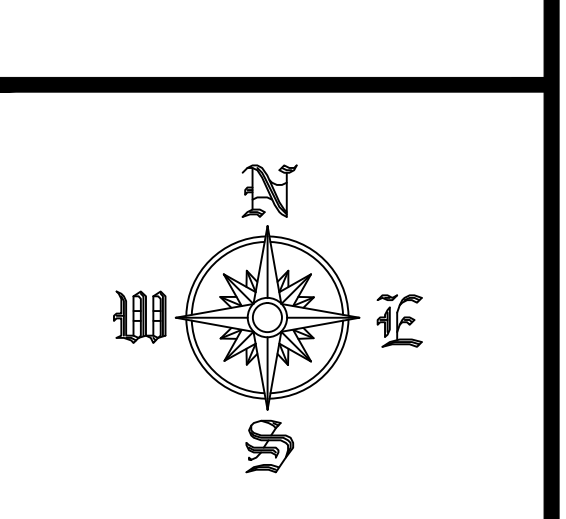


REVISIONS		
NO.	DATE	DESCRIPTION

**RECORD DRAWINGS STAMP**

CONTI ELECTRIC DATE (Last Update):  
 2/21/2012 10:22 AM  
 DRAWING FILE NAME:  
 EL2-814  
 CAD OPERATOR:  
 GEMMAN  
 PRINTED BY:  
 FREDMAN, GREGG  
 PLOT DATE:  
 2/21/2012 10:22 AM  
 SUBMITTED BY:  
 G.L.P.  
 ASSIGNED TO:

LEVEL 8 LIGHTING  
 ZONE 14  
 SCALE: 1/8" = 1'-0"

EL2-814

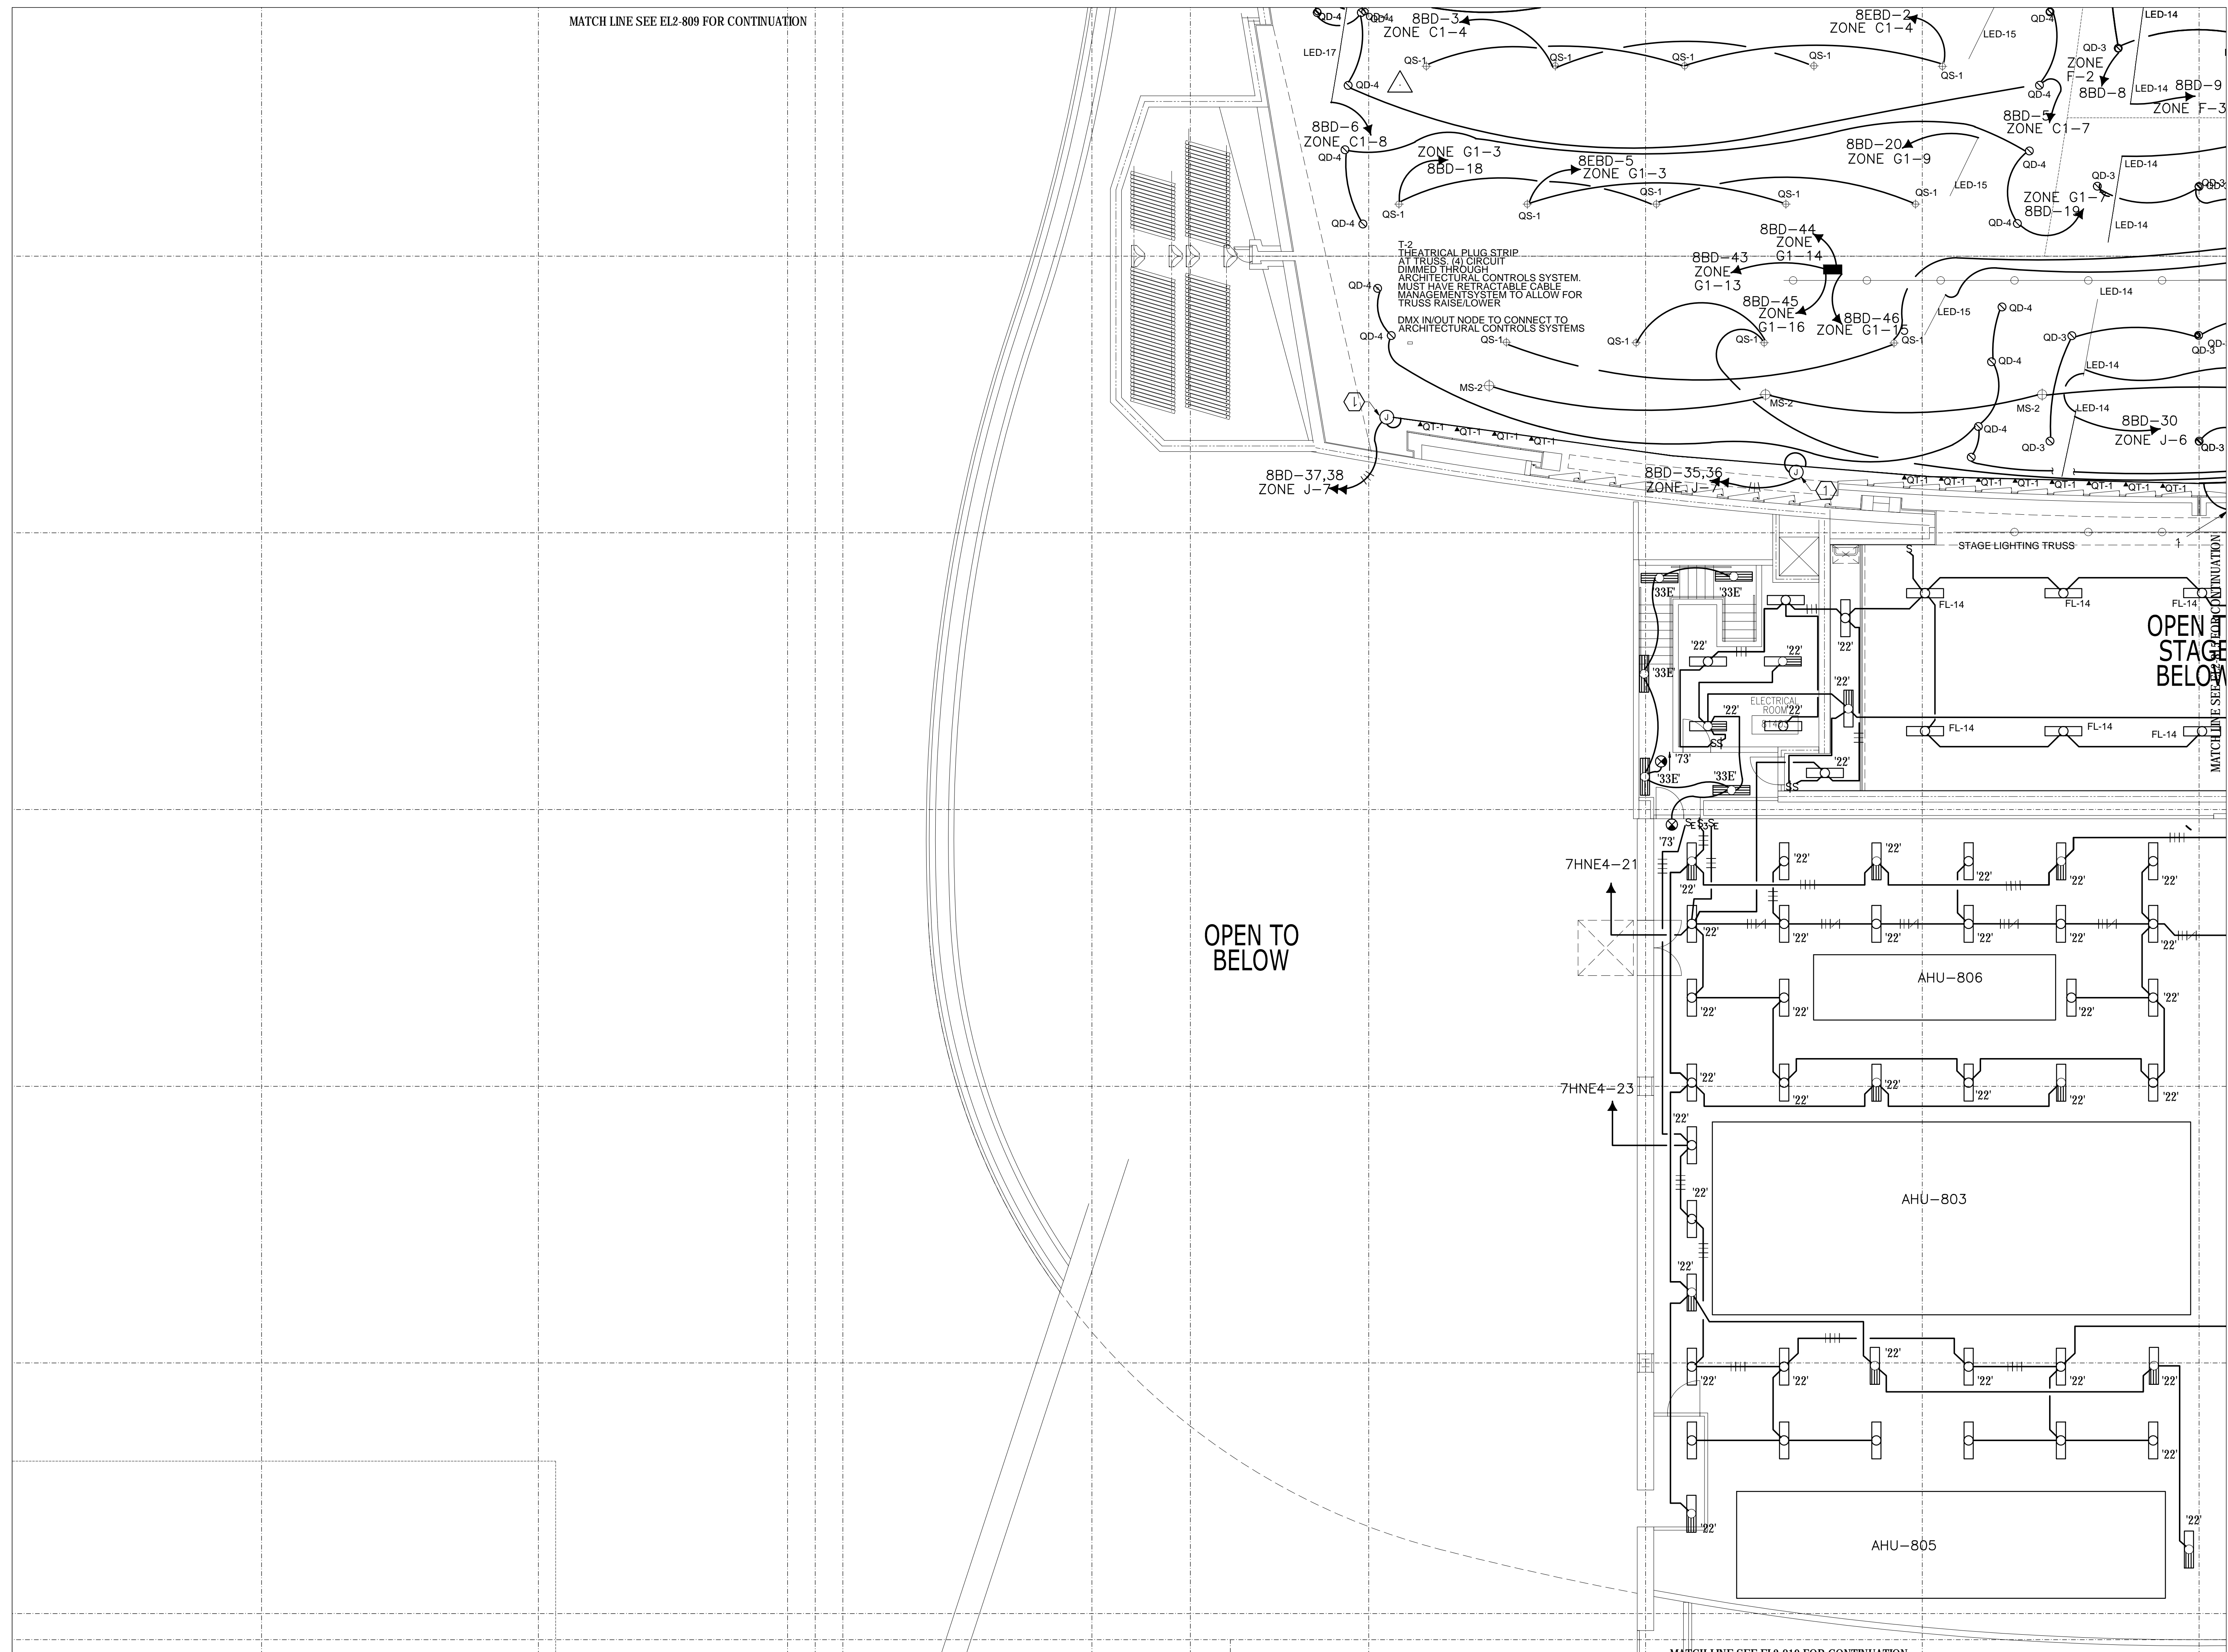

FILE PATH FOR CAD OPERATOR USE ONLY: C:\Users\Conti\Desktop\Projects\MusicCity\Level 8 Lighting\Zone 14 For Opening.dwg

