

AS-BUILTS


ANCHOR SYMBOLS

 HLL INTERMEDIATE PASS THROUGH ANCHOR
 HLL PASS THROUGH @ END


ACE MACHINE
AND METAL FABRICATION COMPANY


629 CORNELIA CT.
NASHVILLE, TN 37127

DWG. NO. S2-803 BALLROOM MEZZANINE HLL ANCHOR LOCATIONS		
SCALE: N.T.S.	WEIGHT:	SHEET: 1 OF 1

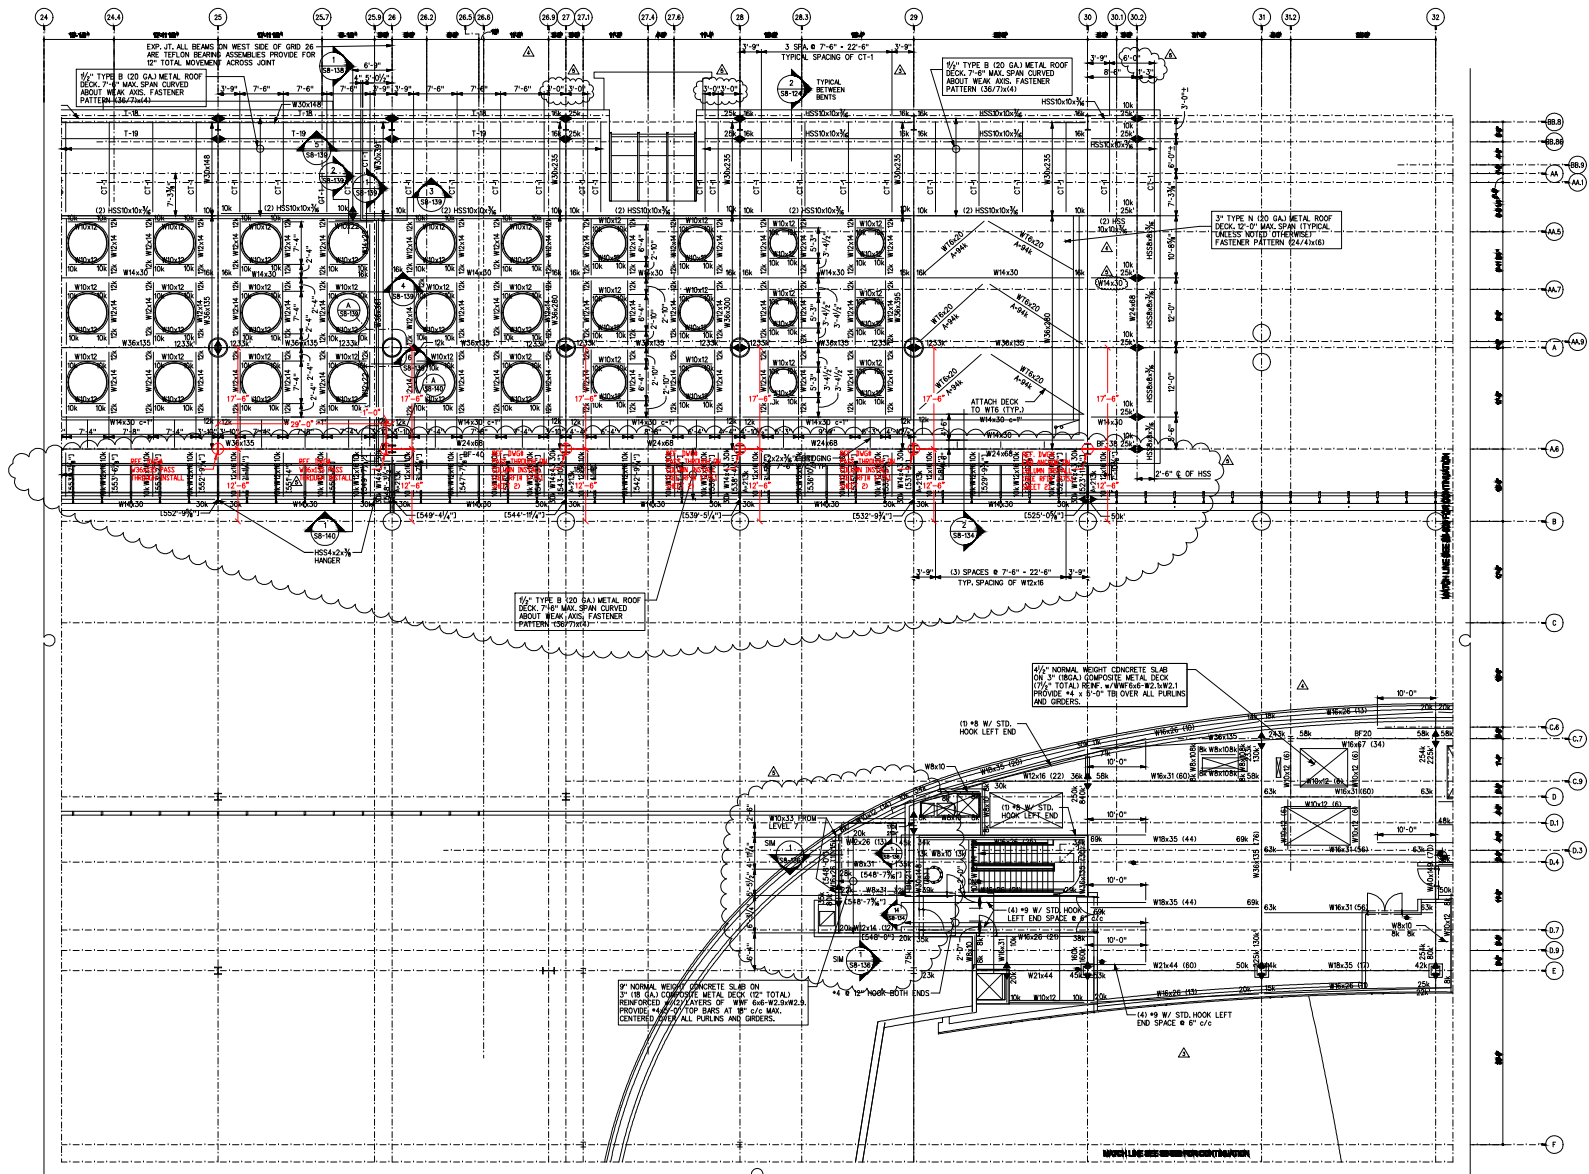

ANCHOR SYMBOLS


HLL INTERMEDIATE PASS THROUGH ANCHOR



HLL PASS THROUGH @ END

AS-BUILTS



629 CORNELIA CT.
NASHVILLE, TN 37127

DWG. NO. S2-804 BALLROOM MEZZANINE HLL ANCHOR LOCATIONS	
SCALE: N.T.S.	WEIGHT:
SHEET: 1 OF 1	

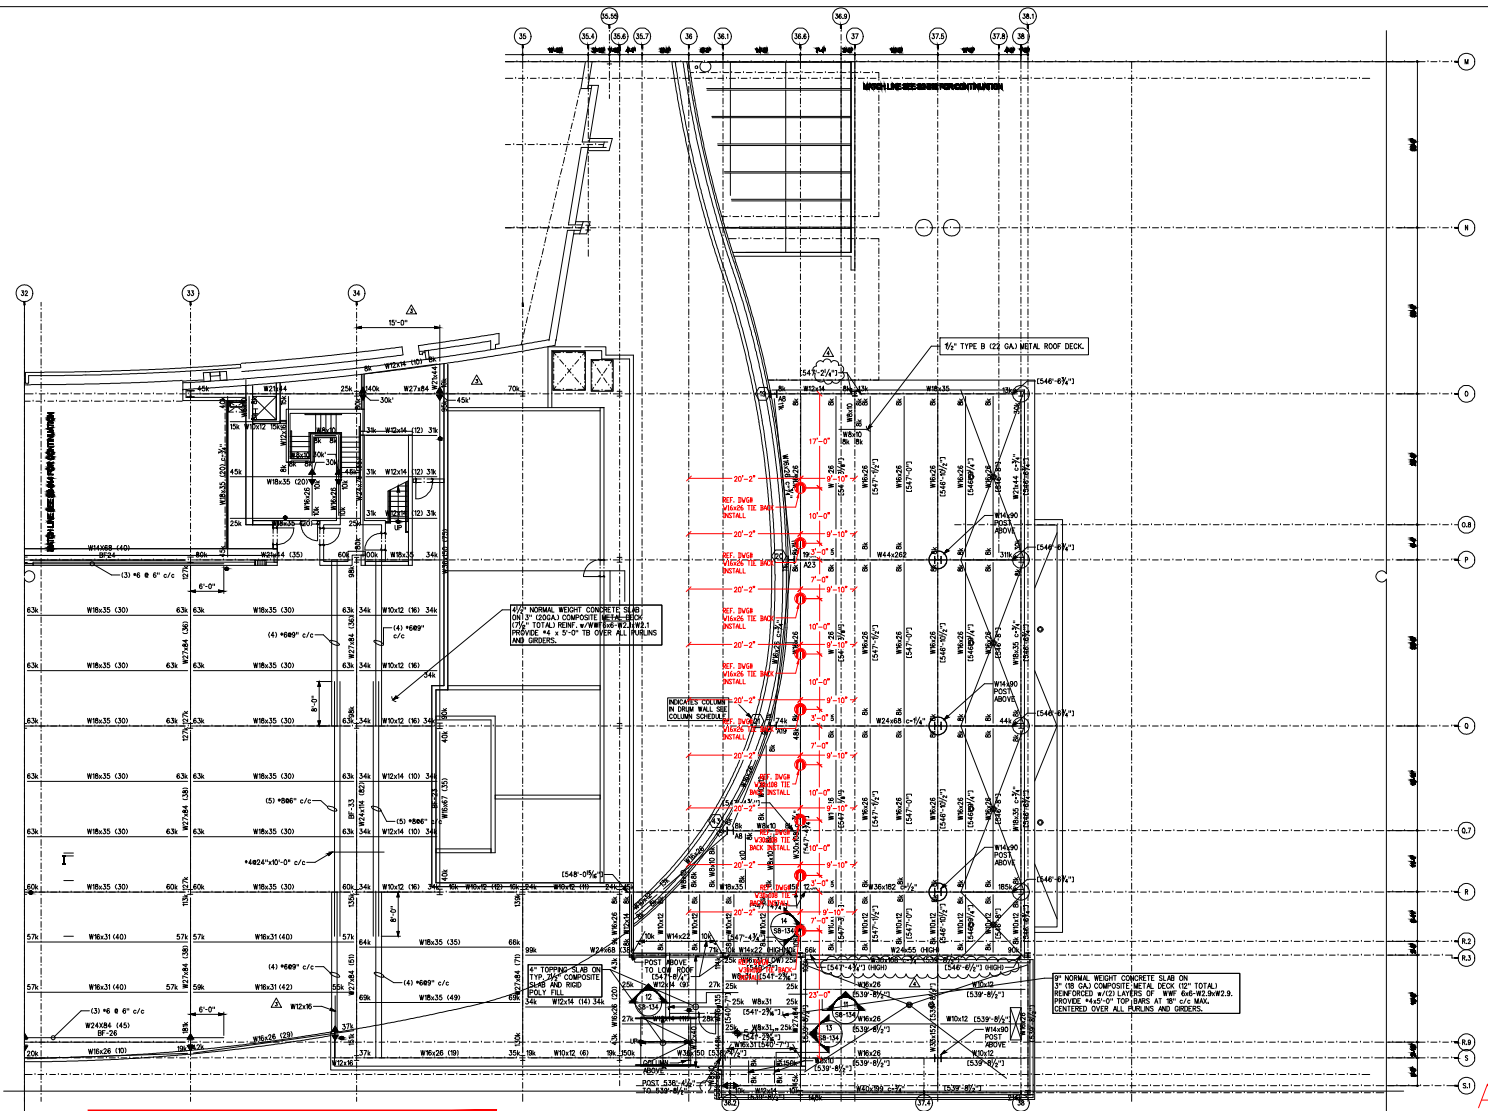


AS-BUILTS

ANCHOR SYMBOLS




WW TIE BACK ANCHOR



**ACE
MACHINE
AND METAL FABRICATION
COMPANY**

629 CORNELIA CT.
NASHVILLE, TN 37127

DWG. NO. S2-815 BALLROOM MEZZANINE WW ANCHOR LOCATIONS	
SCALE: N.T.S.	WEIGHT:
SHEET: 1 OF 1	

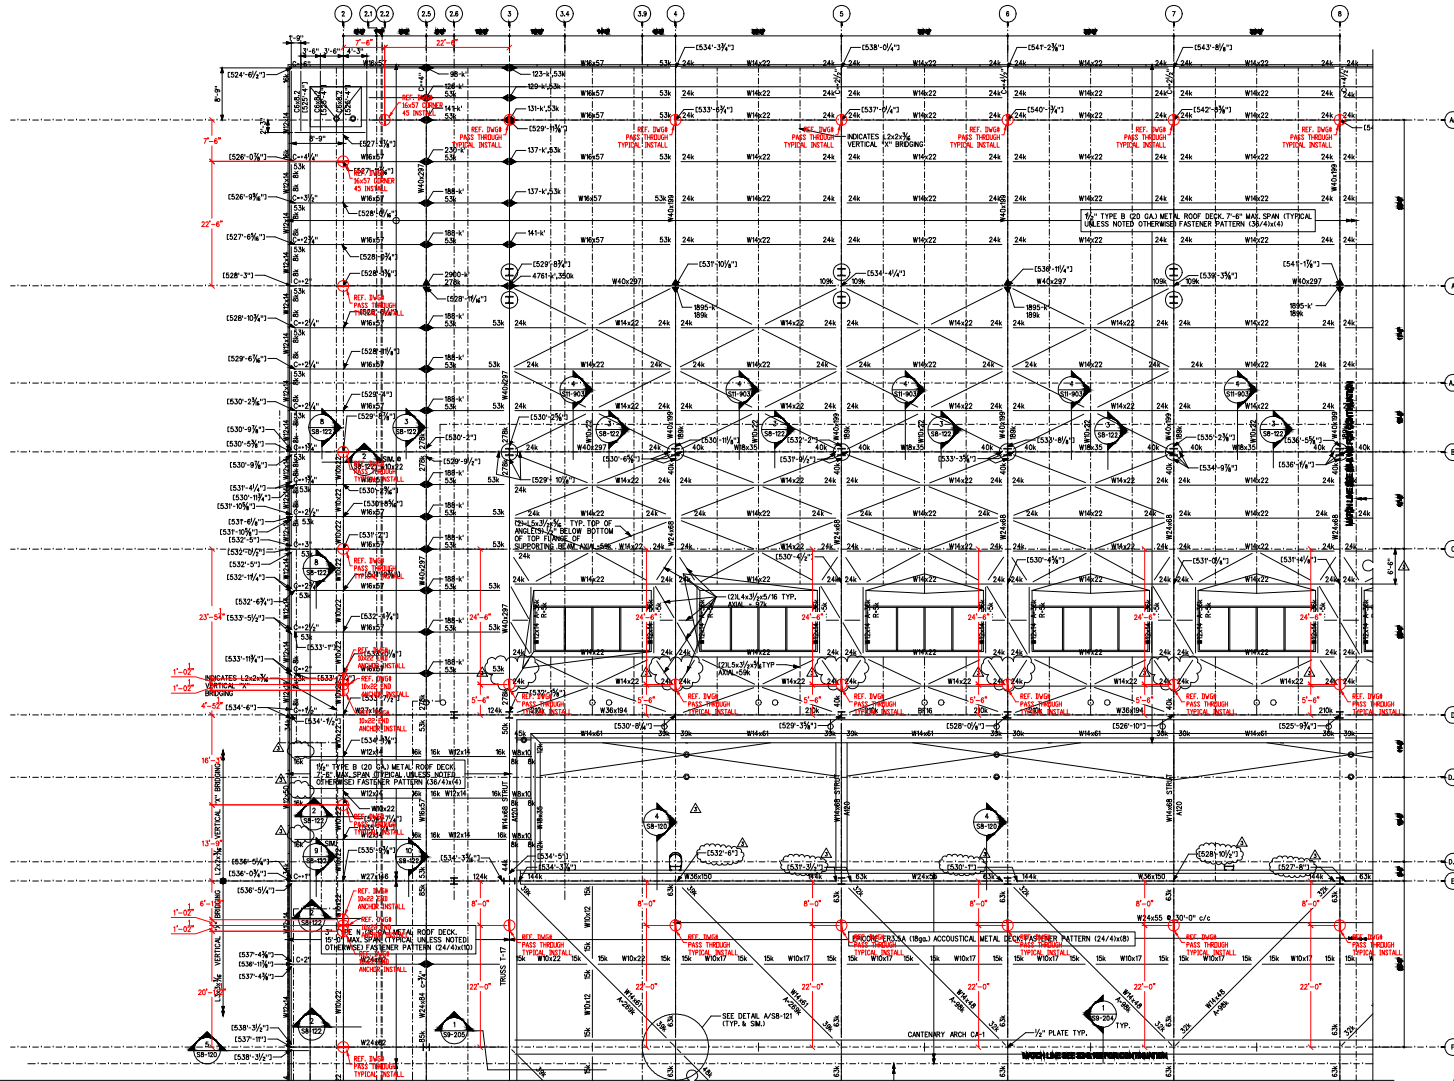


AS-BUILTS

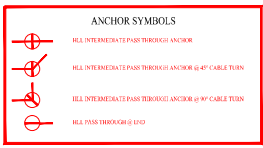


629 CORNELIA CT.
NASHVILLE, TN 37127

DWG. NO. S2-8.101 MAIN ROOF HLL ANCHOR LOCATIONS

SCALE: N.T.S. WEIGHT: SHEET: 1 OF 1

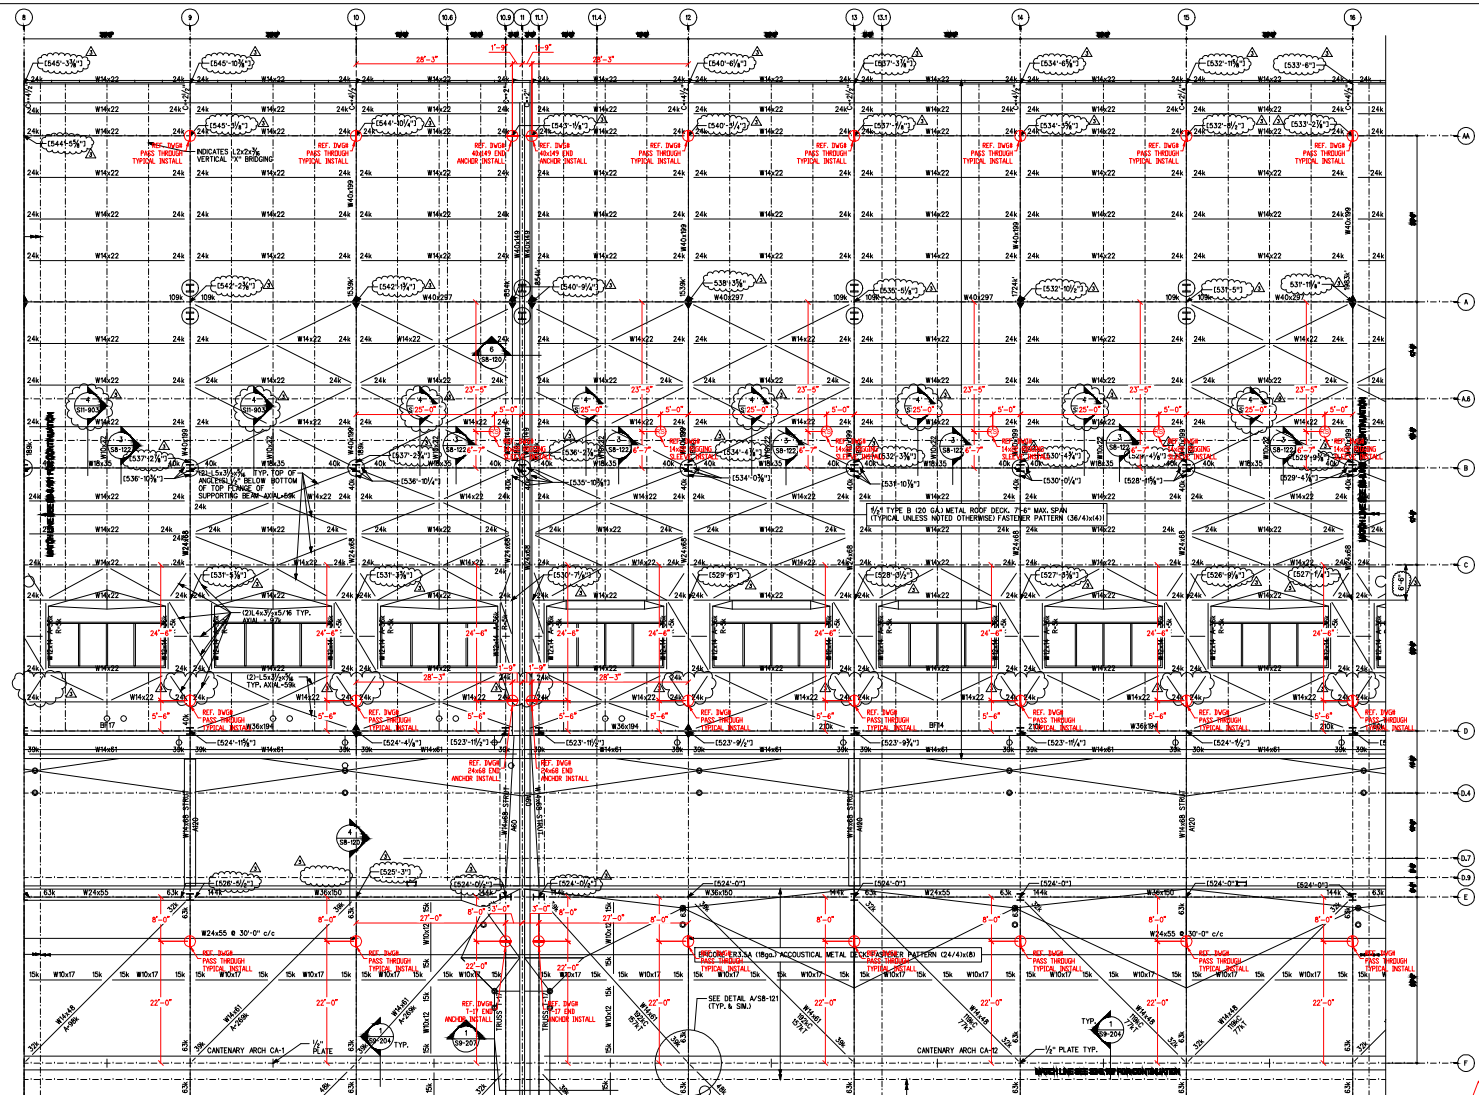


AS-BUILTS

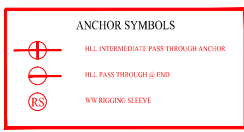

ACE MACHINE
AND METAL FABRICATION COMPANY

629 CORNELIA CT.
NASHVILLE, TN 37127

DWG. NO. S2-8.102 MAIN ROOF HLL & WW ANCHOR LOCATIONS	
SCALE: N.T.S.	WEIGHT:
SHEET: 1 OF 1	

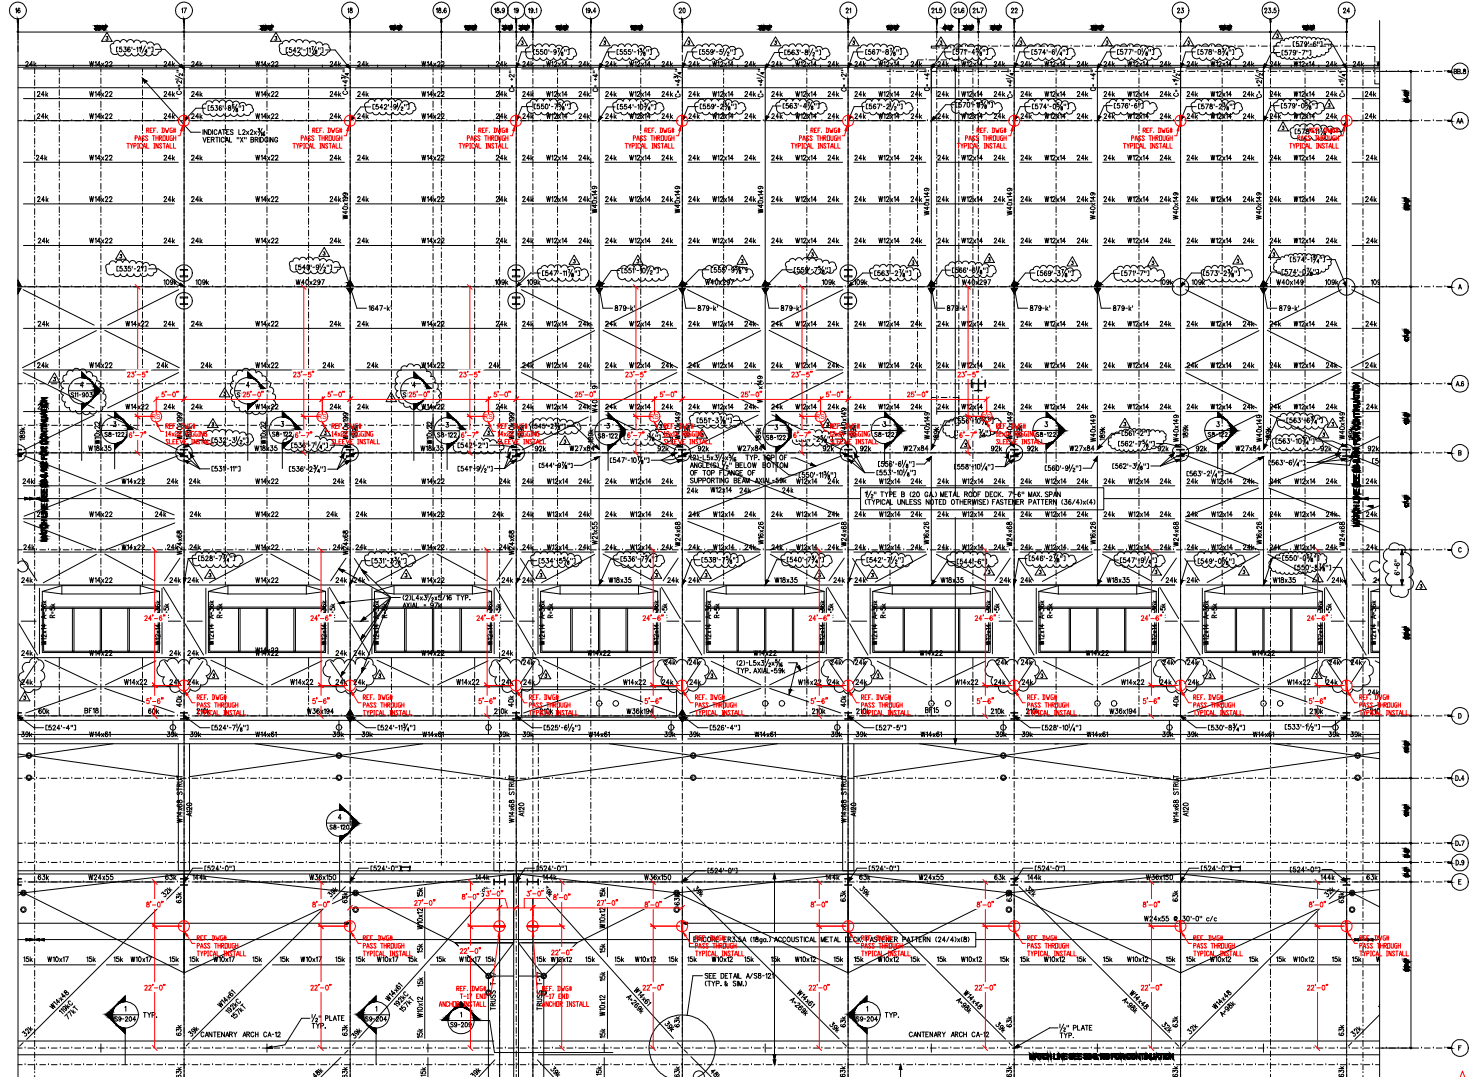


ANCHOR SYMBOLS	
	HLL INTERMEDIATE PASS THROUGH ANCHOR
	HLL PASS THROUGH @ END
	WW RIGGING SLEEVE

ACE MACHINE
AND METAL FABRICATION COMPANY

629 CORNELIA CT.
NASHVILLE, TN 37127

AS-BUILTS

DWG. NO.	S2-8.103 MAIN ROOF HLL & WW ANCHOR LOCATIONS
SCALE: N.T.S.	WEIGHT:
SHEET: 1 OF 1	

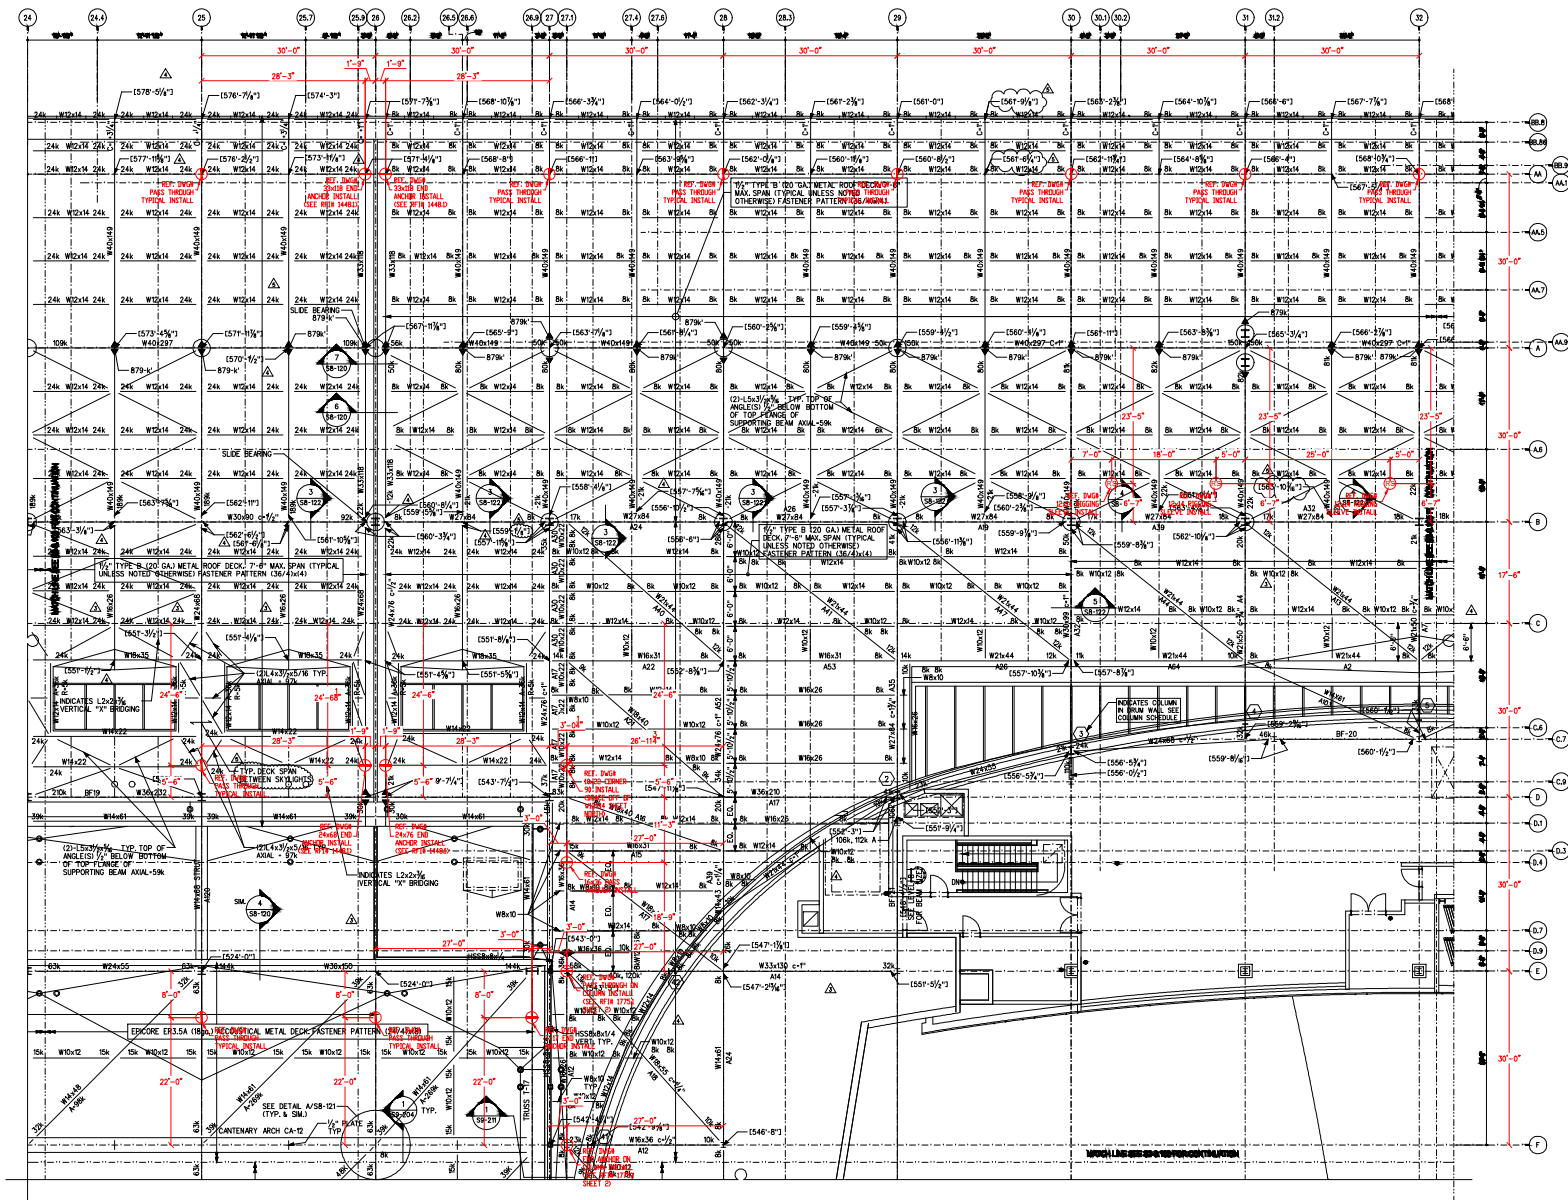

ANCHOR SYMBOLS

	HLL INTERMEDIATE PASS THROUGH ANCHOR
	HLL PASS THROUGH @ END
	HLL INTERMEDIATE PASS THROUGH ANCHOR @ 90° CABLE TURN
	WW RIGGING SLEEVE

AS-BUILTS




629 CORNELIA CT.
NASHVILLE, TN 37127

DWG. NO.

S2-8.104 MAIN ROOF HLL & WW ANCHOR LOCATIONS

SCALE: N.T.S. WEIGHT:

SHEET: 1 OF 1

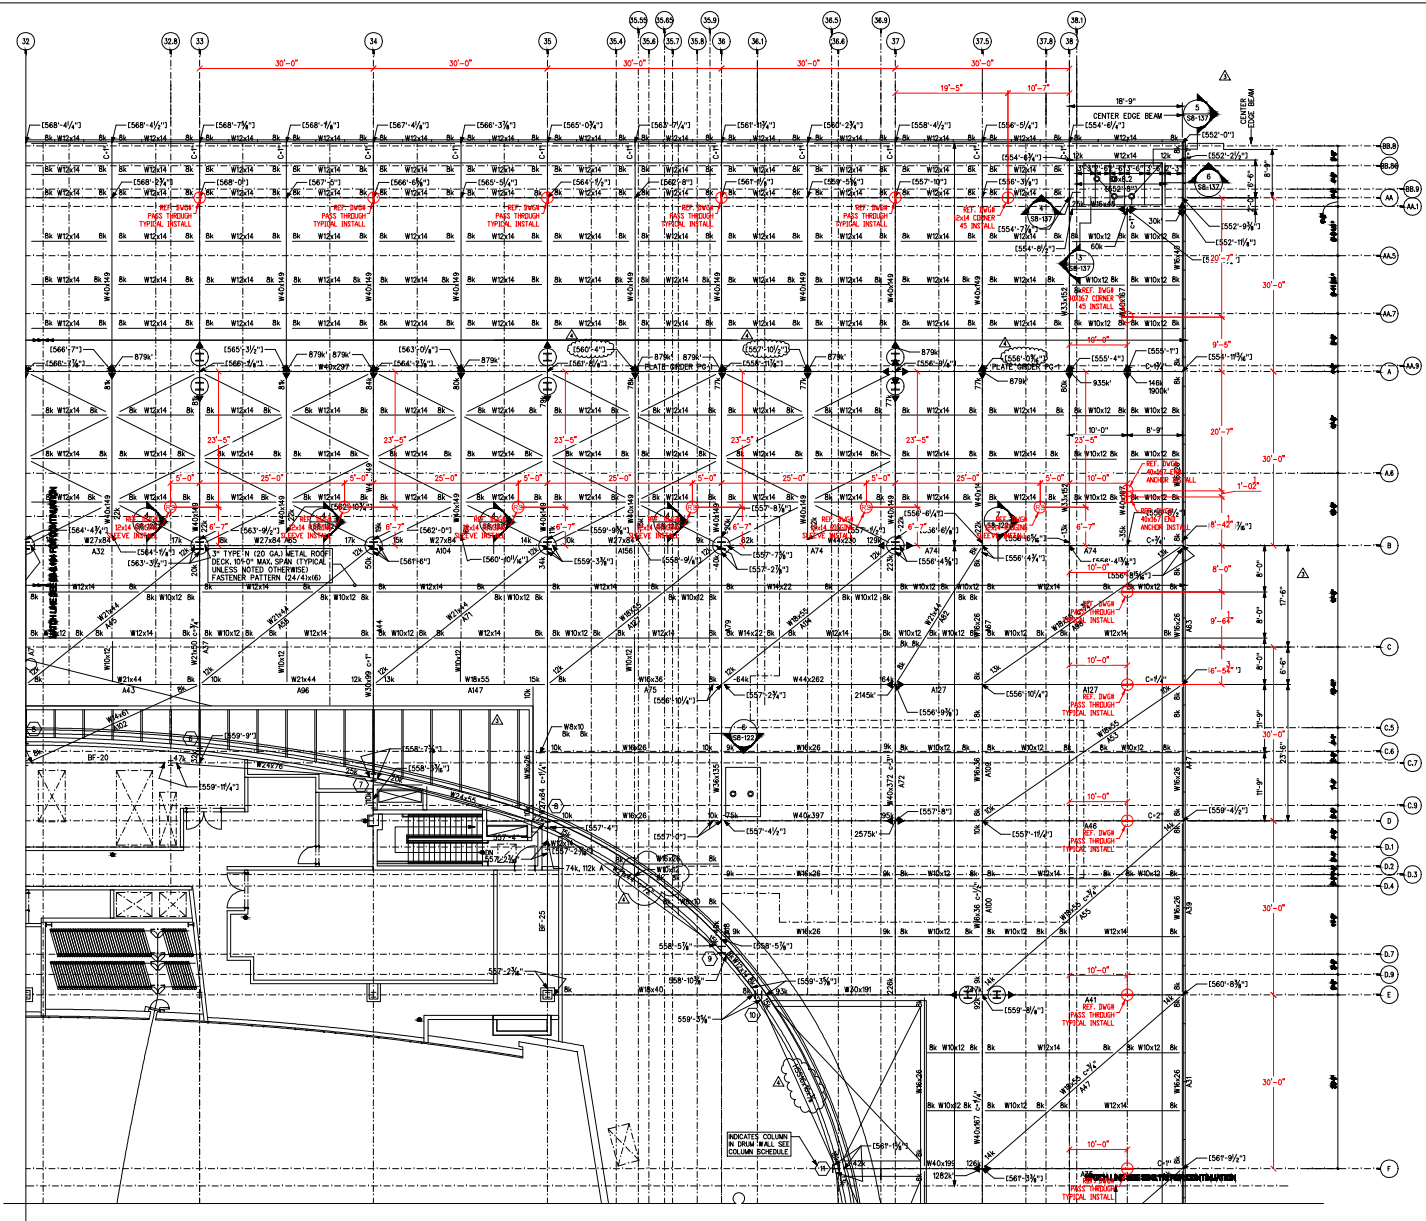

ANCHOR SYMBOLS

⊕	HLL INTERMEDIATE PASS THROUGH ANCHOR
⊙	HLL PASS THROUGH @ END
⊕	HLL INTERMEDIATE PASS THROUGH ANCHOR @ 45° CABLE TURN
⊗	WW RIGGING SLEEVE


AS-BUILTS



629 CORNELIA CT.
NASHVILLE, TN 37127

DWG. NO. S2-8.105 MAIN ROOF HLL & WW ANCHOR LOCATIONS

SCALE: N.T.S. WEIGHT: SHEET: 1 OF 1

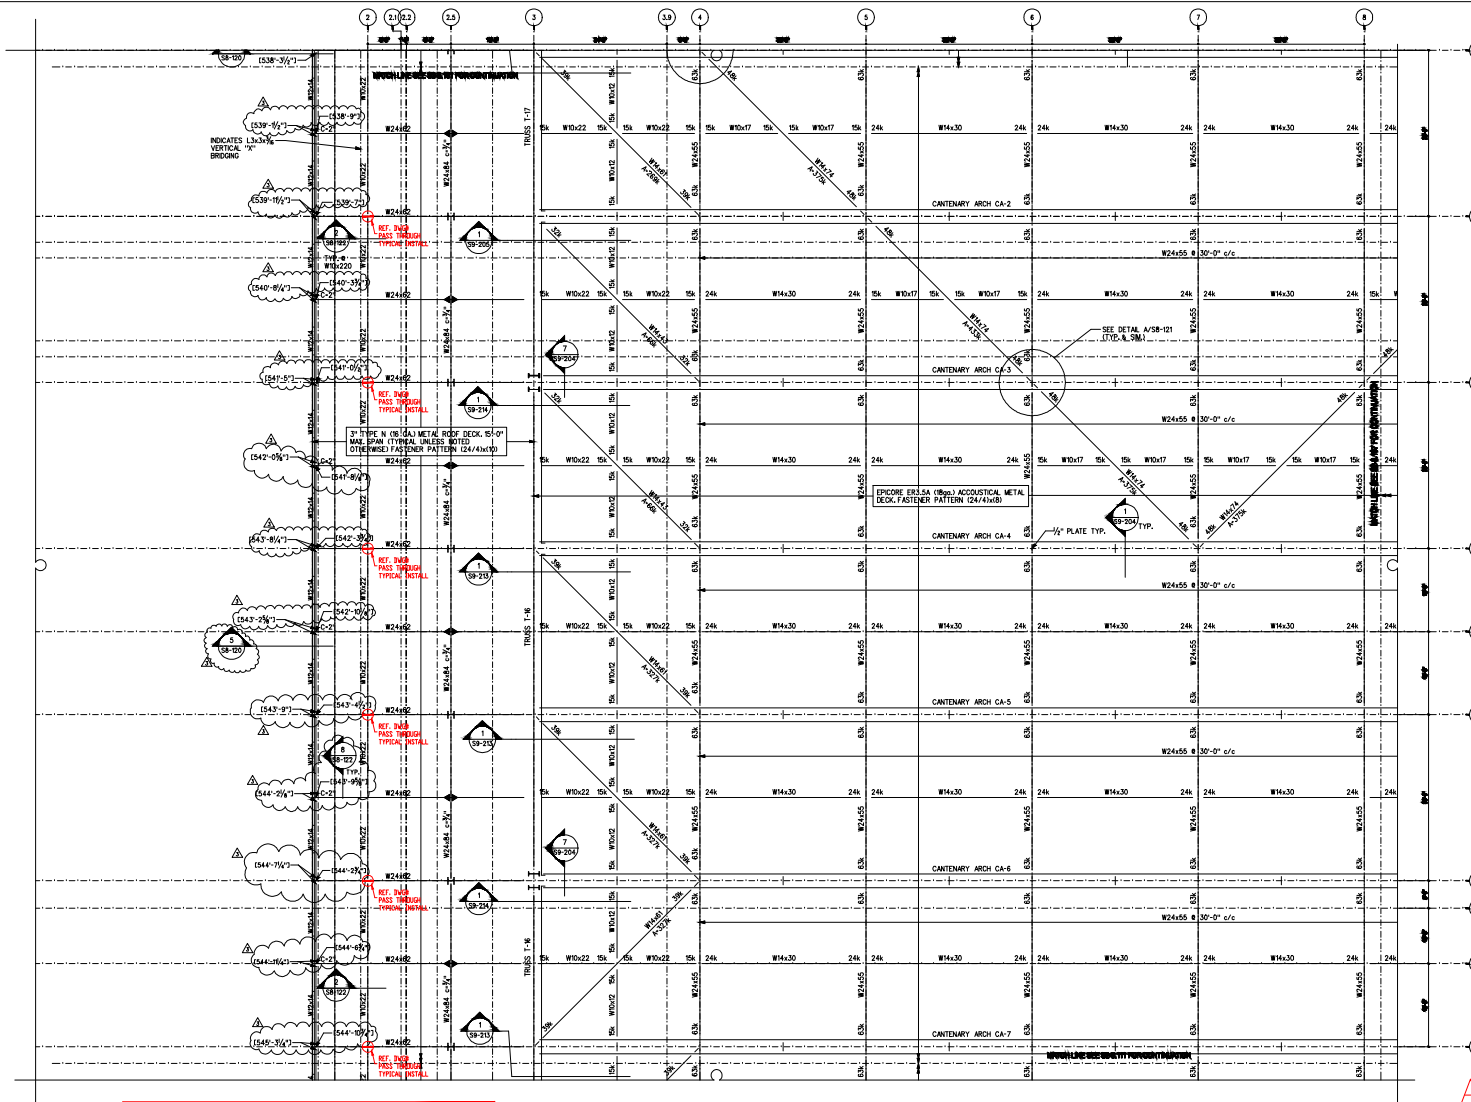



AS-BUILTS



629 CORNELIA CT.
NASHVILLE, TN 37127

DWG. NO. S2-8.106 MAIN ROOF HLL ANCHOR LOCATIONS


SCALE: N.T.S. WEIGHT: SHEET: 1 OF 1

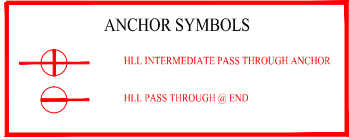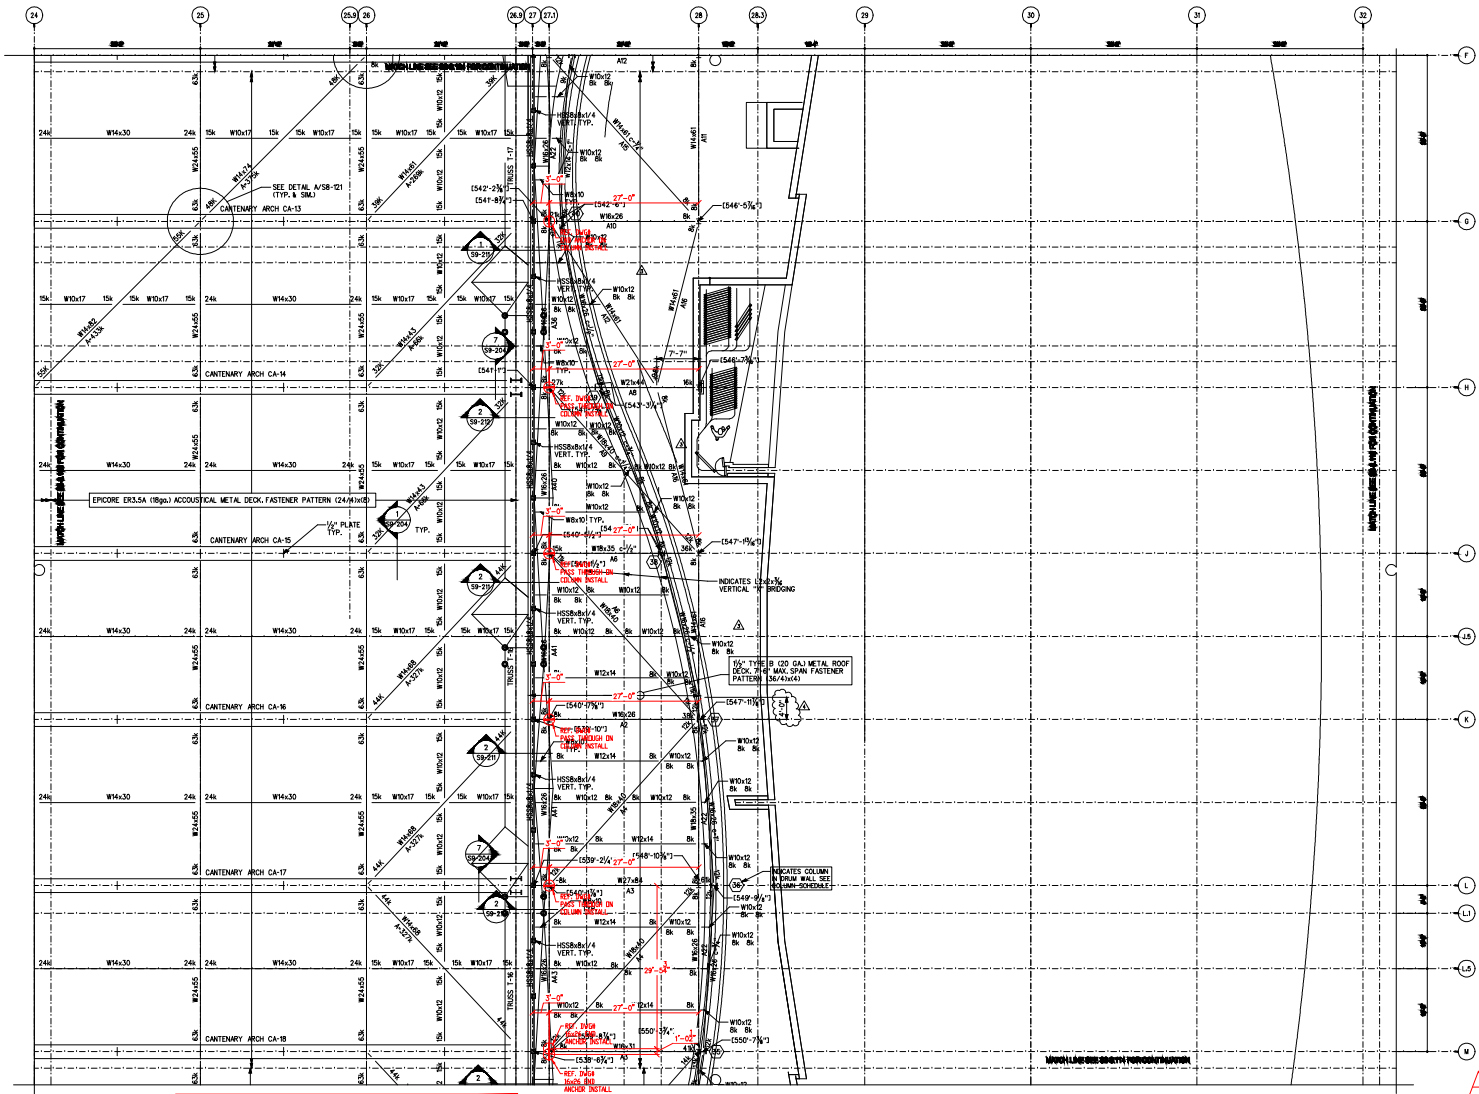

ACE
MACHINE
AND METAL FABRICATION
COMPANY



629 CORNELIA CT.
NASHVILLE, TN 37127

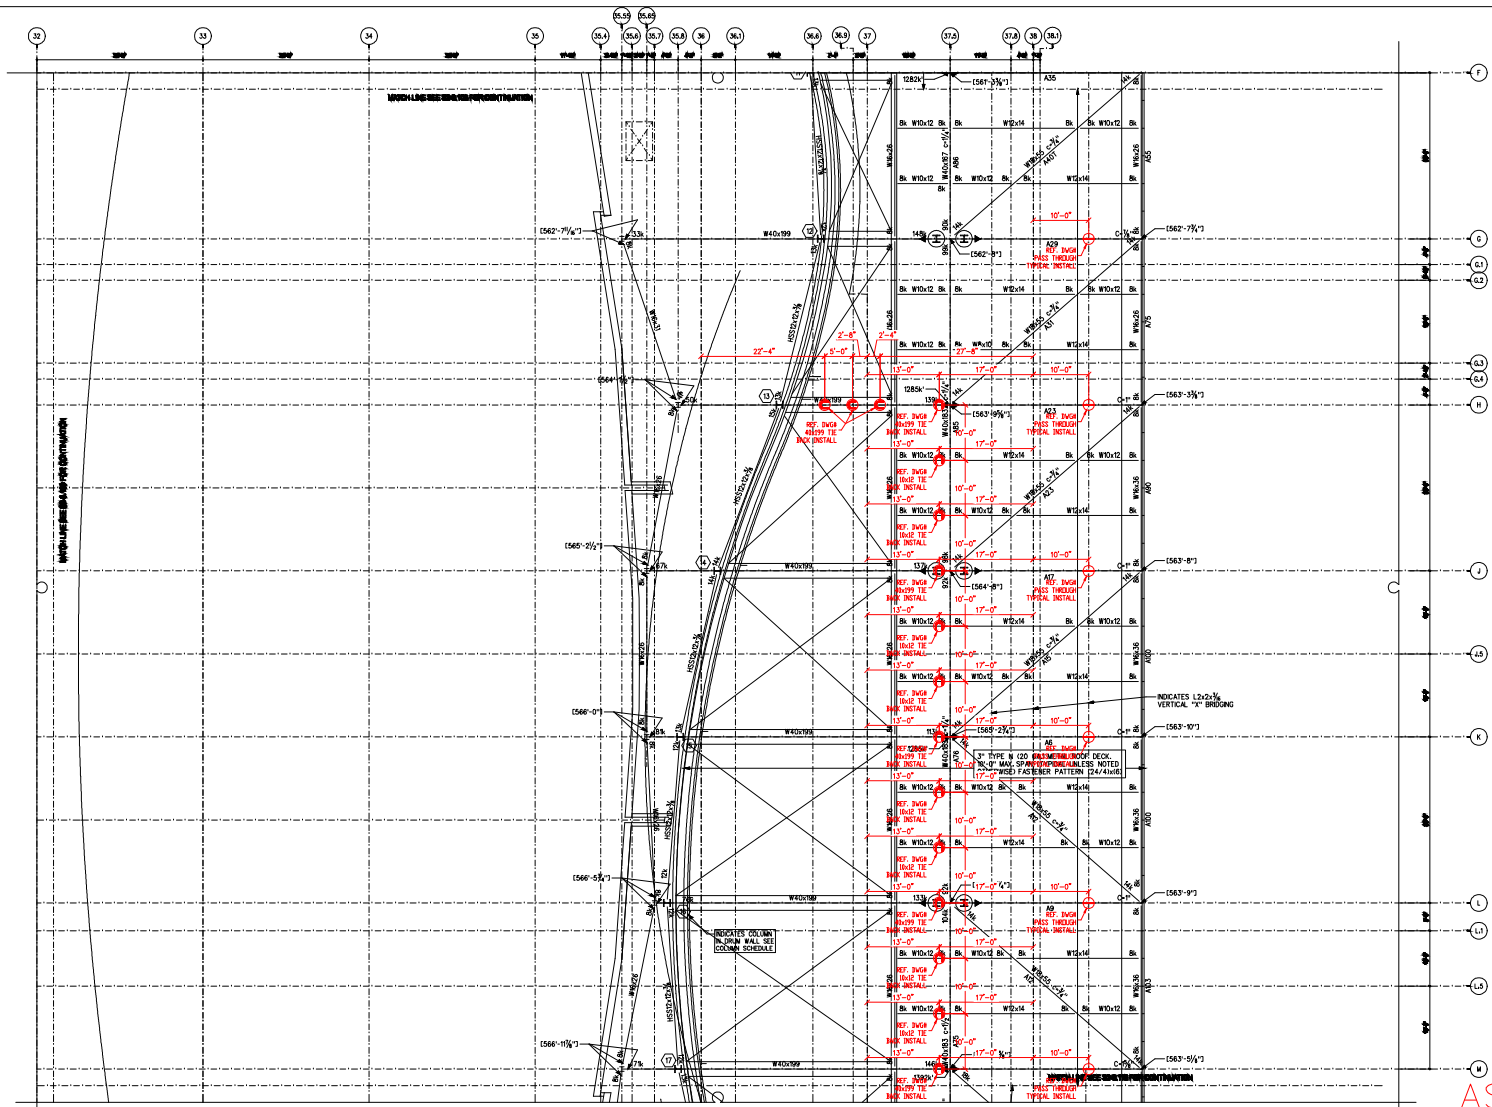DWG. NO. S2-8.109 MAIN ROOF HLL ANCHOR LOCATIONS		
SCALE: N.T.S.	WEIGHT:	SHEET: 1 OF 1



AS-BUILTS


ANCHOR SYMBOLS

-  HLL INTERMEDIATE PASS THROUGH ANCHOR
-  WW TIE BACK ANCHOR


ACE MACHINE
AND METAL FABRICATION COMPANY

629 CORNELIA CT.
NASHVILLE, TN 37127

DWG. NO. S2-8.110 MAIN ROOF HLL & WW ANCHOR LOCATIONS	
SCALE: N.T.S.	WEIGHT:
SHEET: 1 OF 1	

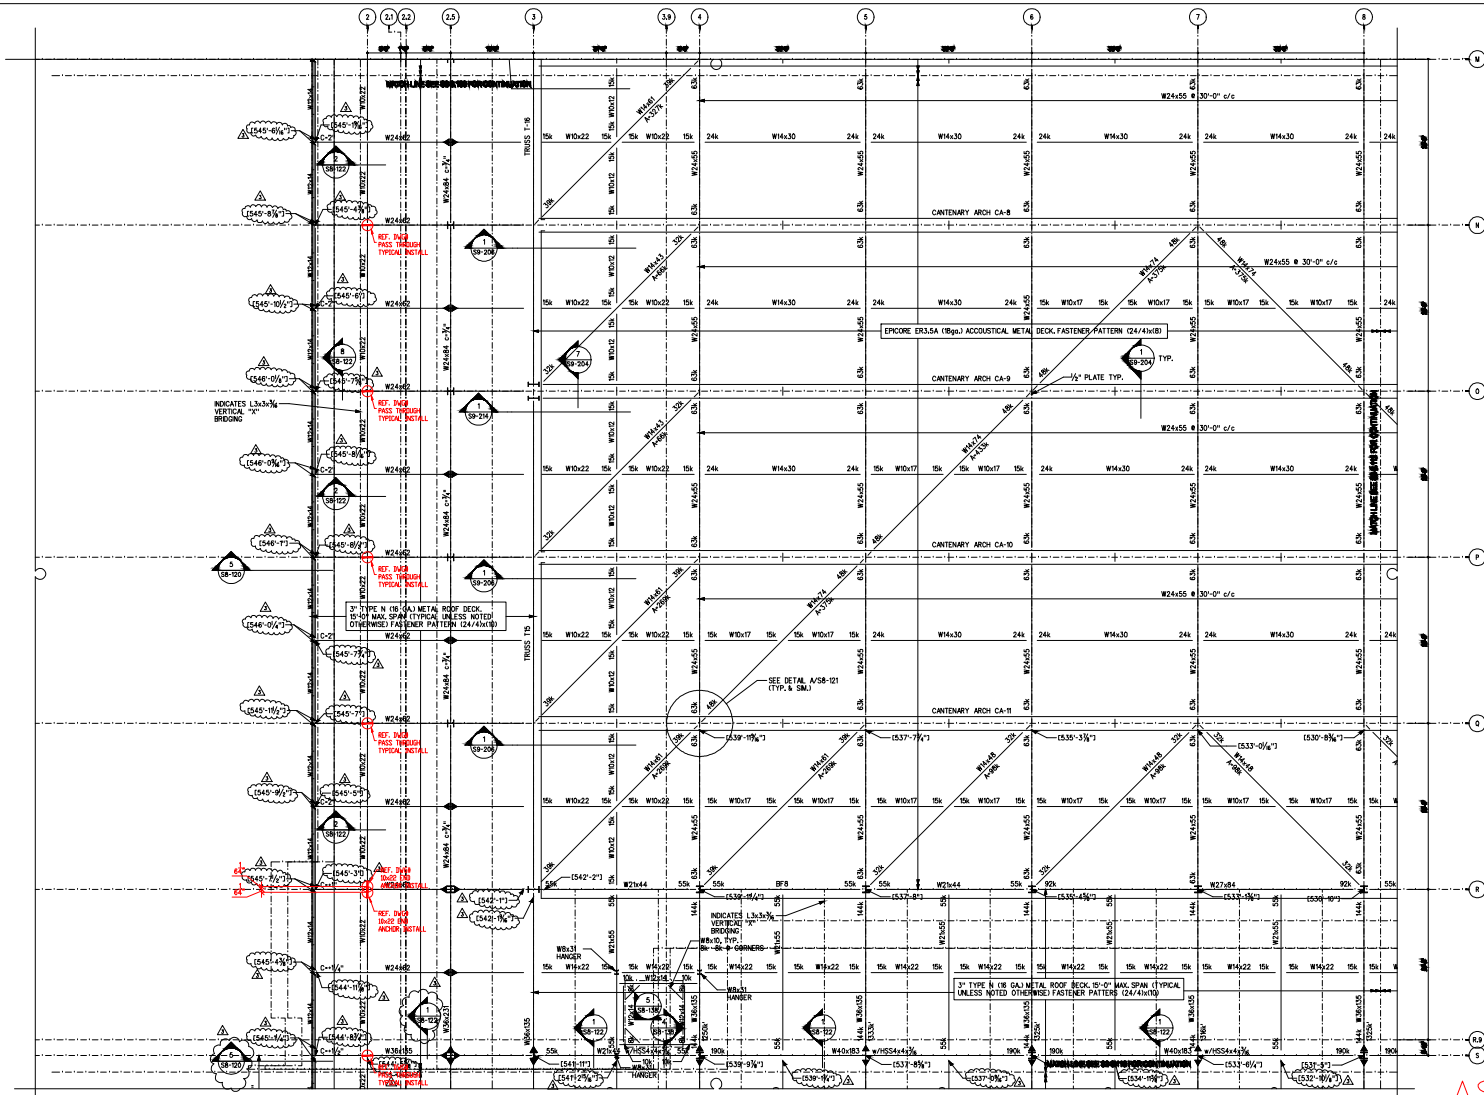


AS-BUILTS

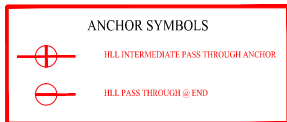

629 CORNELIA CT.
NASHVILLE, TN 37127

DWG. NO. S2-8.111 MAIN ROOF HLL ANCHOR LOCATIONS	
SCALE: N.T.S.	WEIGHT:
SHEET: 1 OF 1	

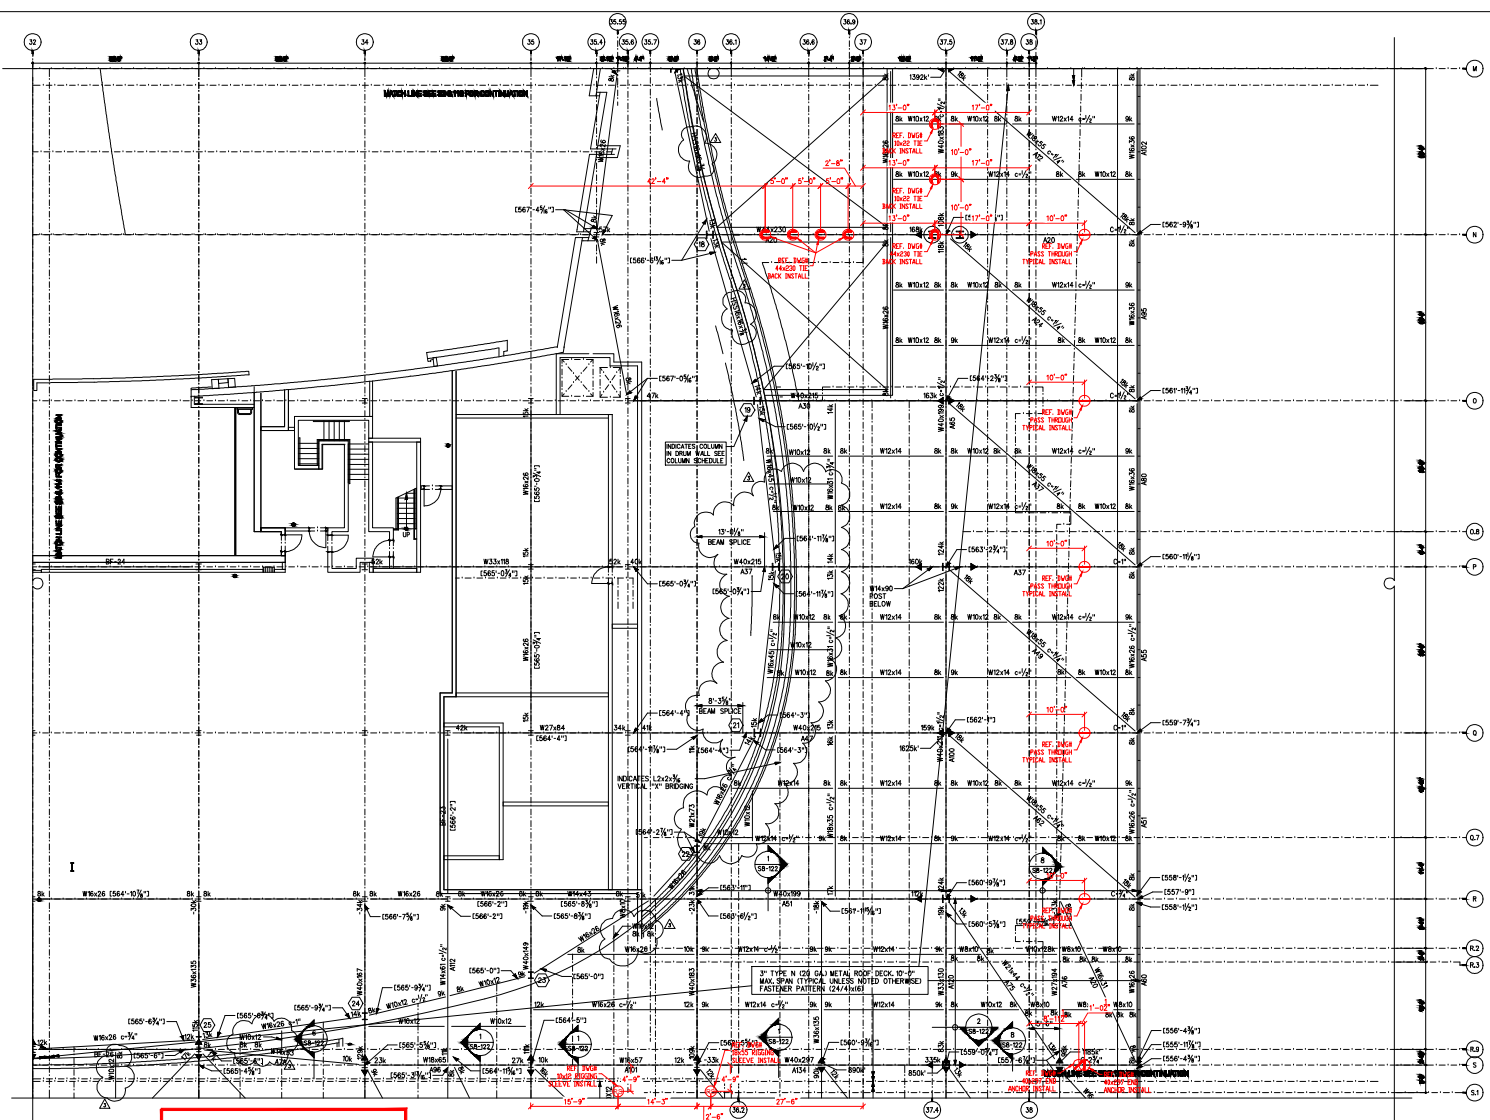


AS-BUILTS


ACE MACHINE
AND METAL FABRICATION COMPANY

629 CORNELIA CT.
NASHVILLE, TN 37127

DWG. NO. S2-8.115 MAIN ROOF HLL & WW ANCHOR LOCATIONS		
SCALE: N.T.S.	WEIGHT:	SHEET: 1 OF 1

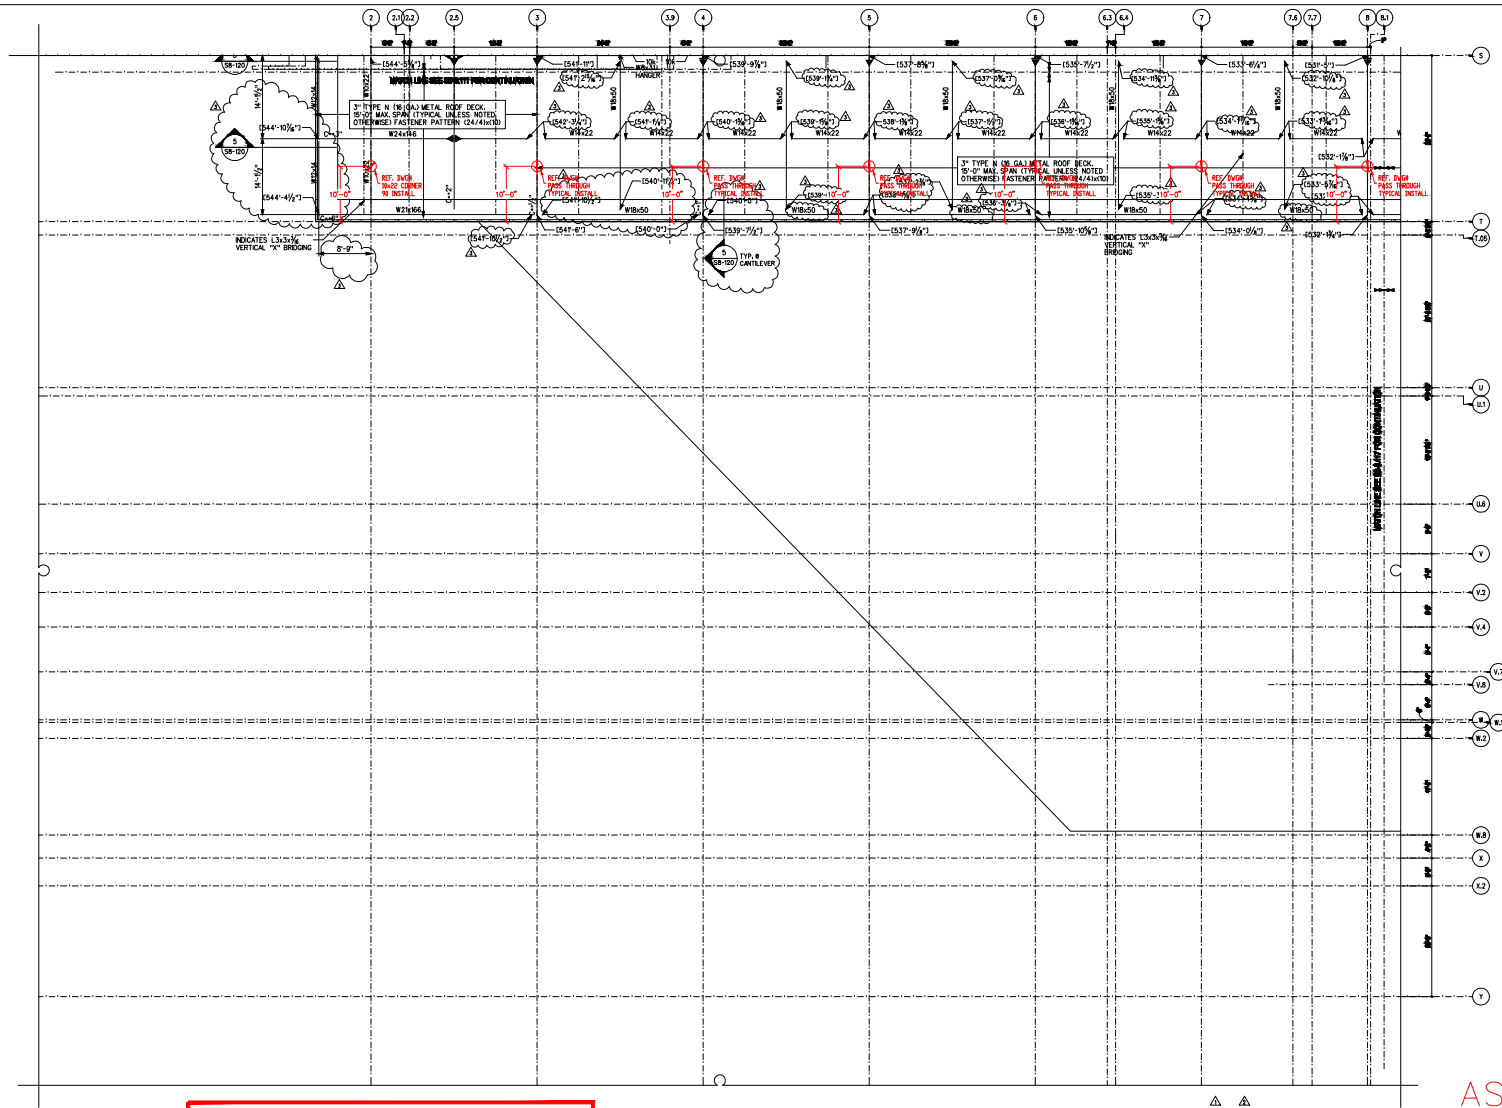


AS-BUILTS

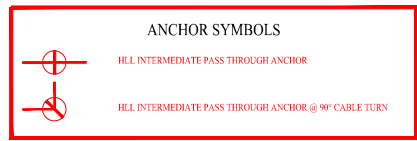


629 CORNELIA CT.
NASHVILLE, TN 37127

DWG. NO. S2-8.116 MAIN ROOF HLL ANCHOR LOCATIONS		
SCALE: N.T.S.	WEIGHT:	SHEET: 1 OF 1

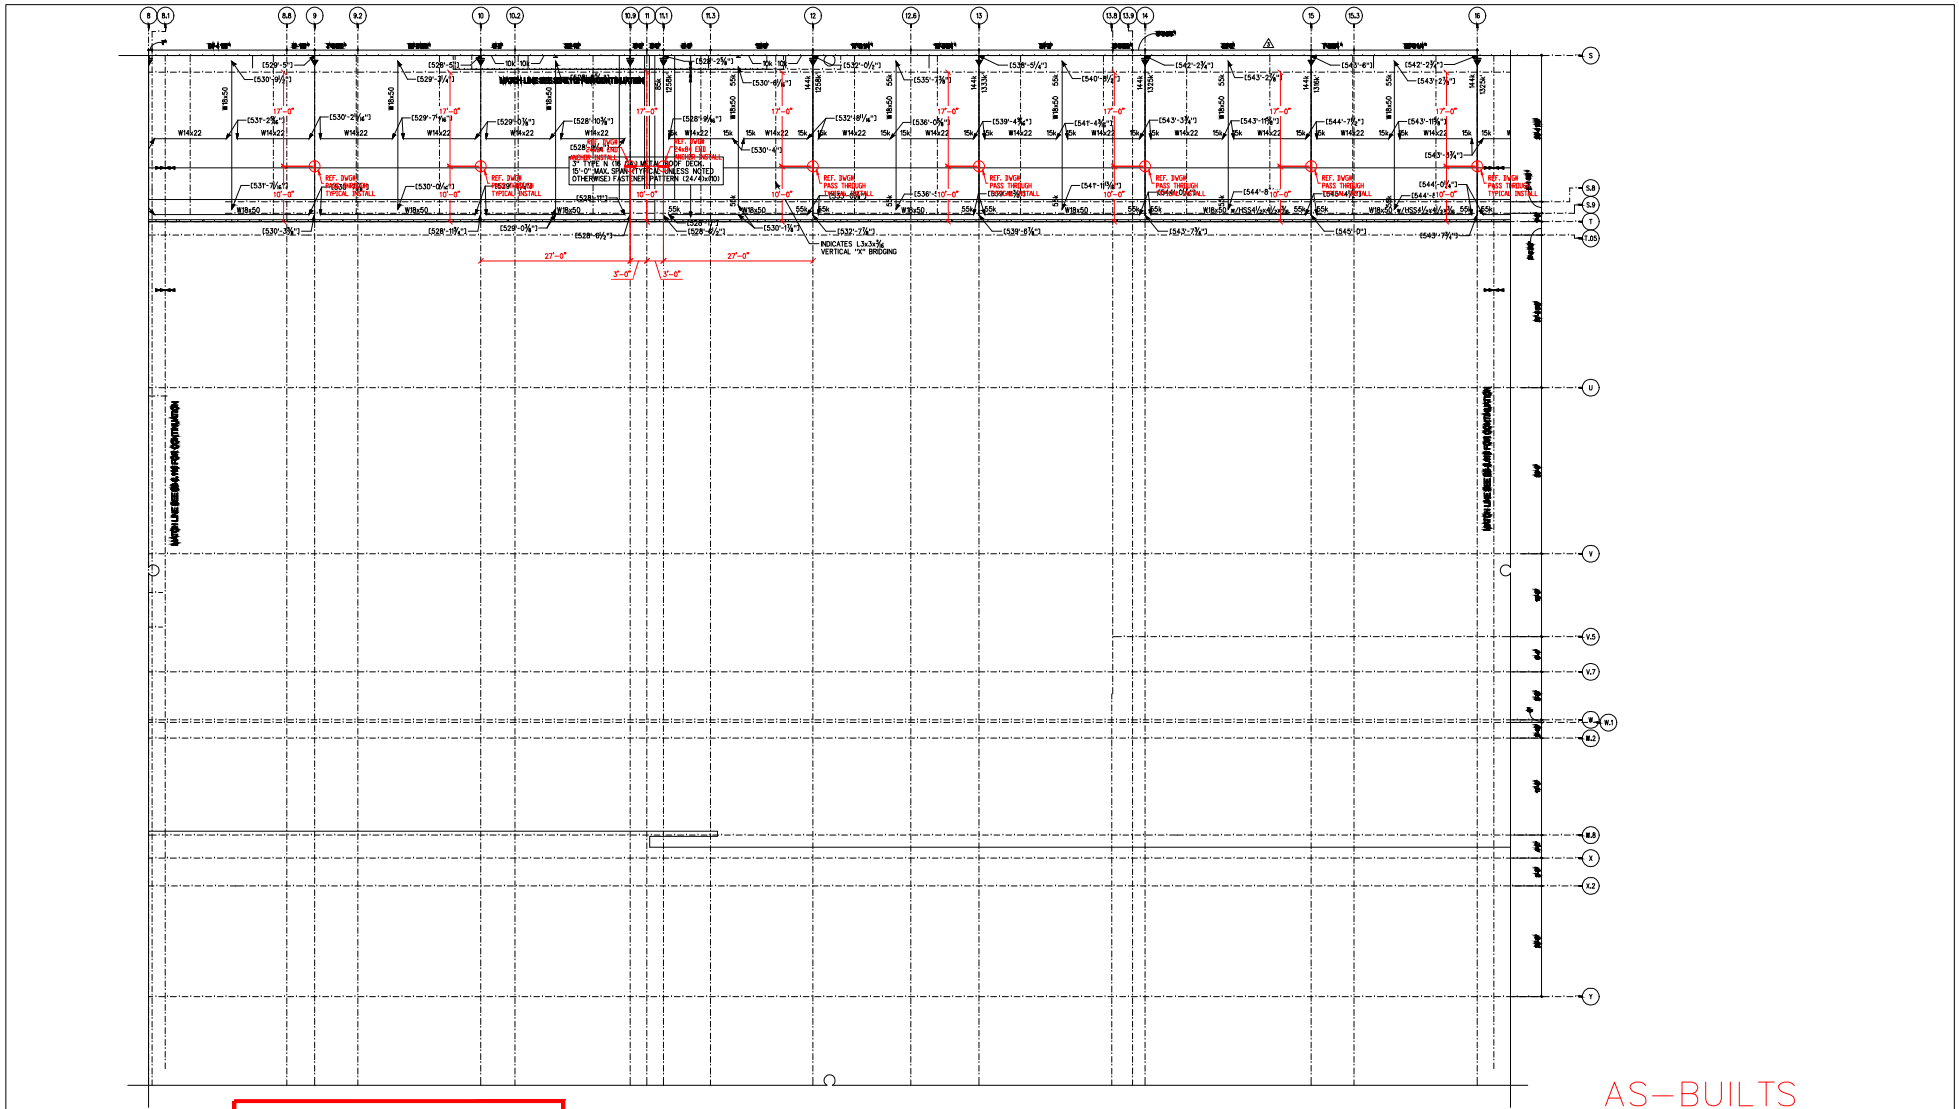


AS-BUILTS

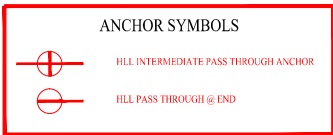

629 CORNELIA CT.
NASHVILLE, TN 37127



DWG. NO.
S2-8.117 MAIN ROOF HLL ANCHOR LOCATIONS

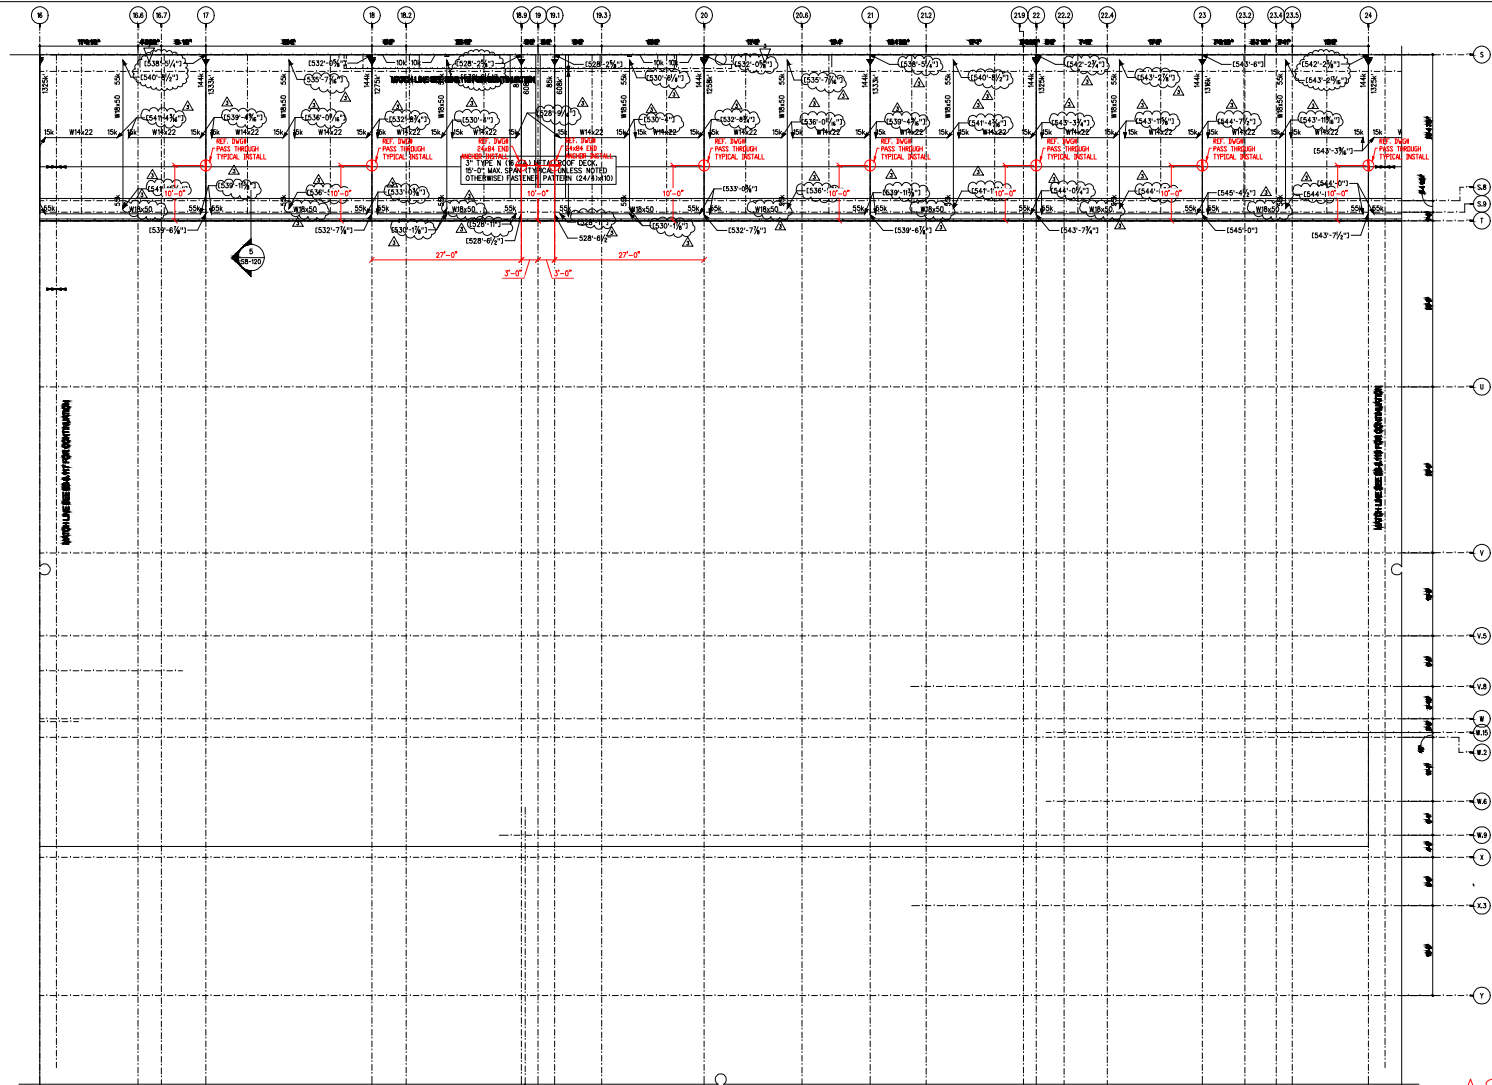SCALE: N.T.S.	WEIGHT:	SHEET: 1 OF 1
---------------	---------	---------------



AS-BUILTS


ANCHOR SYMBOLS

-  HLL INTERMEDIATE PASS THROUGH ANCHOR
-  HLL PASS THROUGH @ END





629 CORNELIA CT.
NASHVILLE, TN 37127

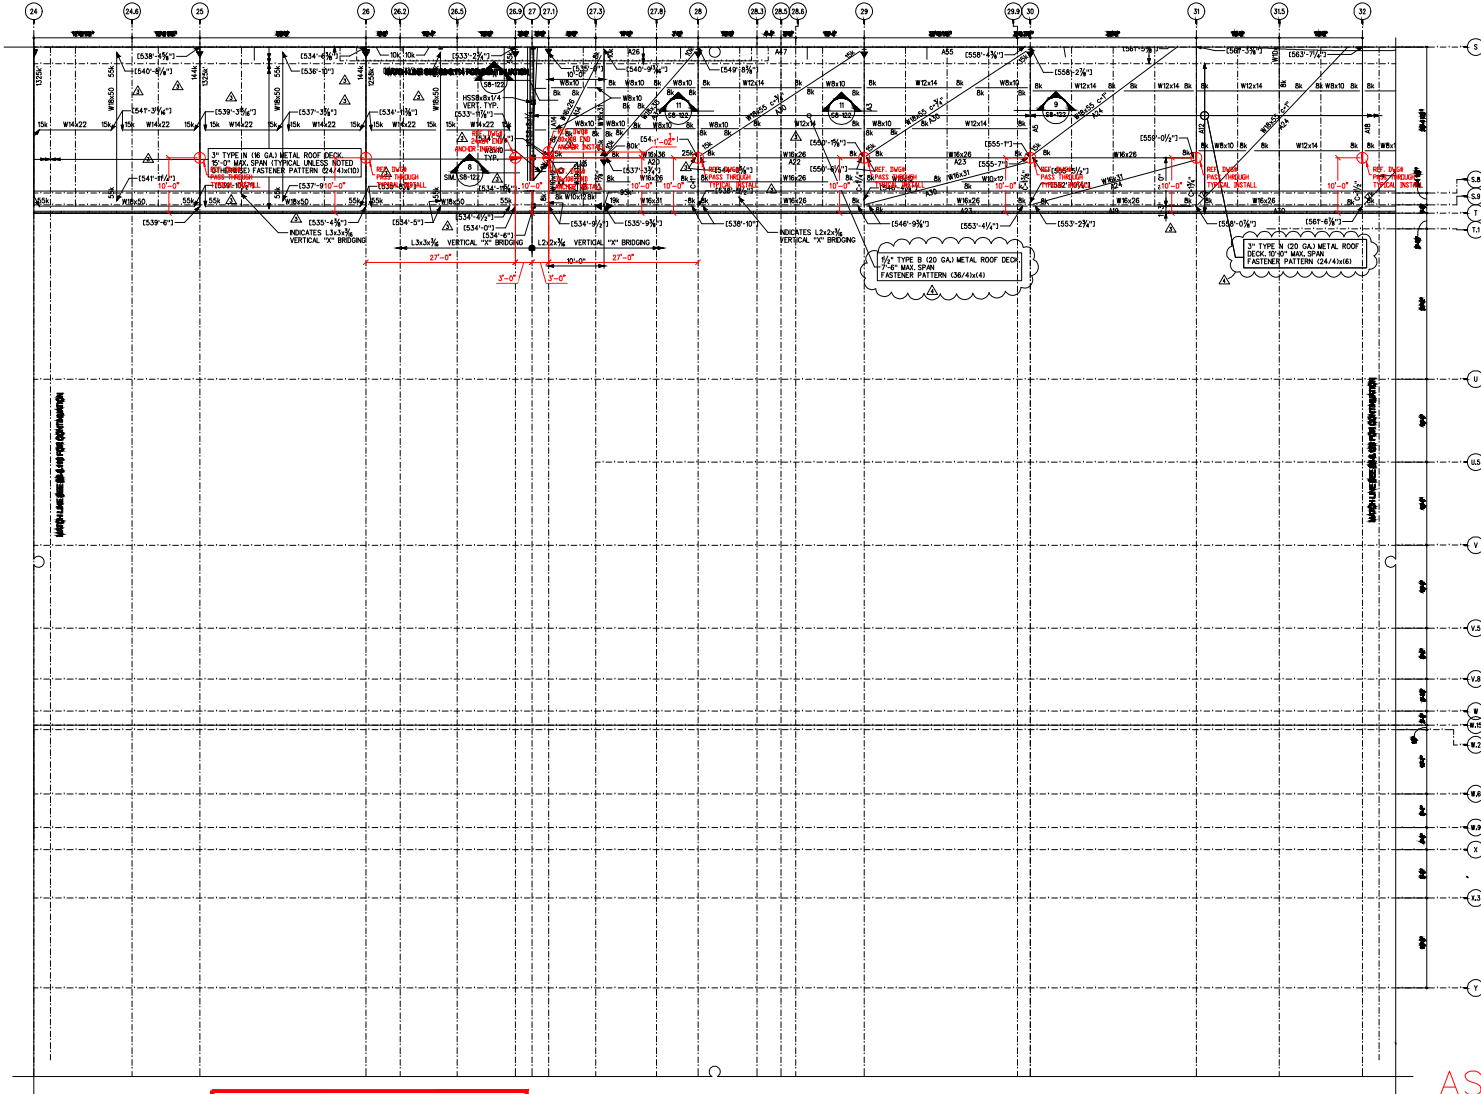DWG. NO. S2-8.118 MAIN ROOF HLL ANCHOR LOCATIONS		
SCALE: N.T.S.	WEIGHT:	SHEET: 1 OF 1



AS-BUILTS

ANCHOR SYMBOLS


-  HLL INTERMEDIATE PASS THROUGH ANCHOR
-  HLL PASS THROUGH @ END



629 CORNELIA CT.
NASHVILLE, TN 37127

DWG. NO.
S2-8.119 MAIN ROOF HLL ANCHOR LOCATIONS

SCALE: N.T.S. WEIGHT: SHEET: 1 OF 1

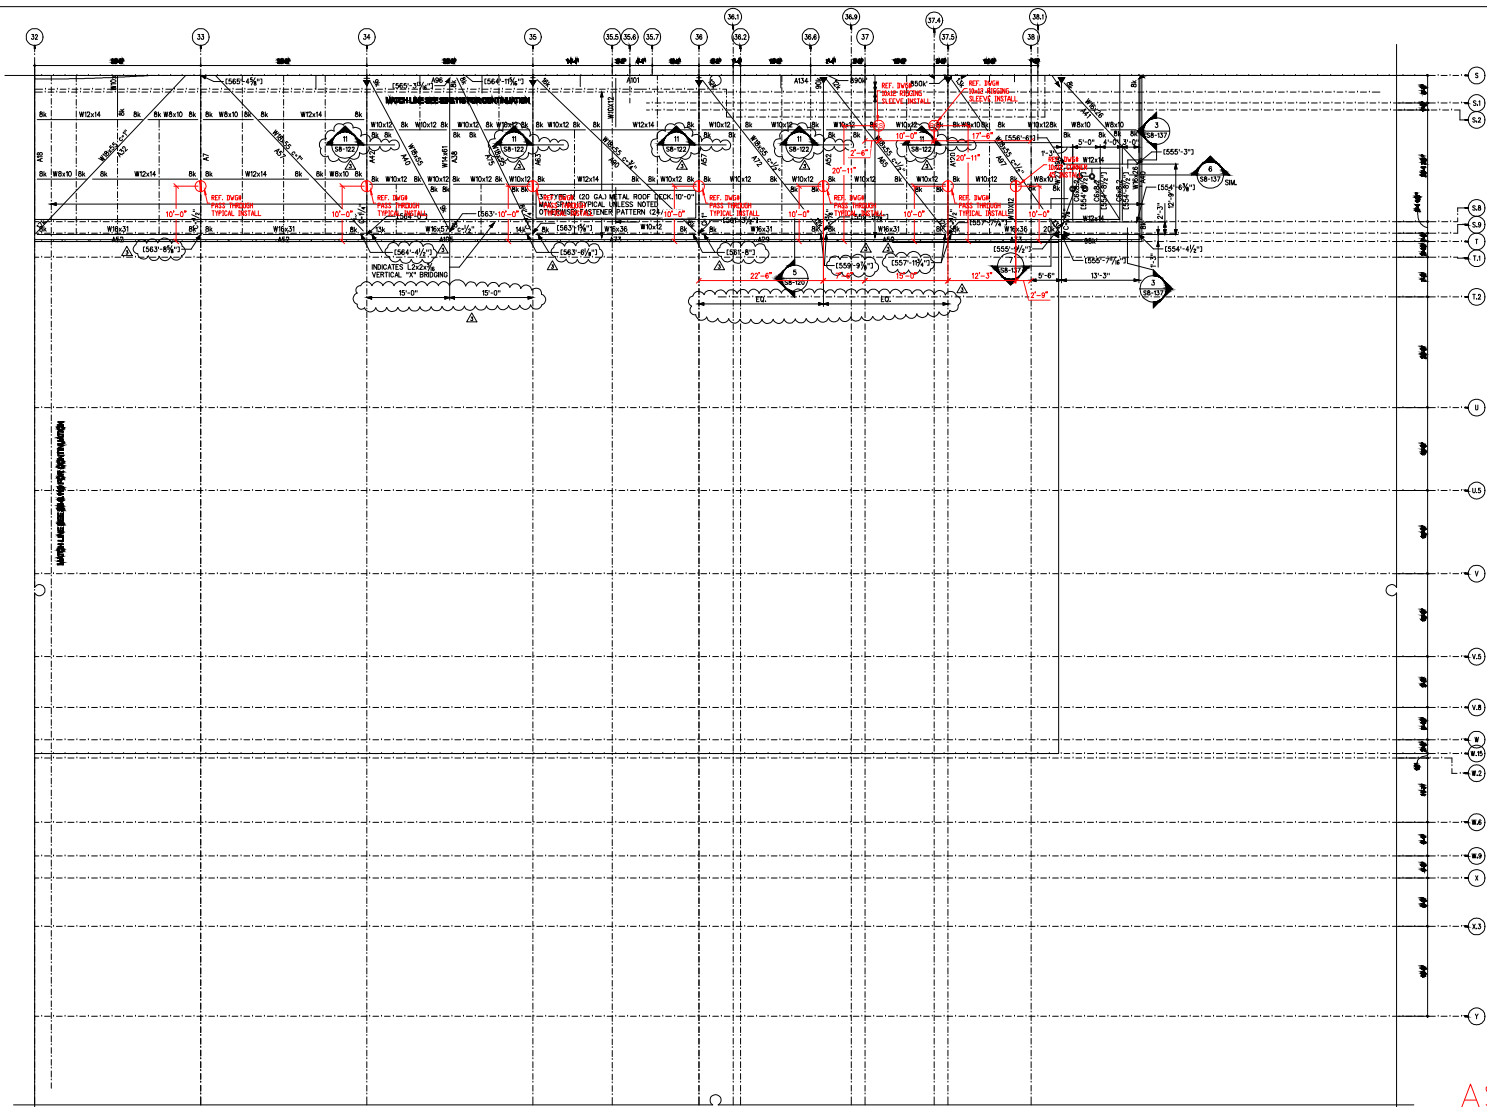

AS-BUILTS


ANCHOR SYMBOLS	
	HLL INTERMEDIATE PASS THROUGH ANCHOR
	HLL INTERMEDIATE PASS THROUGH ANCHOR @ 45° ANGLE TURN
	HLL PASS THROUGH @ END
	WW DRILLING SLEEVE






629 CORNELIA CT.
NASHVILLE, TN 37127

DWG. NO. S2-8.120 MAIN ROOF HLL & WW ANCHOR LOCATIONS

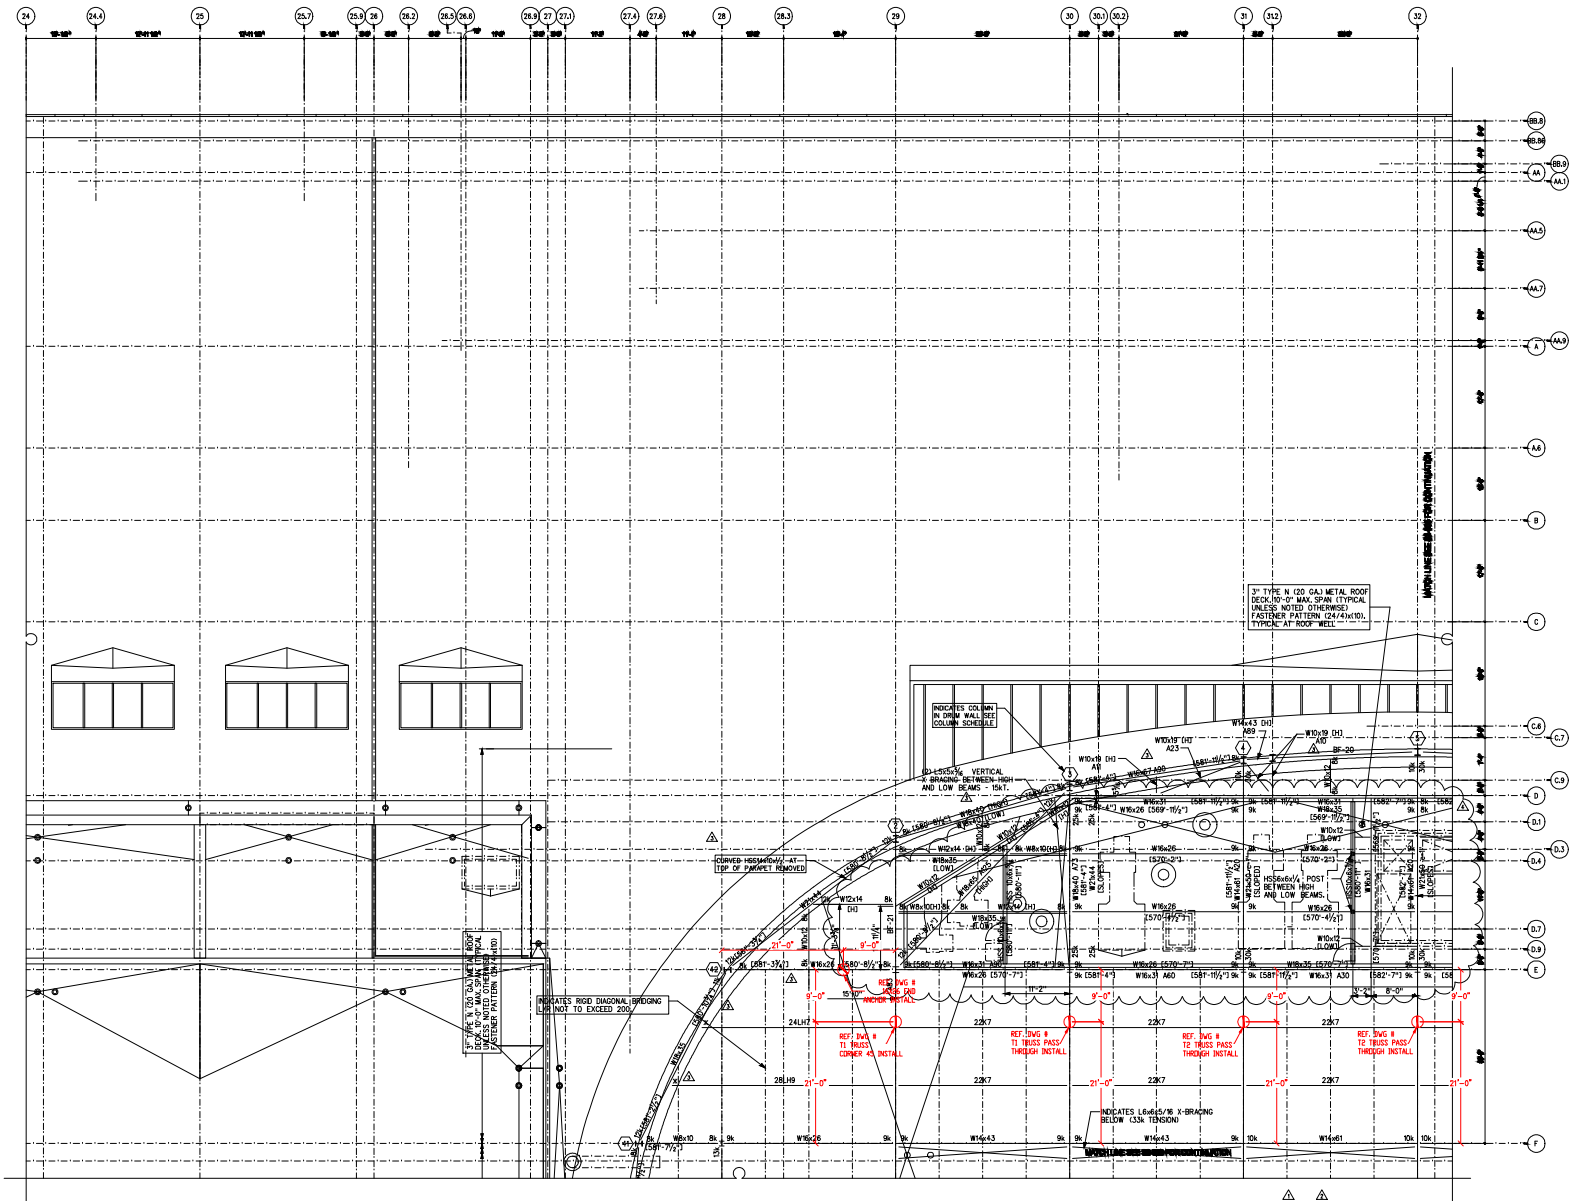SCALE: N.T.S.	WEIGHT:	SHEET: 1 OF 1
---------------	---------	---------------



ANCHOR SYMBOLS



 HLL INTERMEDIATE PASS THROUGH ANCHOR
 HLL INTERMEDIATE PASS THROUGH ANCHOR @ 45° CABLE TURN
 HLL PASS THROUGH @ END

AS-BUILTS



629 CORNELIA CT.
NASHVILLE, TN 37127

DWG. NO.		S2-904 BALLROOM ROOF HLL ANCHOR LOCATIONS	
SCALE: N.T.S.	WEIGHT:	SHEET: 1 OF 1	

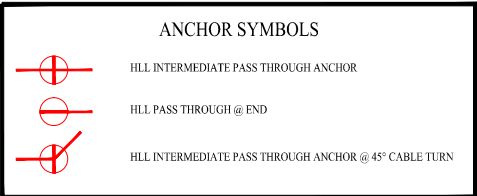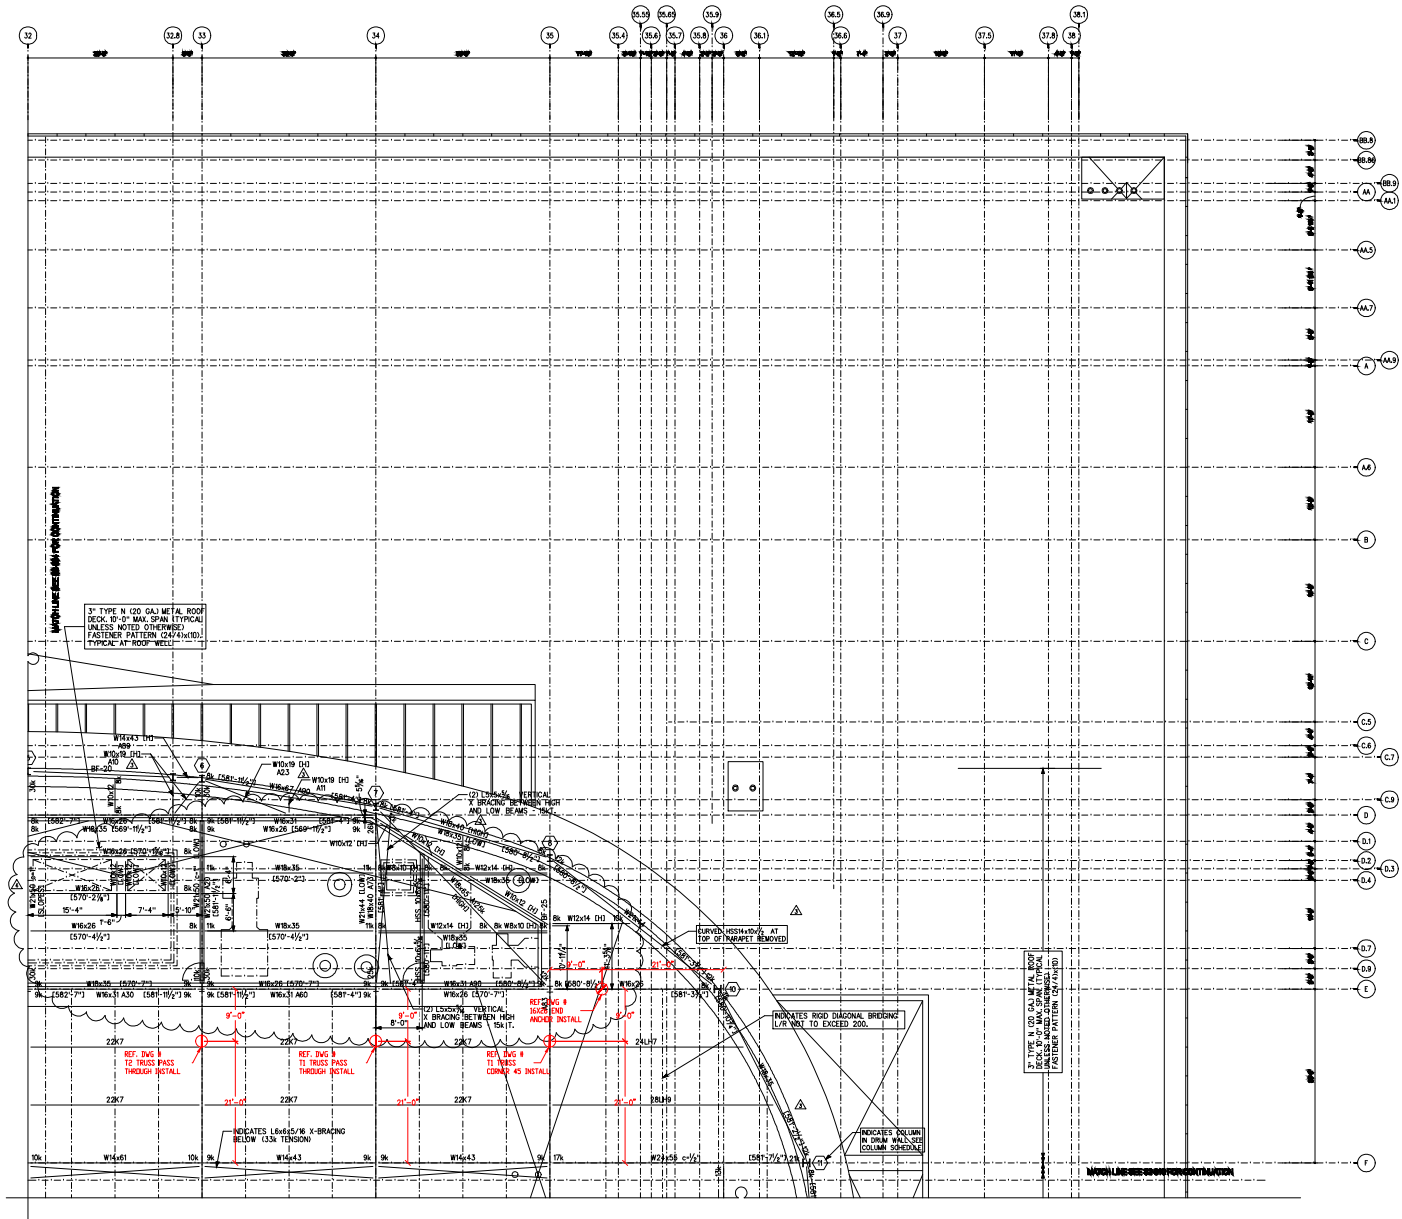

629 CORNELIA CT.
NASHVILLE, TN 37127

AS-BUILTS

DWG. NO. S2-905 BALLROOM ROOF HLL ANCHOR LOCATIONS

SCALE: N.T.S. WEIGHT: SHEET: 1 OF 1




ANCHOR SYMBOLS

- HLL INTERMEDIATE PASS THROUGH ANCHOR
- HLL INTERMEDIATE PASS THROUGH ANCHOR @ 45° CABLE TURN


AS-BUILTS

ACE MACHINE AND METAL FABRICATION COMPANY
 629 CORNELIA CT.
 NASHVILLE, TN 37127

DWG. NO. S2-909 BALLROOM ROOF HLL ANCHOR LOCATIONS
 SCALE: N.T.S. WEIGHT: SHEET: 1 OF 1

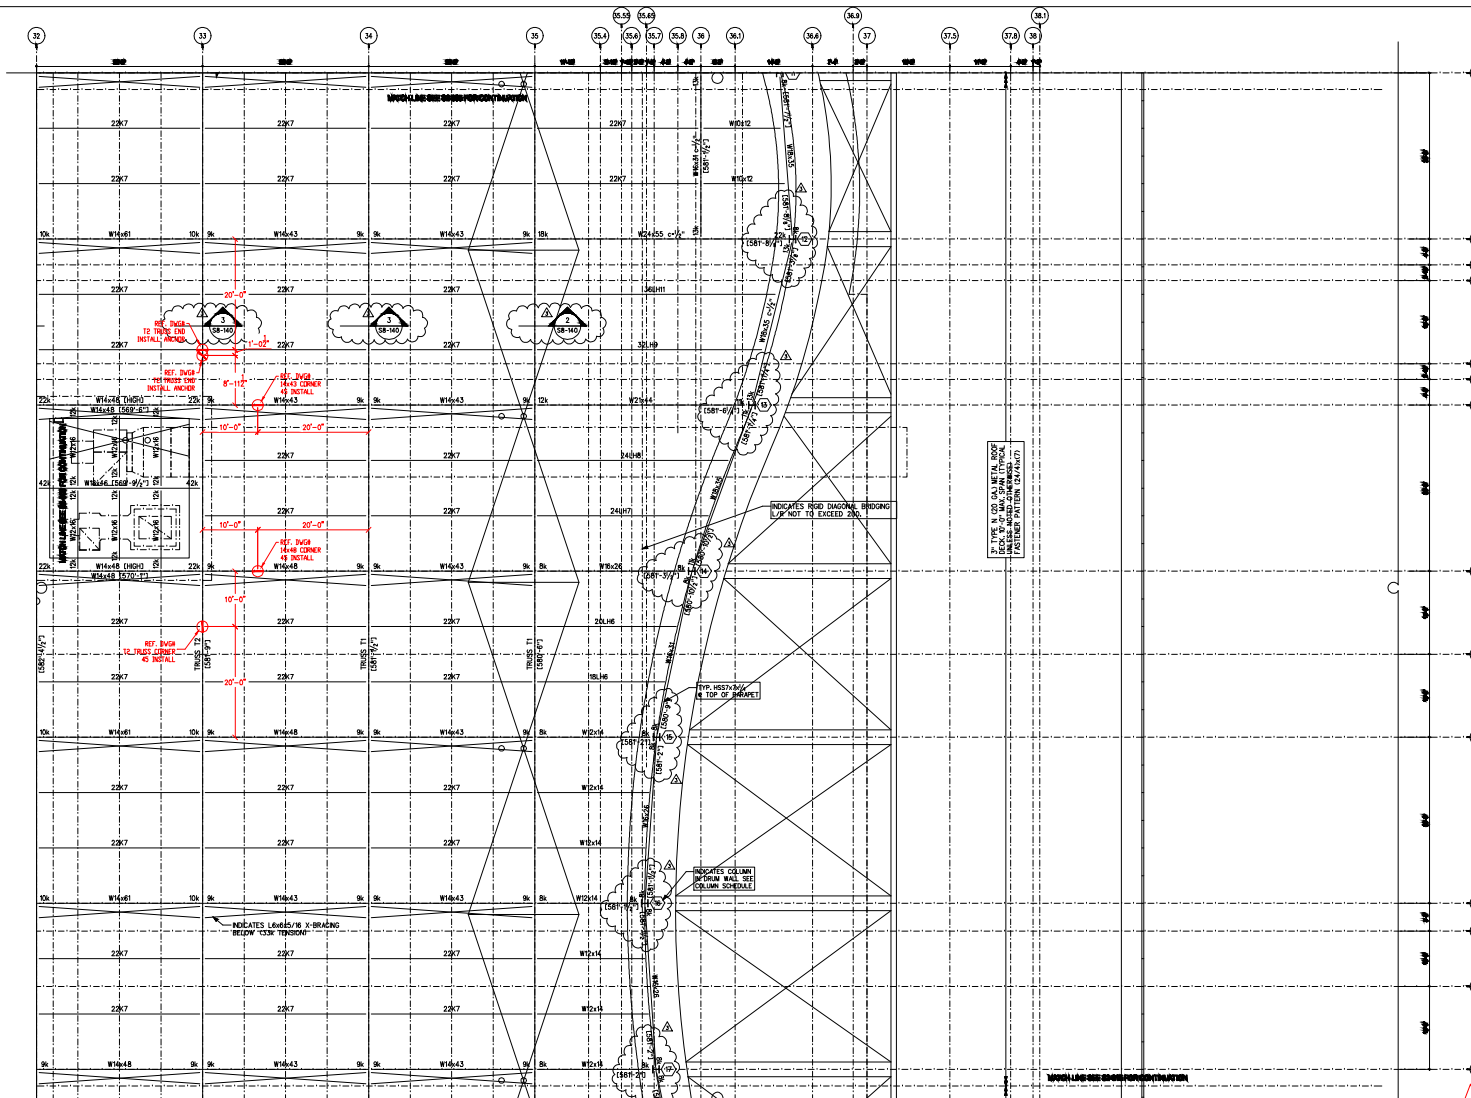


AS-BUILTS

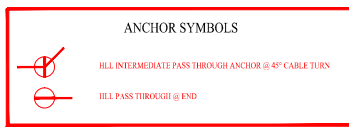

ACE
MACHINE
 AND METAL FABRICATION
 COMPANY

629 CORNELIA CT.
 NASHVILLE, TN 37127

DWG. NO. S2-910 BALLROOM ROOF HLL ANCHOR LOCATIONS	
SCALE: N.T.S.	WEIGHT:
SHEET: 1 OF 1	

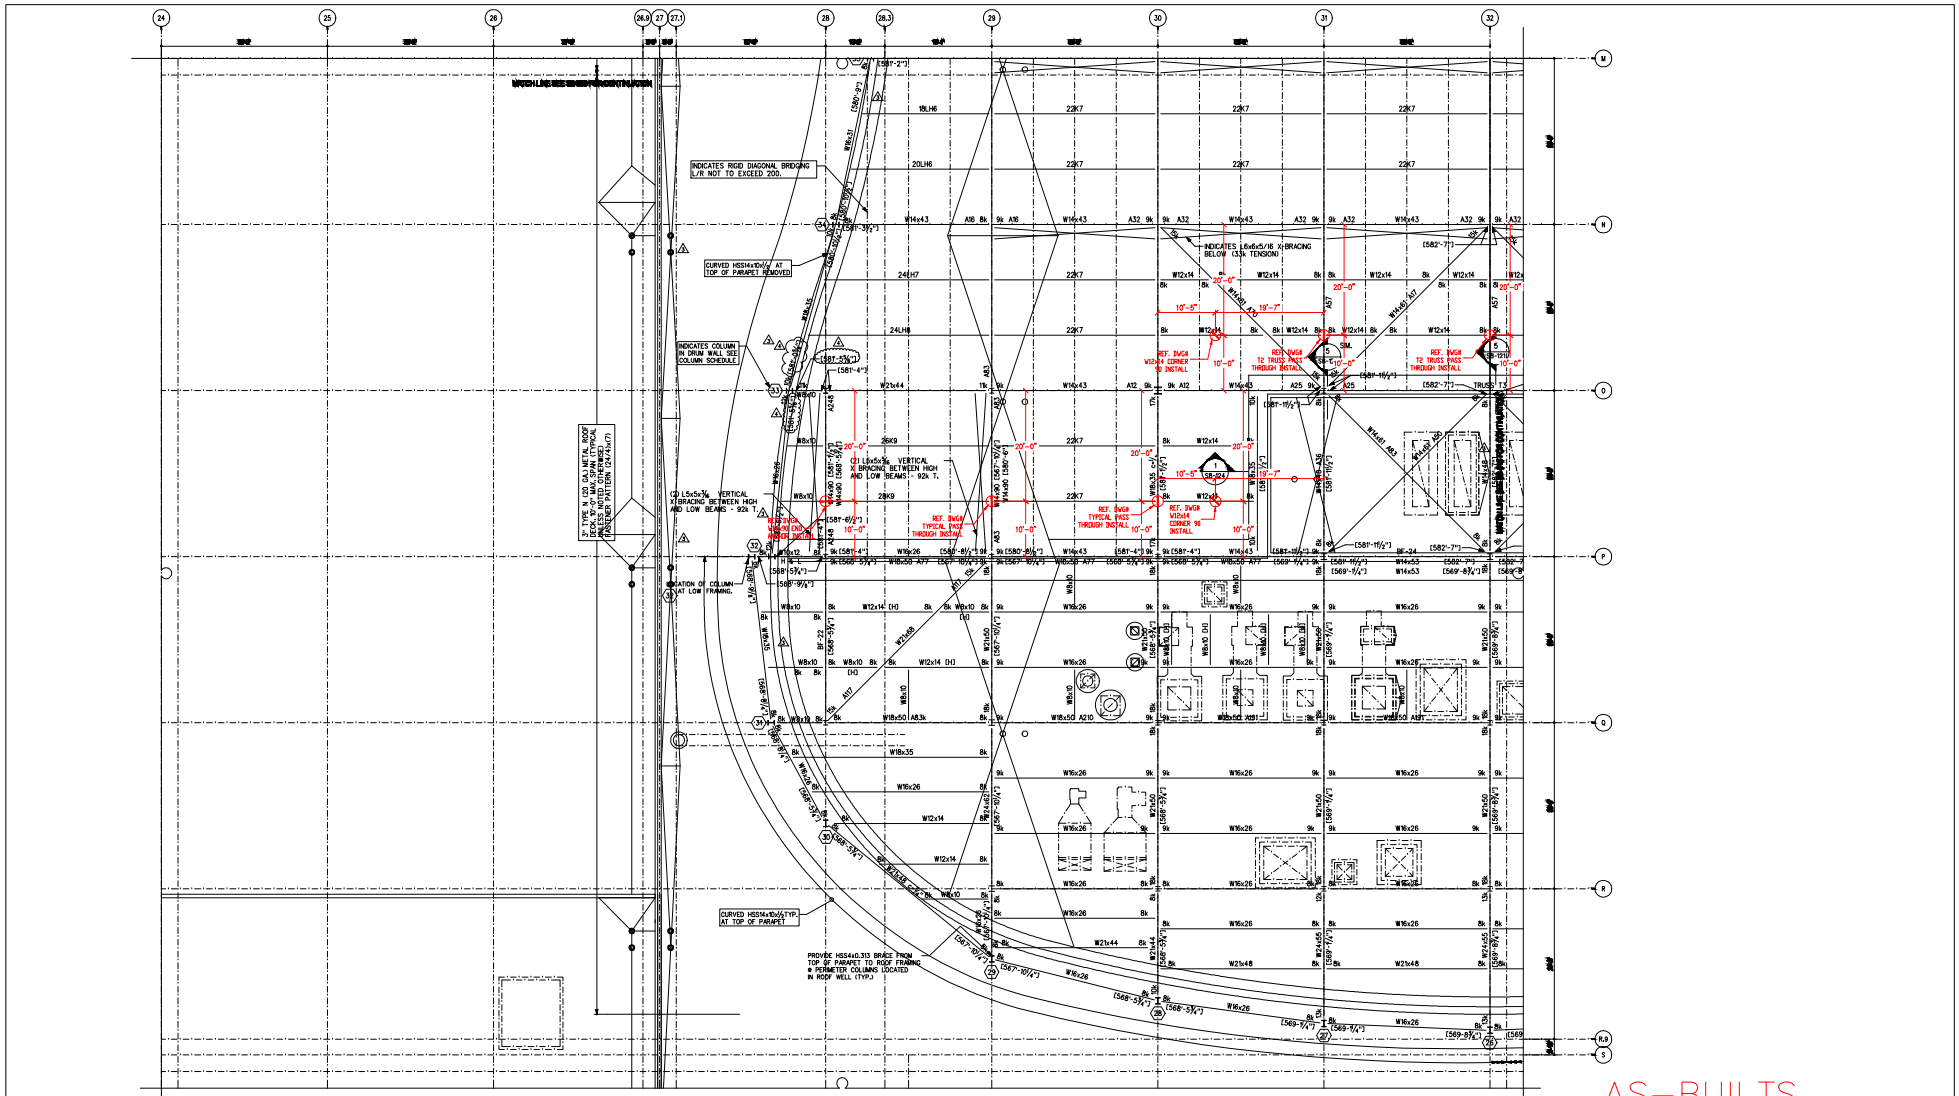

ANCHOR SYMBOLS	
	HLL INTERMEDIATE PASS THROUGH ANCHOR
	HLL INTERMEDIATE PASS THROUGH ANCHOR @ 90° CORN. TURN
	HLL PASS THROUGH @ END




629 CORNELIA CT.
NASHVILLE, TN 37127

AS-BUILTS

DWG. NO.
S2-914 BALLROOM ROOF HLL ANCHOR LOCATIONS

SCALE: N.T.S.	WEIGHT:	SHEET: 1 OF 1
---------------	---------	---------------

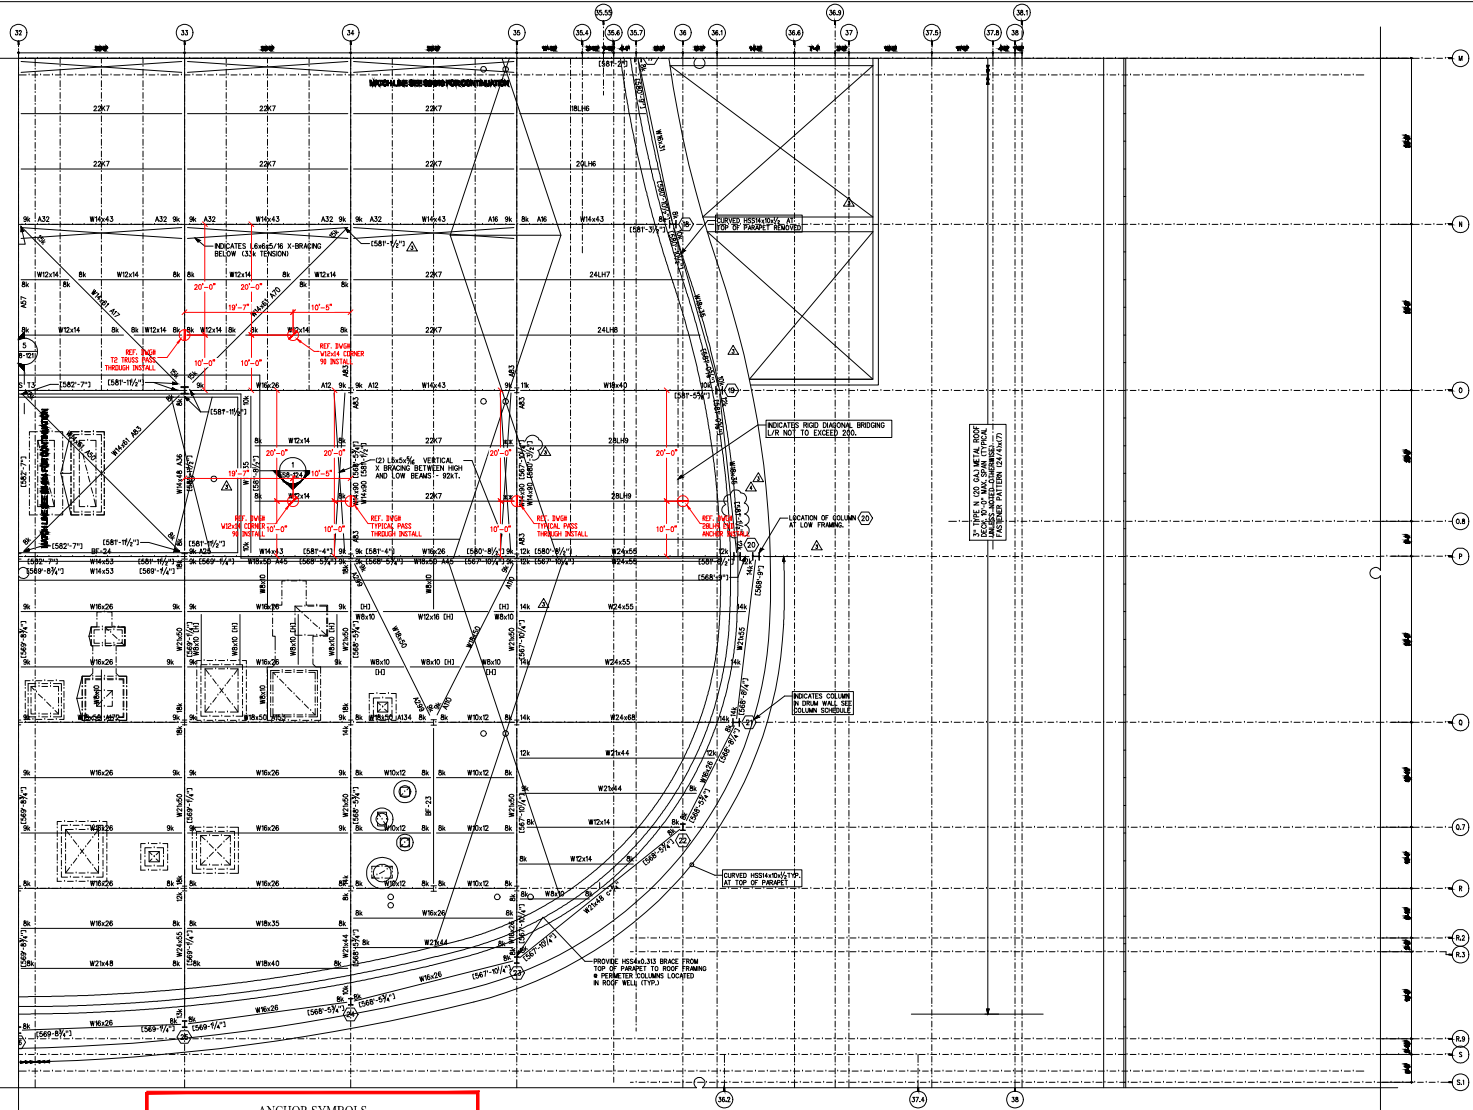

ANCHOR SYMBOLS

- HLL INTERMEDIATE PASS THROUGH ANCHOR
- HLL INTERMEDIATE PASS THROUGH ANCHOR @ 90° CABLE TURN
- HLL PASS THROUGH @ END

AS-BUILTS



629 CORNELIA CT.
NASHVILLE, TN 37127

DWG. NO.
S2-915 BALLROOM ROOF HLL ANCHOR LOCATIONS

SCALE: N.T.S. WEIGHT: SHEET: 1 OF 1